
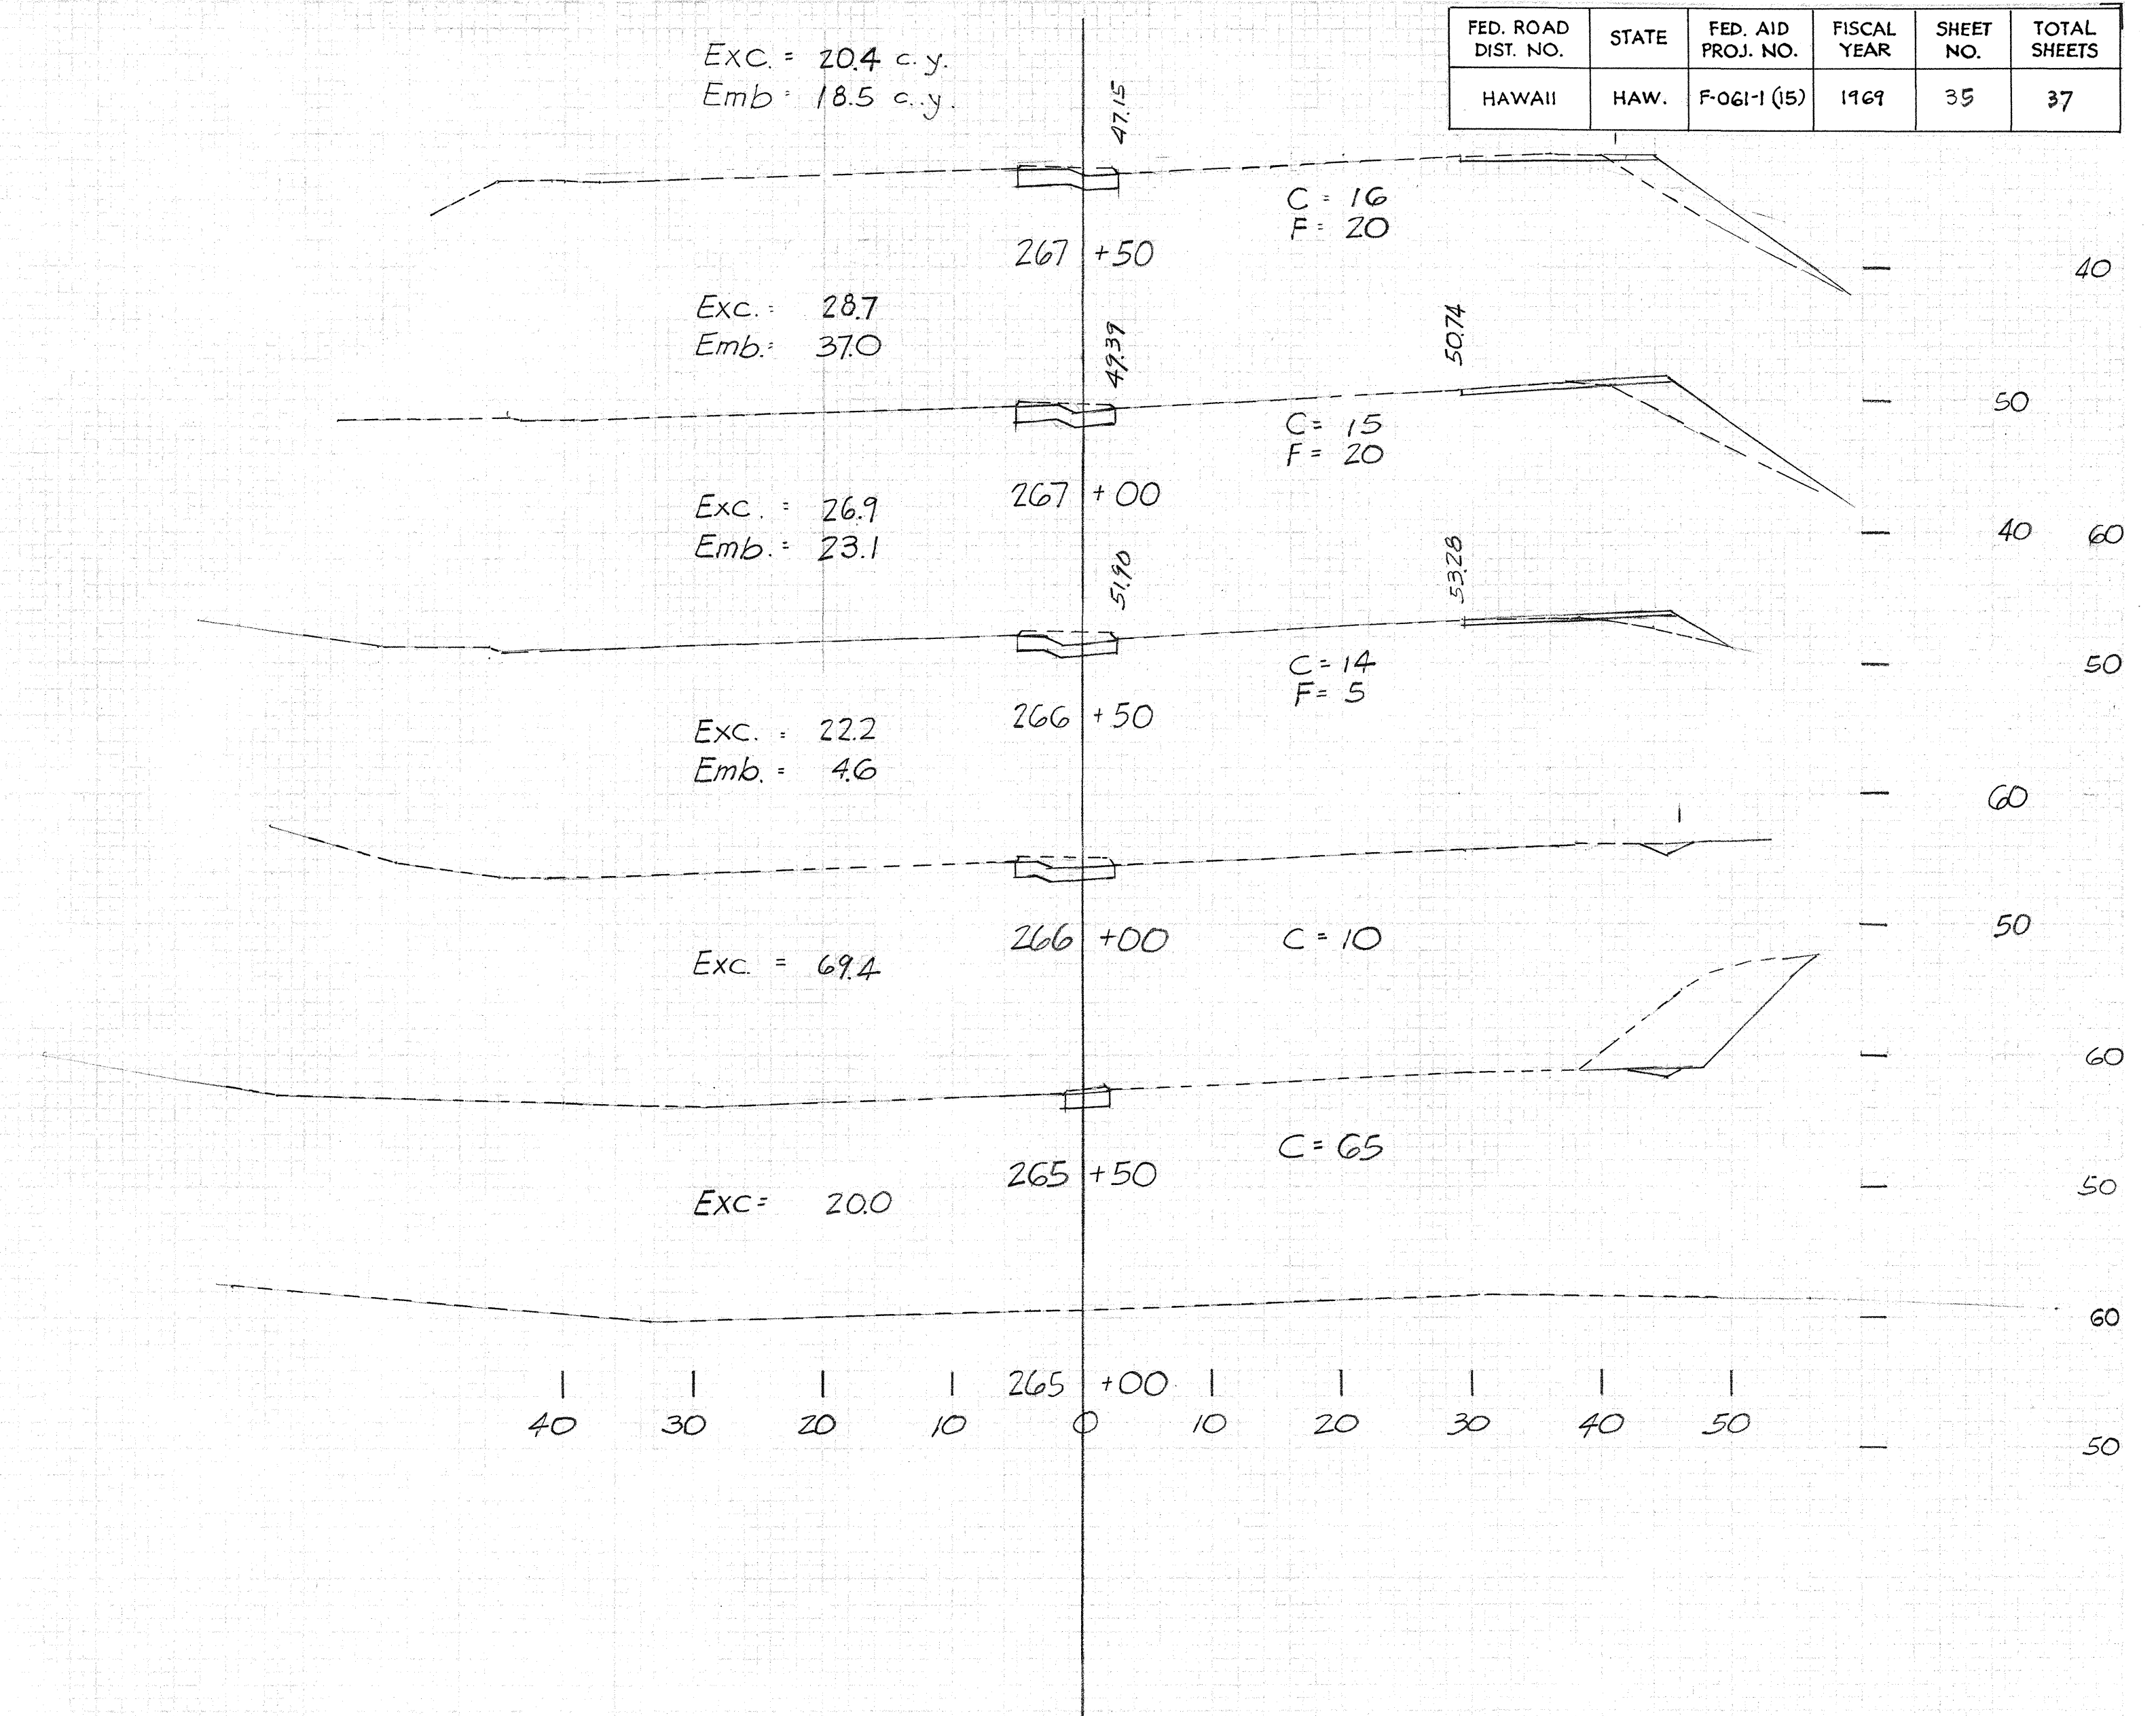


DATE	
BY	
CHECKED	
DESIGNED	
APPROVED	


Earthwork at Intersection
vicinity of Line "C" (to be added to E sections)

Removal of existg. pavt. for sodded islands	Area (s.y.) = 275	Exc (c.y.) = 92	Top Soil = 92 c.y.
New pavement	= 60	40	

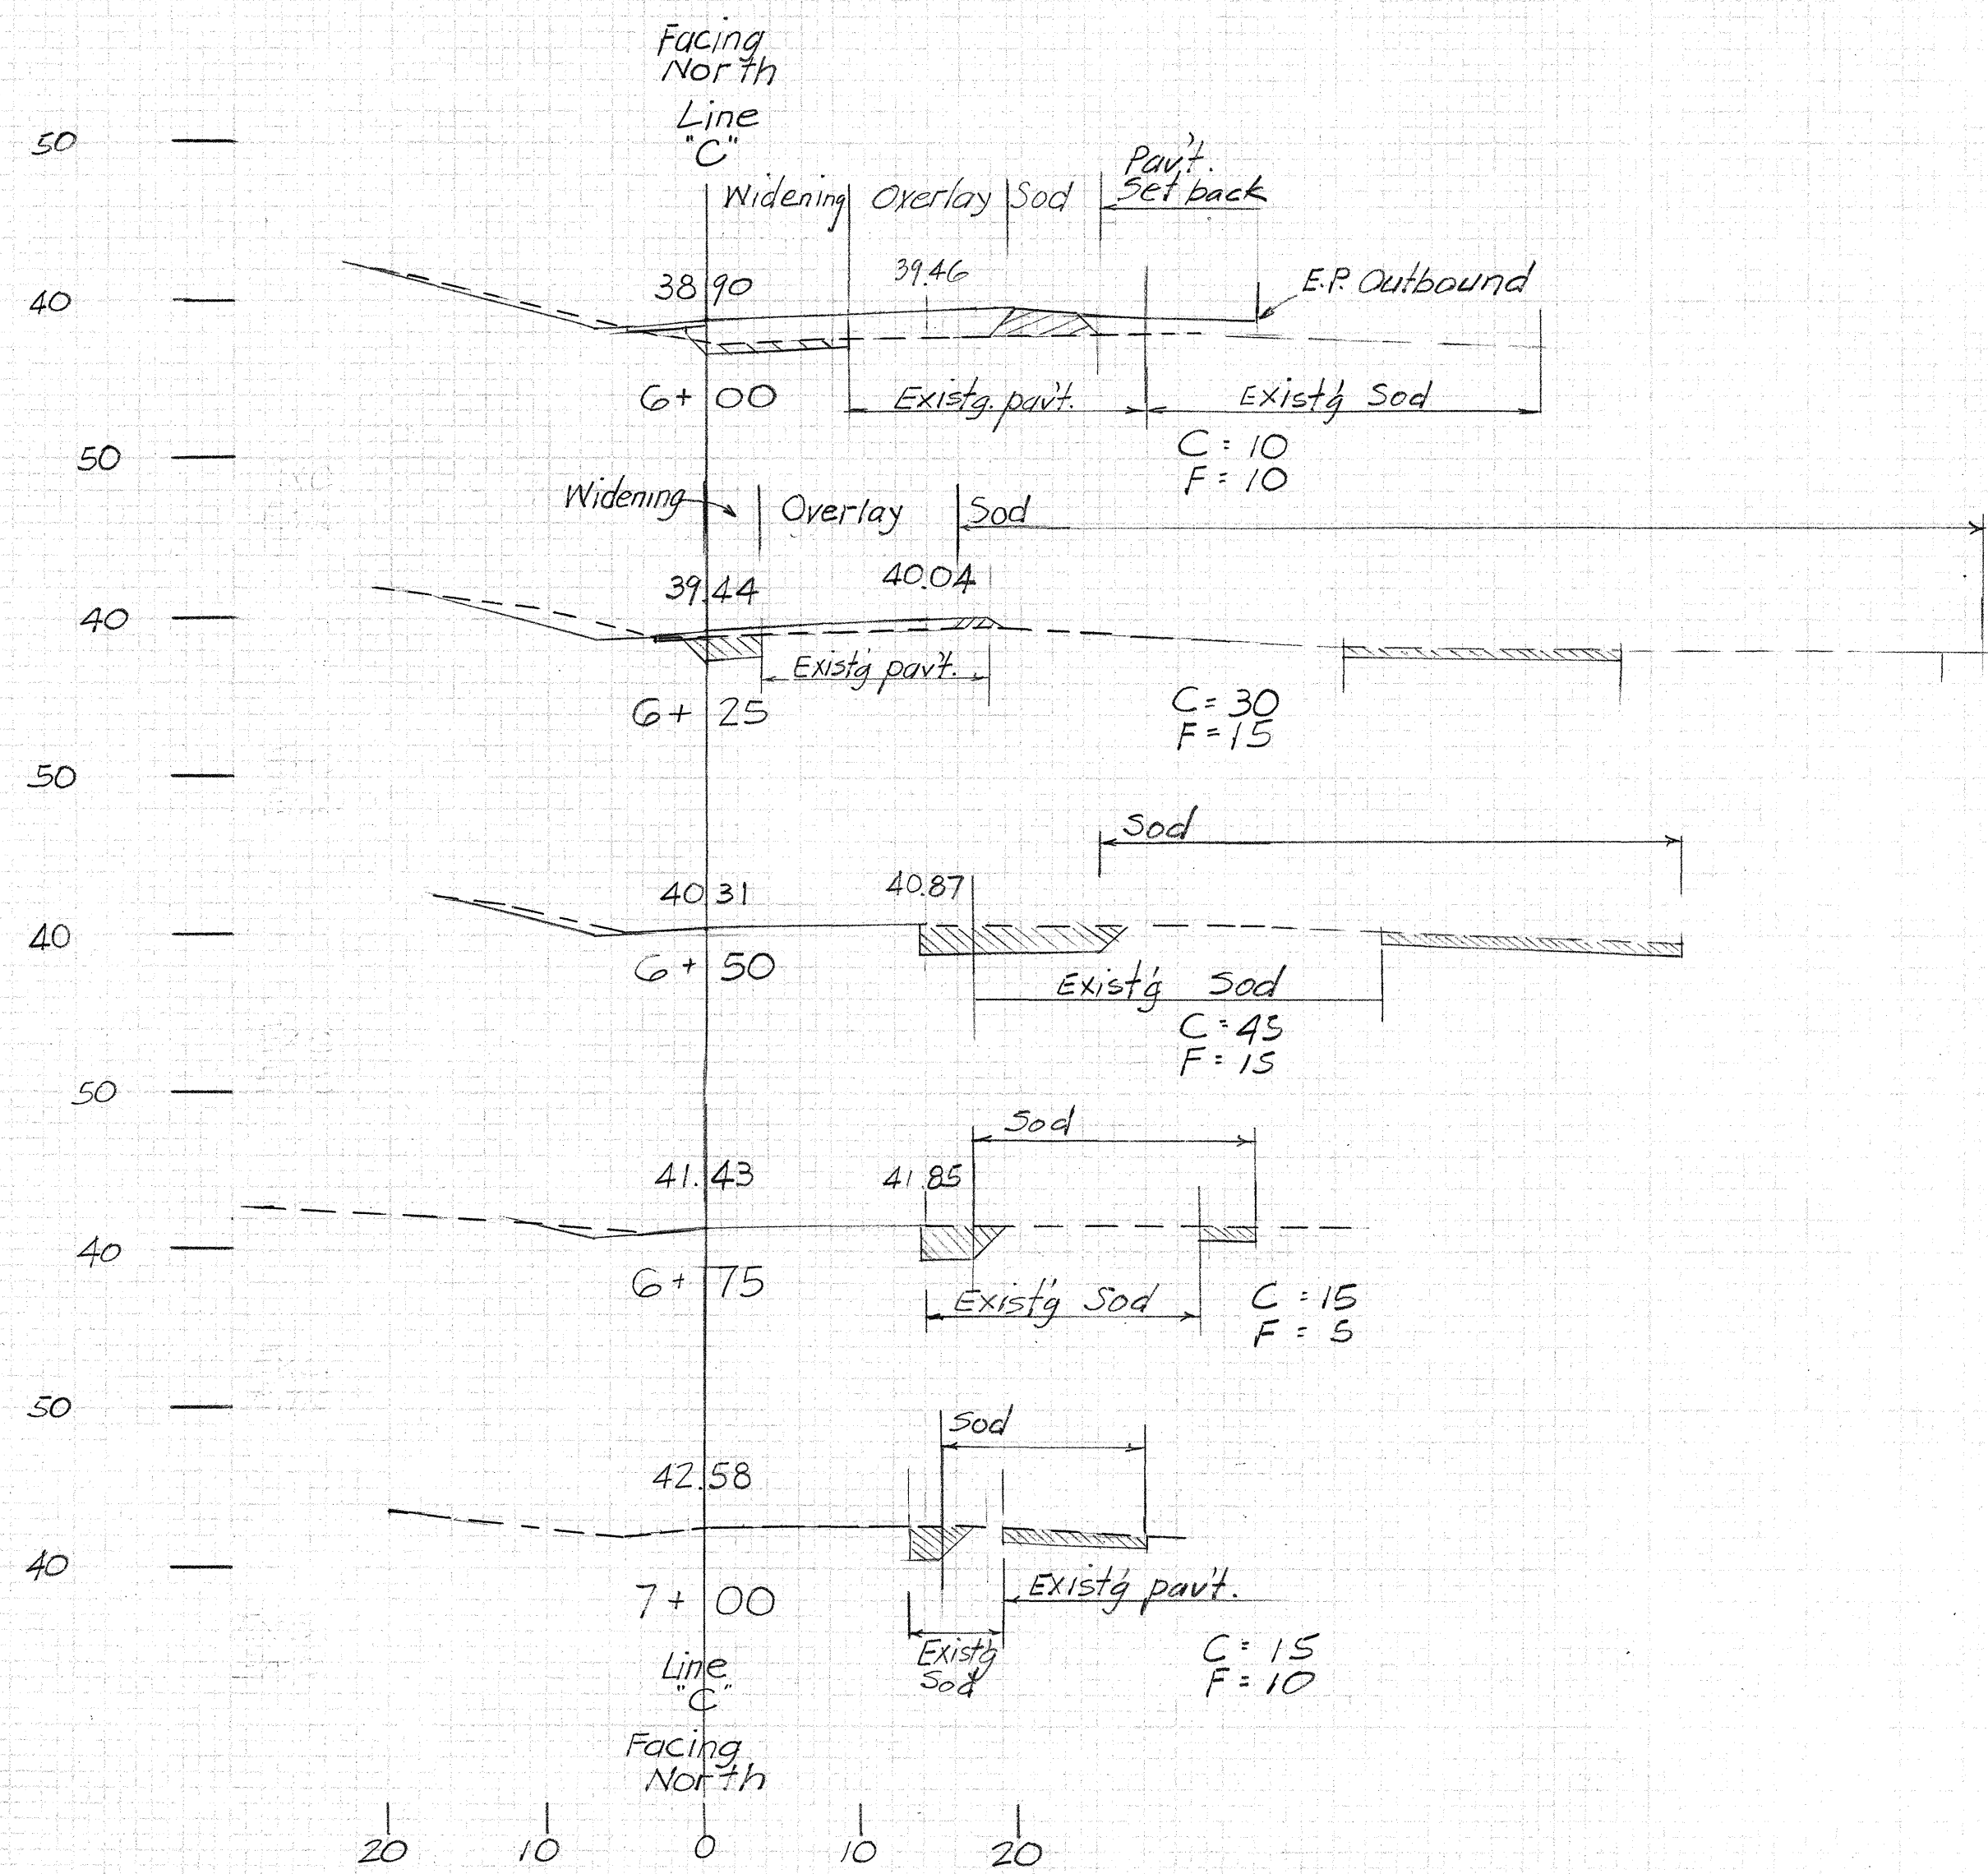

FED. ROAD DIST. NO.	STATE	FED. AID PROJ. NO.	FISCAL YEAR	SHEET NO.	TOTAL SHEETS
HAWAII	HAW.	F-061-1 (5)	1969	35	37

FED. ROAD DIST. NO.	STATE	FED. AID PROJ. NO.	FISCAL YEAR	SHEET NO.	TOTAL SHEETS
HAWAII	HAW	F-061-1 (15)	1969	36	37

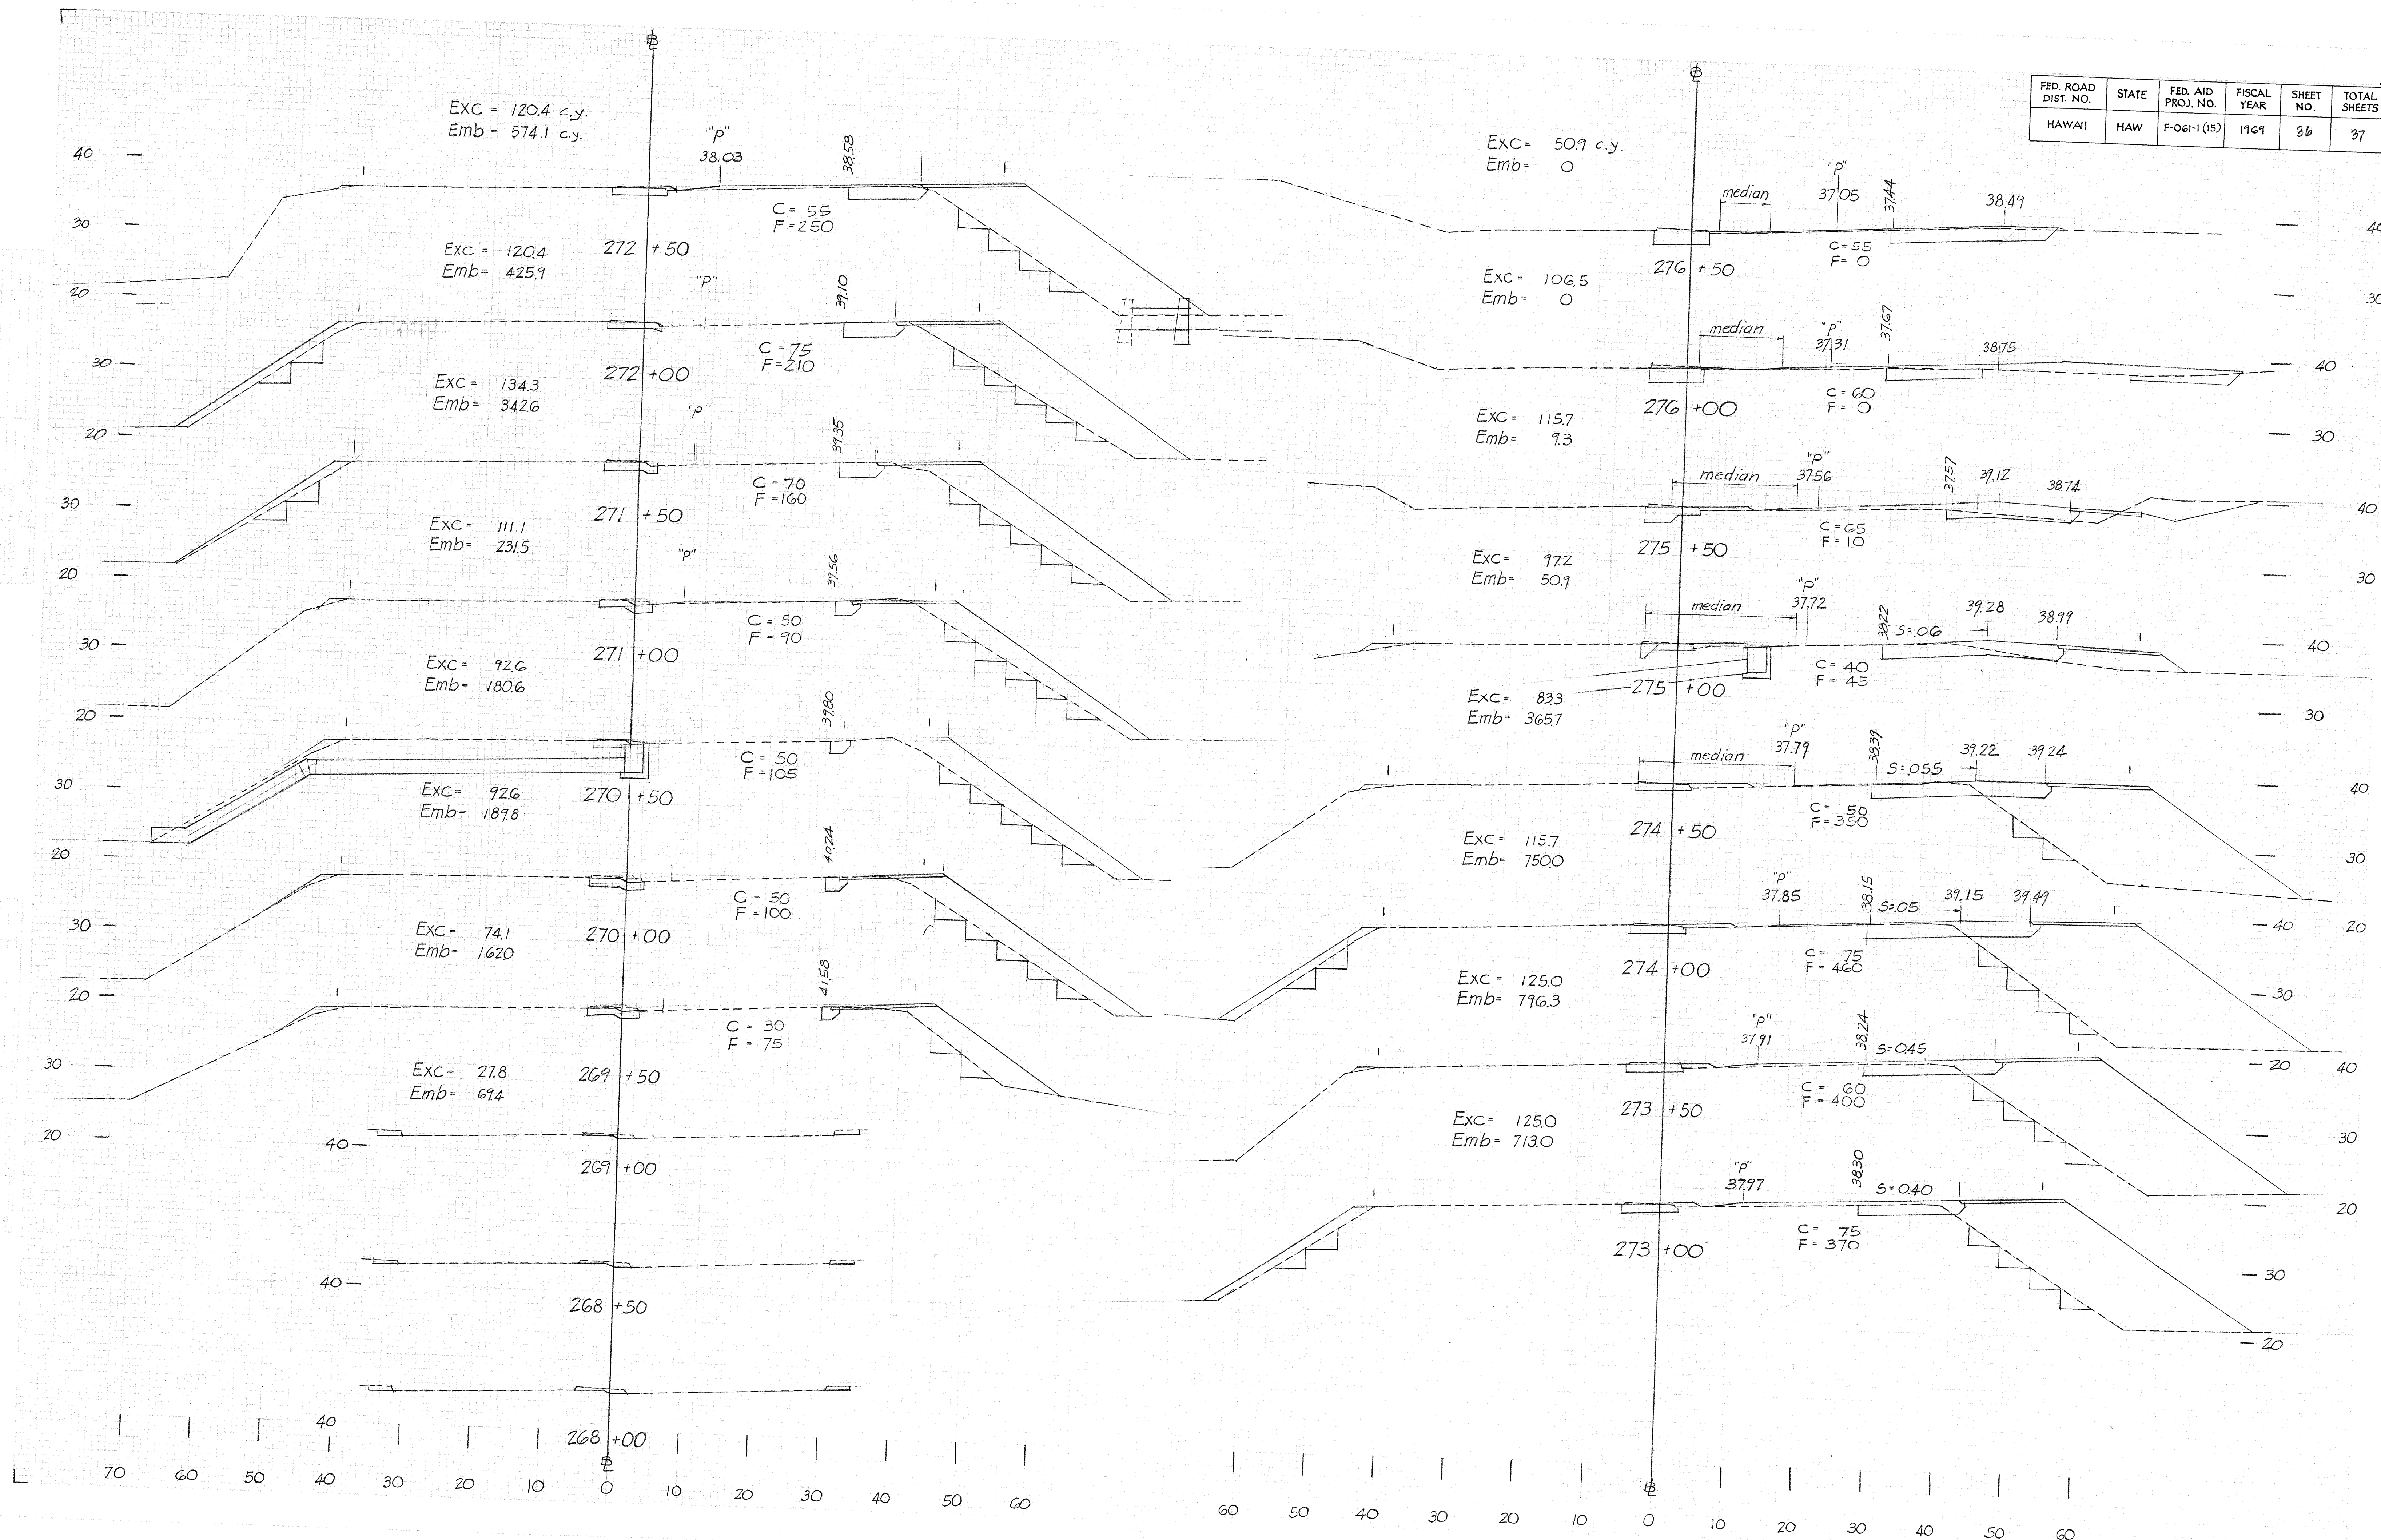

FED. ROAD DIST. NO.	STATE	FED. AID PROJ. NO.	FISCAL YEAR	SHEET NO.	TOTAL SHEETS
HAWAII	HAW.	F-OGH (5)	1969	37	37

