
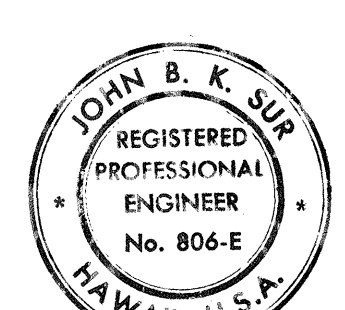


FED. ROAD DIST. NO.	STATE	FED. AID PROJ. NO.	FISCAL YEAR	SHEET NO.	TOTAL SHEETS
HAWAII	HAW.	F-061-1(15)	1969	4	37

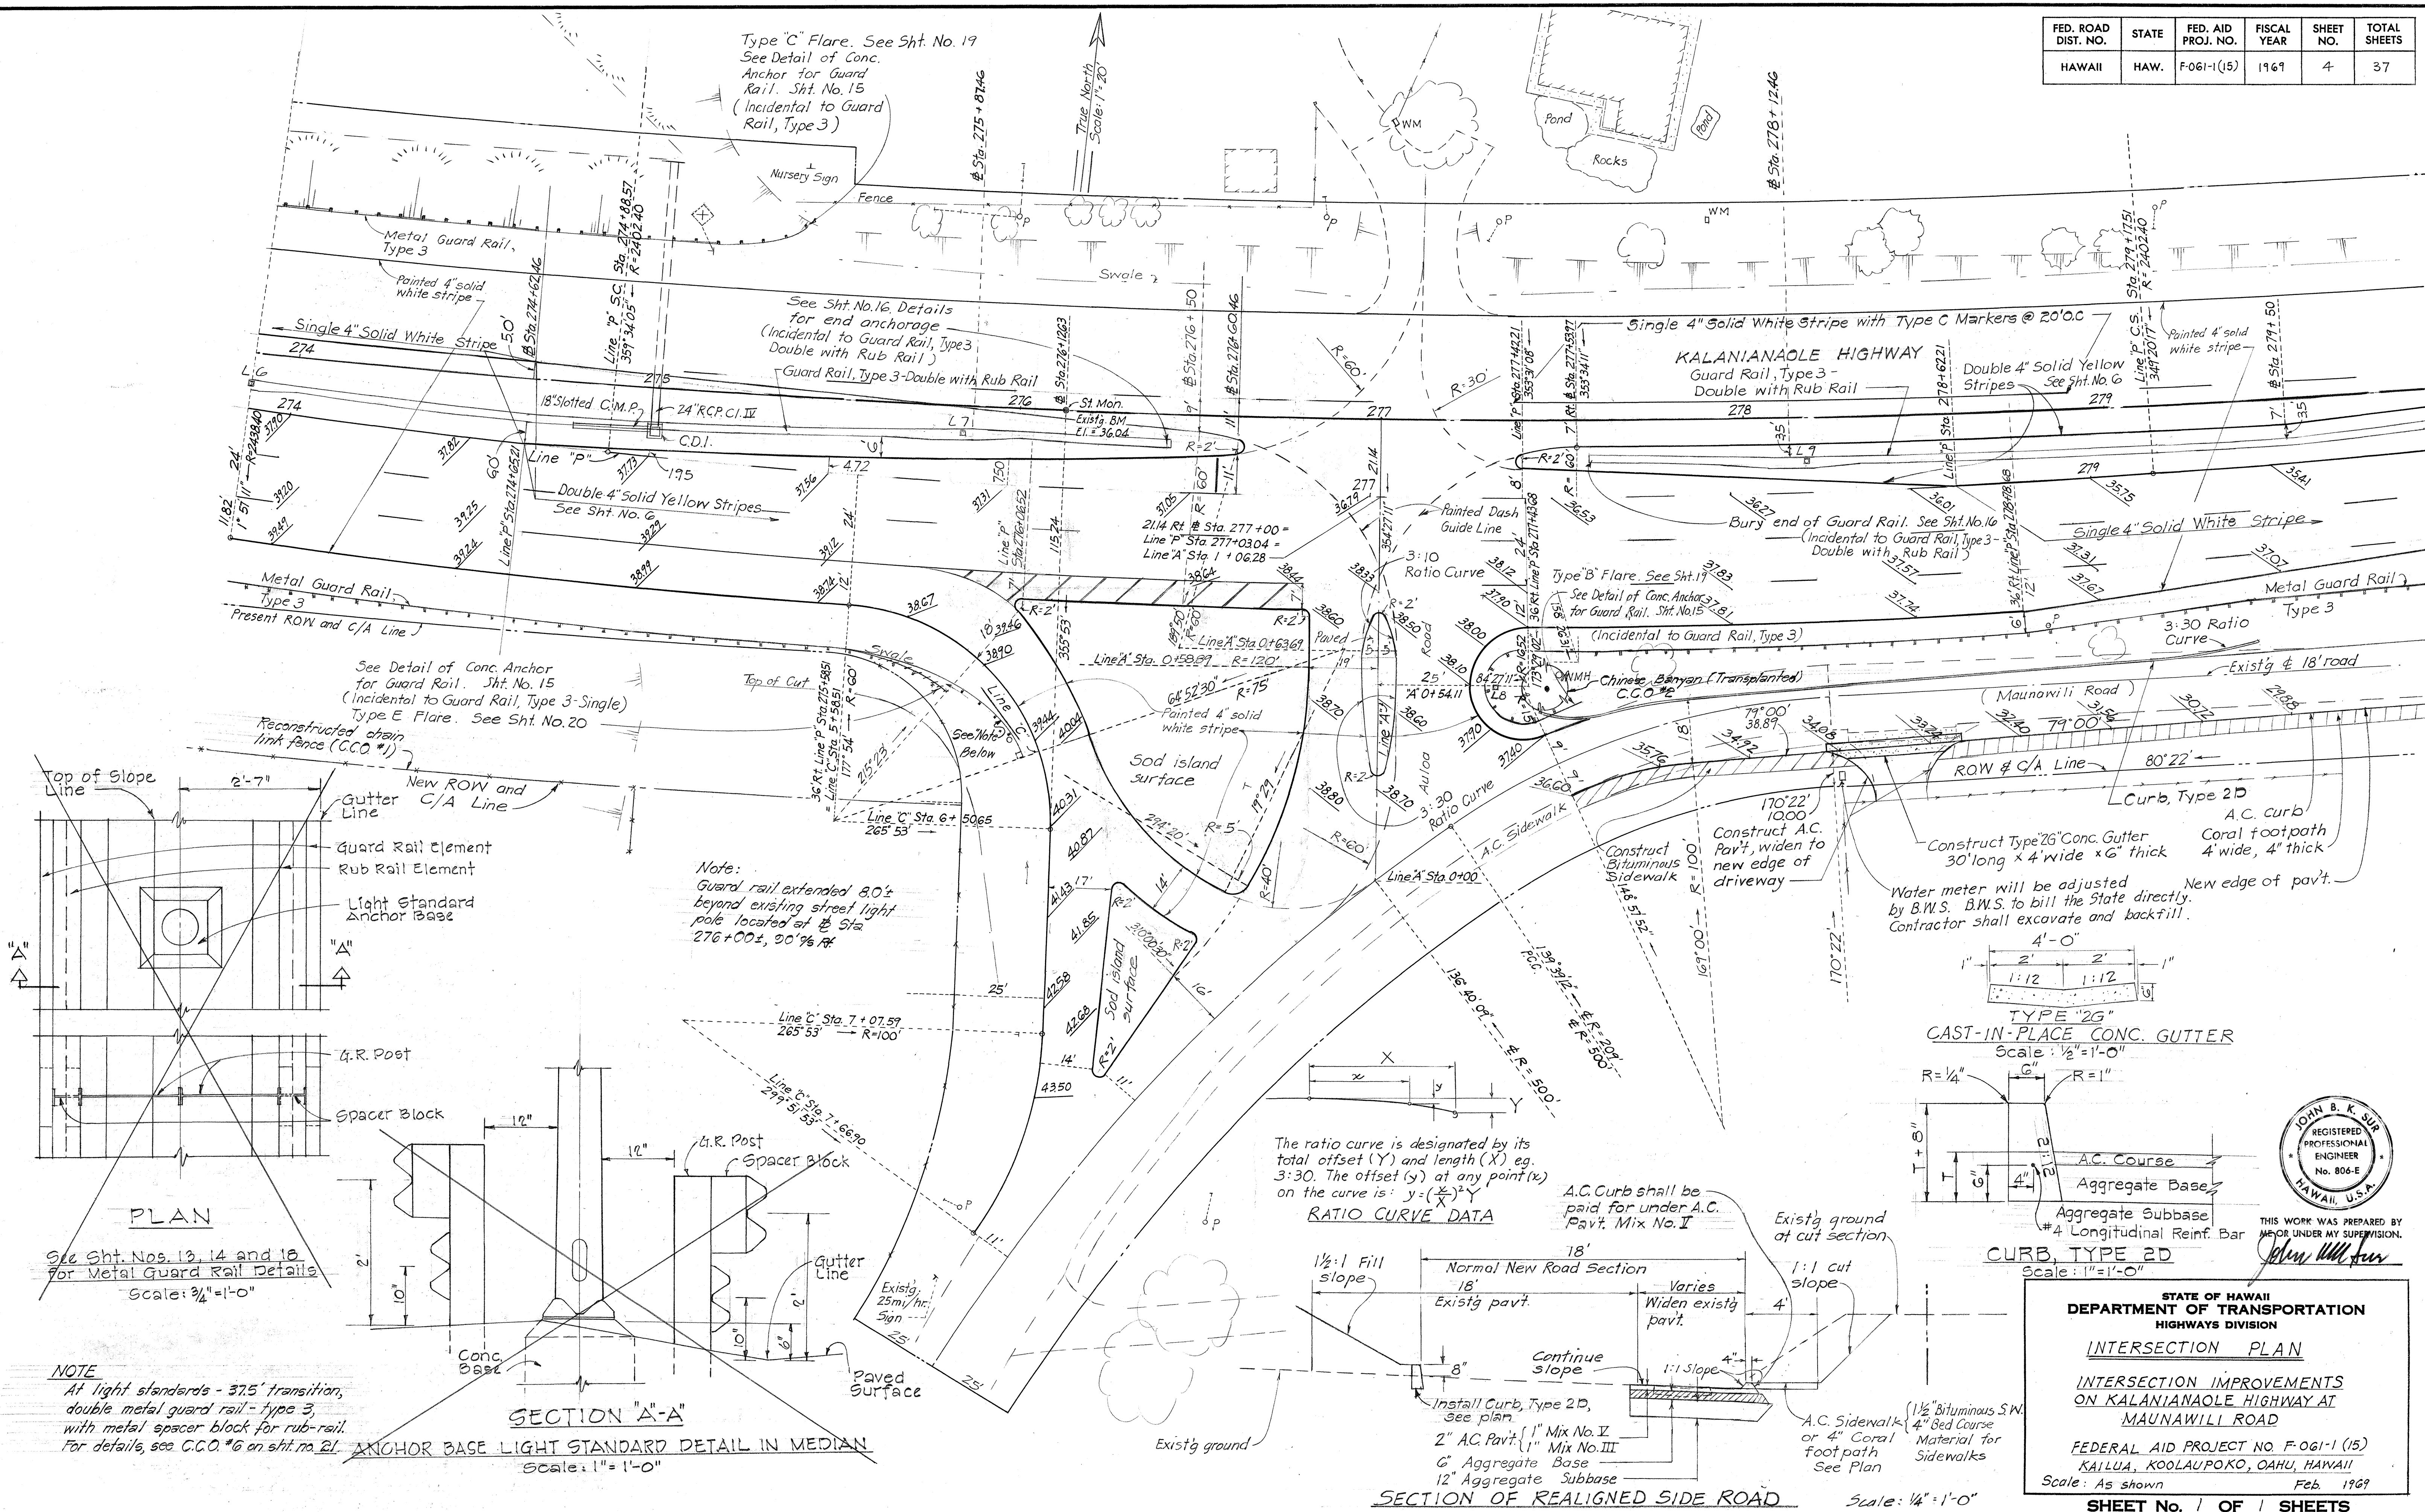

THIS WORK WAS PREPARED BY ME OR UNDER MY SUPERVISION.

STATE OF HAWAII
DEPARTMENT OF TRANSPORTATION
HIGHWAYS DIVISION

INTERSECTION PLAN

INTERSECTION IMPROVEMENTS ON KALANIANA'OLE HIGHWAY AT MAUNAWILI ROAD

FEDERAL AID PROJECT NO. F-061-1(15)
KAILUA, KOOLAUPOKO, OAHU, HAWAII

Scale: As shown Feb. 1969

SHEET NO. 1 OF 1 SHEETS