
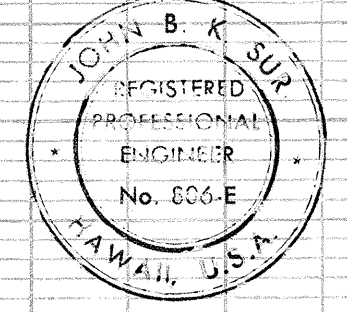
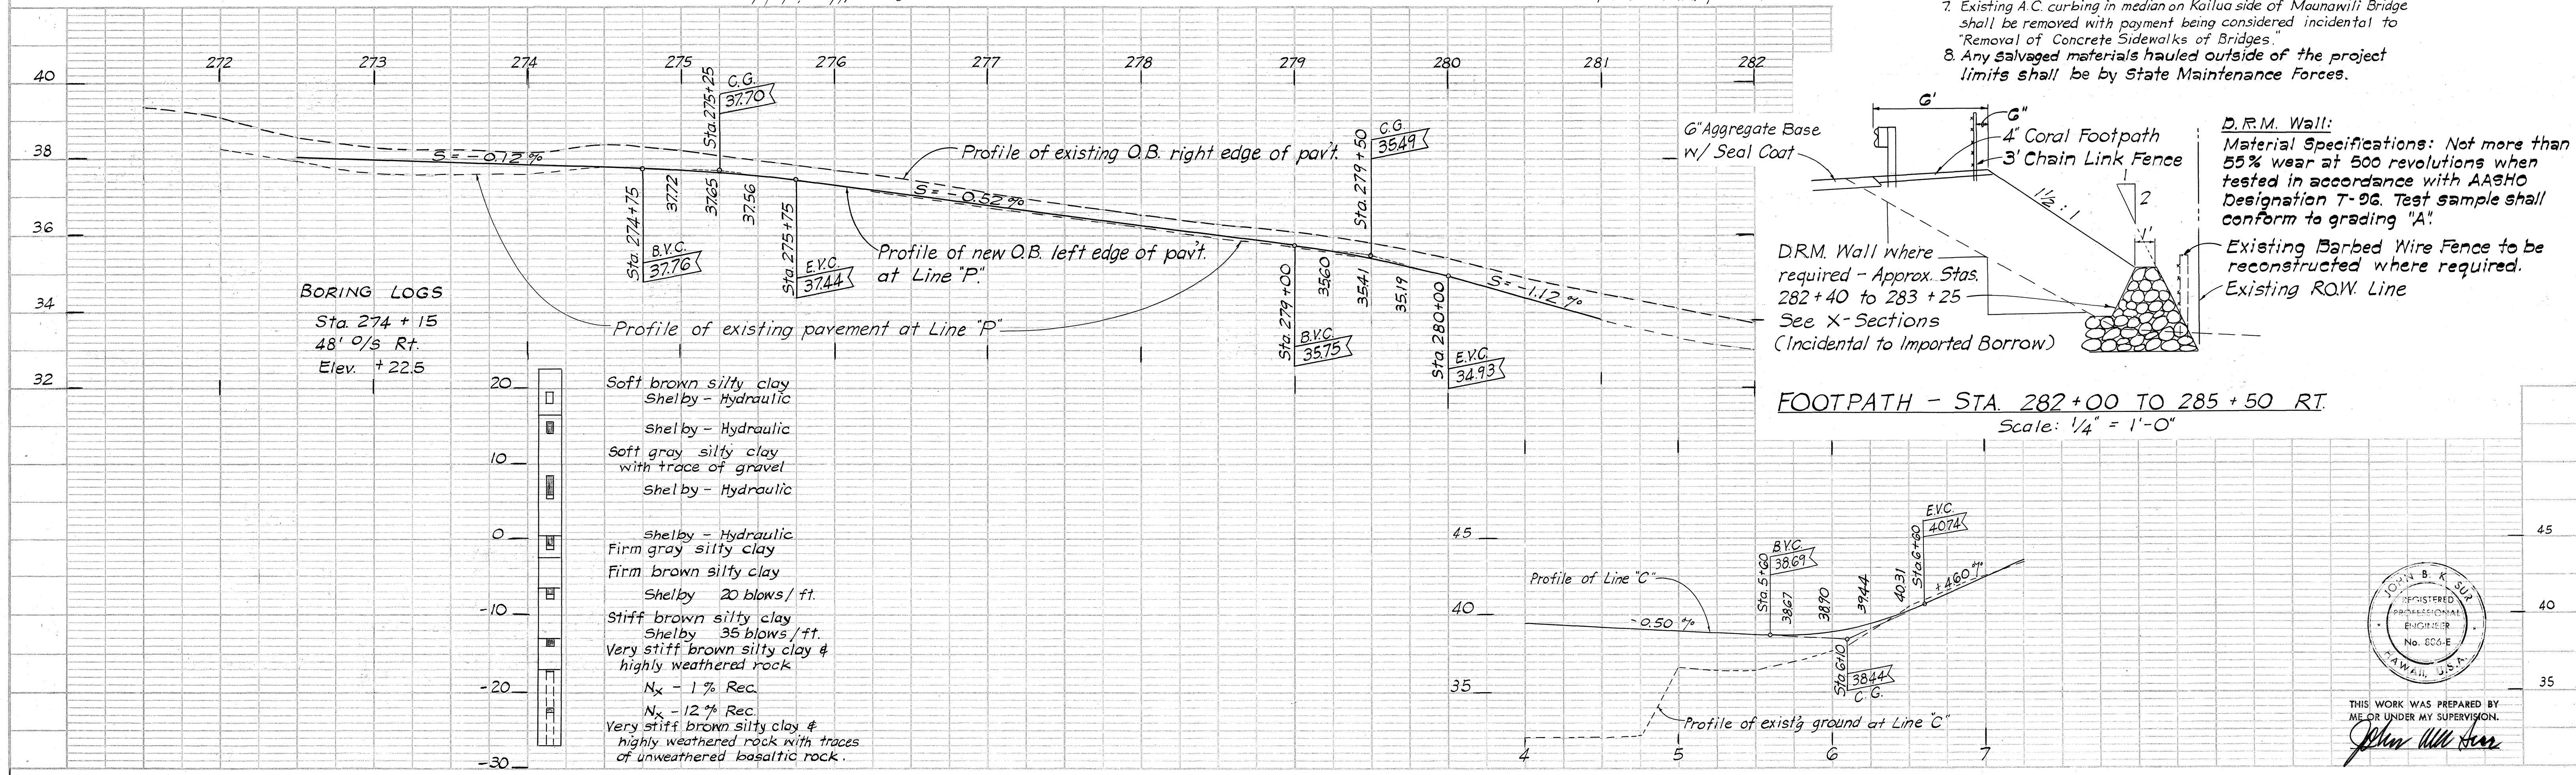


FED. ROAD DIST. NO.	STATE	PROJ. NO.	FISCAL YEAR	SHEET NO.	TOTAL SHEETS
HAWAII	HAW.	F 06-1 (15)	1969	3	37

PLAN	DATE	BY
DESIGNED		
CHECKED		
NOTED		
NO.		

PROFILE	DATE	BY
DESIGNED		
CHECKED		
NOTED		
NO.		

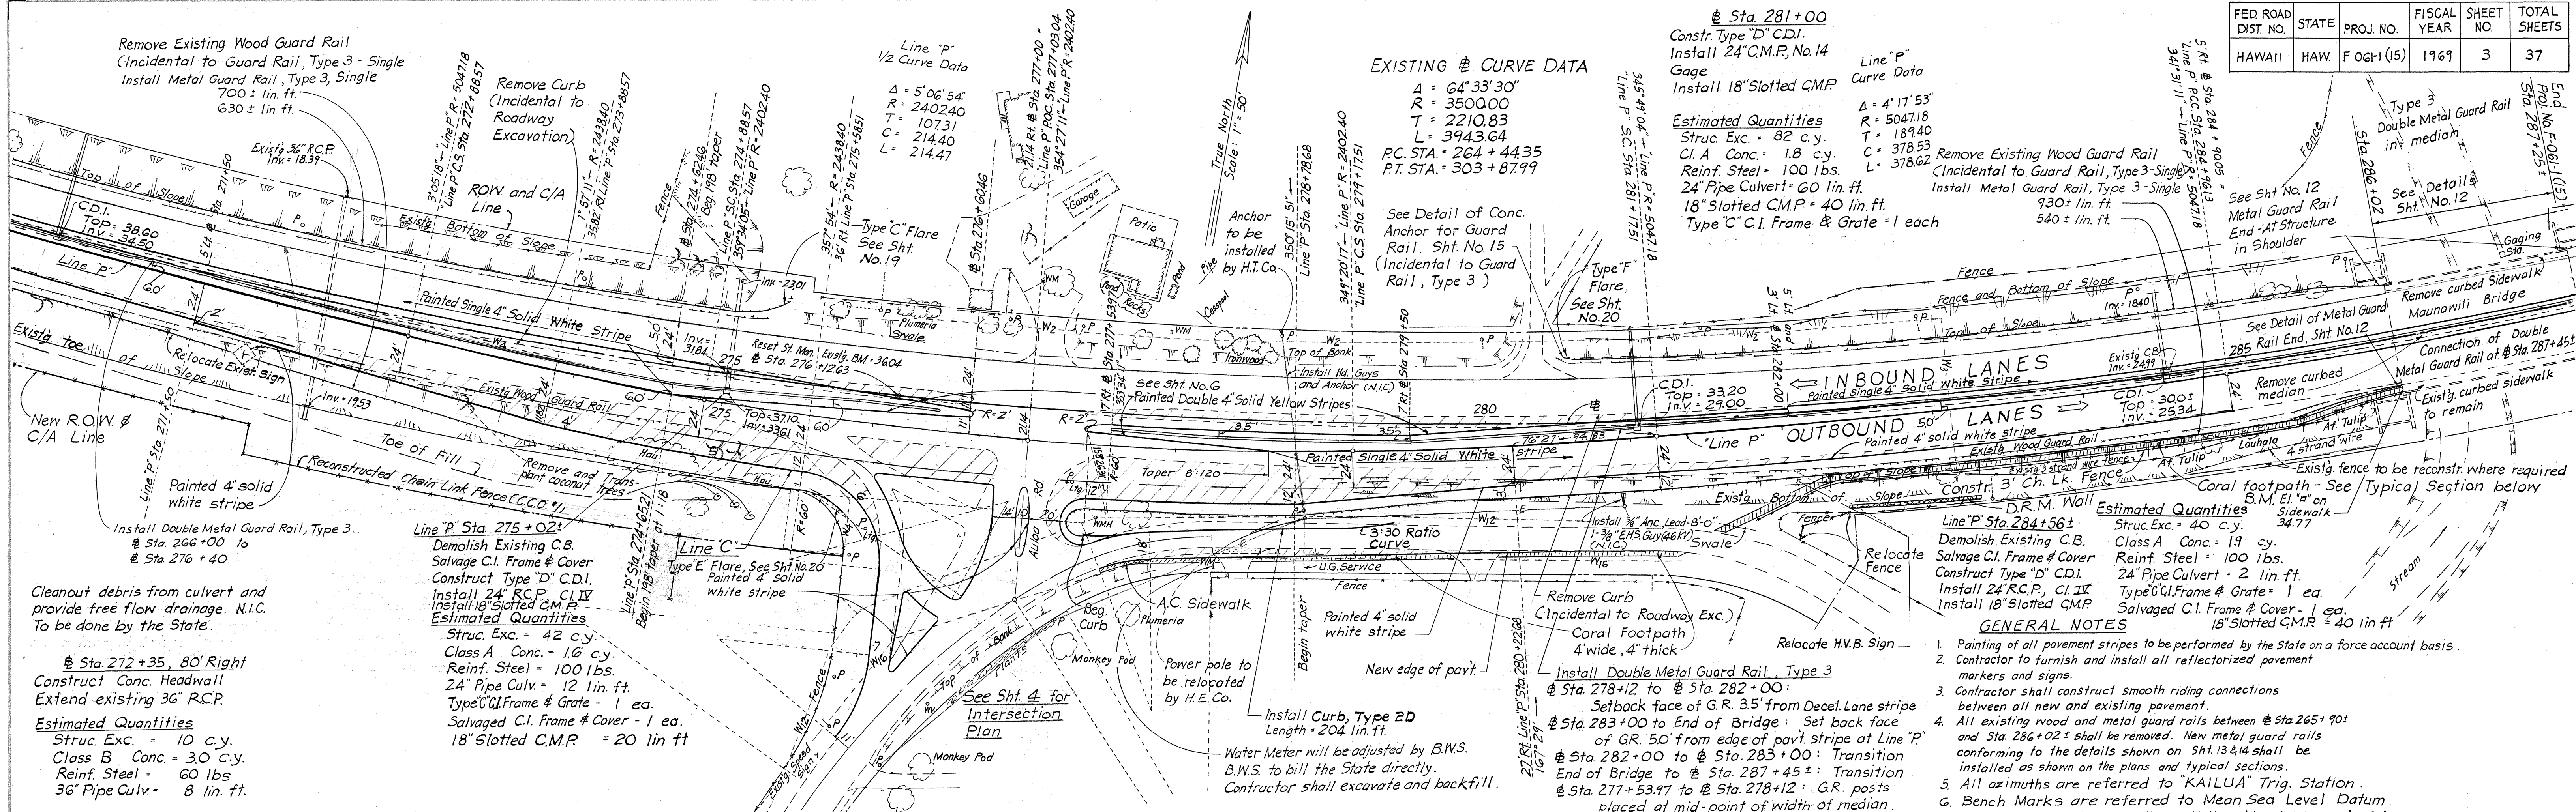

THIS WORK WAS PREPARED BY ME OR UNDER MY SUPERVISION.

John B. K. Sur