

STATE OF HAWAII

DEPARTMENT OF TRANSPORTATION

HIGHWAYS

DIVISION

HONOLULU, HAWAII

"AS BUILT"


PLAN FOR

INTERSECTION IMPROVEMENTS
ON KALANIANAOLE HIGHWAY
AT MAUNAWILI ROAD

FEDERAL AID PROJECT NO. F-061-1(15)

DISTRICT OF KOOLAUPOKO

ISLAND OF OAHU

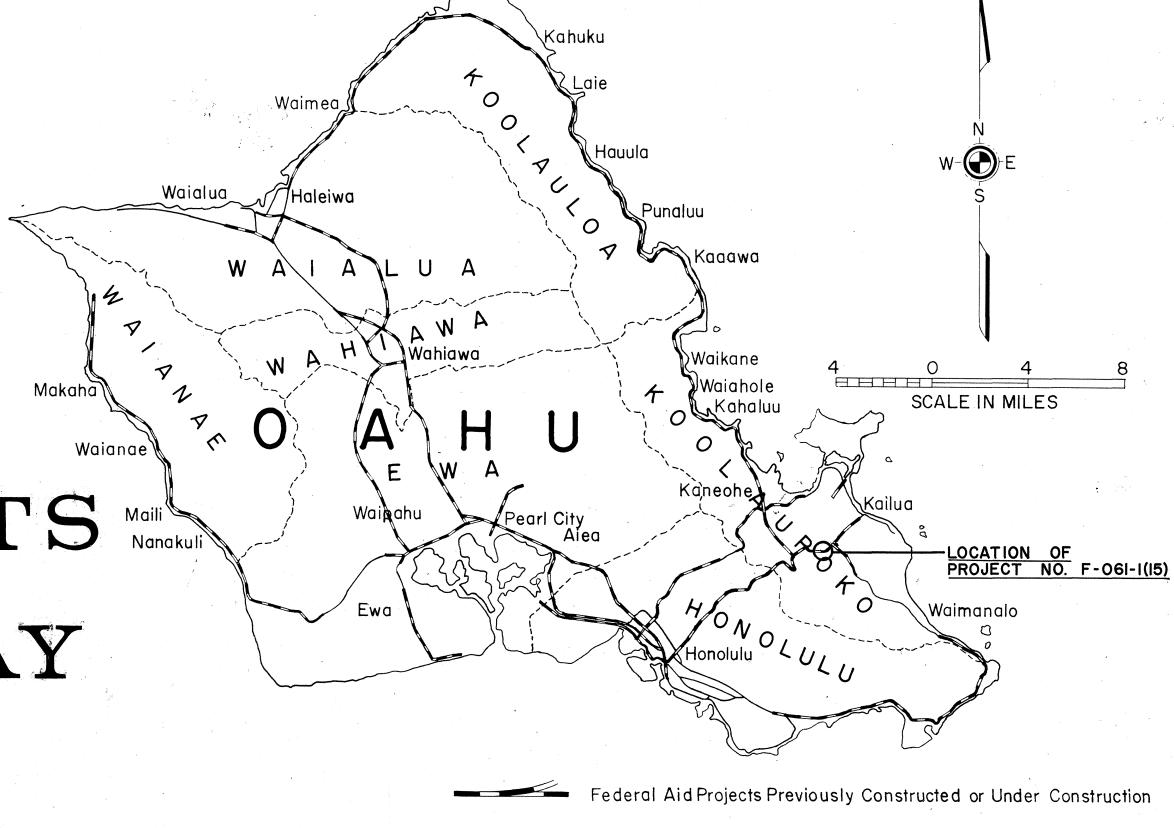

NOTE:

ALL CHANGES MADE DURING CONSTRUCTION
HAVE BEEN NOTED IN RED ON THESE TRACINGS
AND CHECKED BY


H.Hasuiko PROJECT ENGINEER

12/1/71 DATE

FED. AID FISCAL PROJ. NO.; YEAR

HAW. F-061-1(15) 1969

SHEET TOTAL NO. SHEETS

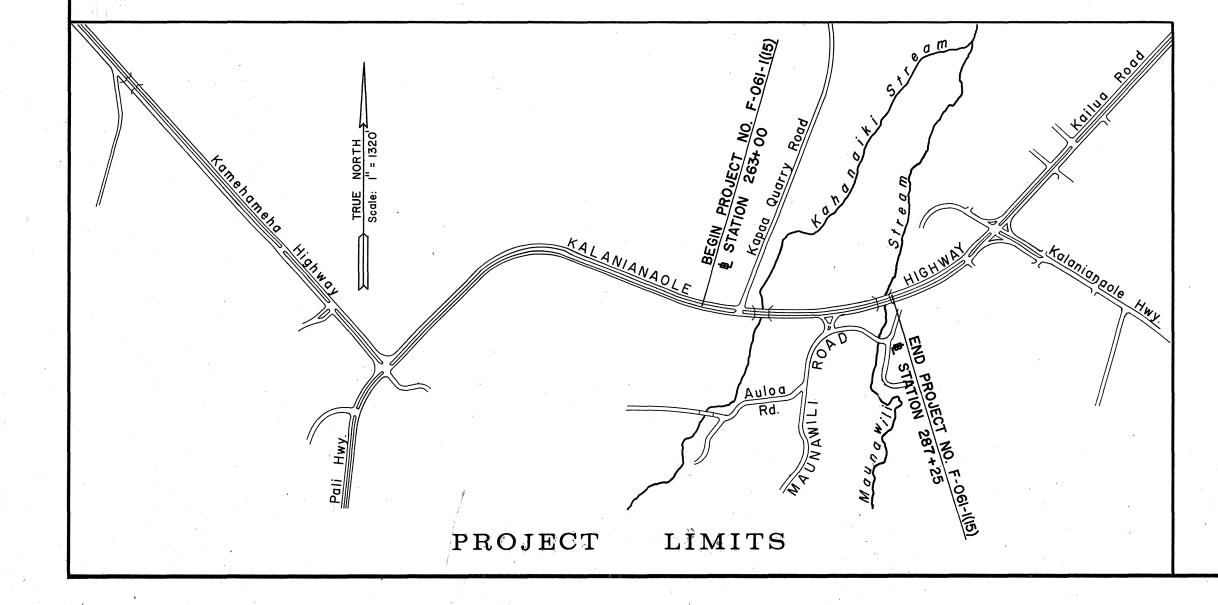

GROSS LENGTH OF PROJECT 0.459 MI.

LESS BRIDGES OVER 20'-0" SPAN 0.044 MI.

NET LENGTH OF ROADWAY 0.415 MI.



U. S. DEPARTMENT OF TRANSPORTATION
BUREAU OF PUBLIC ROADS

APPROVED:

S/5/70

FOR DIVISION ENGINEER DATE

 DESIGN ADT (1988)
 23,460

 DHV
 12 %

 D
 80/20

 T
 1.0 %

 T₂₄
 2.5 %

 V
 50 MPH

DESIGN CLASSIFICATION

DEPARTMENT OF TRANSPORTATION
STATE OF HAWAII

APPROVED:

G. Olivey William 1/28/70

DIR. OF TRANSPORTATION DATE

4