


FED. ROAD DIST. NO.	STATE	PROJ. NO.	FISCAL YEAR	SHEET NO.	TOTAL SHEETS
HAWAII	HAW.	61D-01-71	1971	35	6

FINAL SURVEY	BY	DATE	SURVEYED
			4/13/71
NOTE BOOK	BY	DATE	PLOTTED
			4/13/71
NO.	BY	DATE	TEMPLATE
			4/13/71
			AREAS
			CHECKED

ORIGINAL SURVEY	SURVEYED	BY	DATE
	PLOTTED		
	TEMPLETE		
	AREAS		
NOTE BOOK			
NO.	AREAS CHECKED		

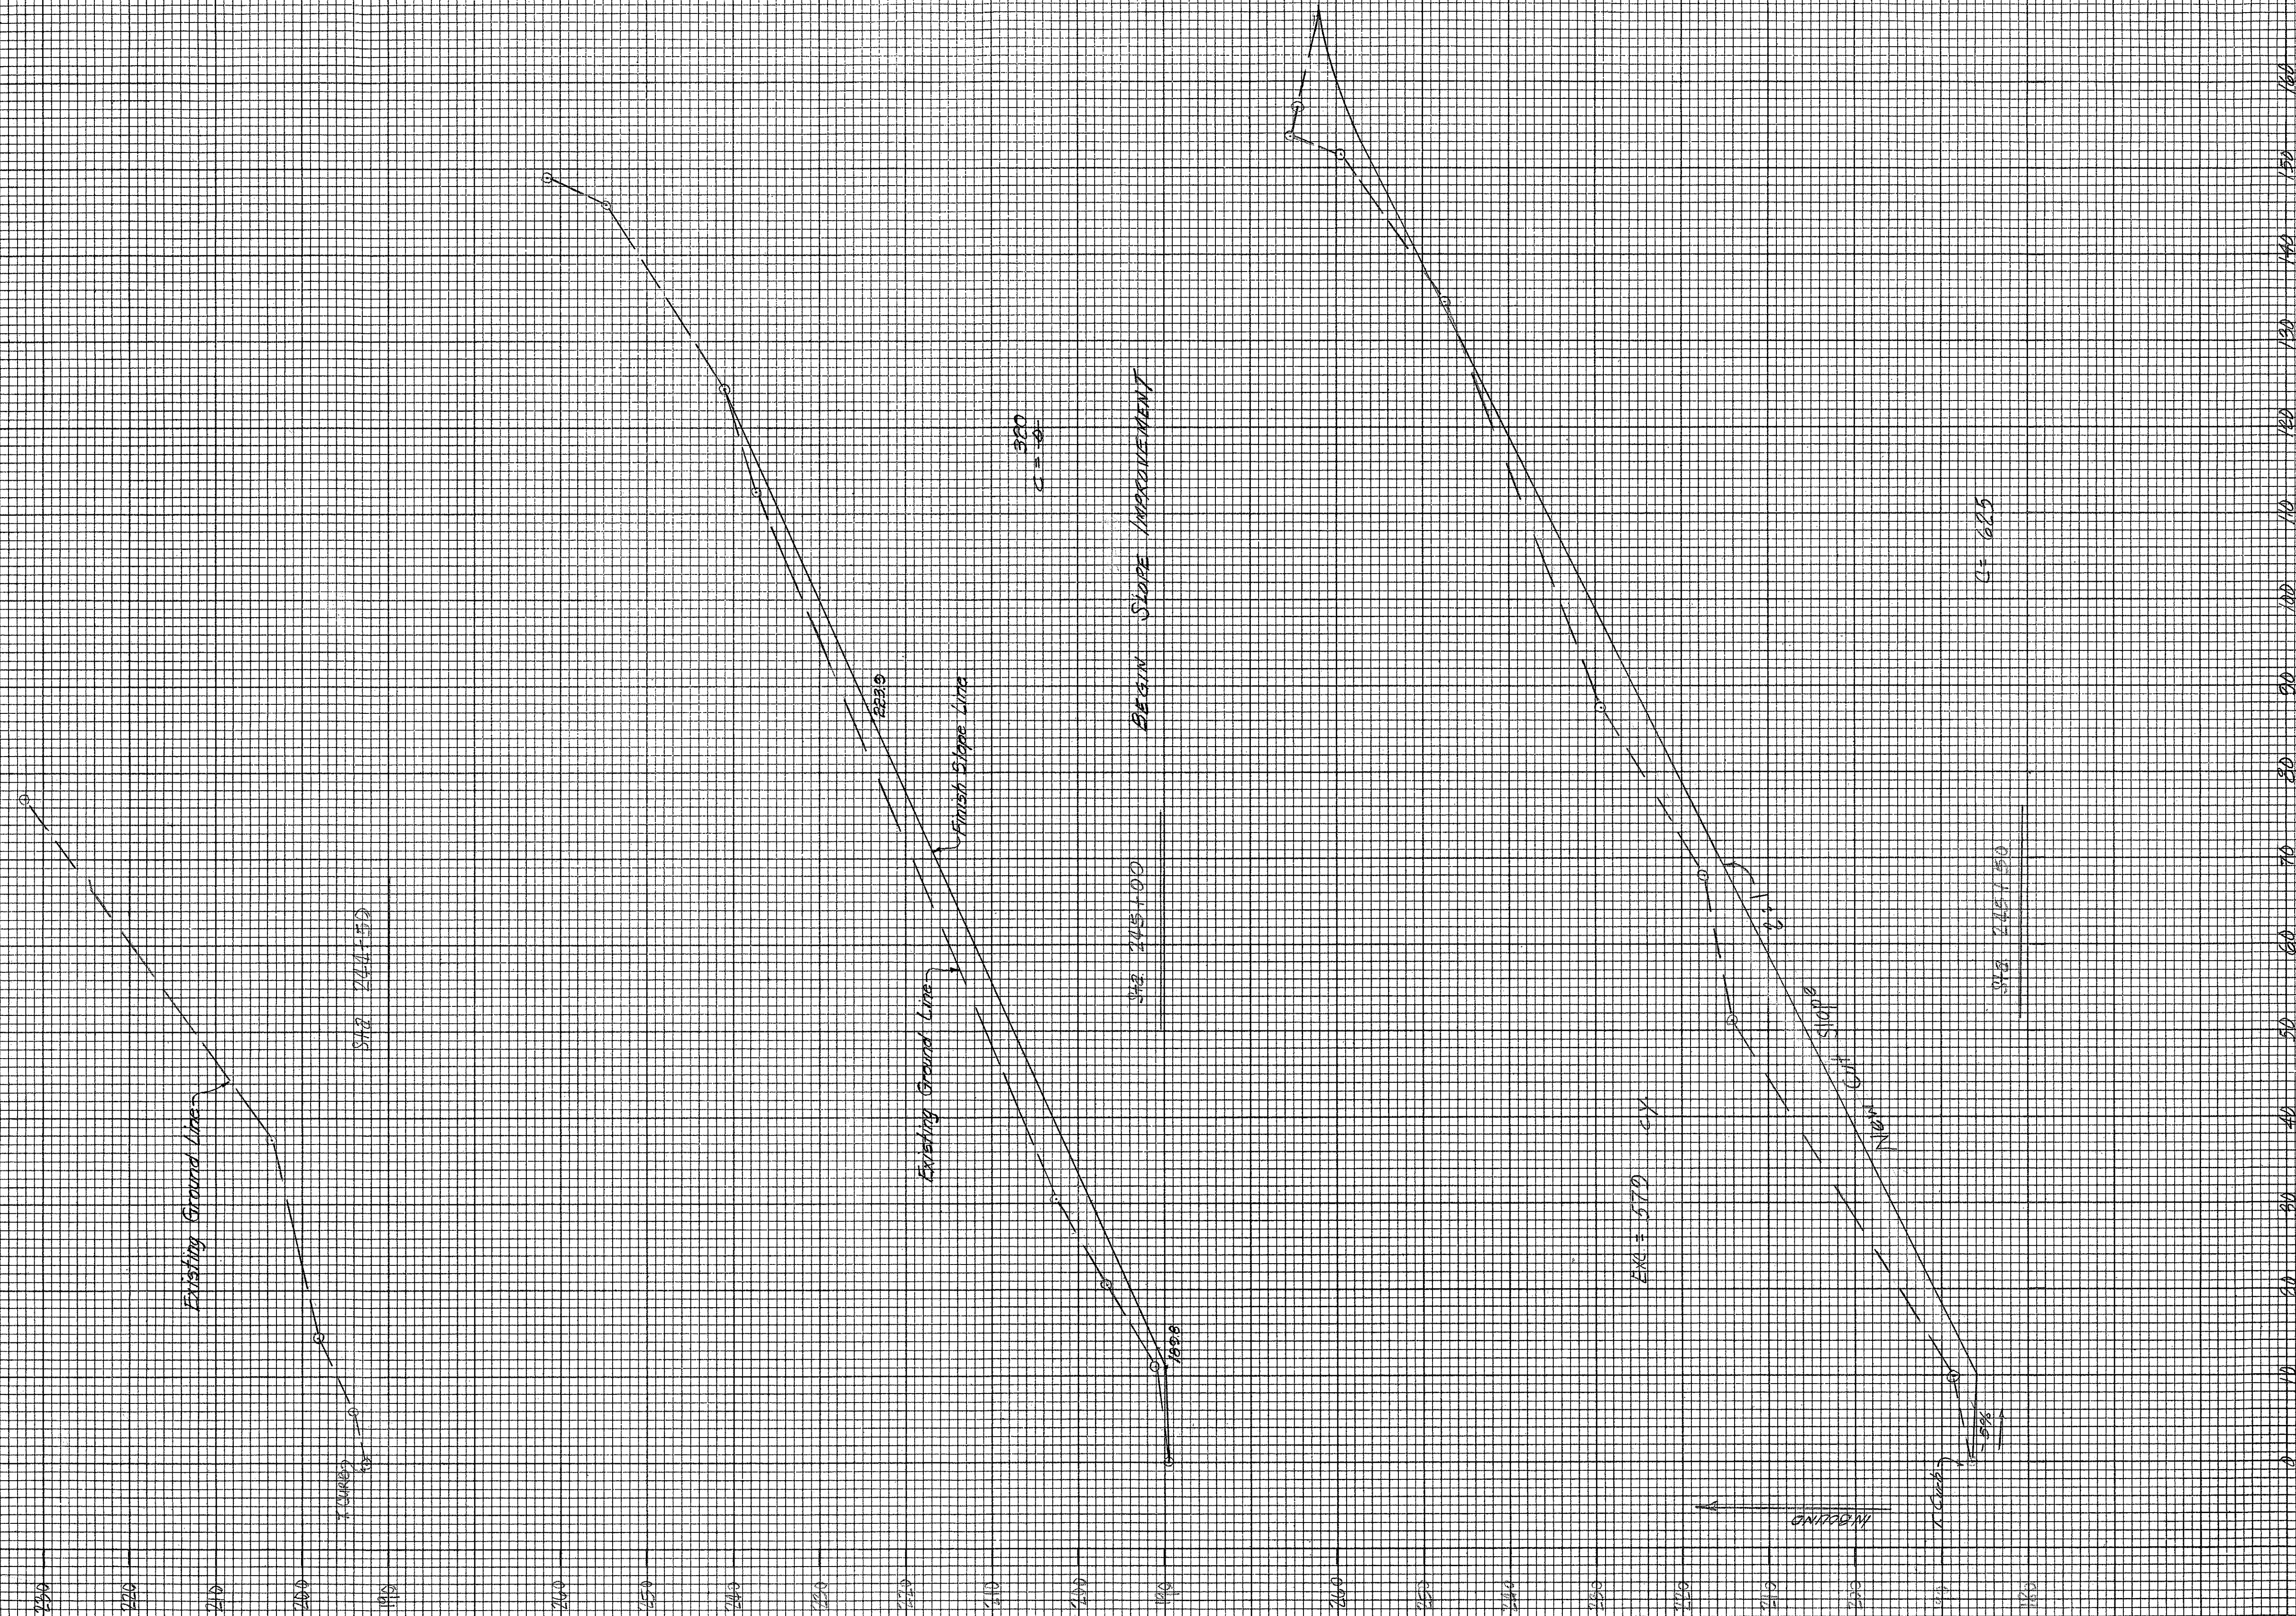


Note: Sections are shown looking toward decreasing stations.

THIS SHEET IS A SUPPLEMENT TO
THE CONTRACT PLANS, CROSS-SECTIONS
TAKEN AFTER AWARD OF CONTRACT.

FINAL SURVEY	SURVEYED	BY	DATE
	PLANNED		
	NOTE BOOK		
	NO.		

ORIGINAL SURVEY	SURVEYED	BY	DATE
	PLANNED		
	NOTE BOOK		
	NO.		

FED. ROAD DIST. NO.	STATE	PROJ. NO.	FISCAL YEAR	SHEET NO.	TOTAL SHEETS
HAWAII	HAW.	610-01-71	1971	45	6

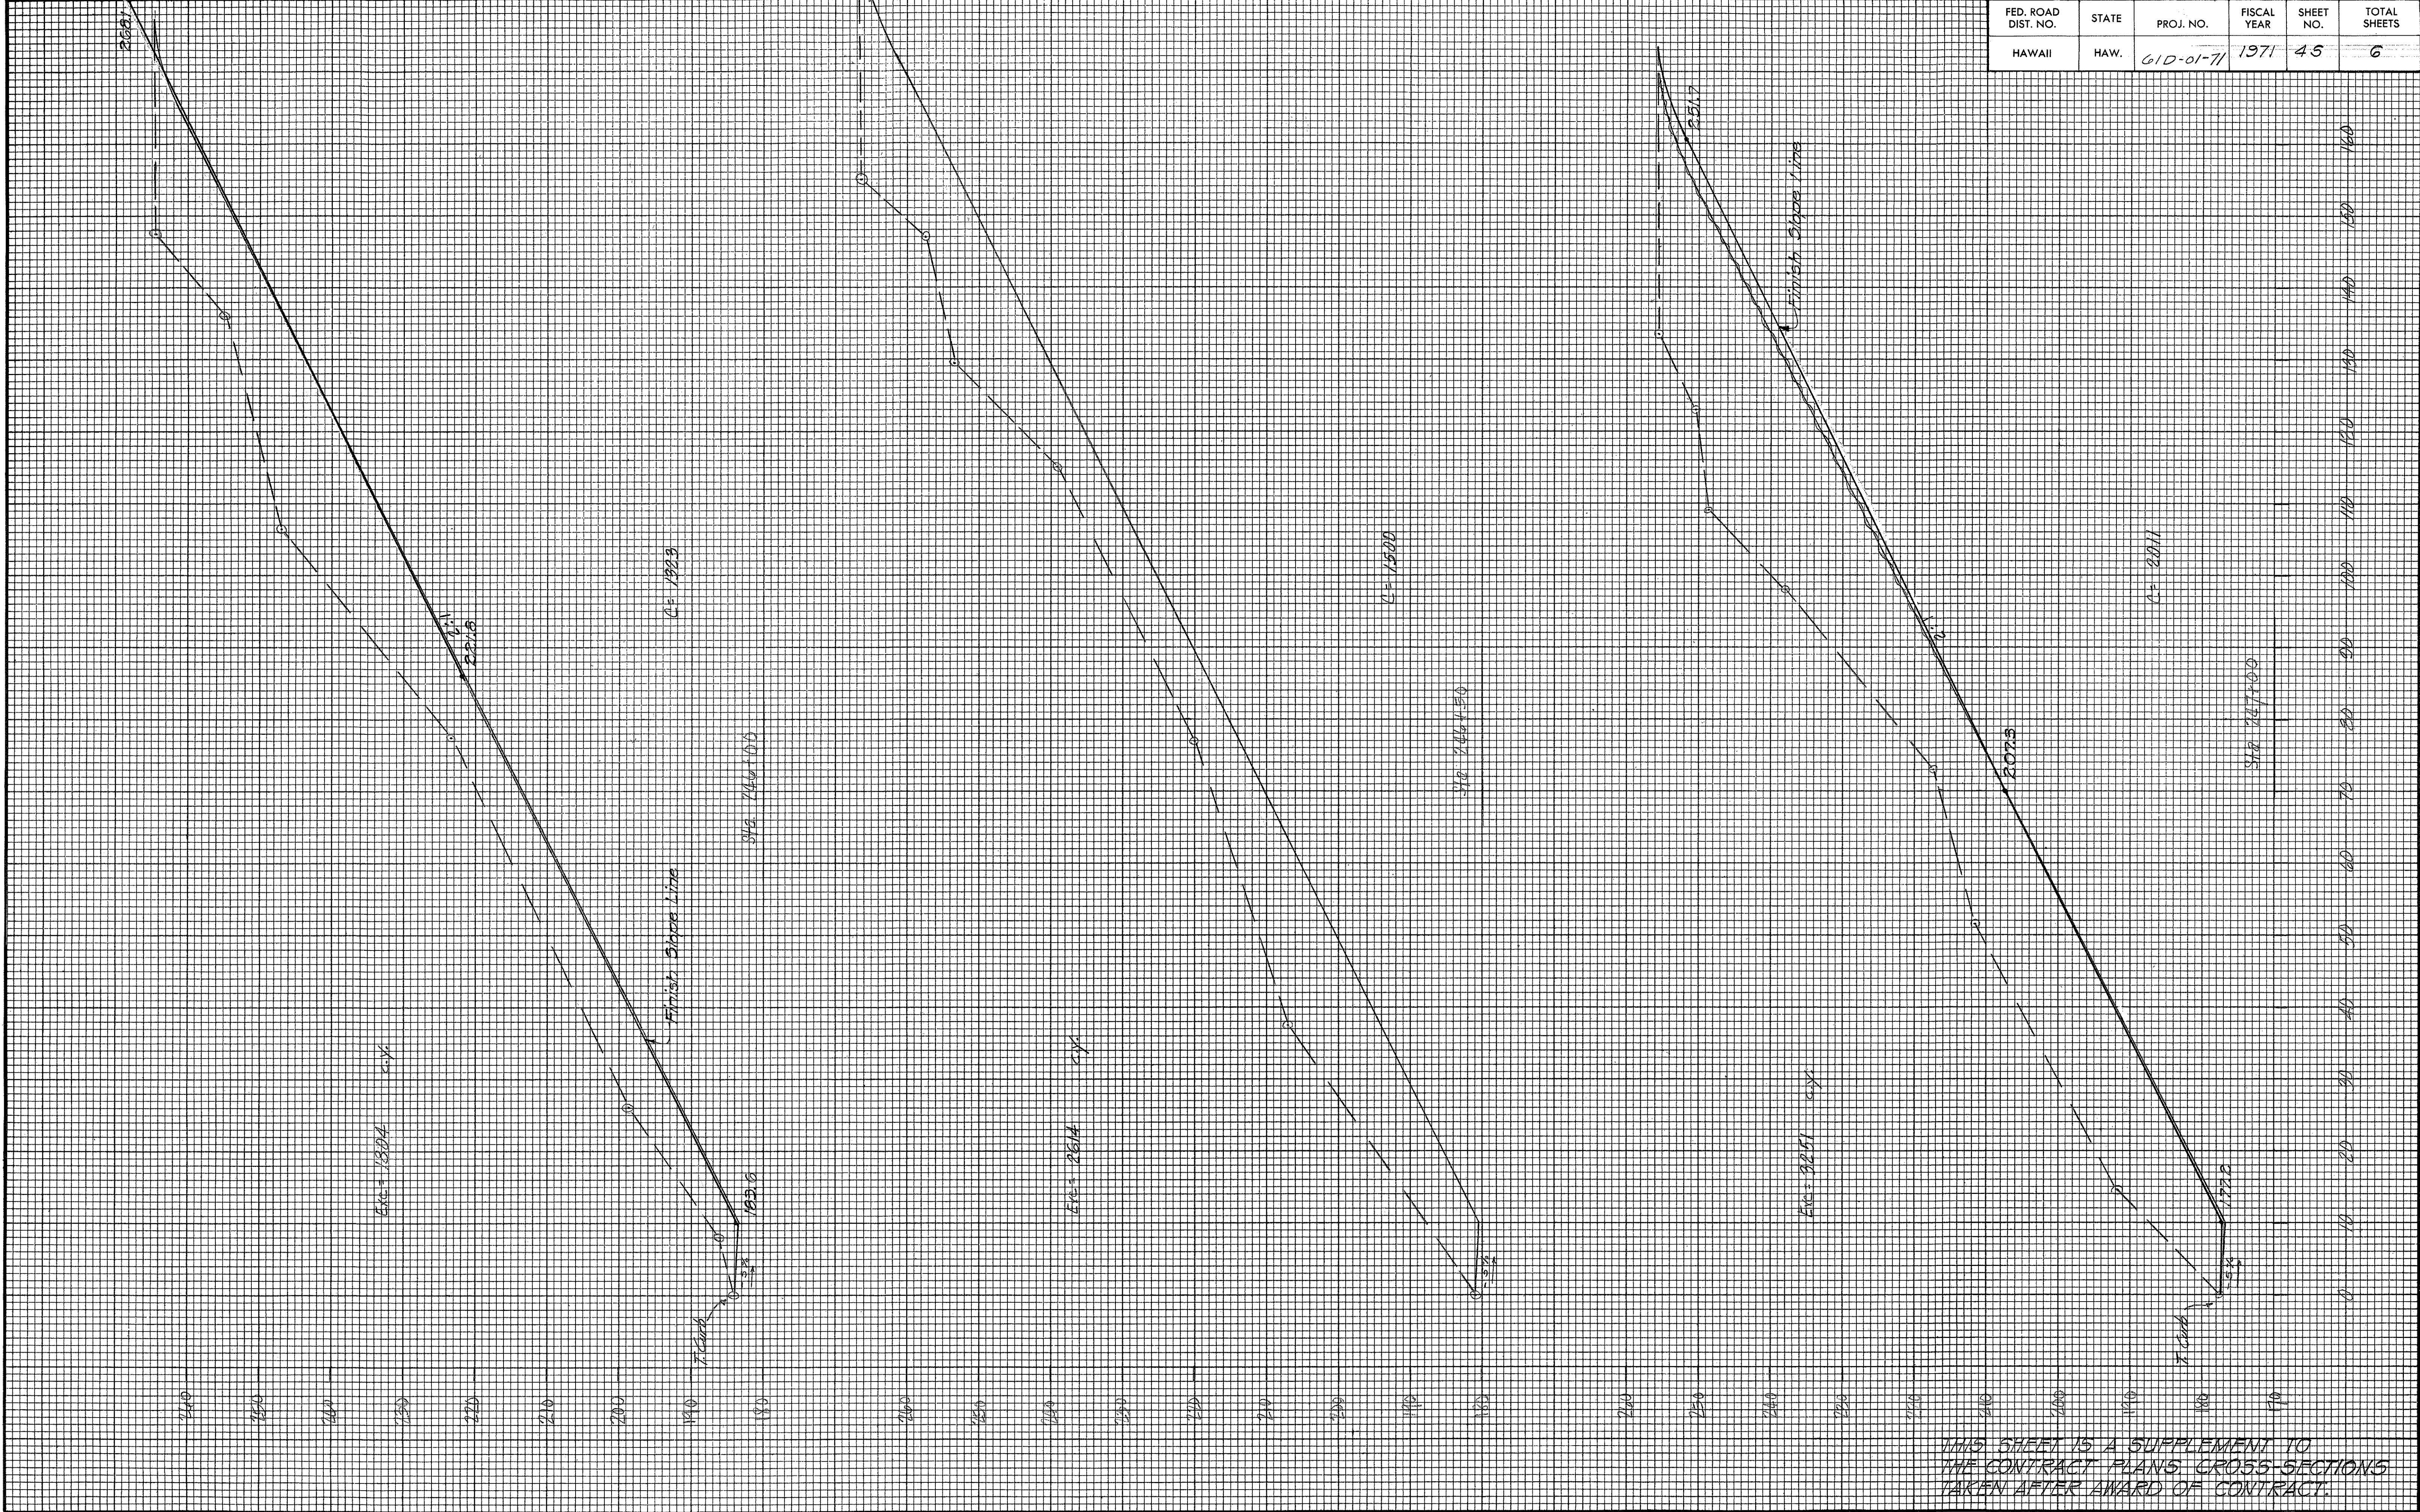

THIS SHEET IS A SUPPLEMENT TO
THE CONTRACT PLANS. CROSS SECTIONS
TAKEN AFTER AWARD OF CONTRACT.

FED. ROAD DIST. NO.	STATE	PROJ. NO.	FISCAL YEAR	SHEET NO.	TOTAL SHEETS
HAWAII	HAW.	61D-01-71	1971	55	6

FINAL SURVEY

NOTE BOOK NO.

DATE

BY

REVISIONS

REVISIONS

REVISIONS

REVISIONS

ORIGINAL SURVEY

NOTE BOOK NO.

DATE


BY

REVISIONS

REVISIONS

REVISIONS

REVISIONS

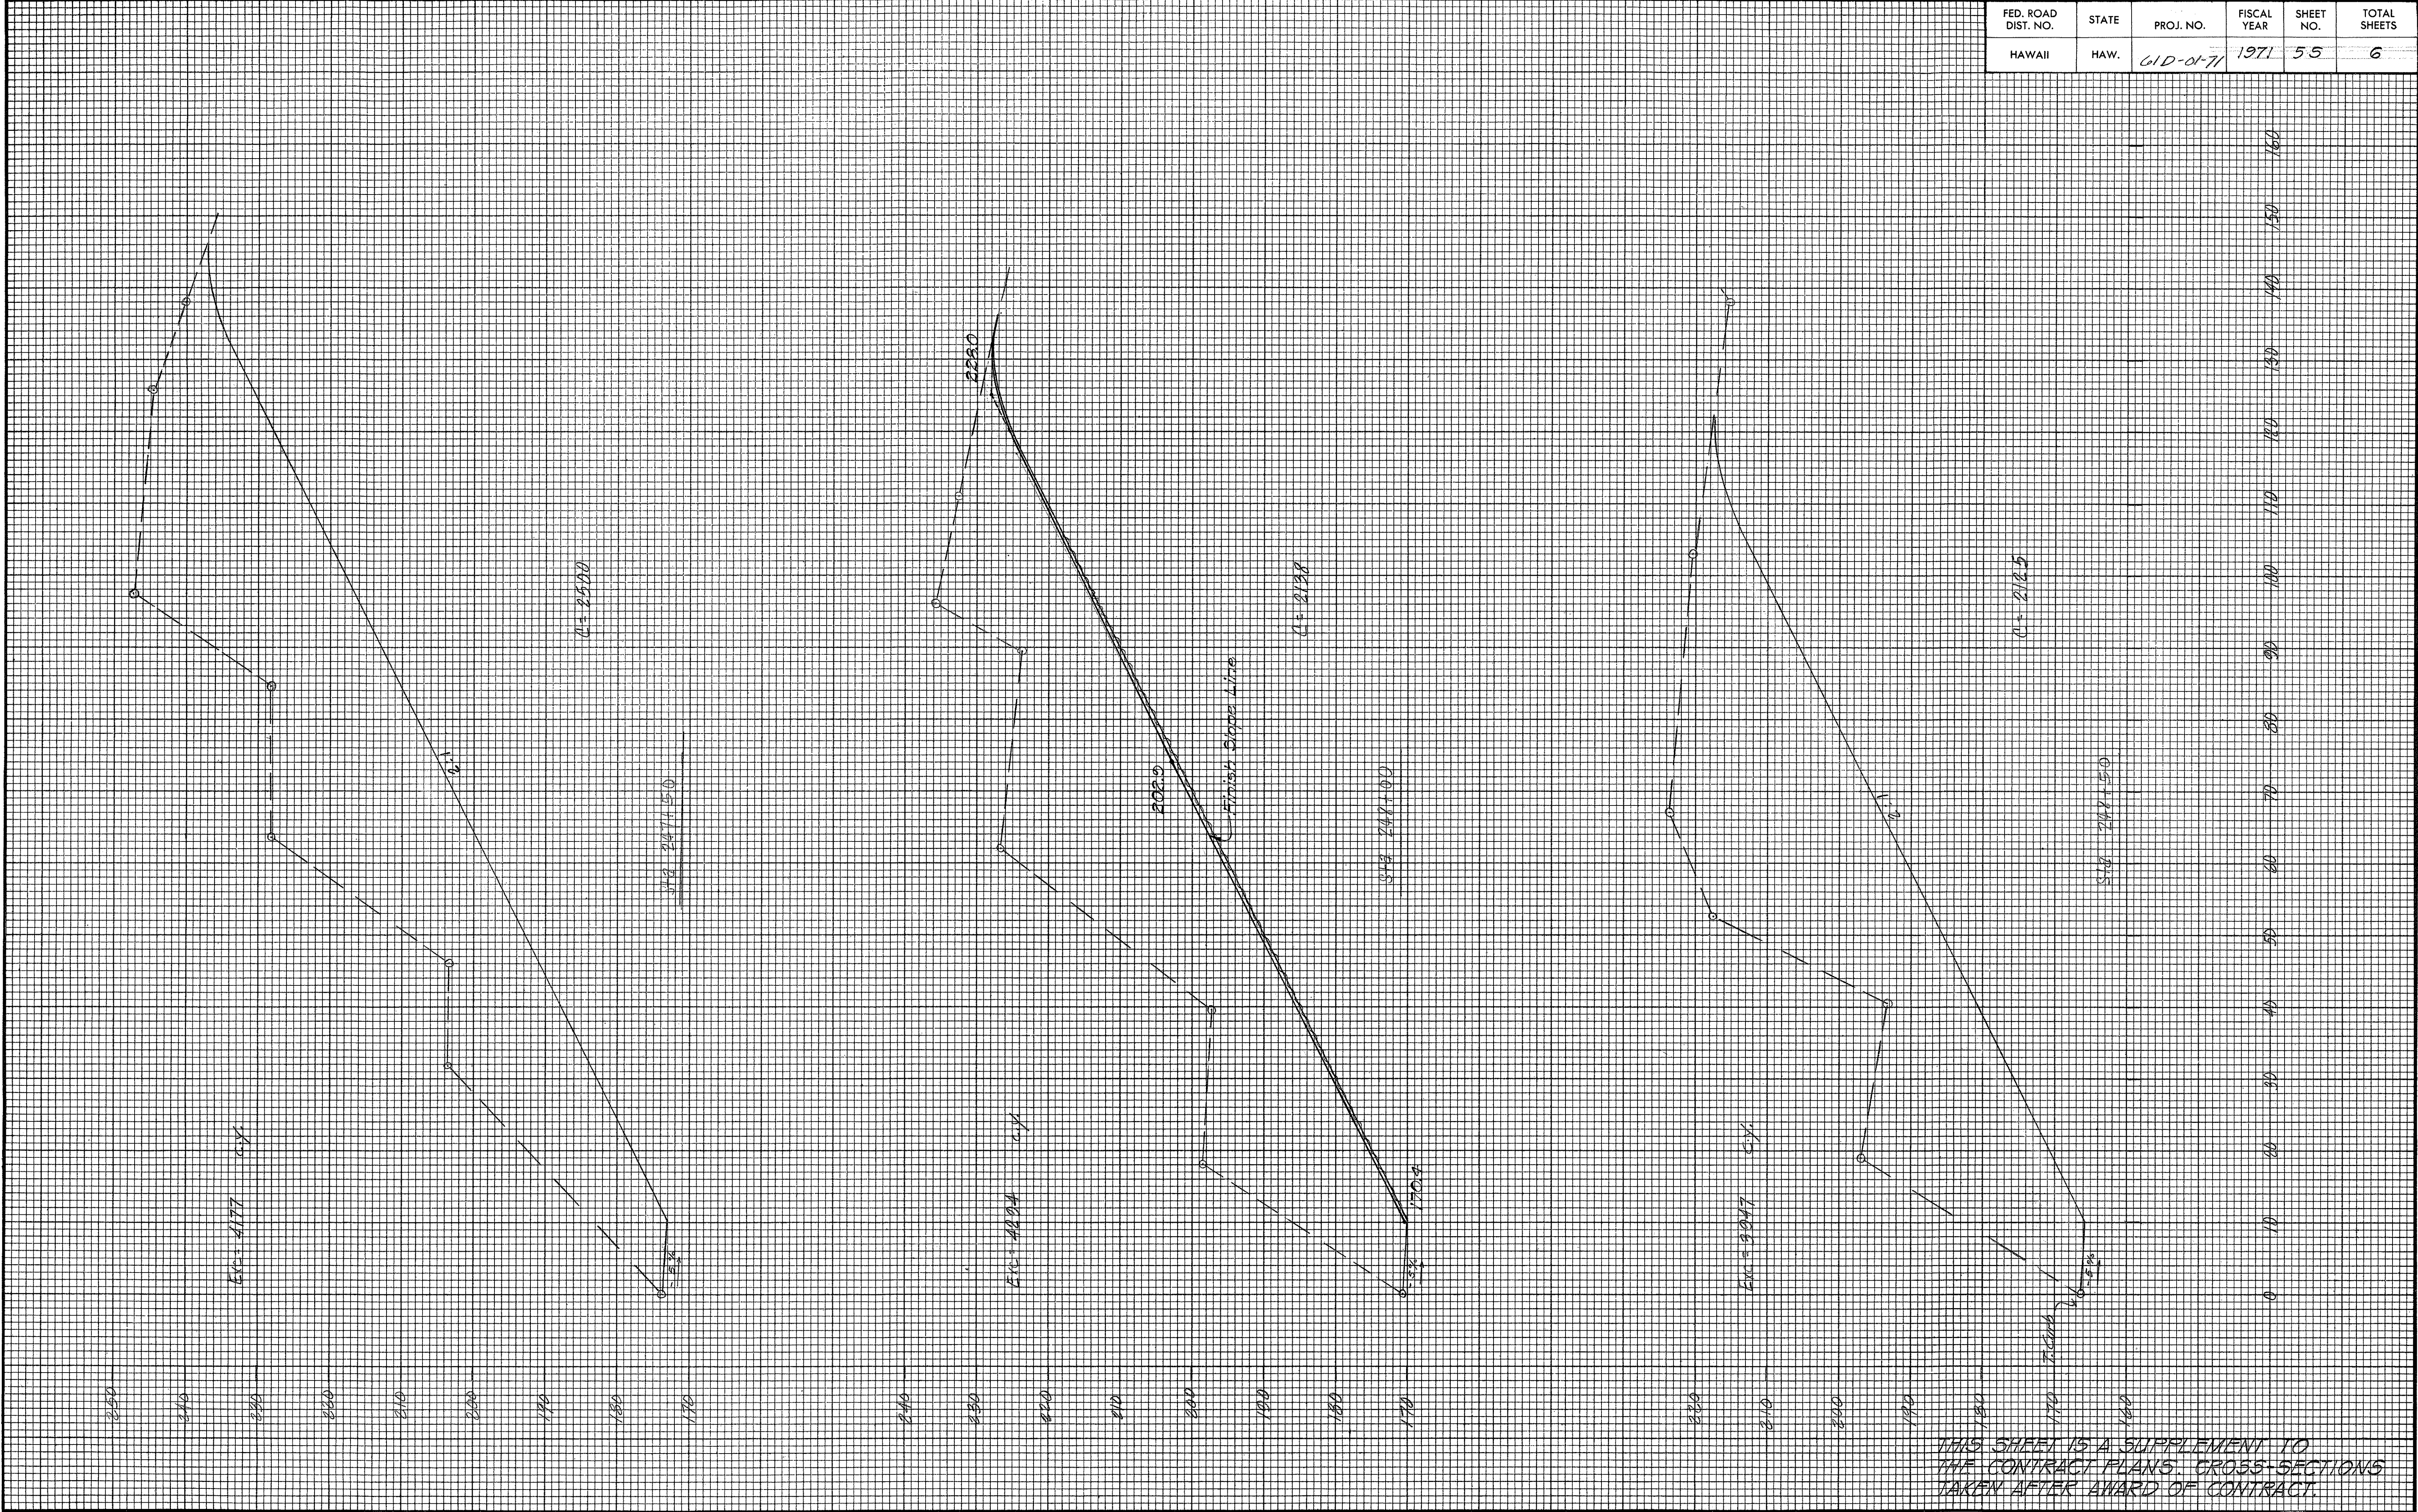

55

