

INDEX TO DRAWINGS	
SHEET NO.	DESCRIPTION
1	TITLE SHEET
2	PROJ. INFORMATION SIGN
3S - 6S	CROSS-SECTIONS


FED. ROAD DIST. NO.	STATE	PROJ. NO.	FISCAL YEAR	SHEET NO.	TOTAL SHEETS
HAWAII	HAW.	61D-01-71	1971	1	62

STATE OF HAWAII
DEPARTMENT OF TRANSPORTATION
HIGHWAYS DIVISION
HONOLULU, HAWAII
"AS-BUILT"
PLANS FOR

SLOPE IMPROVEMENT ALONG
KALANIANA'OLE HIGHWAY
245 + 50
(STA. ~~244 + 00~~ TO STA. 250 + 00 ±)



PROJECT NO. 61D-01-71

DISTRICT OF KOOLAUPOKO
ISLAND OF OAHU

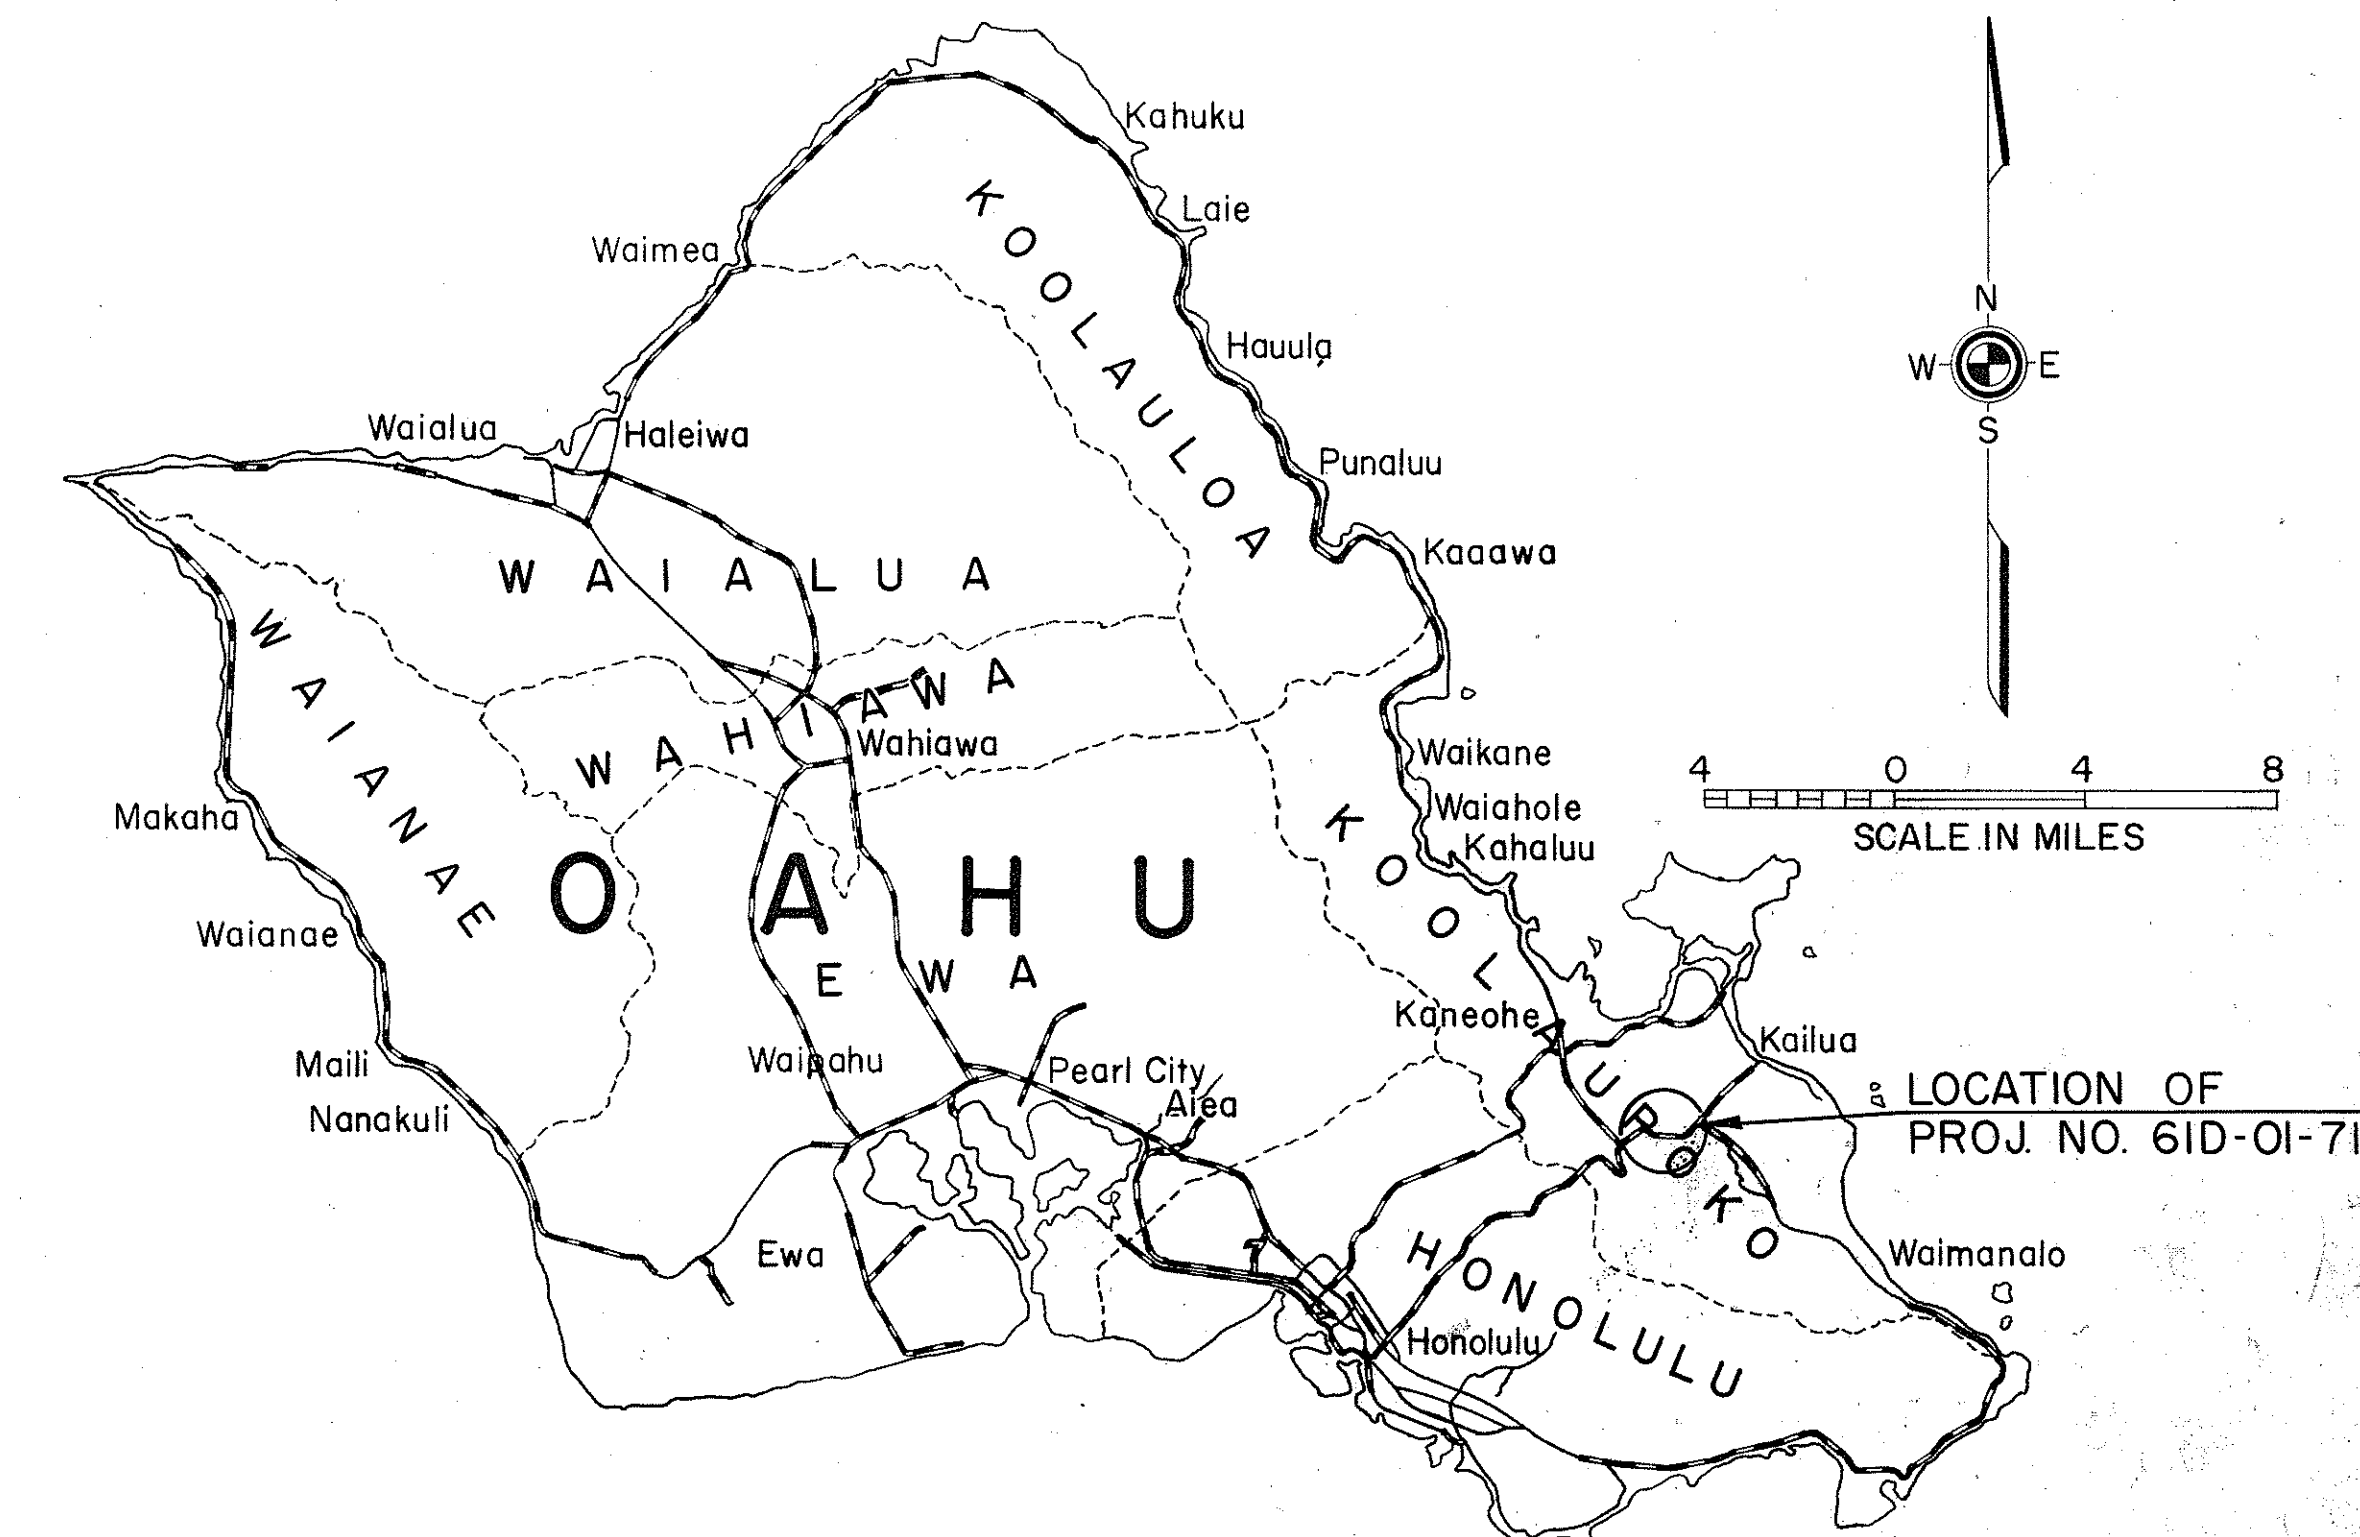

Start of work:
Grading shall start from the top
of the new cut slope and progress
toward the toe of the new cut slope.

— Federal Aid Projects Previously Constructed or Under Construction

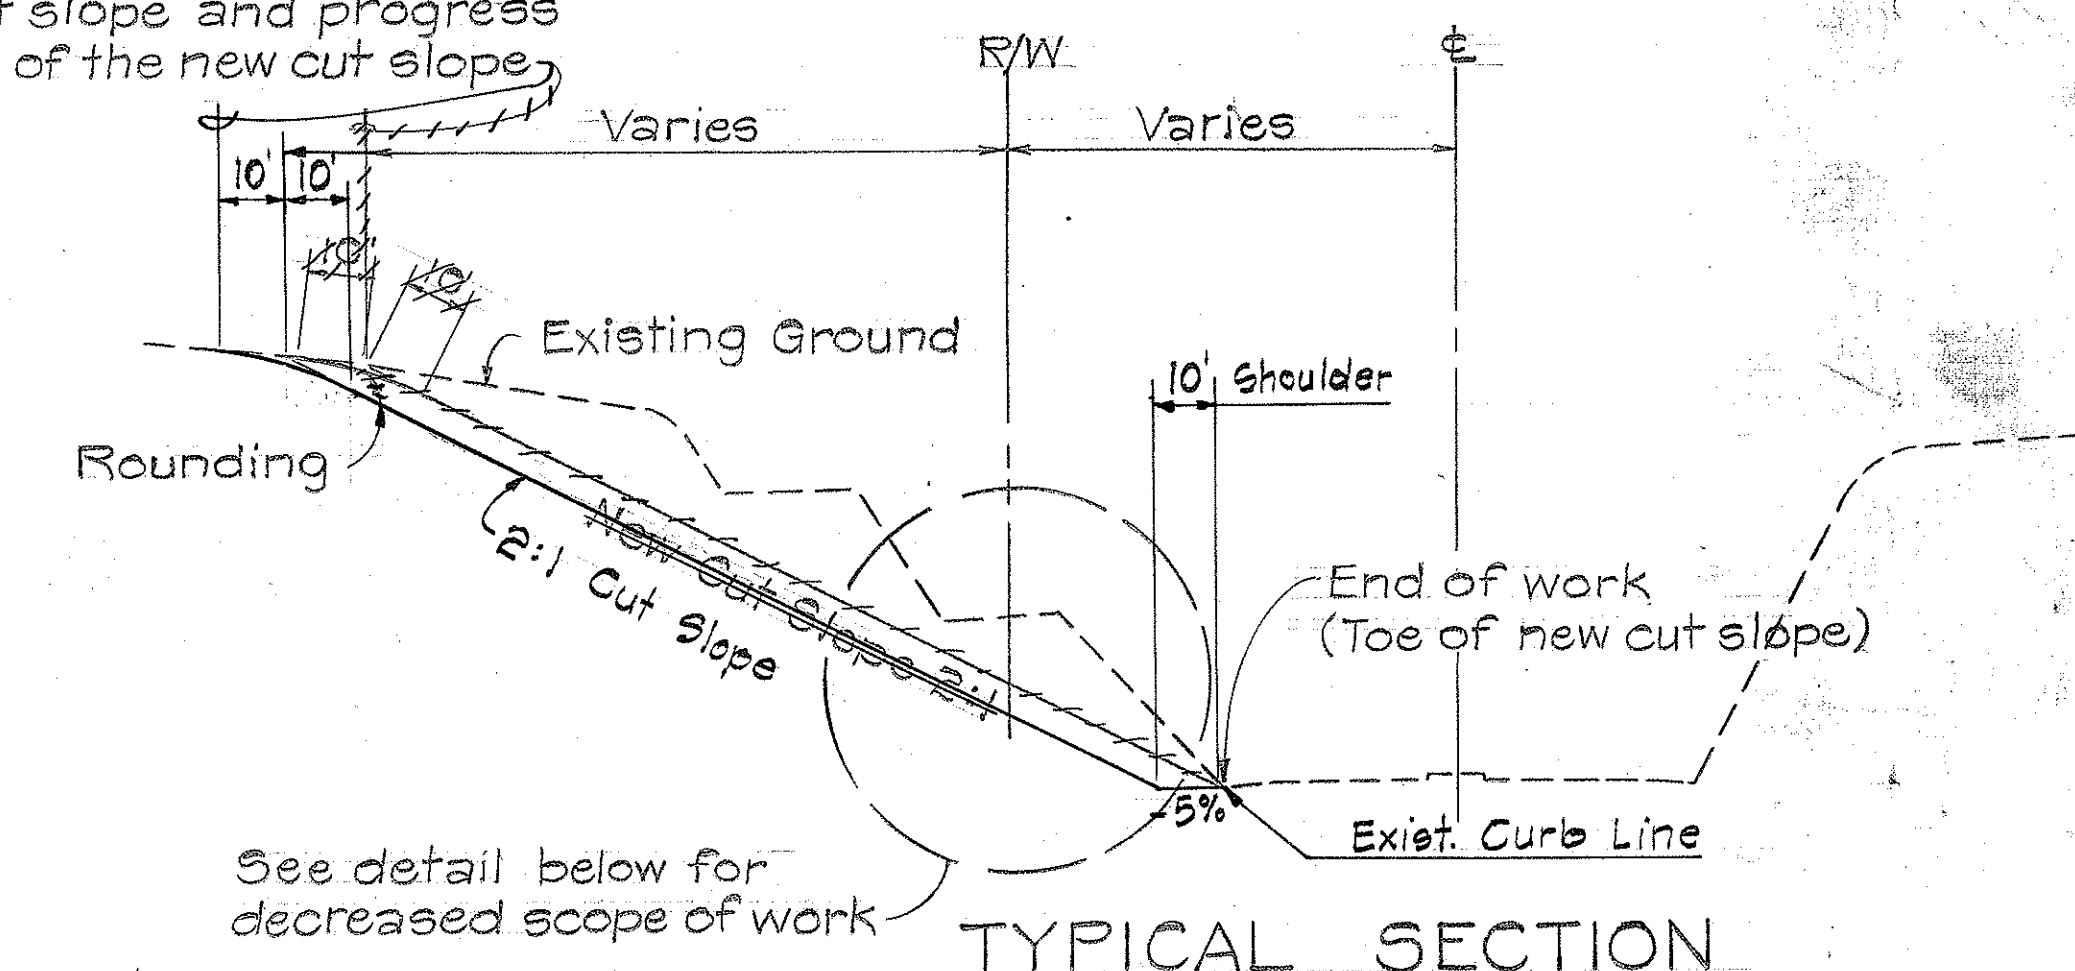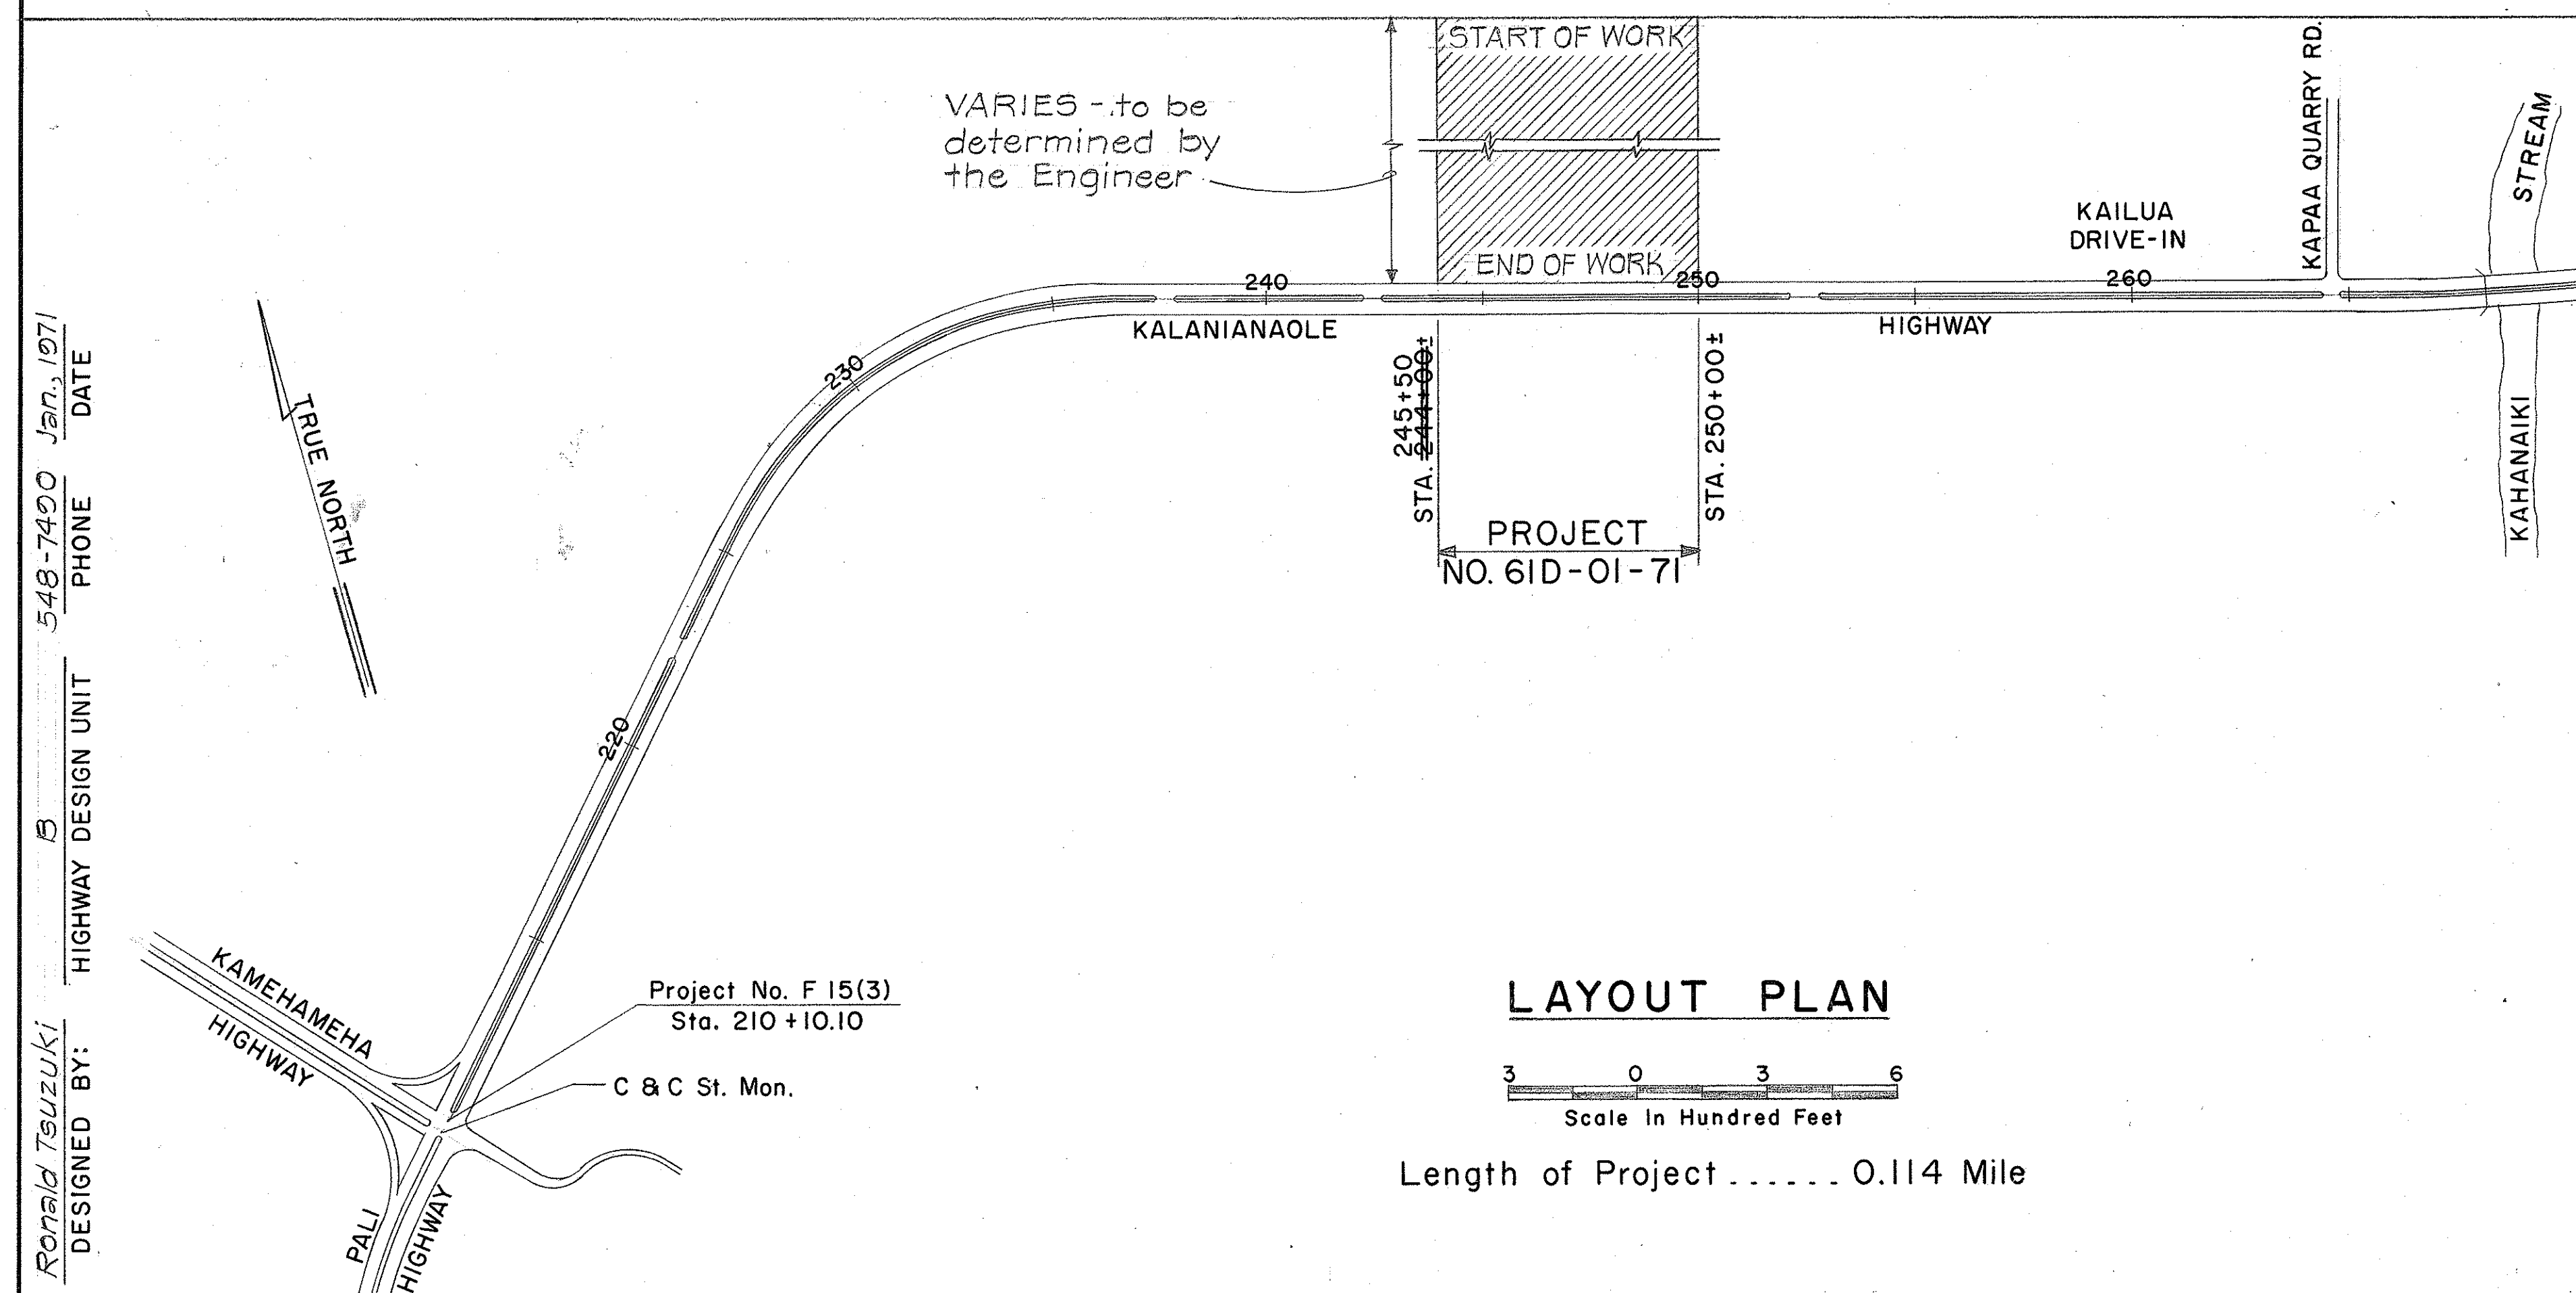


TYPICAL SECTION

Scale: Horiz. 1"=30'
Vert. 1"=30'

NOTE:
ALL CHANGES MADE DURING CONSTRUCTION
HAVE BEEN NOTED IN RED ON THESE
TRACINGS AND CHECKED BY:

[Signature]
PROJECT ENGINEER
1-10-72
DATE

DEPARTMENT OF TRANSPORTATION
STATE OF HAWAII
APPROVED:
[Signature]
DIR. OF TRANSPORTATION DATE

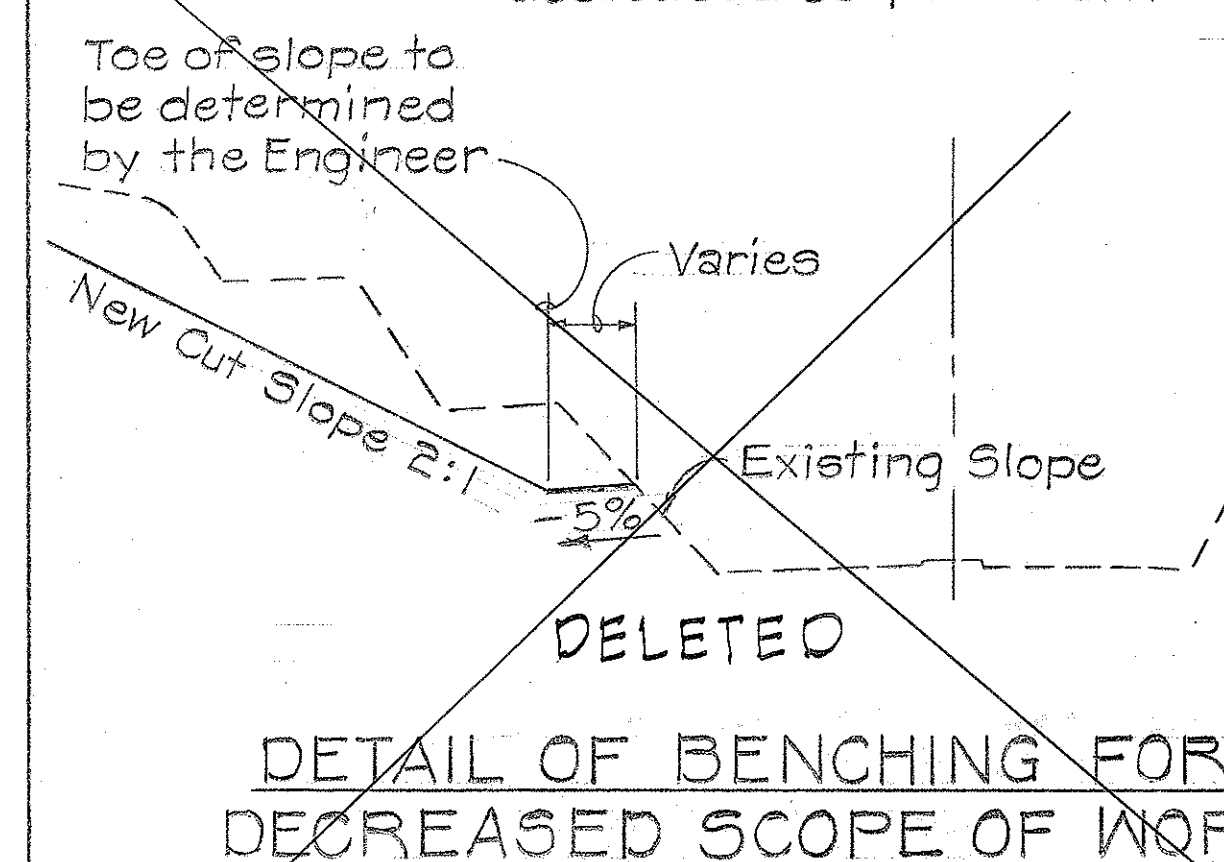

DETAIL OF BENCHING FOR
DECREASED SCOPE OF WORK

LAYOUT PLAN

Scale In Hundred Feet

Length of Project 0.114 Mile

DESIGNED BY: *Ronald Tsuzuki*
HIGHWAY DESIGN UNIT
548-7420 Jan., 1971
DATE