
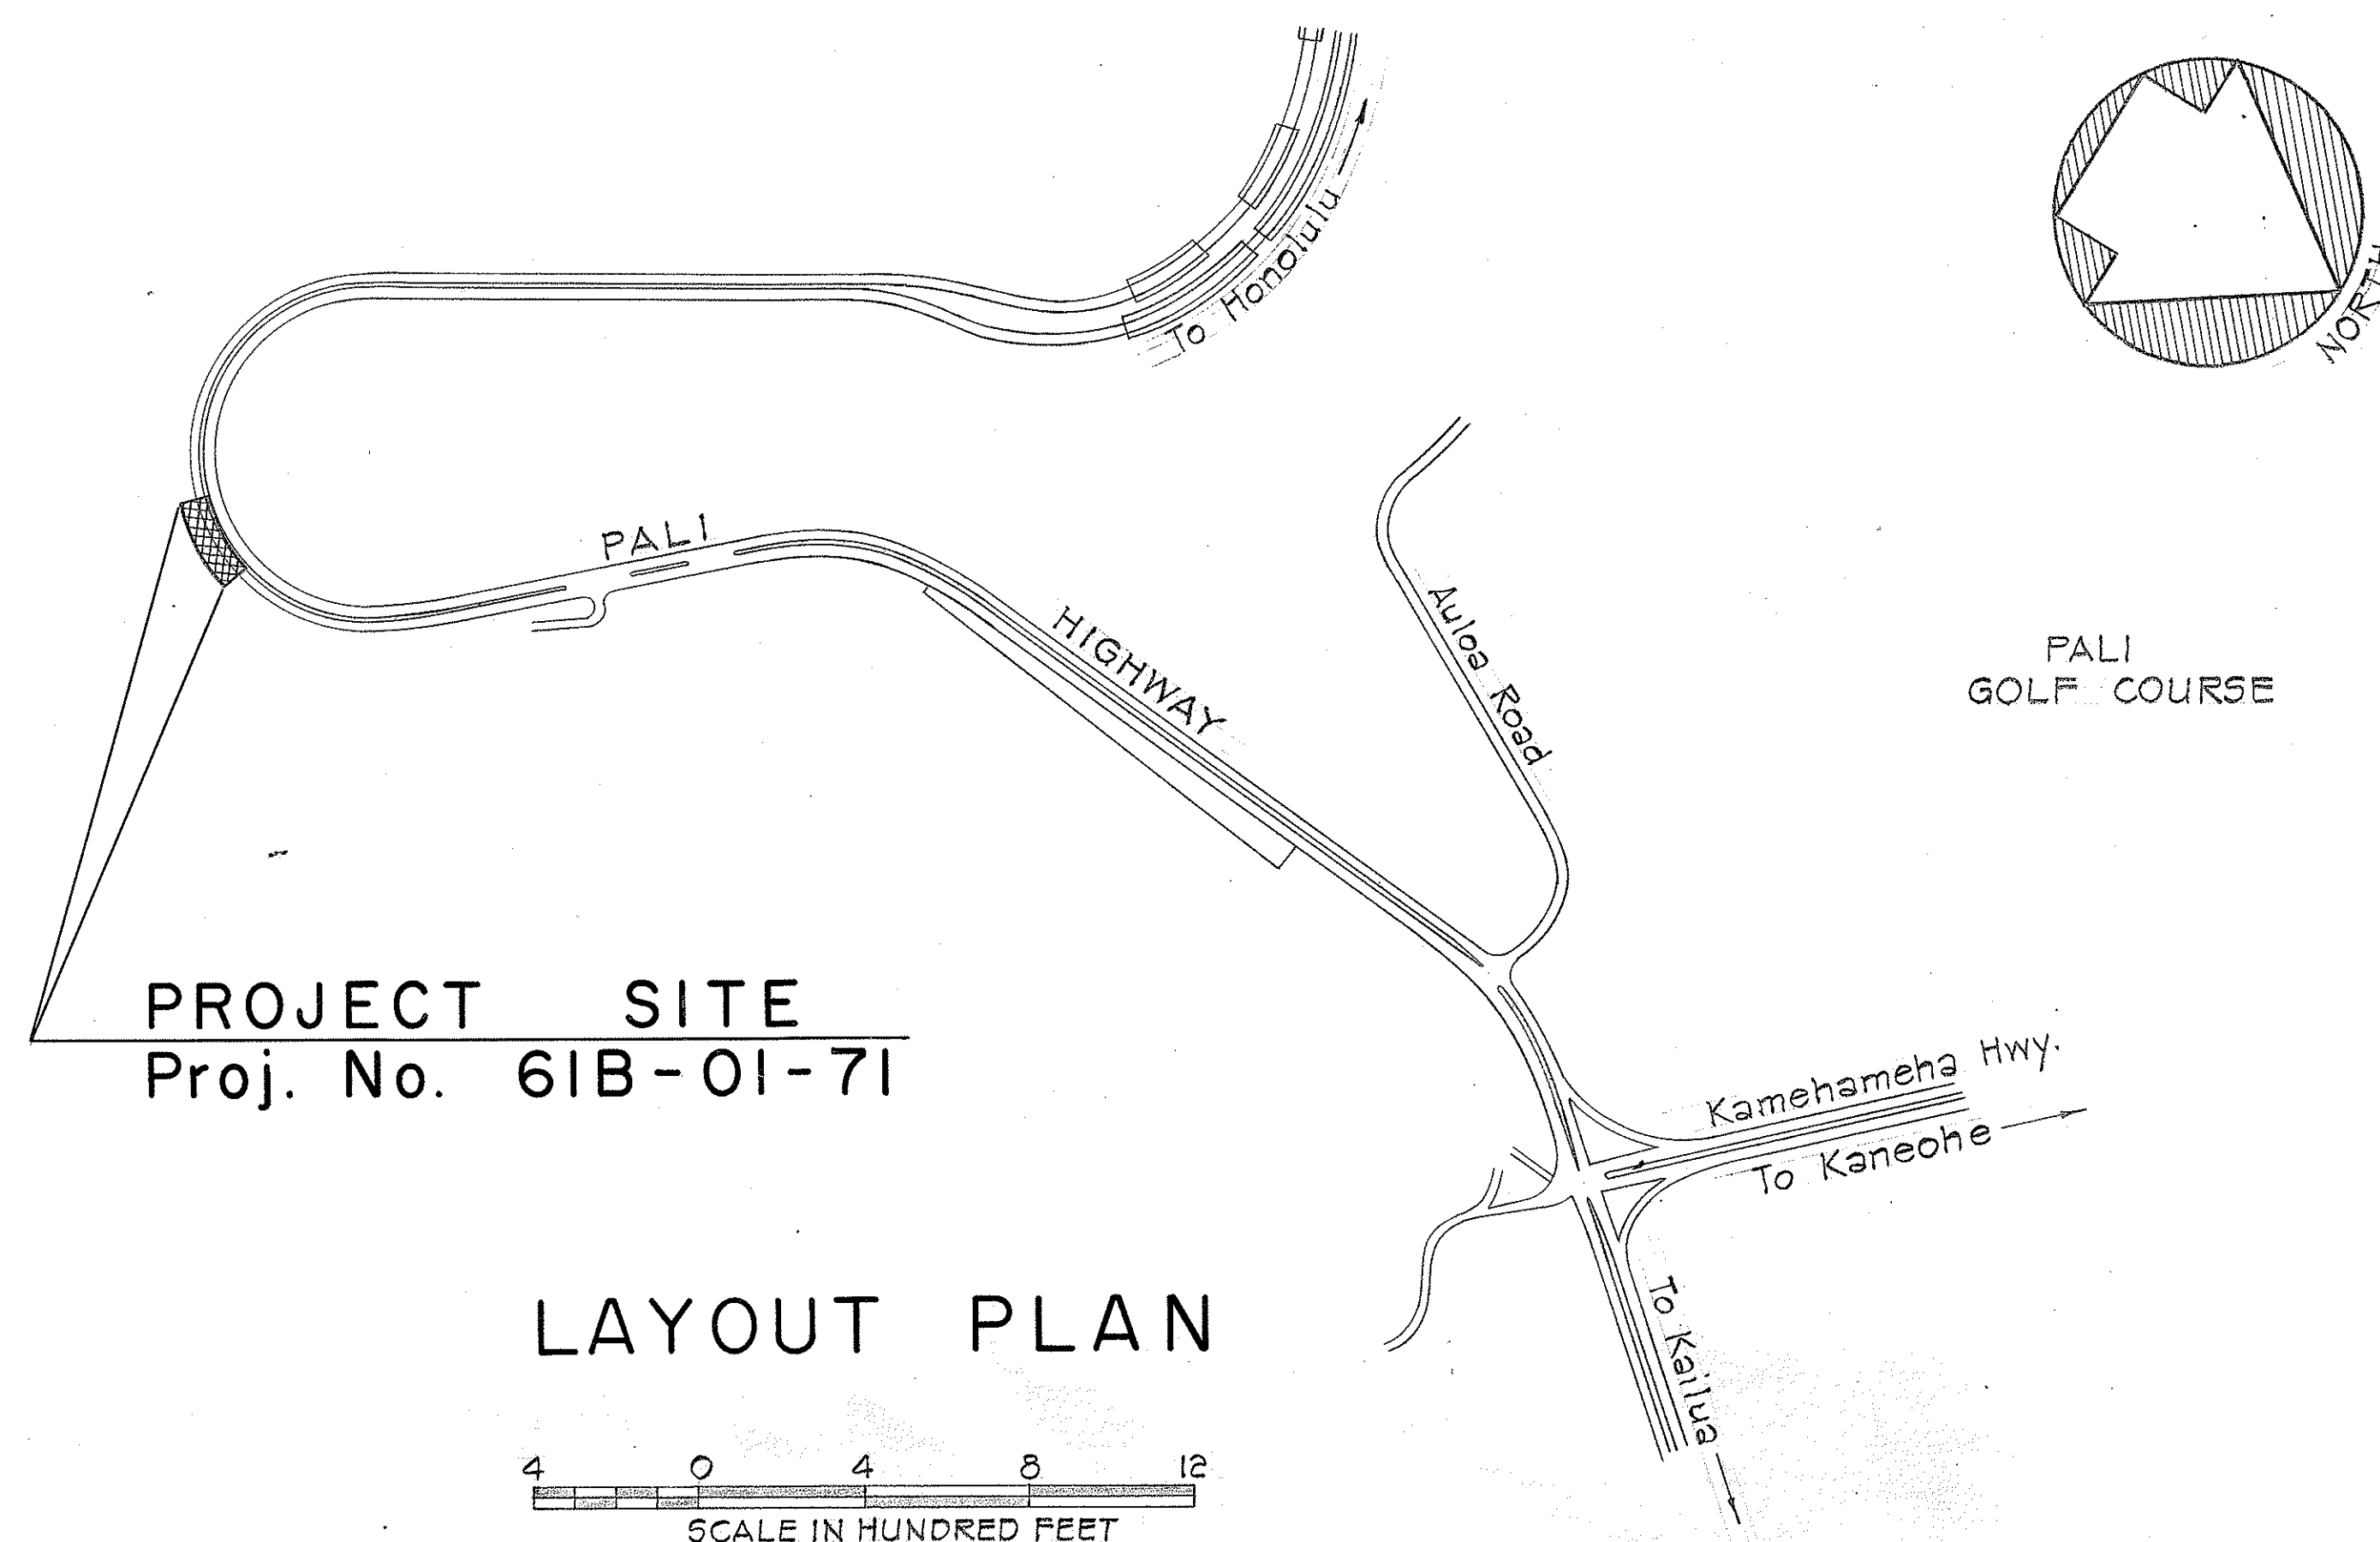


INDEX TO DRAWINGS	
SHEET NO.	DESCRIPTION
1	TITLE SHEET
2	PLAN, PROFILE AND TYPICAL SECTION
3	STANDARD DETAILS
4	PROJECT INFORMATION SIGN

FED. ROAD DIST. NO.	STATE	PROJ. NO.	FISCAL YEAR	SHEET NO.	TOTAL SHEETS
HAWAII	HAW.	61B-01-71	1971	1	4

STATE OF HAWAII
DEPARTMENT OF TRANSPORTATION
HIGHWAYS DIVISION
HONOLULU, HAWAII
"AS-BUILT"
PLANS FOR
CONSTRUCTION OF
PALI HIGHWAY IMPROVEMENT
PROTECTIVE WALL FOR
SCENIC LOOKOUT AT HAIRPIN CURVE
PROJECT NO. 61B-01-71

DISTRICT OF KOOLAUPOKO
ISLAND OF OAHU

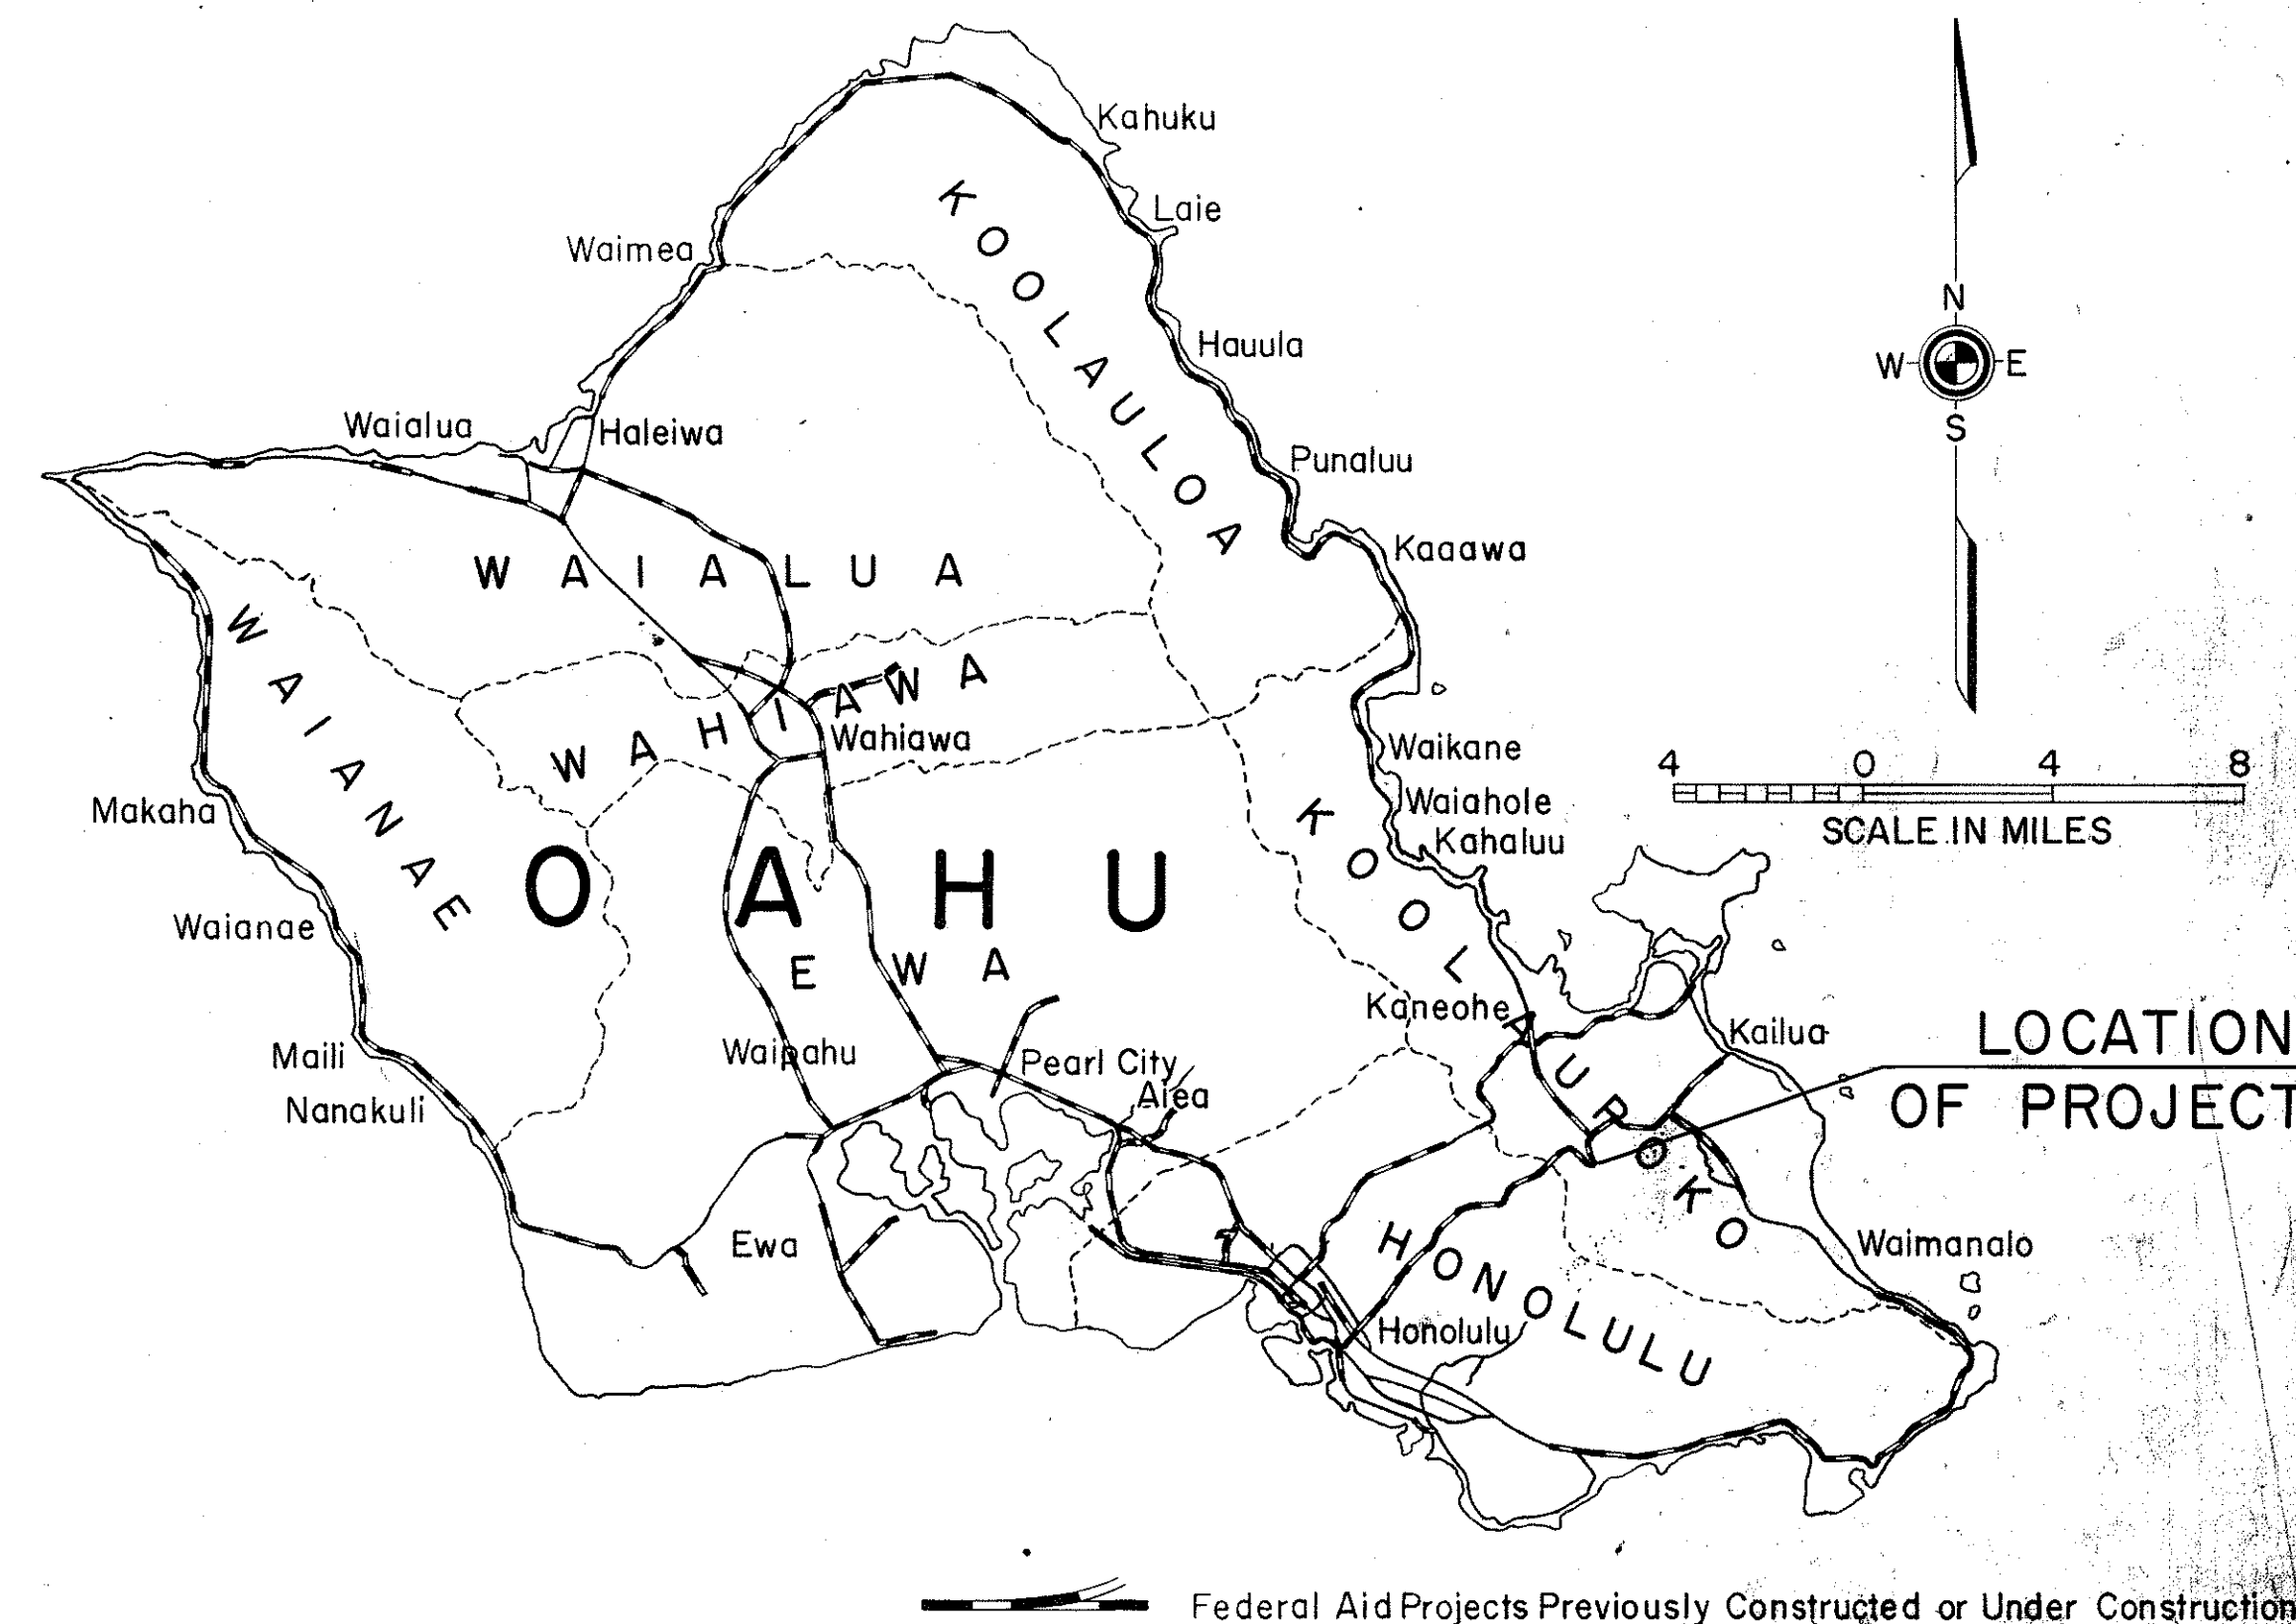

NO CHANGES WERE MADE DURING CONSTRUCTION ON THESE PLANS EXCEPT CHANGES IN THE ORIGINAL THEORETICAL QUANTITIES. FOR ACTUAL QUANTITIES, REFER TO PROJECT LEDGER AND/OR COMPUTATION BOOK.

R. T. Sander
for RESIDENT ENGINEER

11-9-81
DATE

DEPARTMENT OF TRANSPORTATION
STATE OF HAWAII

APPROVED:

G. Alvey Wright 1/27/71
for DIR. OF TRANSPORTATION DATE

R. TSUZUKI 548-7490 Jan. 1971
DESIGN ENGINEER PHONE DATE