IN	DEX TO DRAWINGS
SHEET NO.	DESCRIPTION
	TITLE SHEET
2-4	PLAN
5-11	STANDARD DETAILS
Ligaring de s i de la companya de la c	
•	



STATE OF HAWAII

DEPARTMENT OF TRANSPORTATION HIGHWAYS DIVISION

HONOLULU, HAWAII


"AS BUILT"


PLANS FOR

GUARD RAIL IMPROVEMENTS KALANIANAOLE HIGHWAY AND KAILUA ROAD

PROJECT NO. HWY-0-02-72

DISTRICT OF KOOLAUPOKO
ISLAND OF OAHU

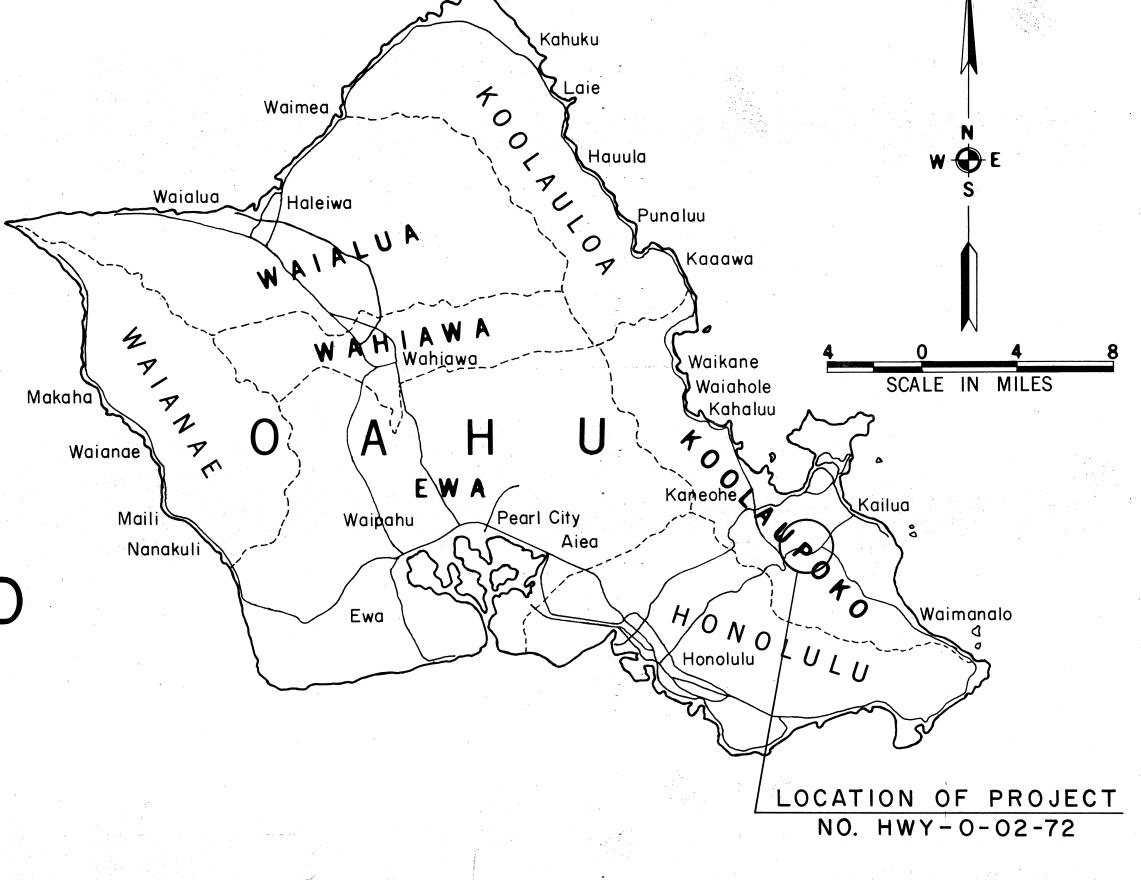

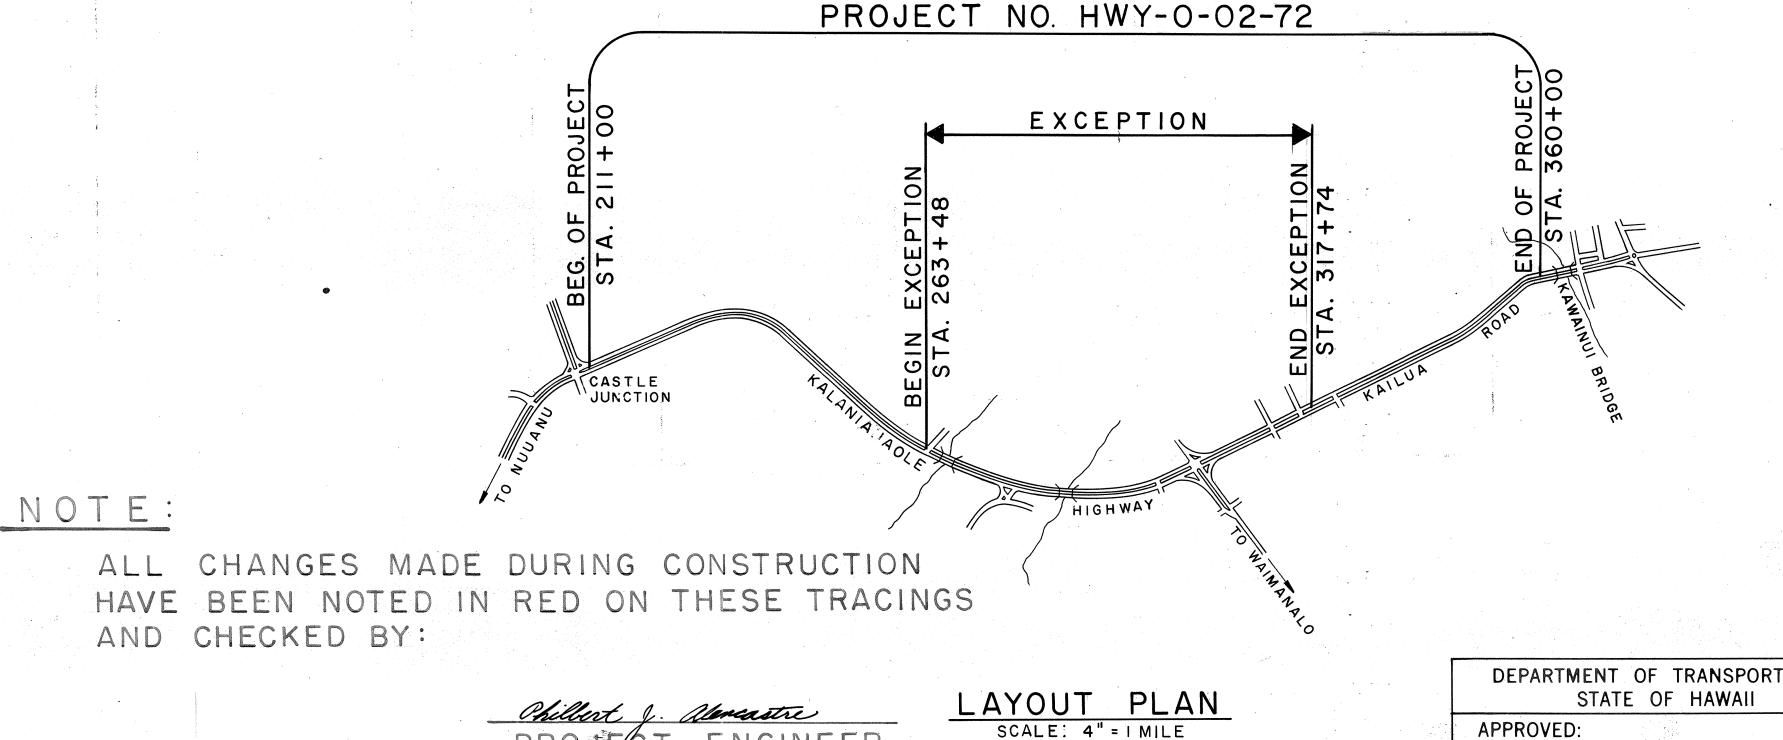

evier 7537 **Feb. 197** E. BY PHONE DATE

ALL CHANGES MADE DURING CONSTRUCTION HAVE BEEN INCORPORATED ON THESE PLANS EXCEPT CHANGES IN THE ORIGINAL THEORITICAL QUANTITIES. FOR ACTUAL QUANTITIES REFER TO PROJECT MEASUREMENT BOOK.

PHILBERT ALENCASTRE

DEPARTMENT OF TRANSPORTATION
STATE OF HAWAII

APPROVED:

Munny Lee 3/22/2

FOR DIR. OF TRANSPORTATION DATE

J

FISCAL SHEET YEAR NO.