
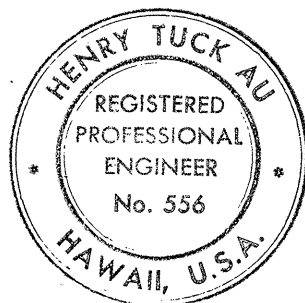
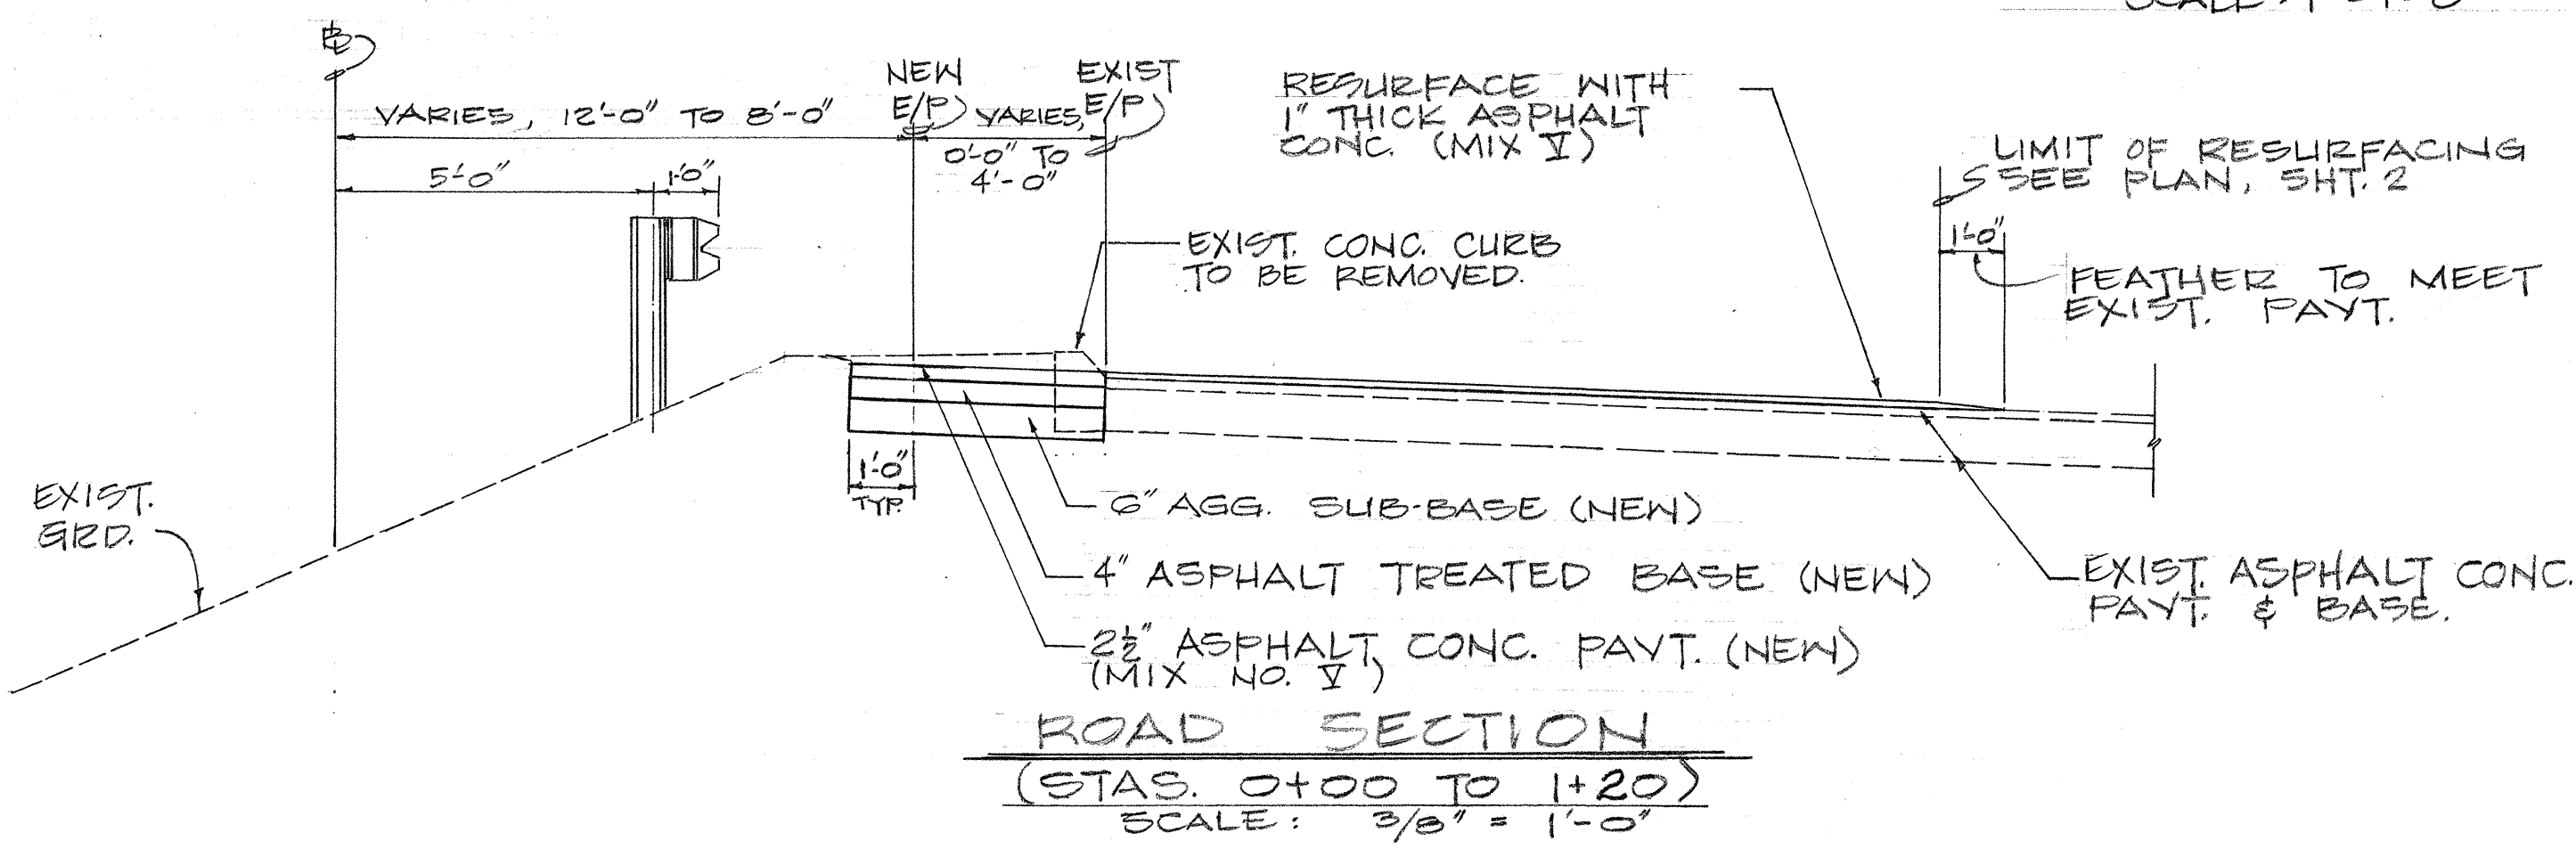
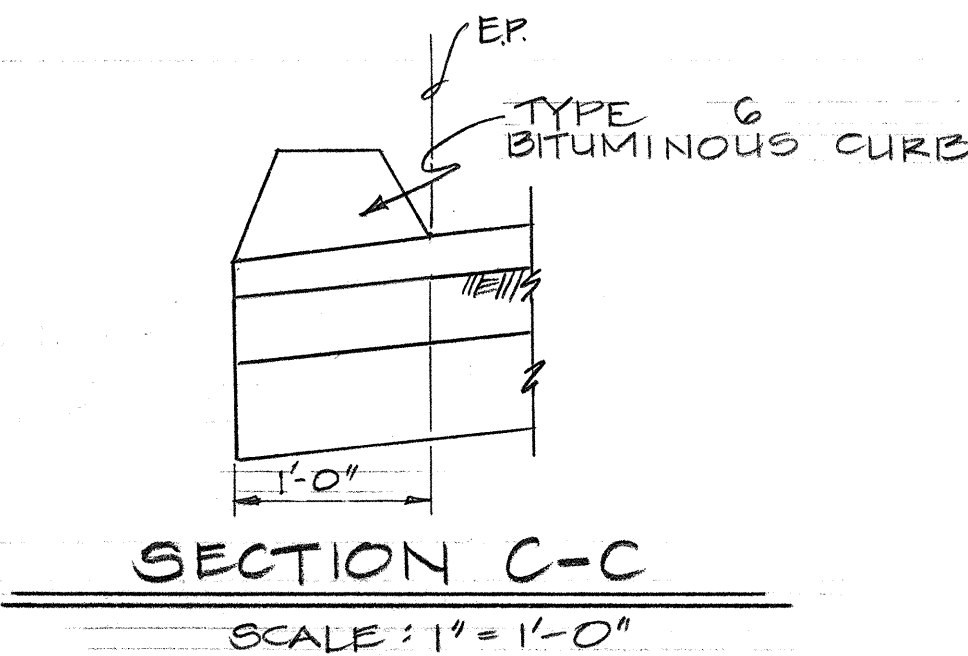
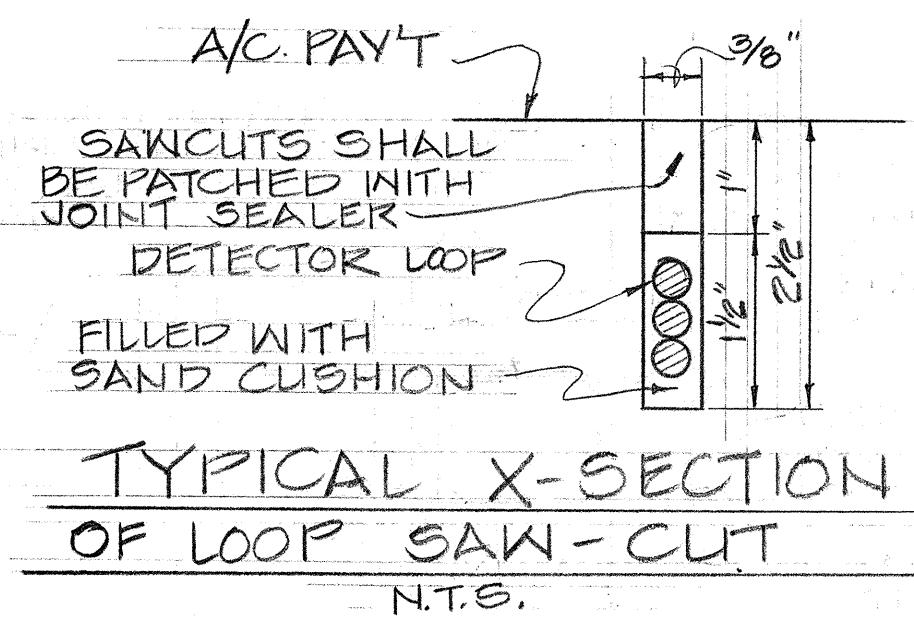
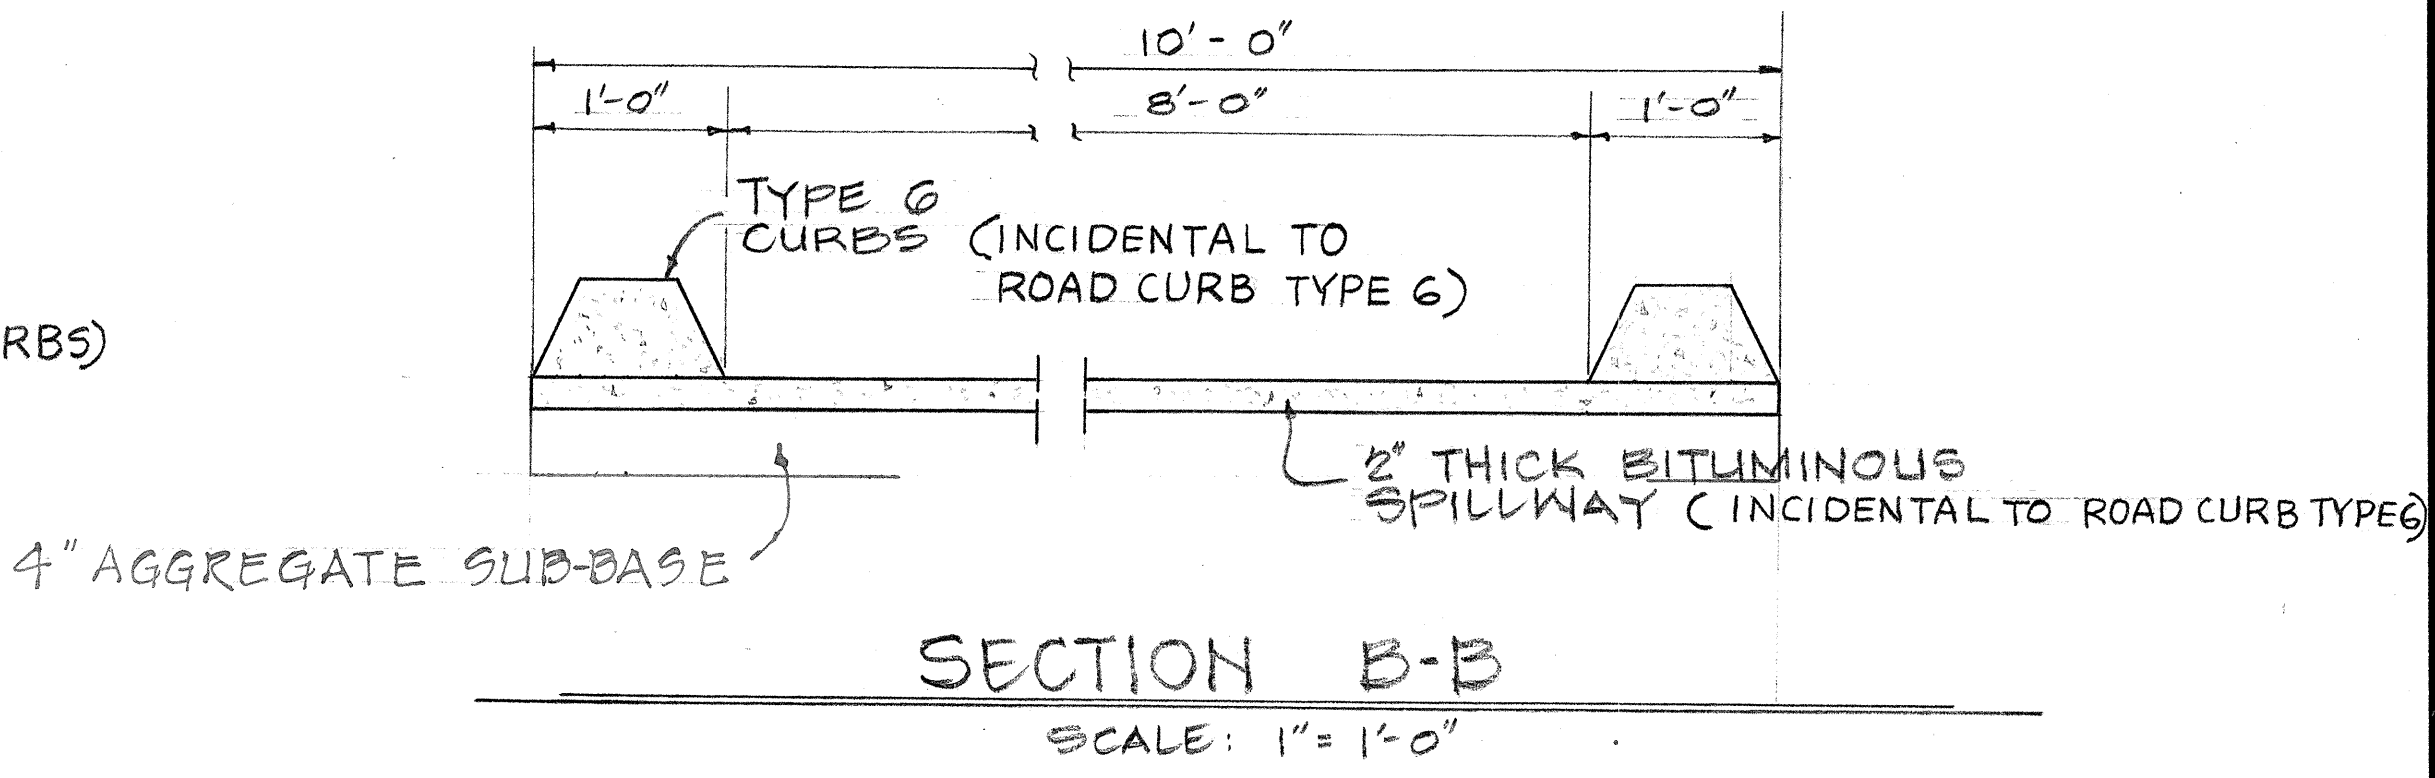
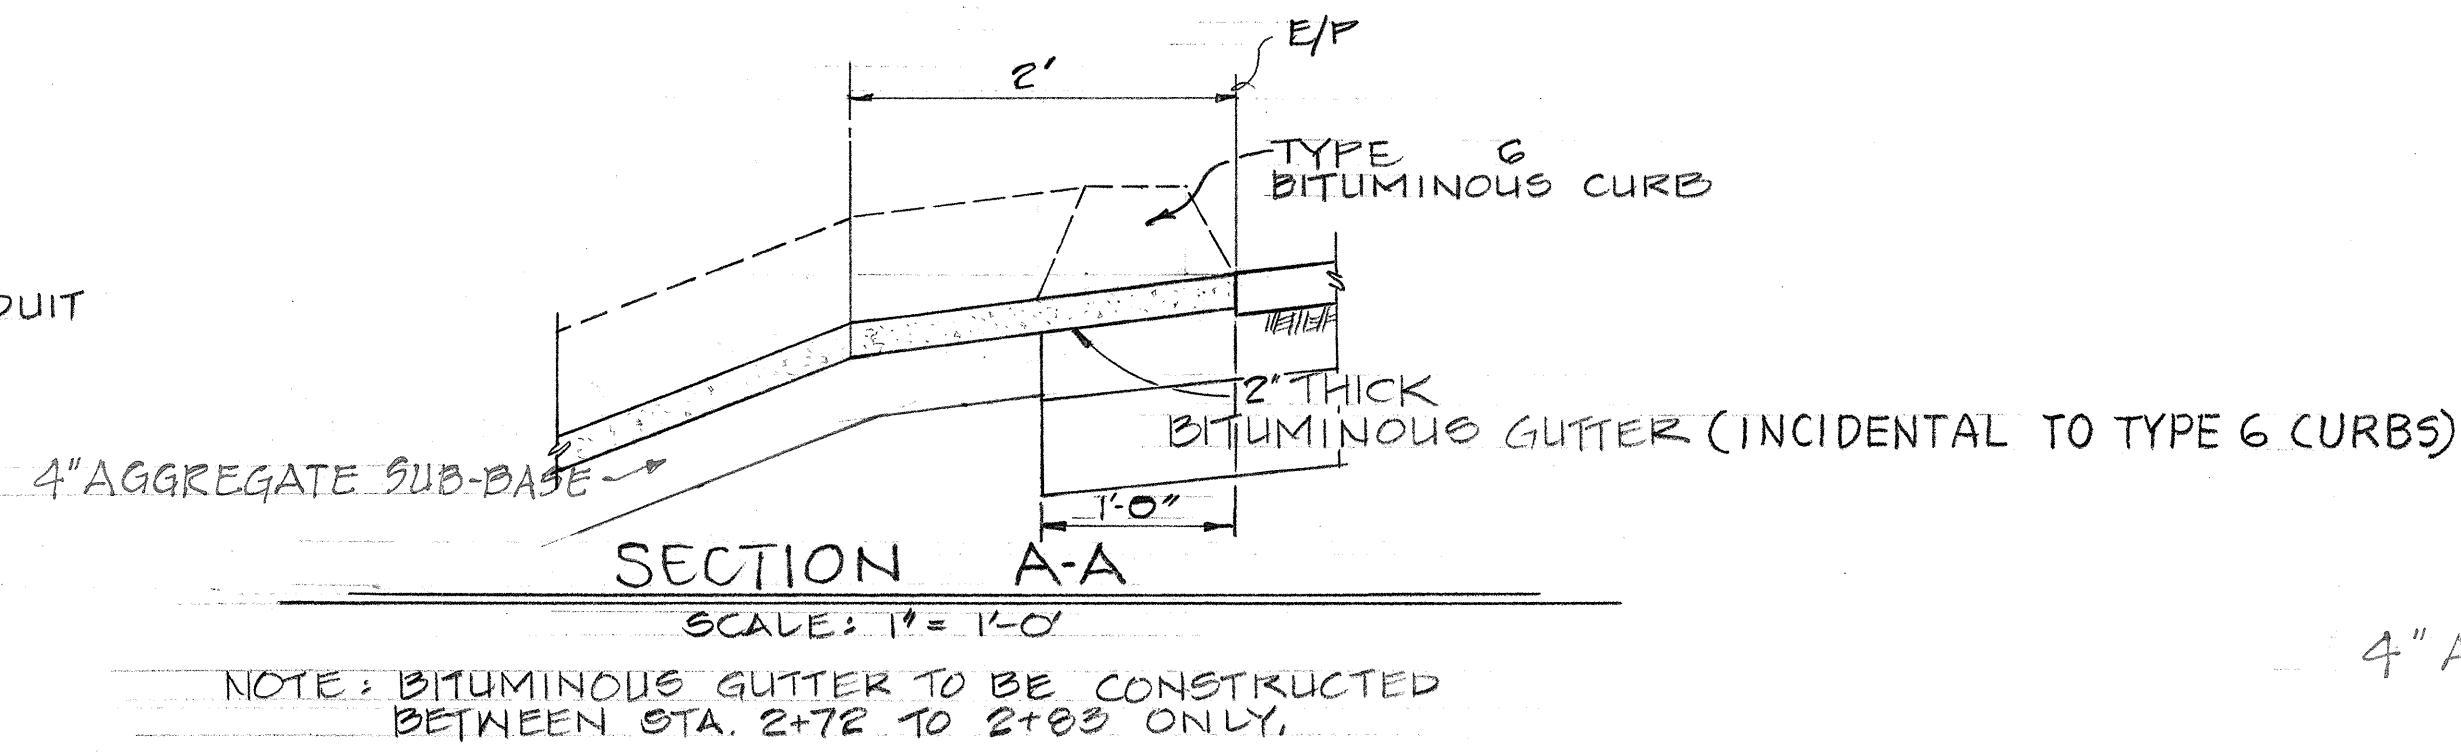
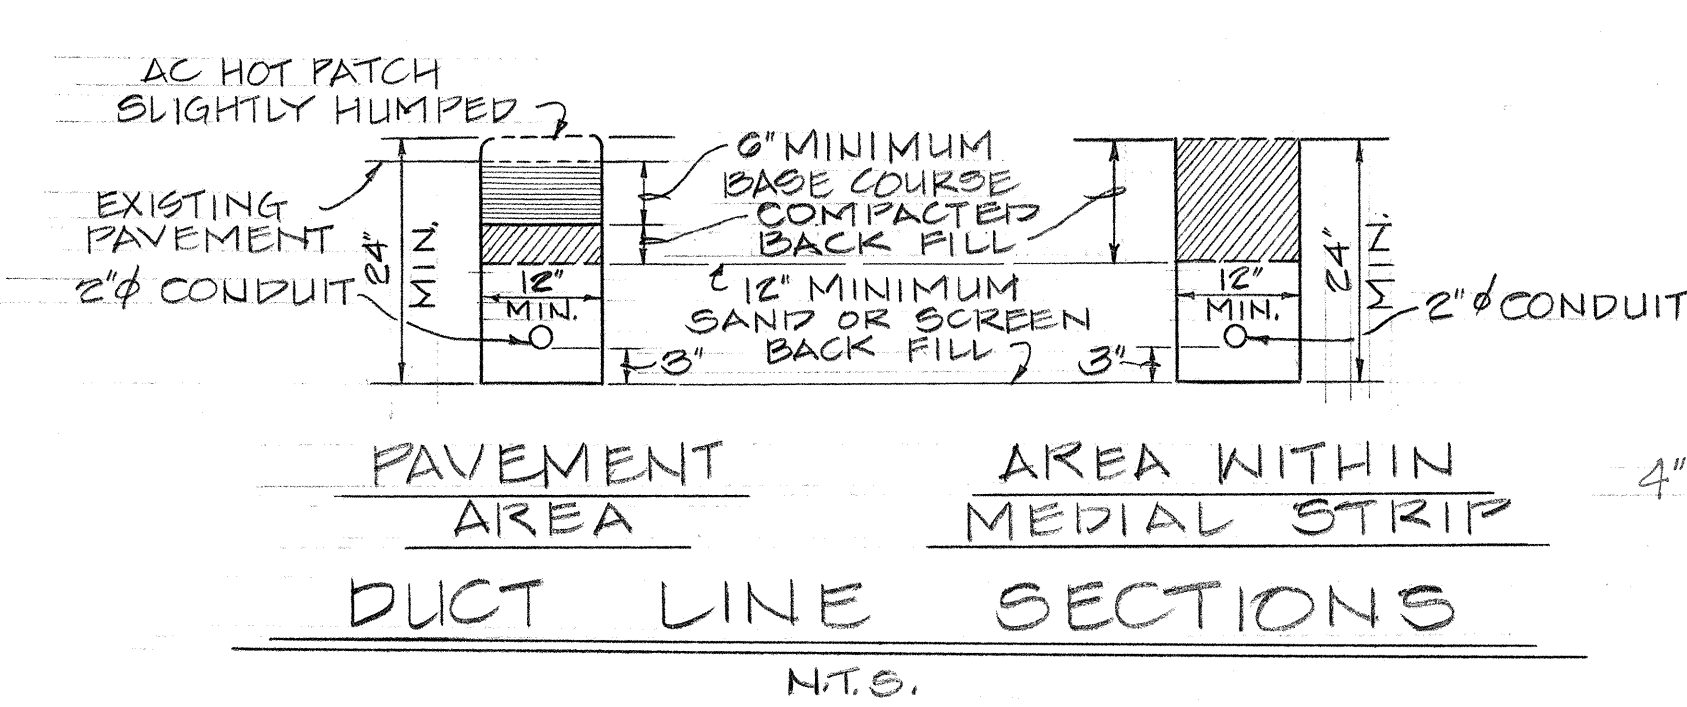
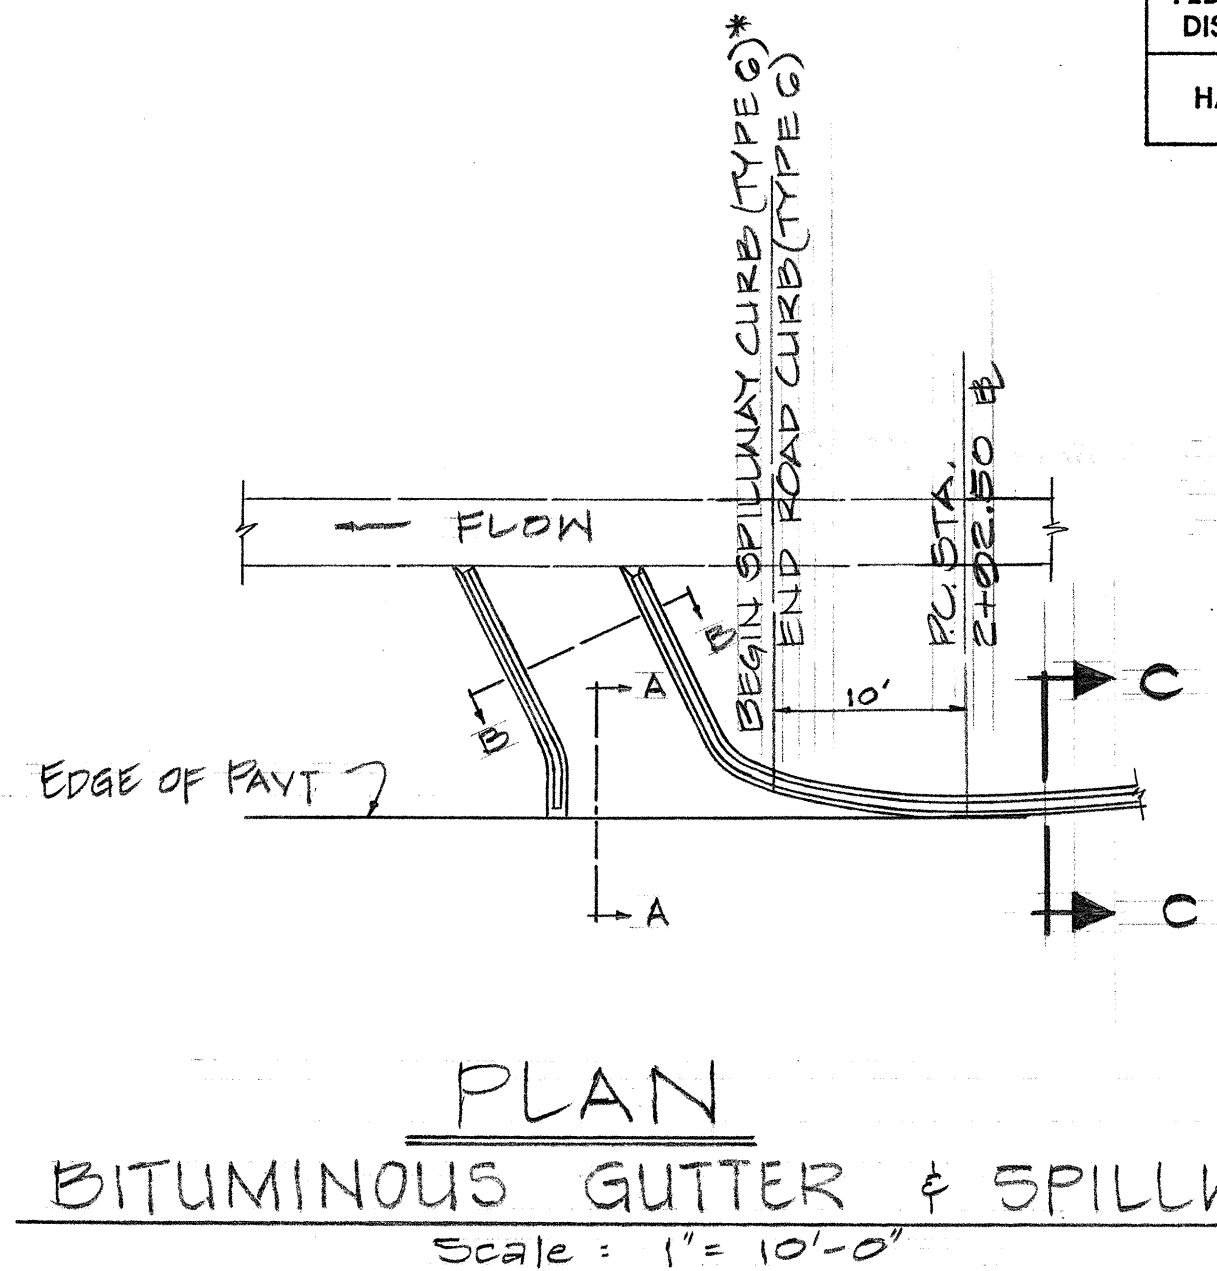


FED. ROAD DIST. NO.	STATE	PROJ. NO.	FISCAL YEAR	SHEET NO.	TOTAL SHEETS
HAWAII	HAW.	0-05-72 PHASE II	72	3	10

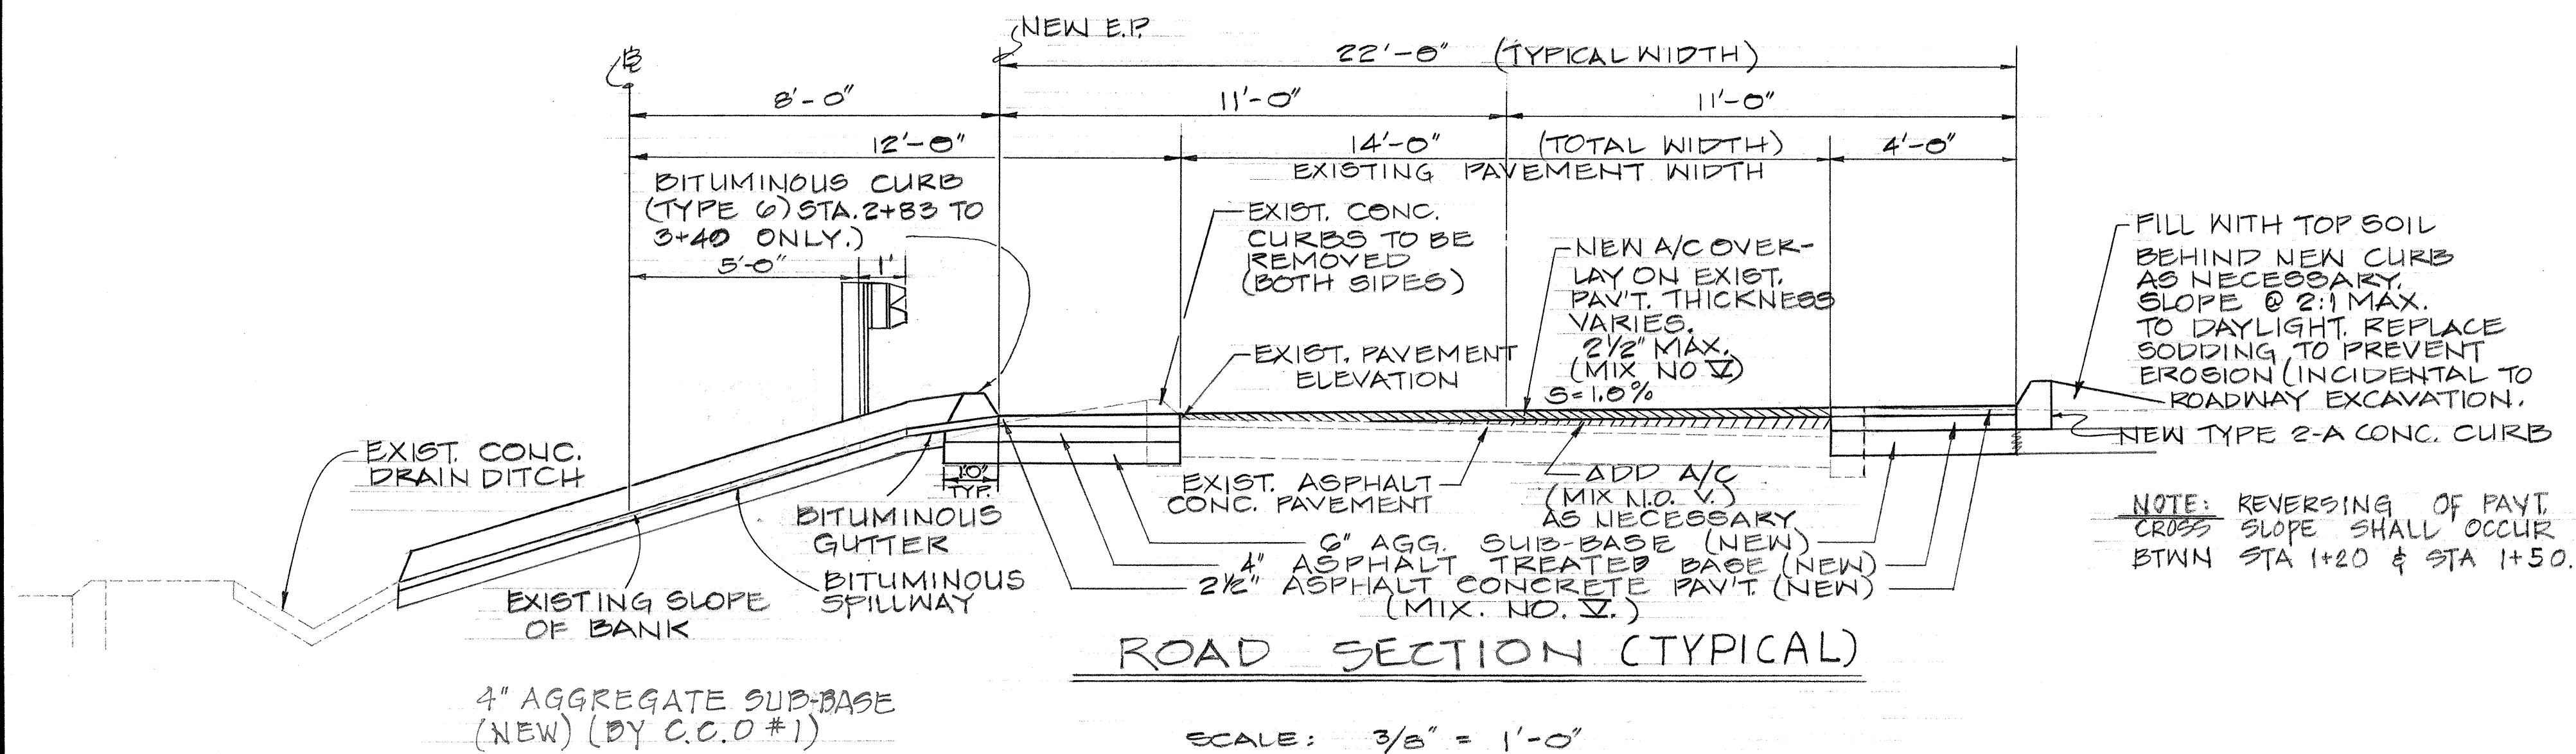

THIS WORK WAS PREPARED BY ME OR UNDER MY SUPERVISION,

Henry Tuck Au

February 25, 1972

STATE OF HAWAII
DEPARTMENT OF TRANSPORTATION
HIGHWAYS DIVISION

TYPICAL ROAD SECTION AND MISCELLANEOUS DETAILS

DOUBLE LEFT TURN LANES ON KAMEHAMEHA HIGHWAY AT CASTLE JUNCTION

PROJECT NO. HWY 0-05-72 (PHASE II)

SCALE AS SHOWN DATE FEB 25, 1972