
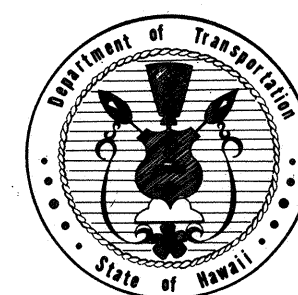


[illegible]

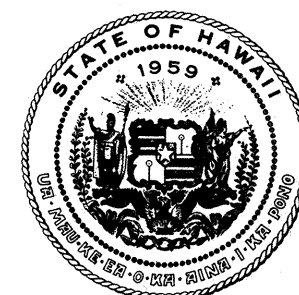

STATE OF HAWAII

DEPARTMENT OF TRANSPORTATION

HIGHWAYS DIVISION

HONOLULU, HAWAII




"AS BUILT" PLANS FOR

PALI HIGHWAY AND KAILUA ROAD RESURFACING AND RECONSTRUCTION OF VARIOUS SECTIONS

PROJECT NO. 61ABC-01-72

DISTRICT OF HONOLULU AND KOOLAUPOKO
ISLAND OF OAHU

FED. ROAD DIST. NO.	STATE	PROJ. NO.	FISCAL YEAR	SHEET NO.	TOTAL SHEETS
HAWAII	HAW.	61ABC-01-72	1972	1	8

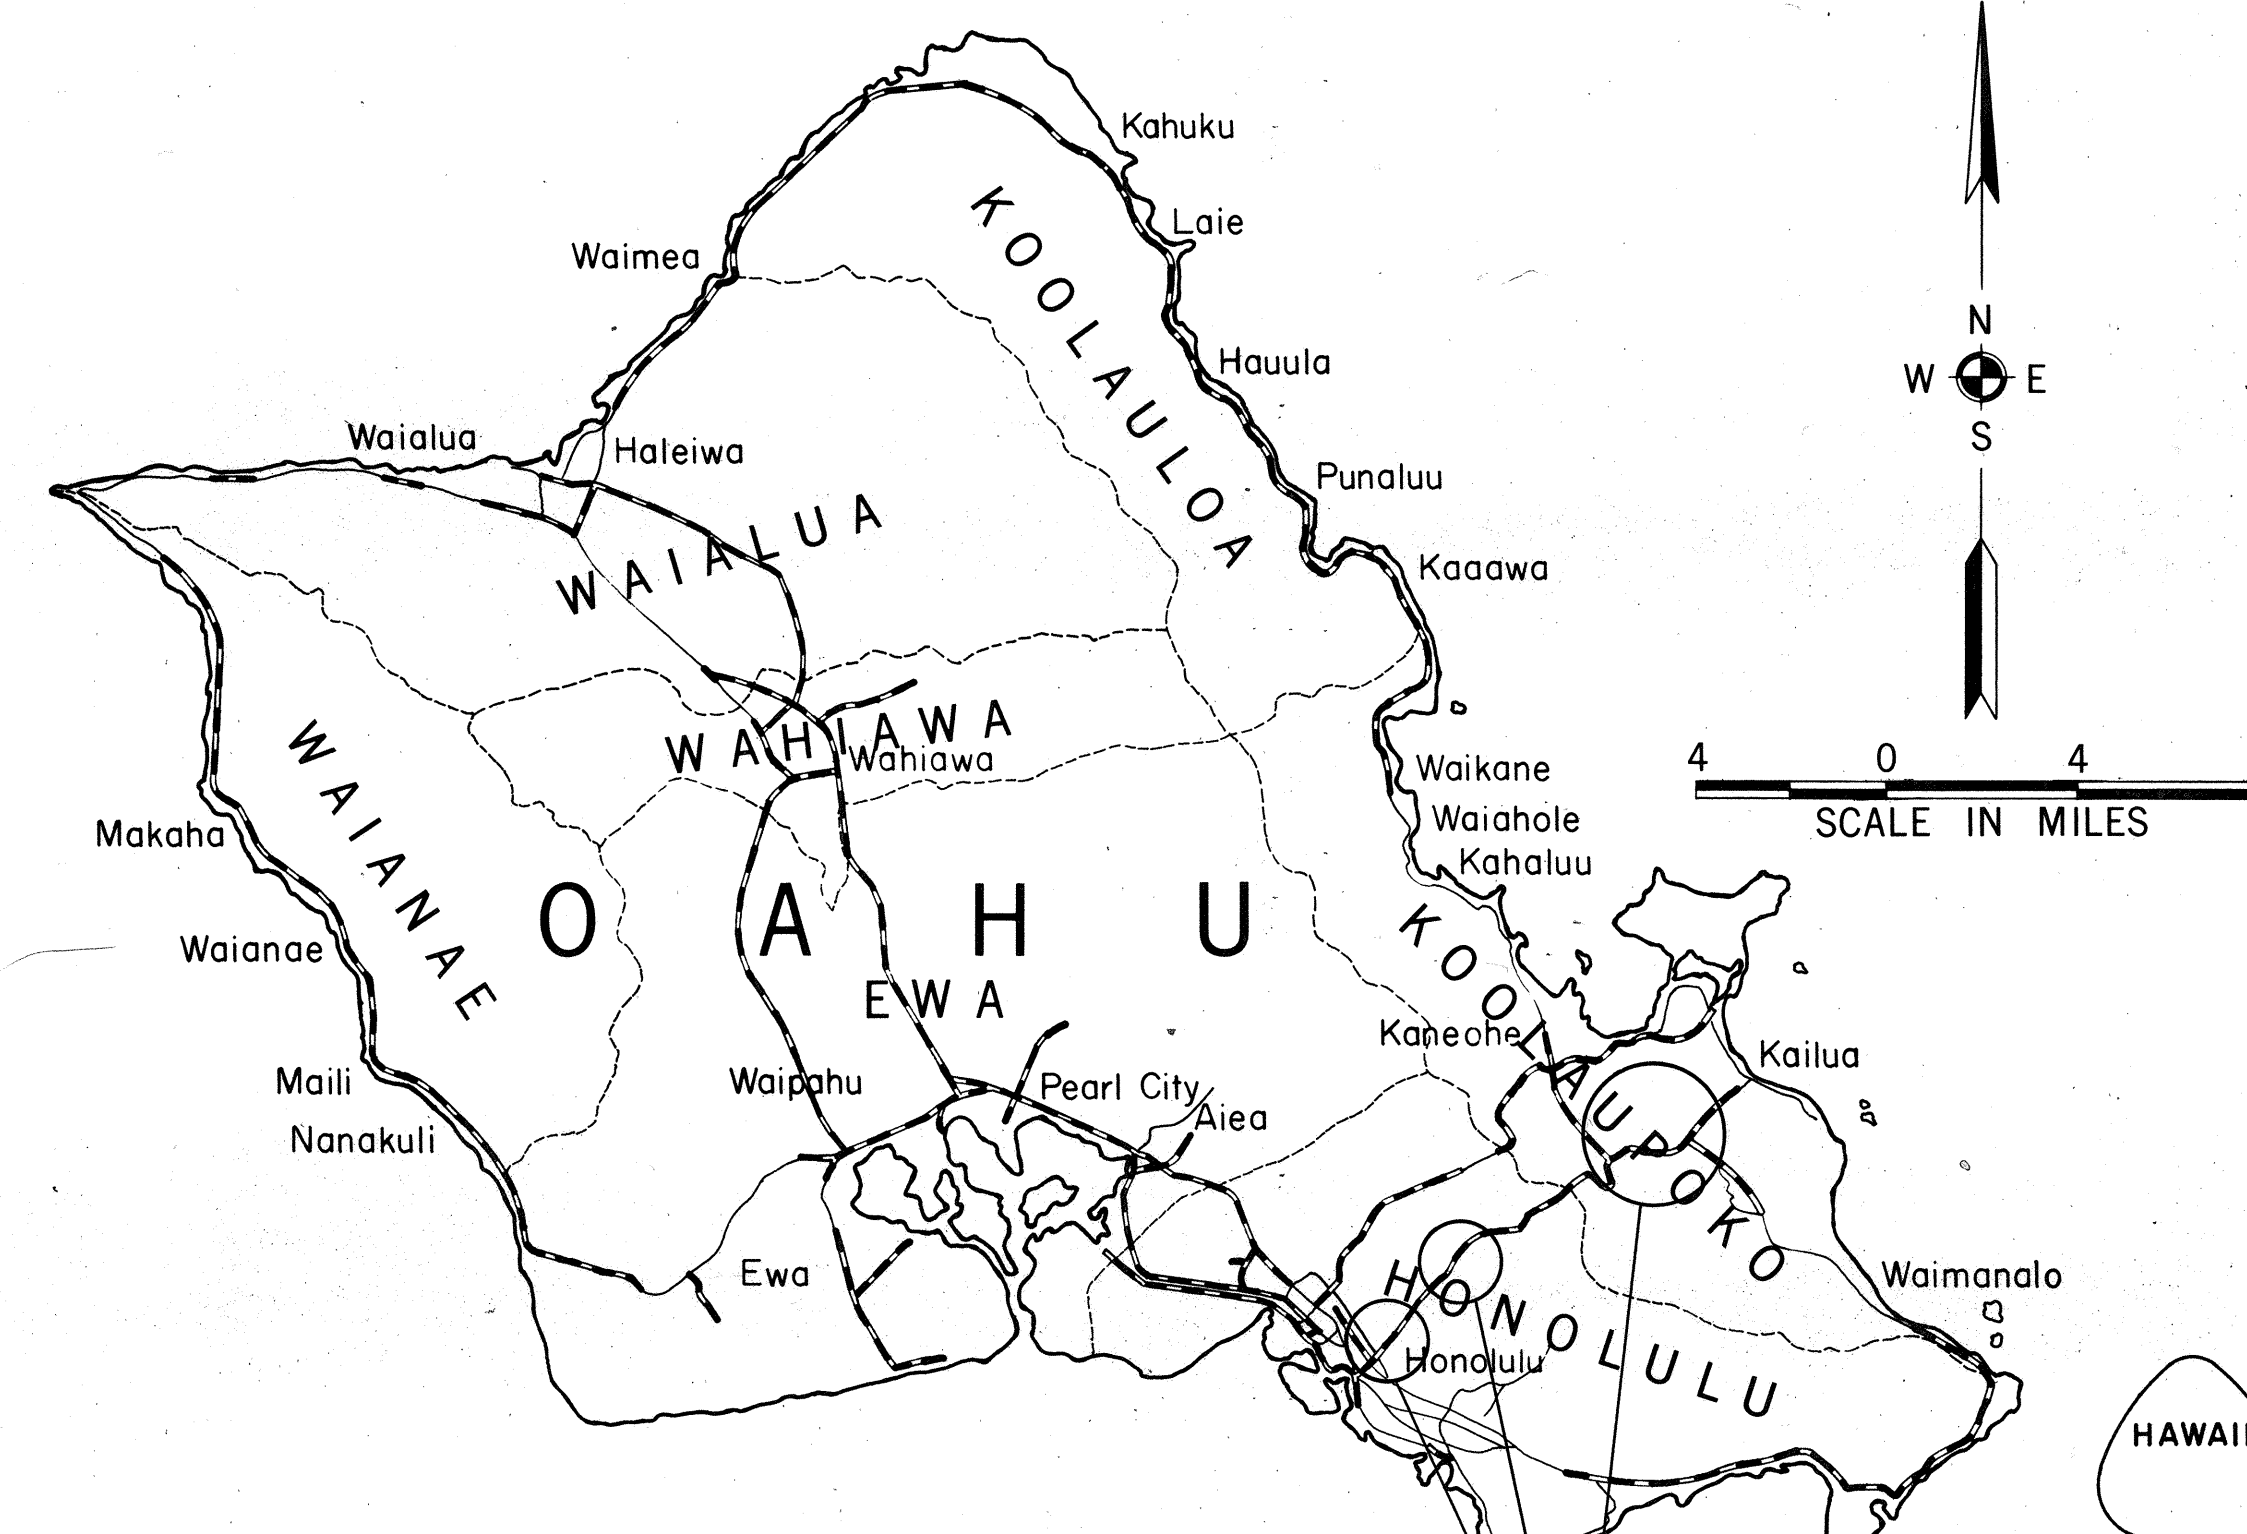


NOTE :

ALL CHANGES MADE DURING CONSTRUCTION HAVE BEEN INCORPORATED ON THESE PLANS IN RED EXCEPT CHANGES IN THE ORIGINAL THEORETICAL DIMENSIONS AND QUANTITIES. FOR ACTUAL DIMENSIONS AND QUANTITIES, REFER TO PROJECT LEDGER AND/OR COMPUTATION BOOK.


Federal Aid Projects Previously Constructed or Under Construction

LOCATIONS OF PROJECT
NO. 61ABC-01-72


Philbert Alencastre July 11, 1973
PHILBERT ALENCASTRE DATE

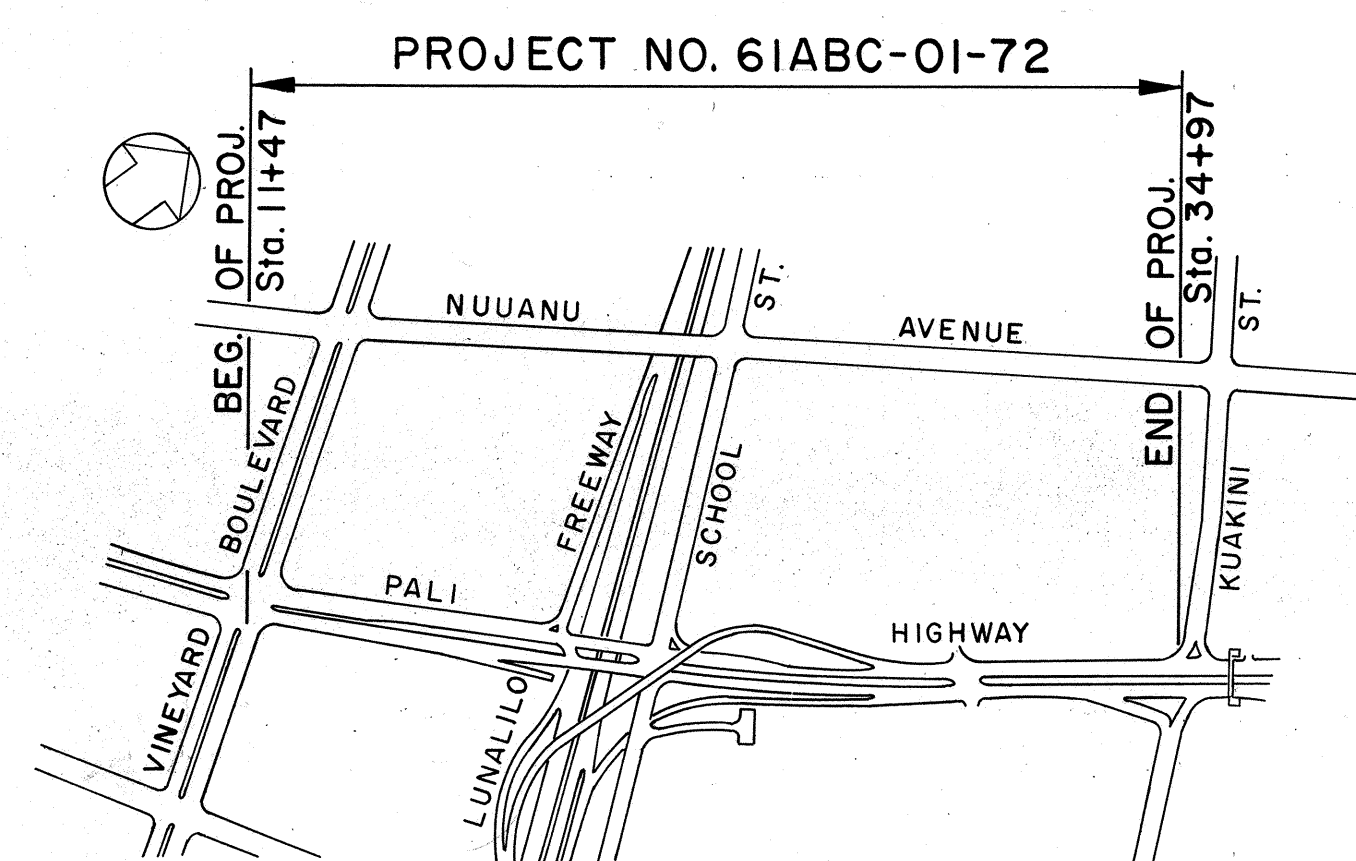

VINEYARD BLVD. TO KUAKINI ST.
NOT TO SCALE

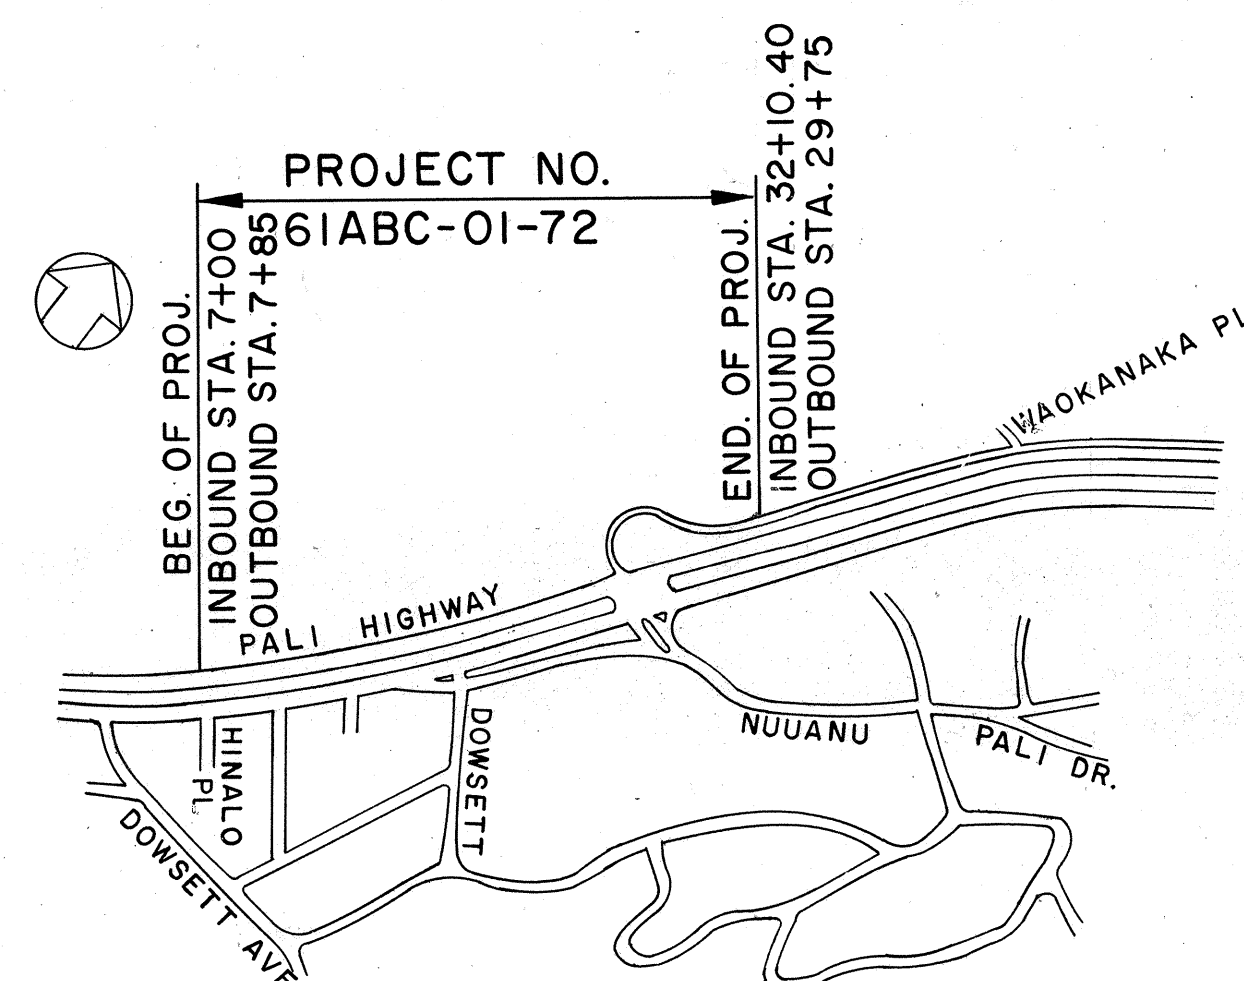

HINALO PL. TO WAOKANAKA PL.
NOT TO SCALE

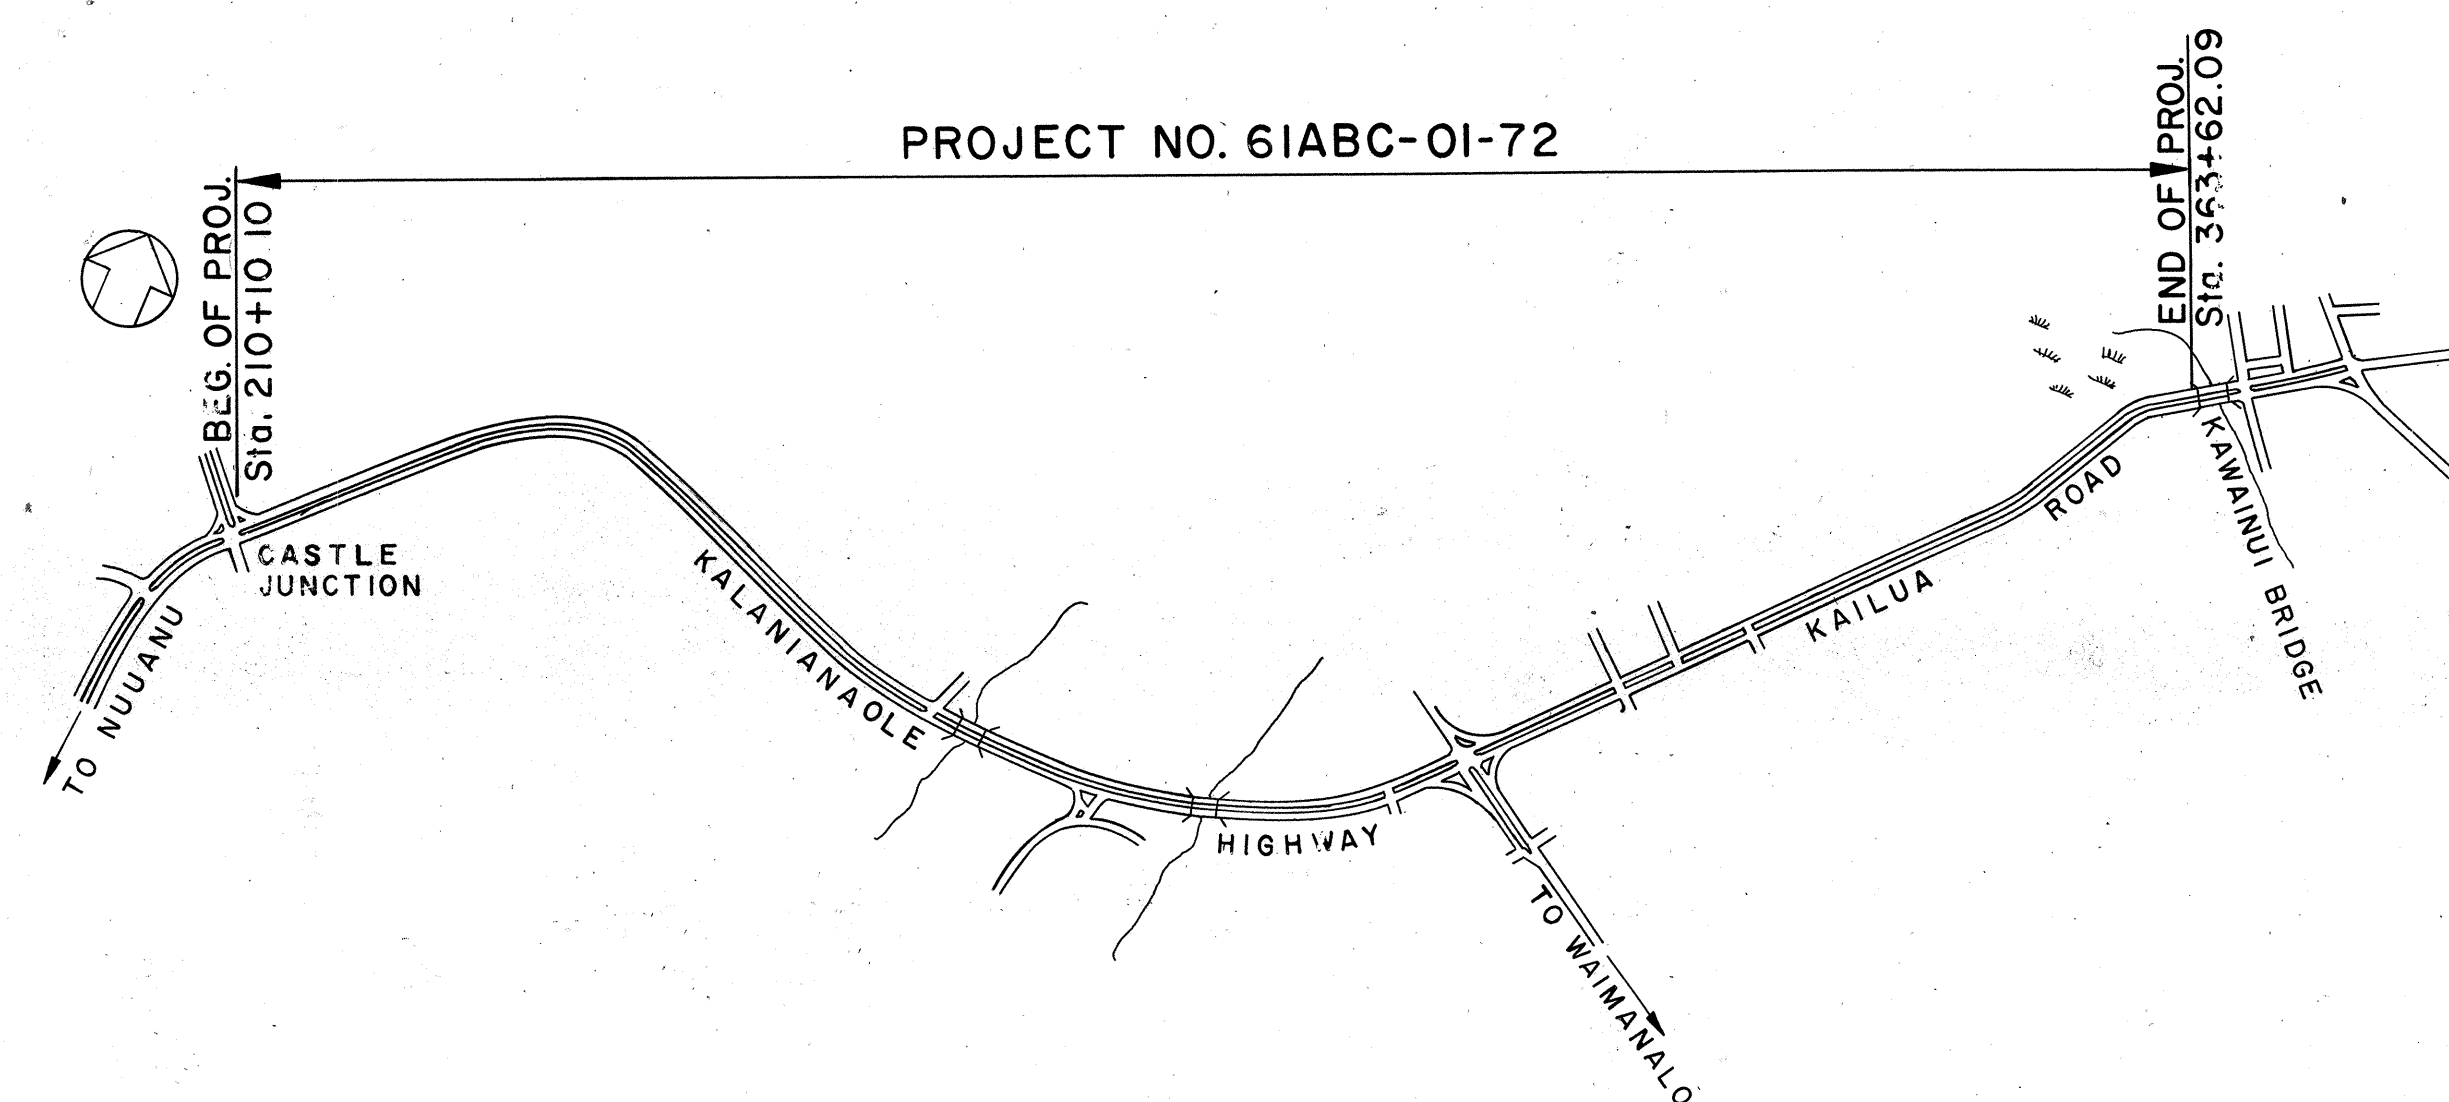

CASTLE JUNCTION TO KAWAINUI BRIDGE
SCALE: 4" = 1 MILE

LAYOUT PLANS

DEPARTMENT OF TRANSPORTATION STATE OF HAWAII	
APPROVED:	
For <u>Murray Lee</u> DIR. OF TRANSPORTATION	<u>6/6/72</u> DATE

DESIGNED BY D. Bevier 548-7537 June 1972
P. S. & E. BY PHONE DATE