IN	DEX TO DRAWINGS
SHEET NO.	DESCRIPTION
	TITLE SHEET
*2	GENERAL NOTES &
	MISCELLANEOUS DETAILS
**3-10	ROADWAY PLANS
11-19	PAVEMENT MARKINGS PLANS
•	
1 A	
	·

PLAN SHEET NOS. *C.O. 25-1 8 ** C.O. 105-1 ARE SUPPLEMENTARY SHEETS TO THIS PROJECT.



STATE OF HAWAII

TRANSPORTATION DEPARTMENT OF HIGHWAYS DIVISION

HONOLULU, HAWAII


"AS - BUILT"

PLANS FOR


HIGHWAY RESURFACING PALI NUUANU DRIVE TO CASTLE RANCH OFFICE VICINITY OF

PROJECT NO. 61BD-01-74

DISTRICTS OF HONOLULU & KOOLAUPOKO ISLAND OF OAHU

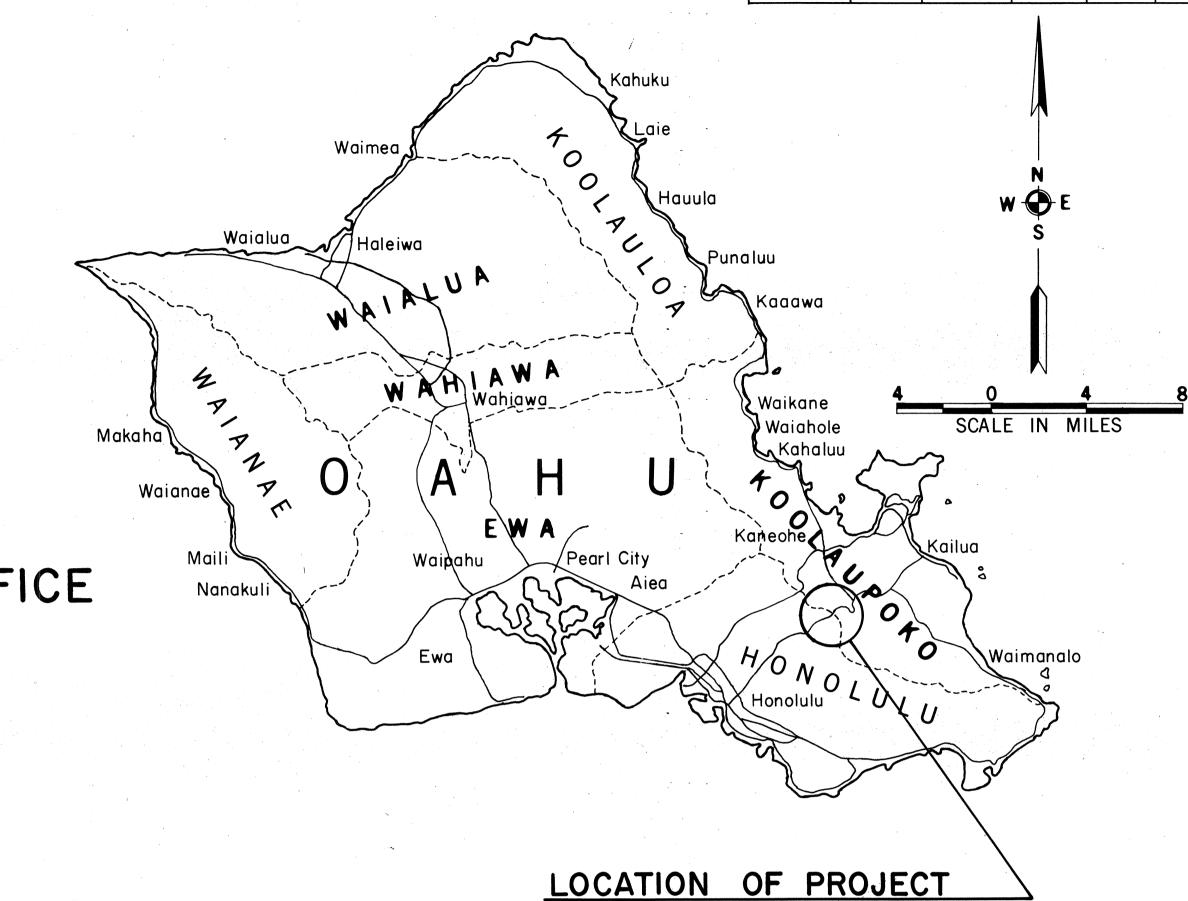

ALL CHANGES MADE DURING CONSTRUCTION HAVE BEEN INCORPORATED ON THESE PLANS IN RED EXCEPT CHANGES IN THE ORIGINAL THEORETICAL QUANTITIES. FOR ACTUAL QUANTITIES, REFER TO PROJECT LEDGER AND/OR COMPUTATION BOOK.

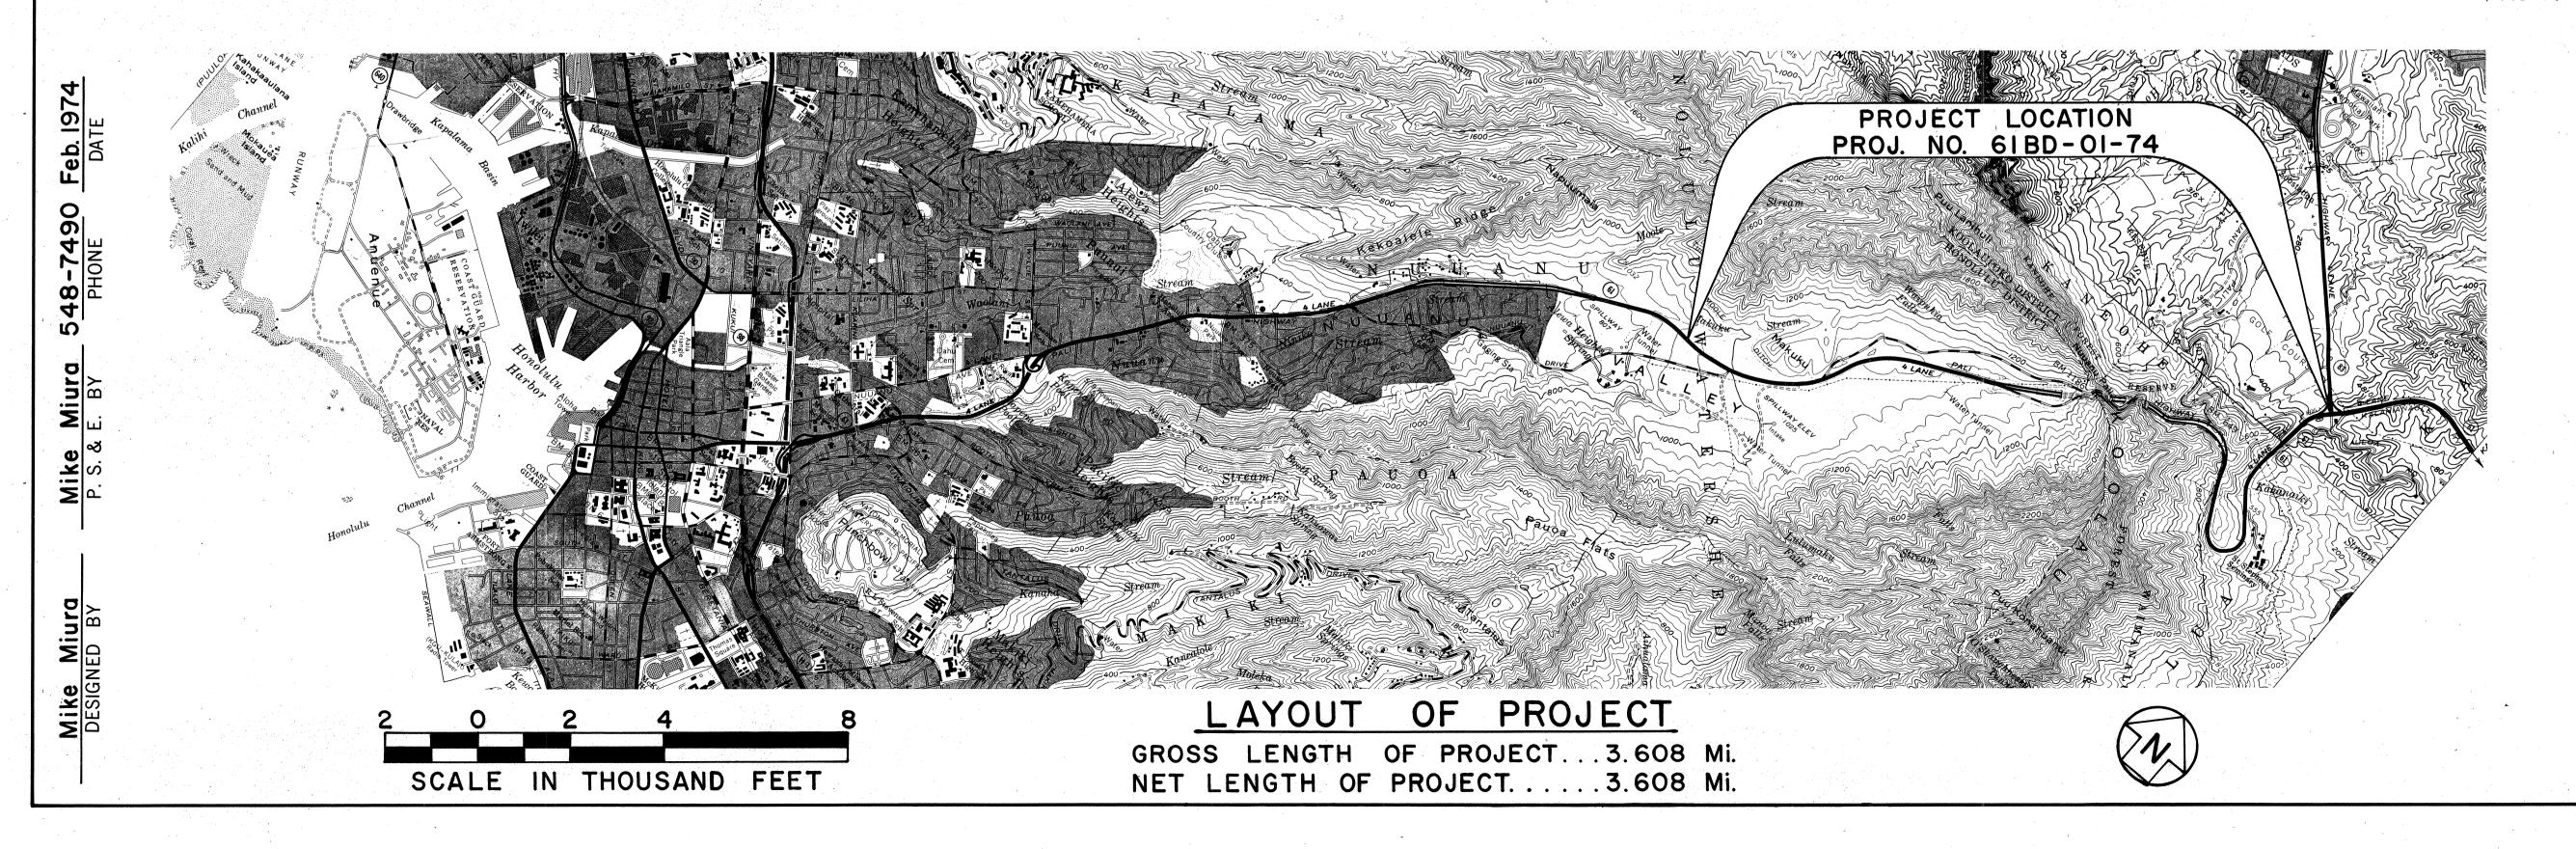

3/29/78 DATE

HAW. 618D-01-74 1974

DEPARTMENT OF TRANSPORTATION STATE OF HAWAII APPROVED: 5/8/74