
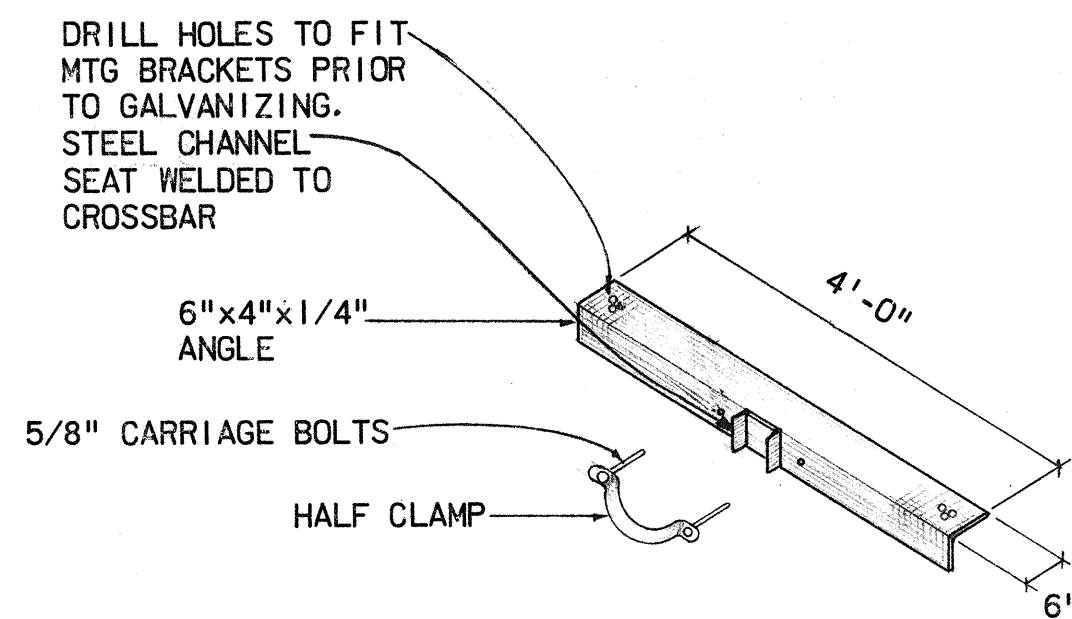
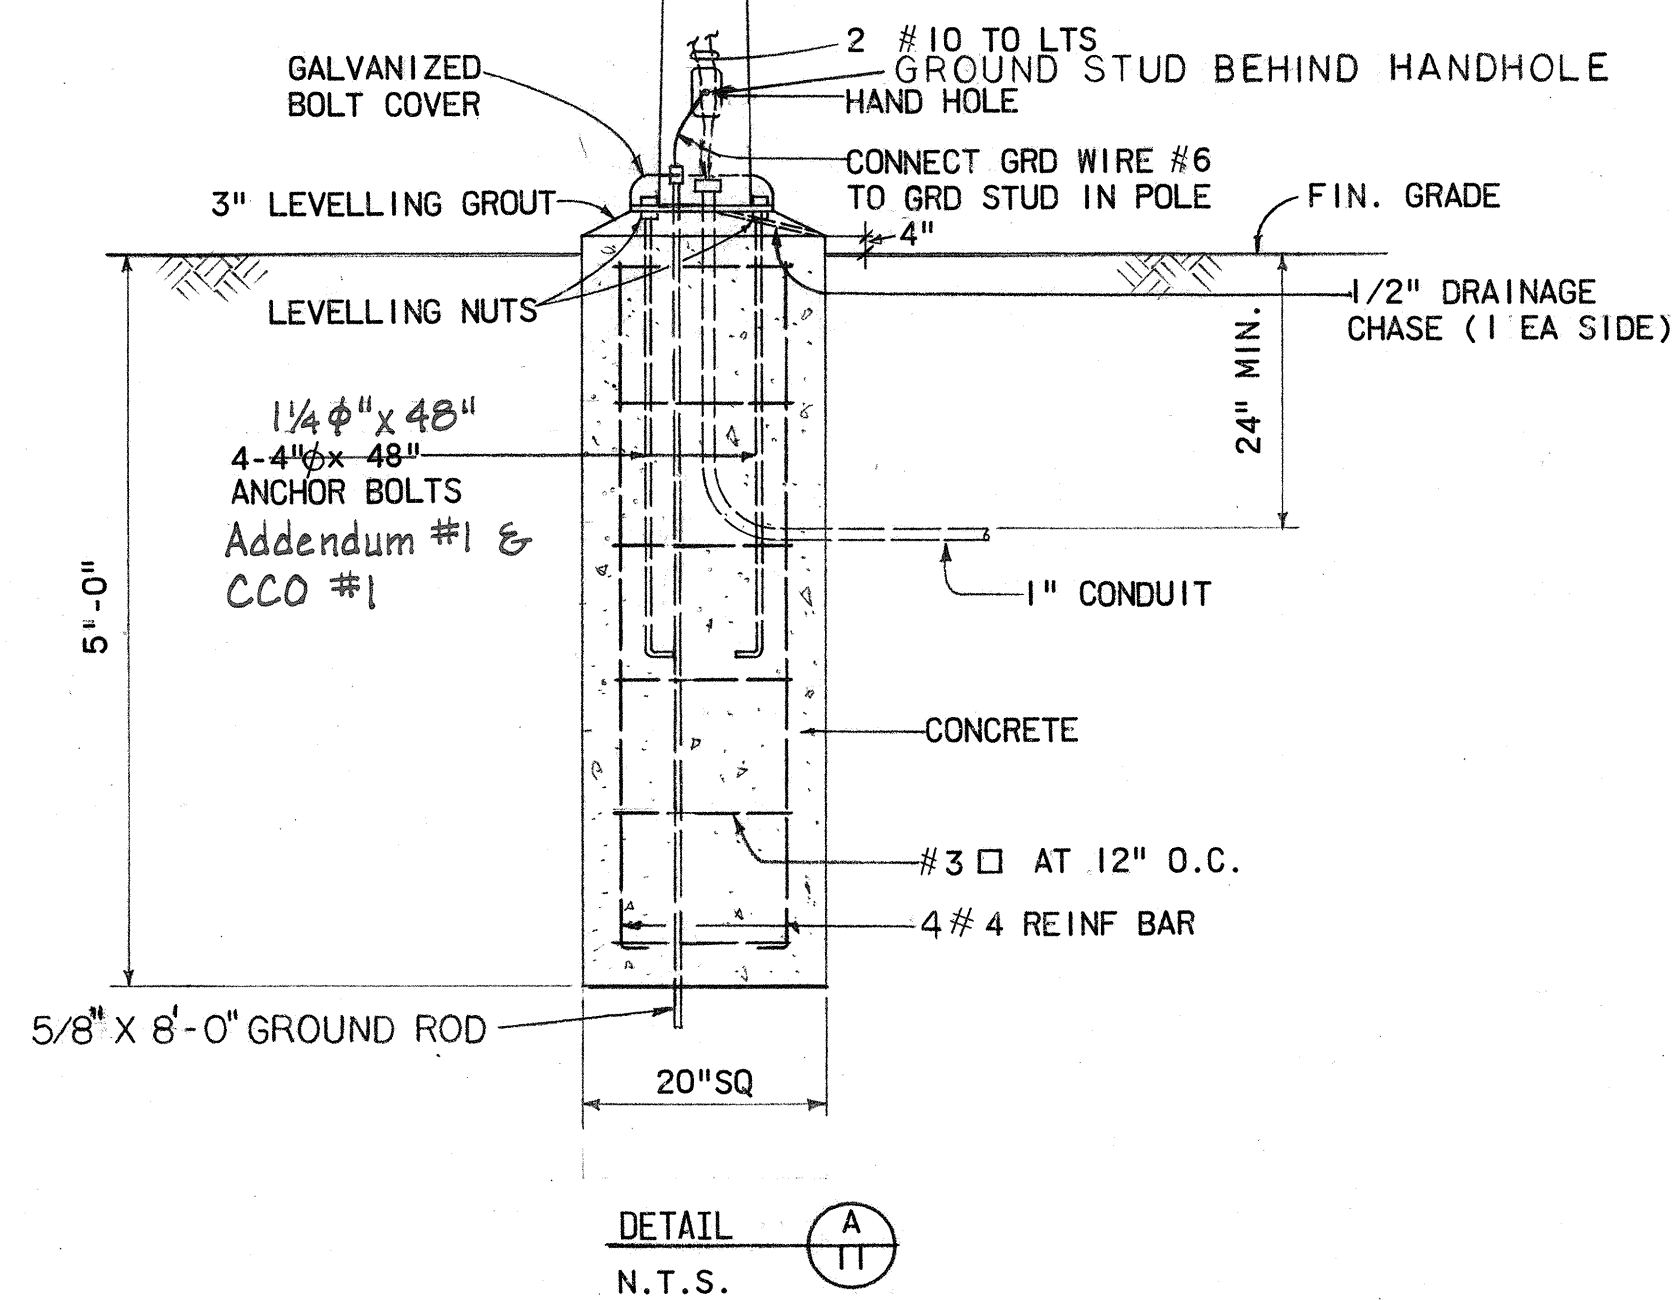
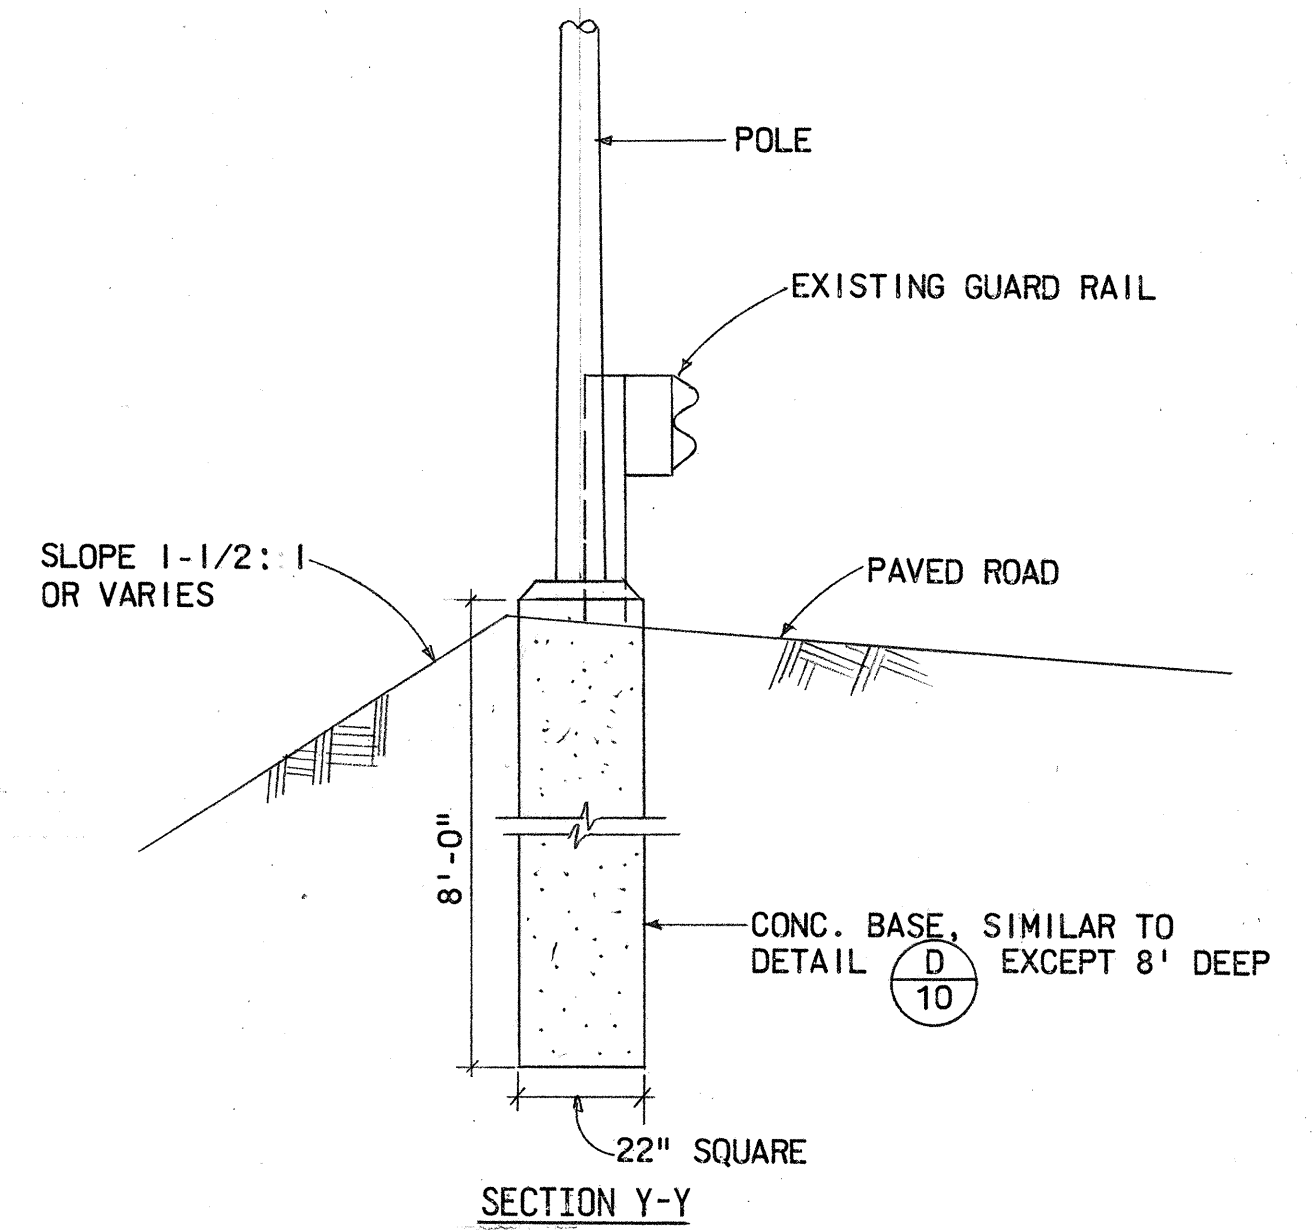
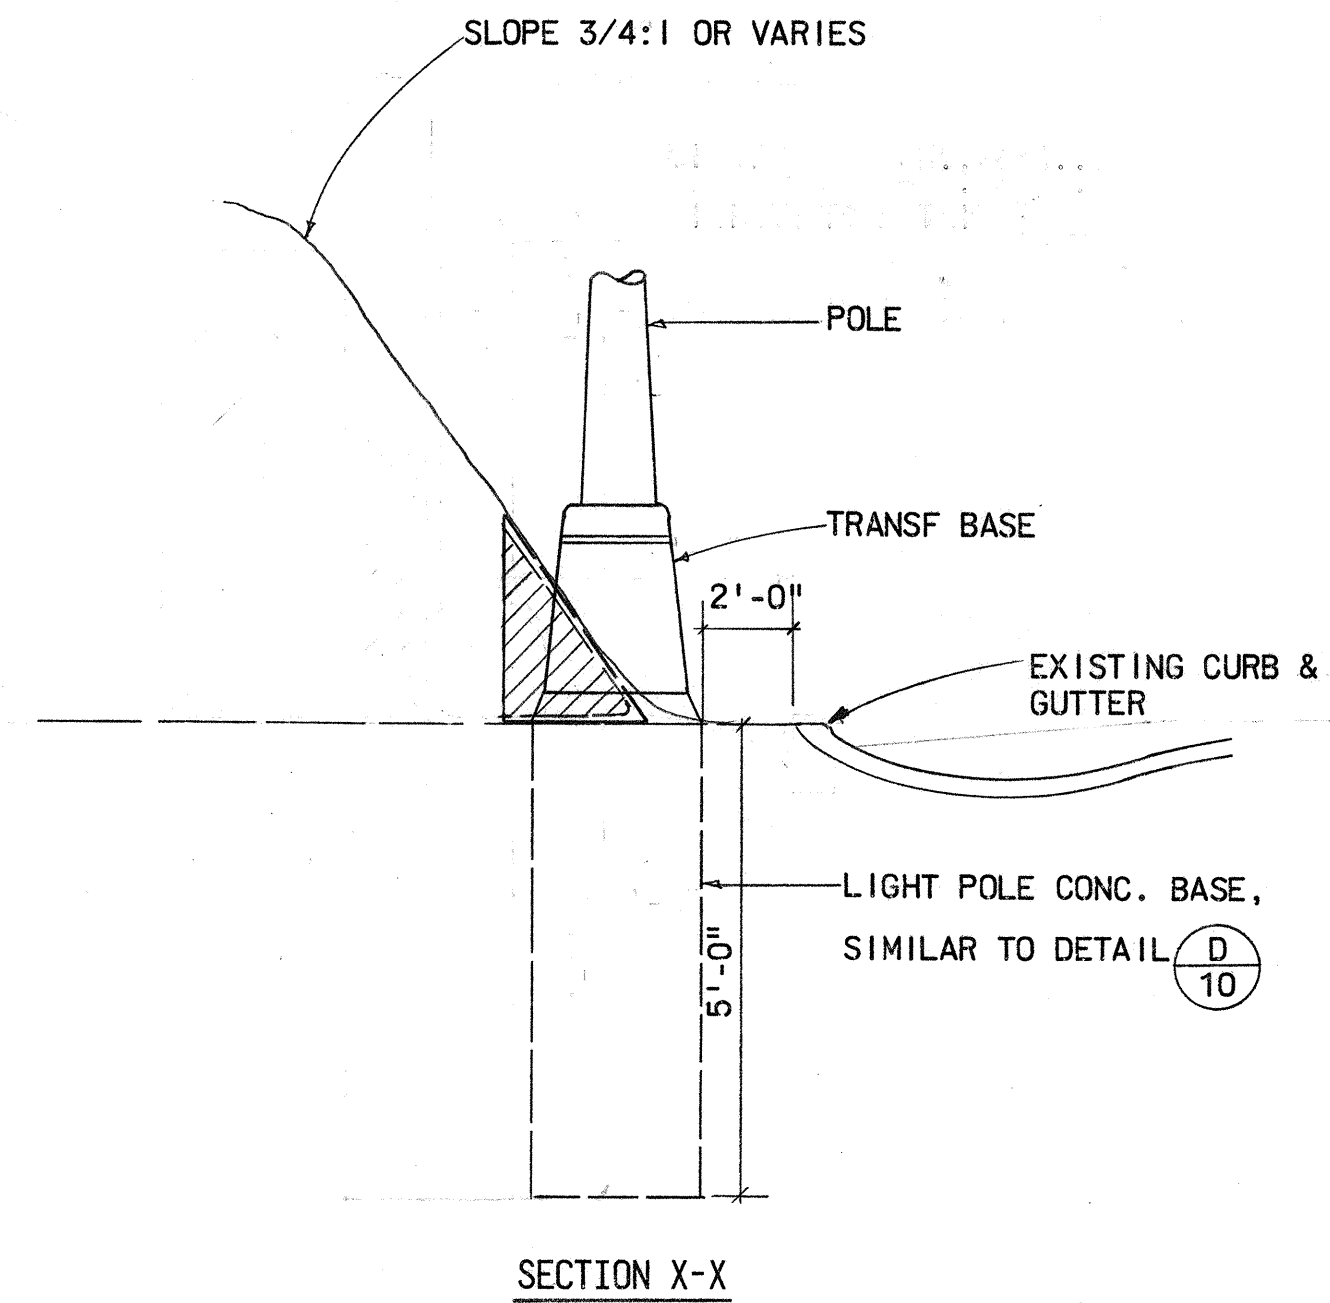





FED. ROAD DIST. NO.	STATE	FED. AID PROJ. NO.	FISCAL YEAR	SHEET NO.	TOTAL SHEETS
HAWAII	HAW.	61B-02-72	1974	11	13

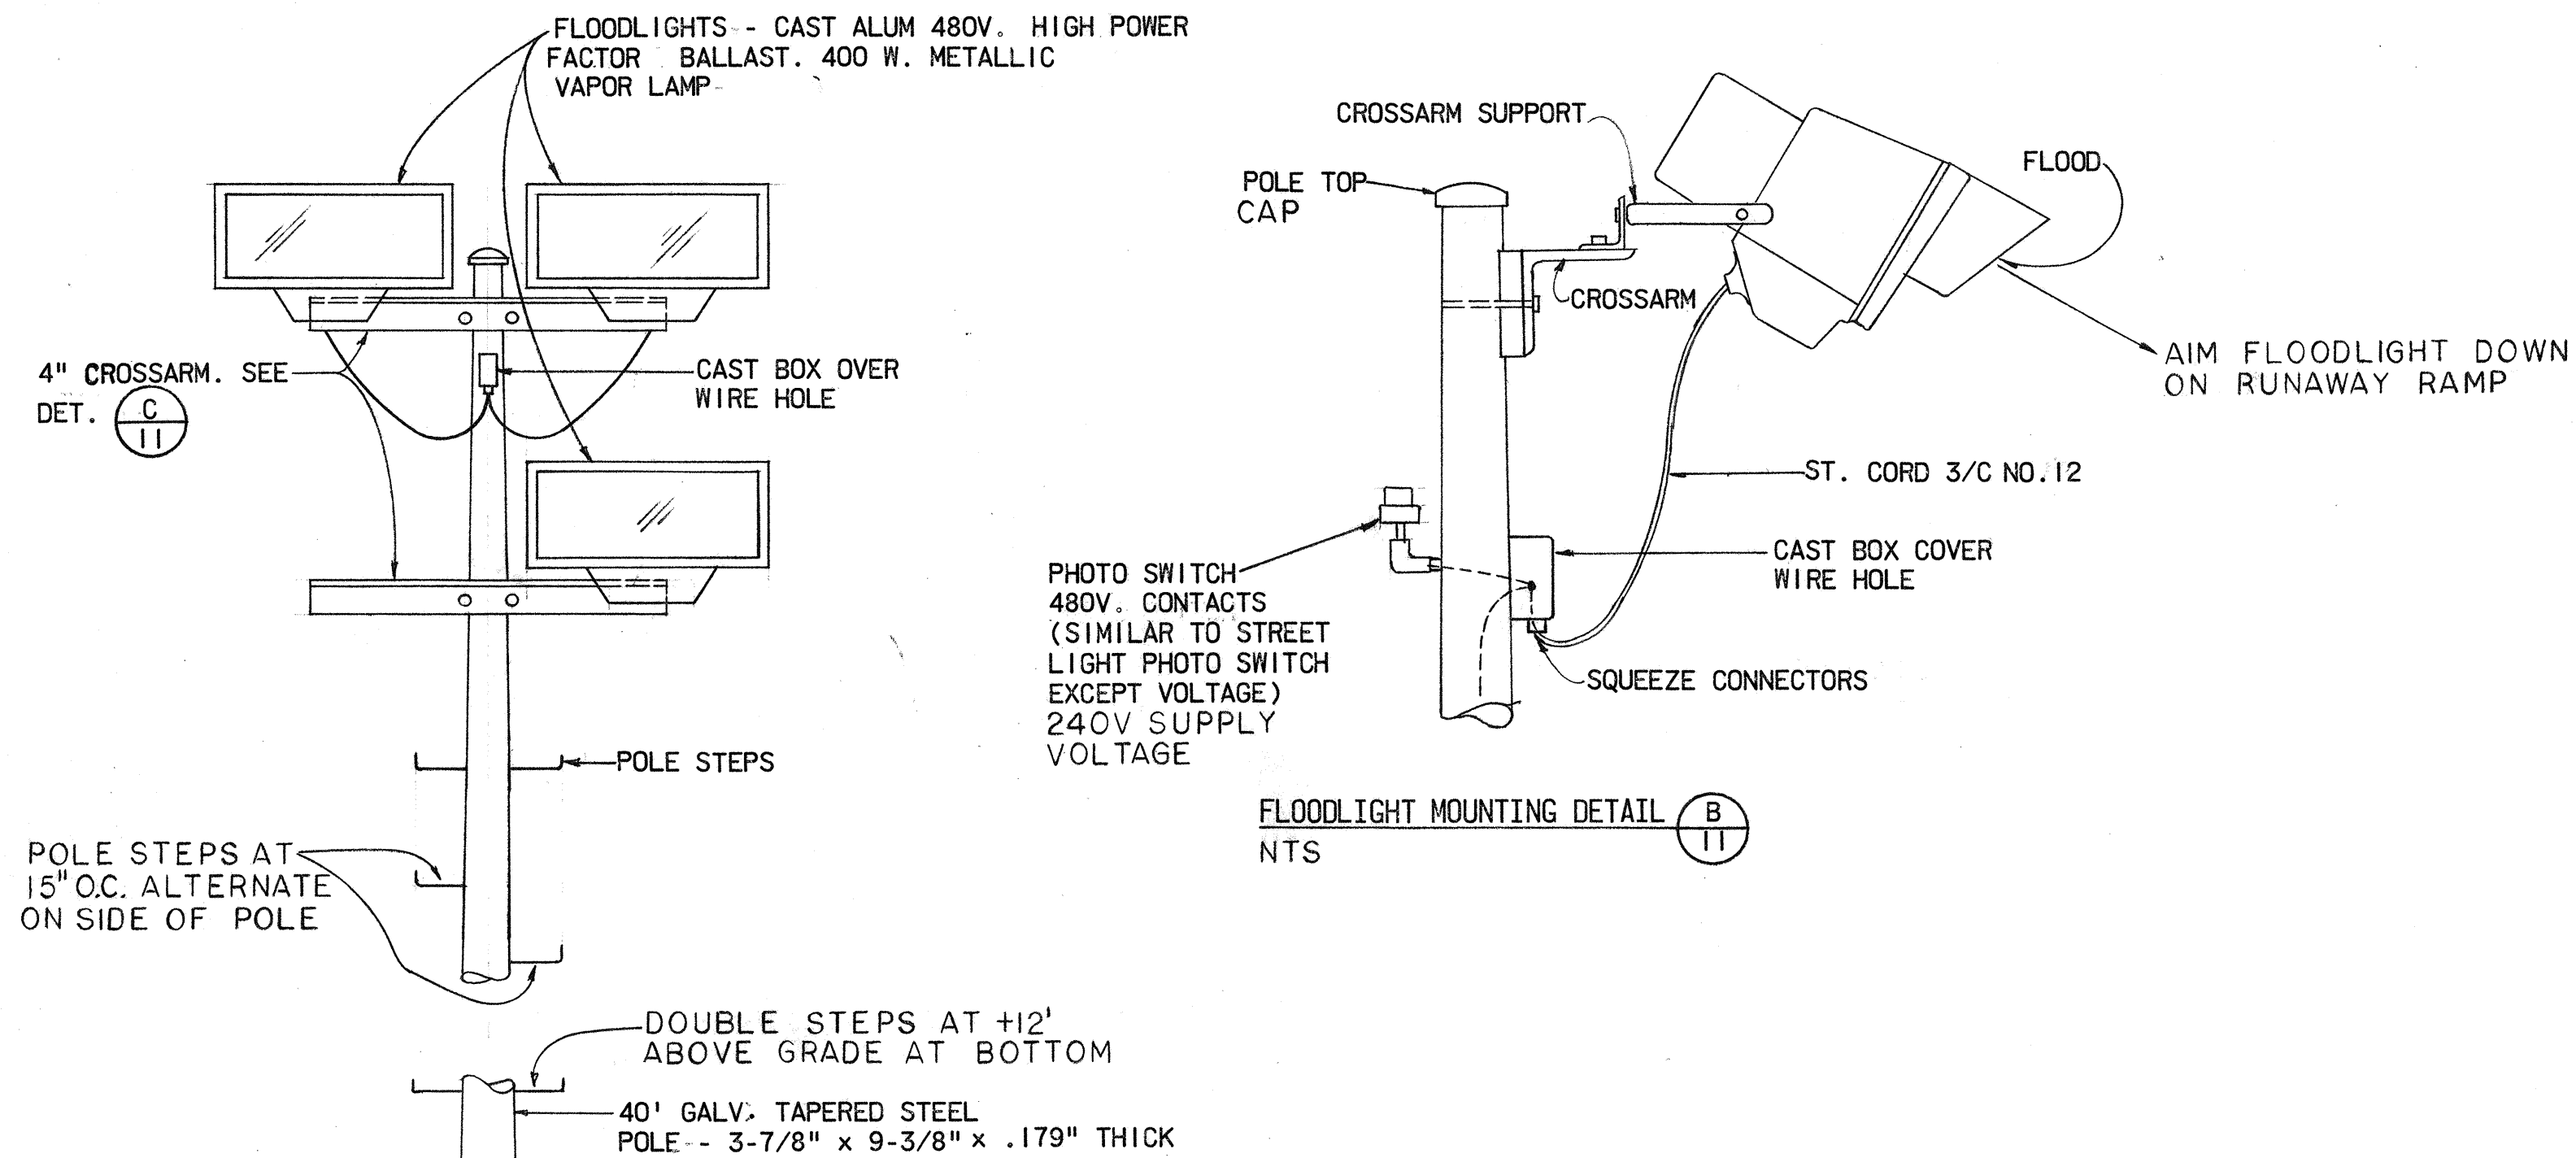

NOTE: CROSSARM ASSEMBLY & ALL HARDWARE TO BE HOT DIPPED GALVANIZED AFTER FABRICATION.

CROSSARM DETAIL (C) 11

N.T.S.

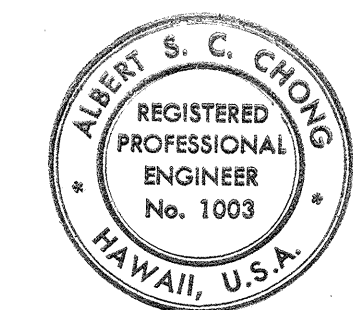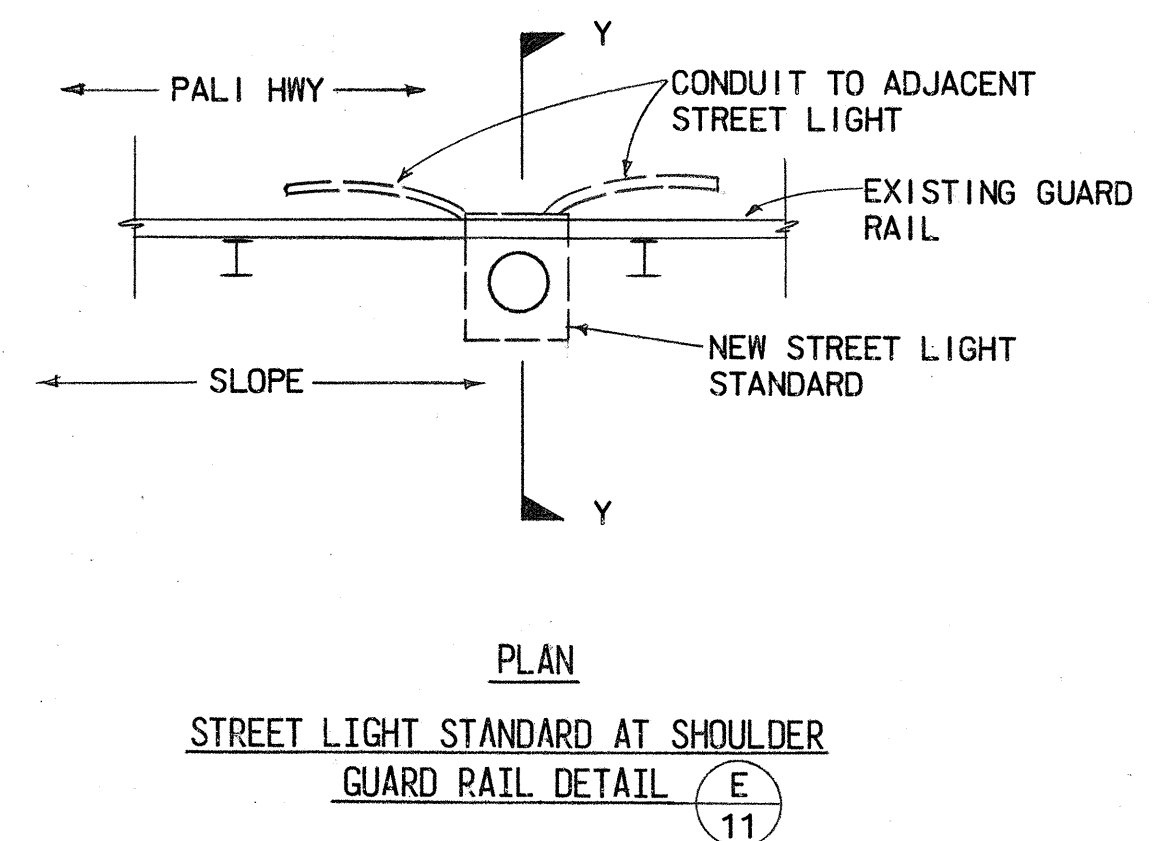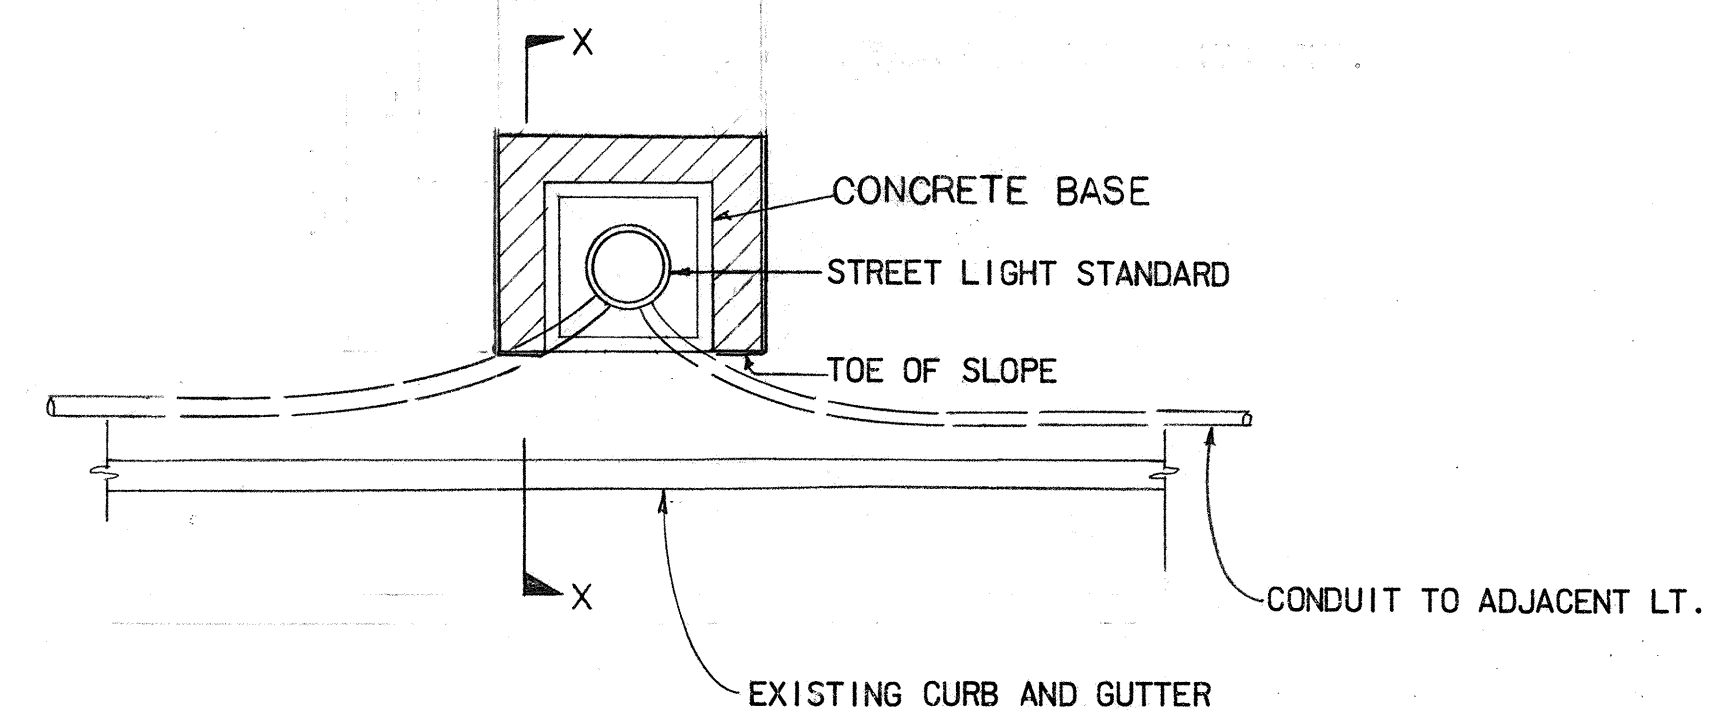

THIS WORK WAS PREPARED BY ME OR UNDER MY SUPERVISION

Albert S. C. Chong

Albert S. C. Chong, PE

STATE OF HAWAII
DEPARTMENT OF TRANSPORTATION
HIGHWAYS DIVISION

HIGHWAY LIGHTING IMPROVEMENT
ON PALI HIGHWAY
BETWEEN PALI TUNNEL AND
WAIMANALO JUNCTION
PROJECT NO: 61B-02-72

SHEET No. 11 OF 13 SHEETS