



FED. ROAD DIST. NO.	STATE	FED. AID PROJ. NO.	FISCAL YEAR	SHEET NO.	TOTAL SHEETS
HAWAII	HAW.	61B-02-72	1974	2	13

SYMBOLS

- NEW HIGHWAY LIGHTS, TWIN ARM 30 FT. SEE SHEET 10 FOR DETAIL
- EXISTING TWIN-ARM HIGHWAY LIGHT
- EXISTING HIGHWAY LIGHT
- NEW HIGHWAY LIGHTS, SINGLE ARM, SEE SHT. 10 FOR DETAIL
- PULL BOX, 'TYPE B'
- ⌵ NEW FLOOD LIGHT POLE
- EXISTING UNDERGROUND LINE
- - - NEW UNDERGROUND LINE
- L1-4-B L1=STREET LIGHT NO. 1
4=4 FEET MAST ARM
B=STREET LIGHT WITH TRANS. BASE
- ⌵ EXISTING FLOOD LIGHT POLE

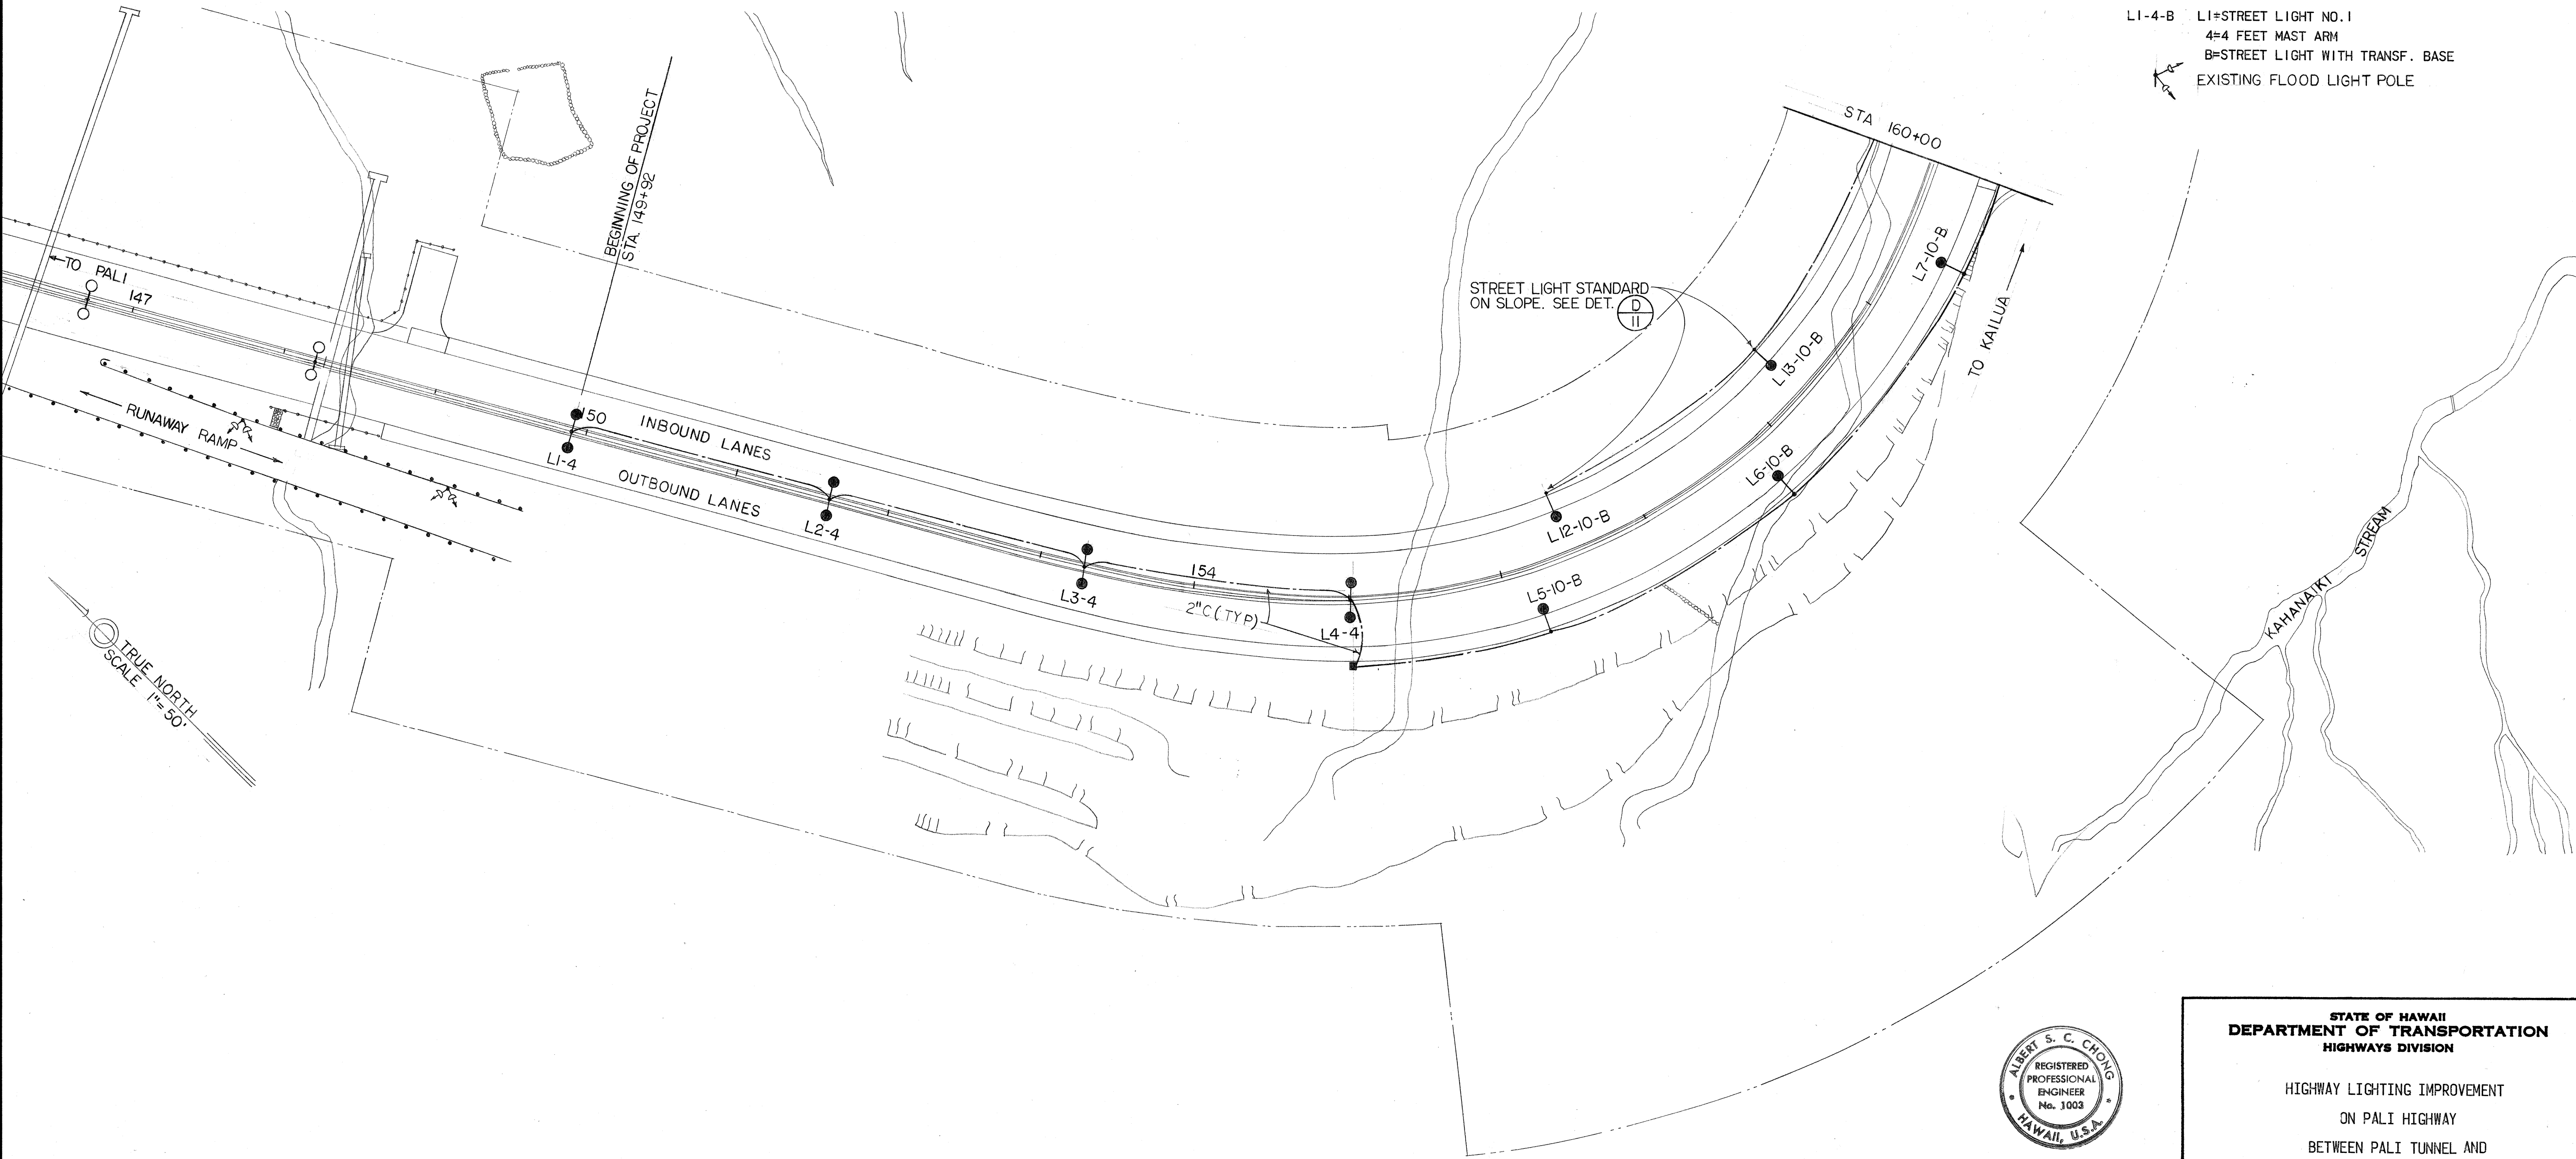

ORIGINAL PLAN	SURVEY PLOTTED BY	DATE
DESIGNED BY	DRAWN BY	
NOTED BY	CHECKED BY	
QUANTITIES BY		
CHECKED BY		

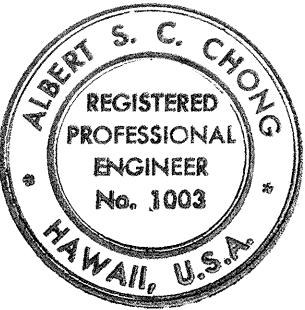


THIS WORK WAS PREPARED BY ME
OR UNDER MY SUPERVISION
Albert S. C. Chong
Albert S. C. Chong, PE

STATE OF HAWAII
DEPARTMENT OF TRANSPORTATION
HIGHWAYS DIVISION

HIGHWAY LIGHTING IMPROVEMENT
ON PALI HIGHWAY
BETWEEN PALI TUNNEL AND
WAIMANALO JUNCTION
PROJECT NO. 61B-02-72


SHEET No. 2 OF 13 SHEETS

FED. ROAD DIST. NO.	STATE	FED. AID PROJ. NO.	FISCAL YEAR	SHEET NO.	TOTAL SHEETS
HAWAII	HAW.	61B-02-72	1974	3	13

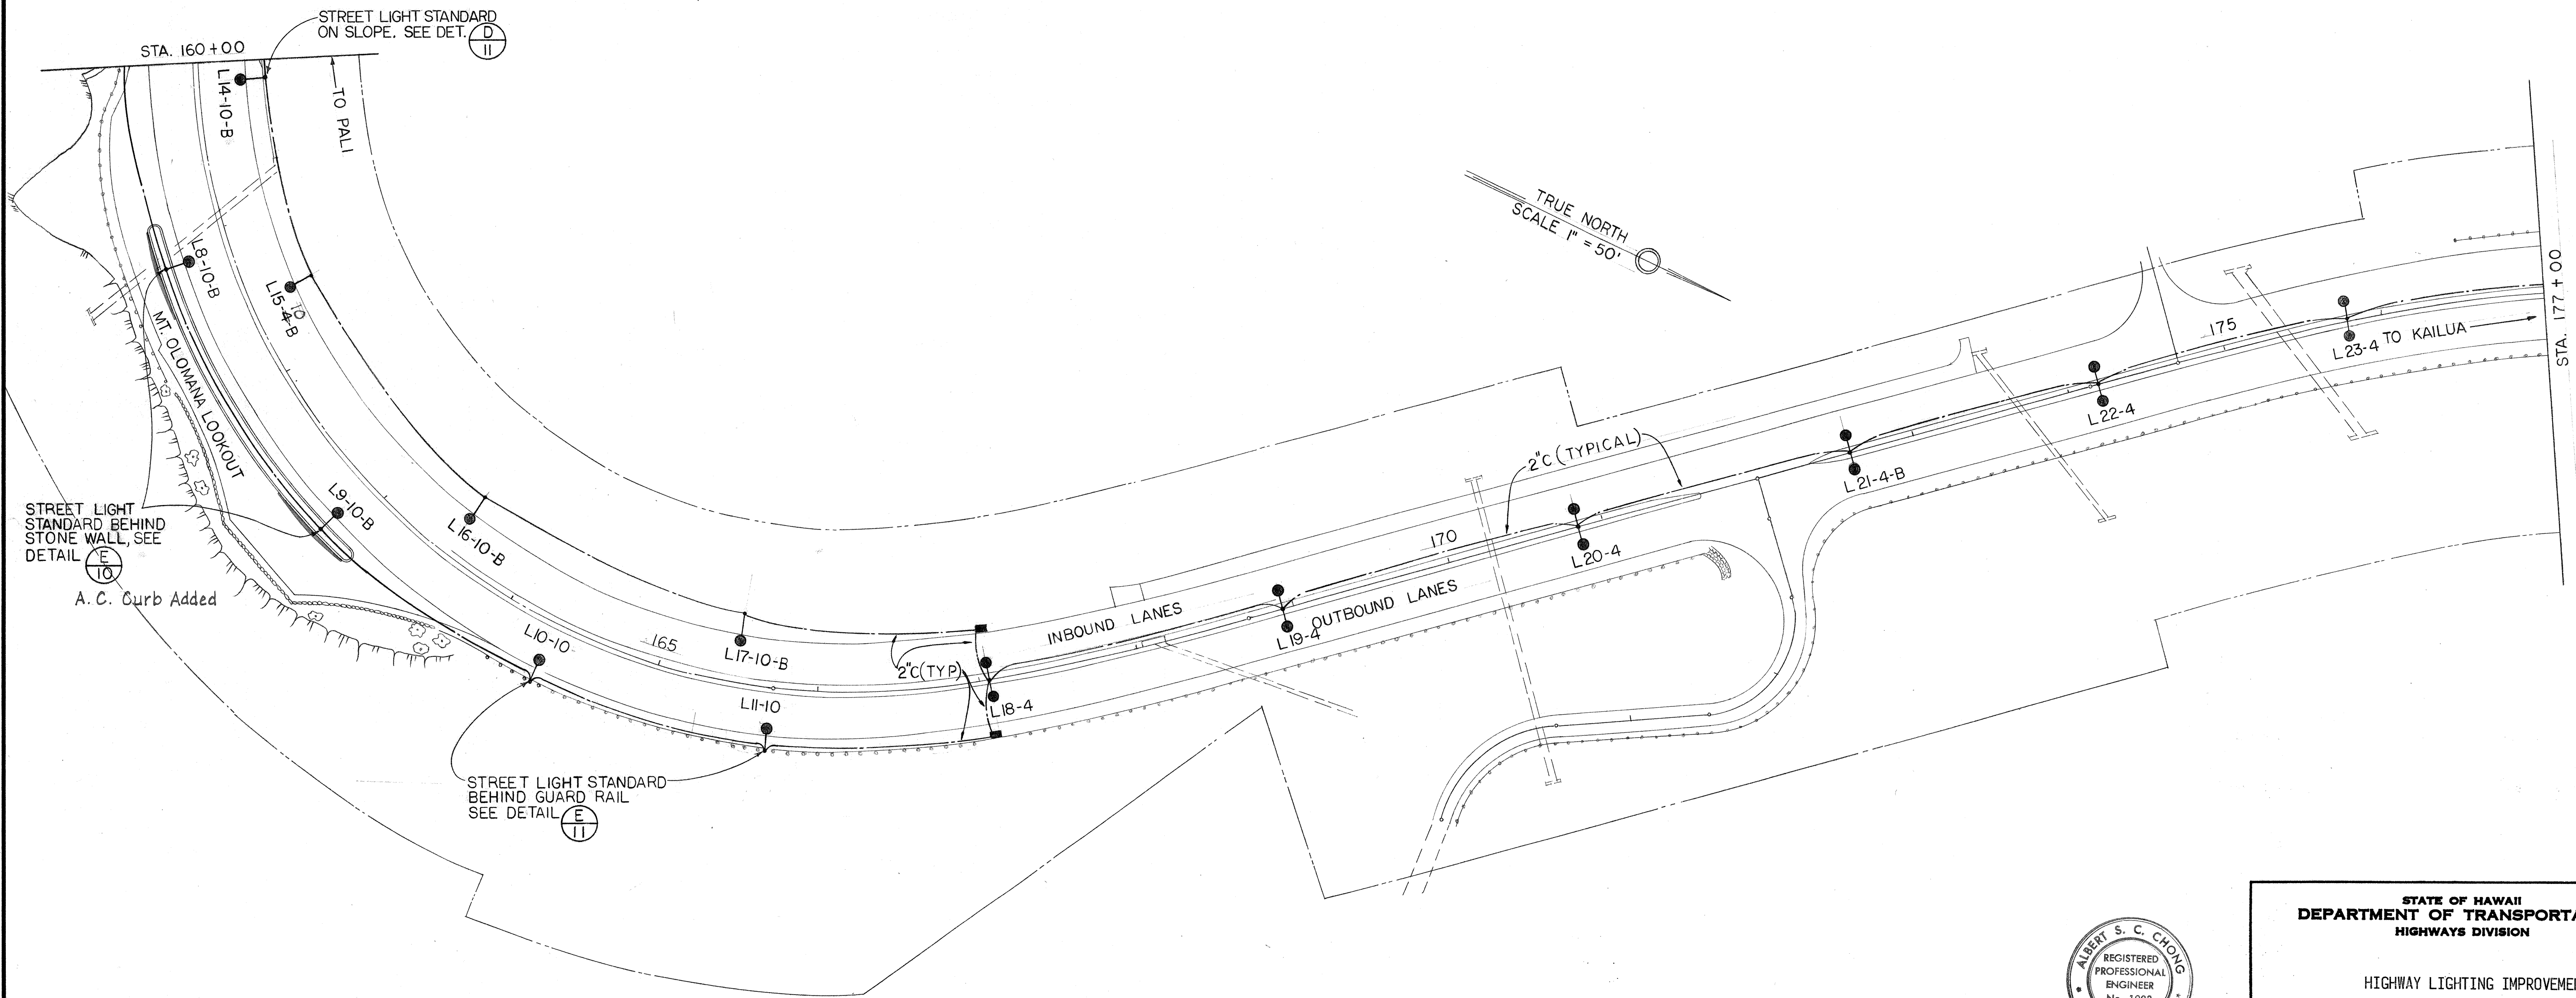

DATE	_____
SURVEY PLOTTED BY	_____
DRAWN BY	_____
CHECKED BY	_____
QUANTITIES BY	_____
NOTED BY	_____
ORIGINAL PLAN	_____
NOTE BOOK	_____
No.	_____

ROMAN CATHOLIC BISHOP OF HONOLULU

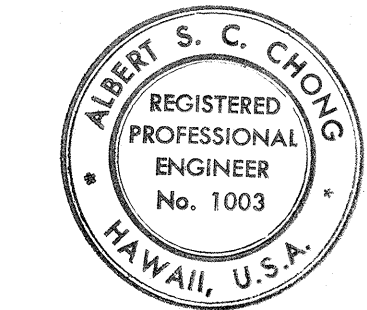


THIS WORK WAS PREPARED BY ME
OR UNDER MY SUPERVISION
Albert S. C. Chong
Albert S. C. Chong, PE

STATE OF HAWAII
DEPARTMENT OF TRANSPORTATION
HIGHWAYS DIVISION

HIGHWAY LIGHTING IMPROVEMENT
ON PALI HIGHWAY
BETWEEN PALI TUNNEL AND
WAIMANALO JUNCTION
PROJECT NO. 61B-02-72

SHEET No. 3 OF 13 SHEETS

FED. ROAD DIST. NO.	STATE	FED. AID PROJ. NO.	FISCAL YEAR	SHEET NO.	TOTAL SHEETS
HAWAII	HAW.	61B-02-72	1974	4	13

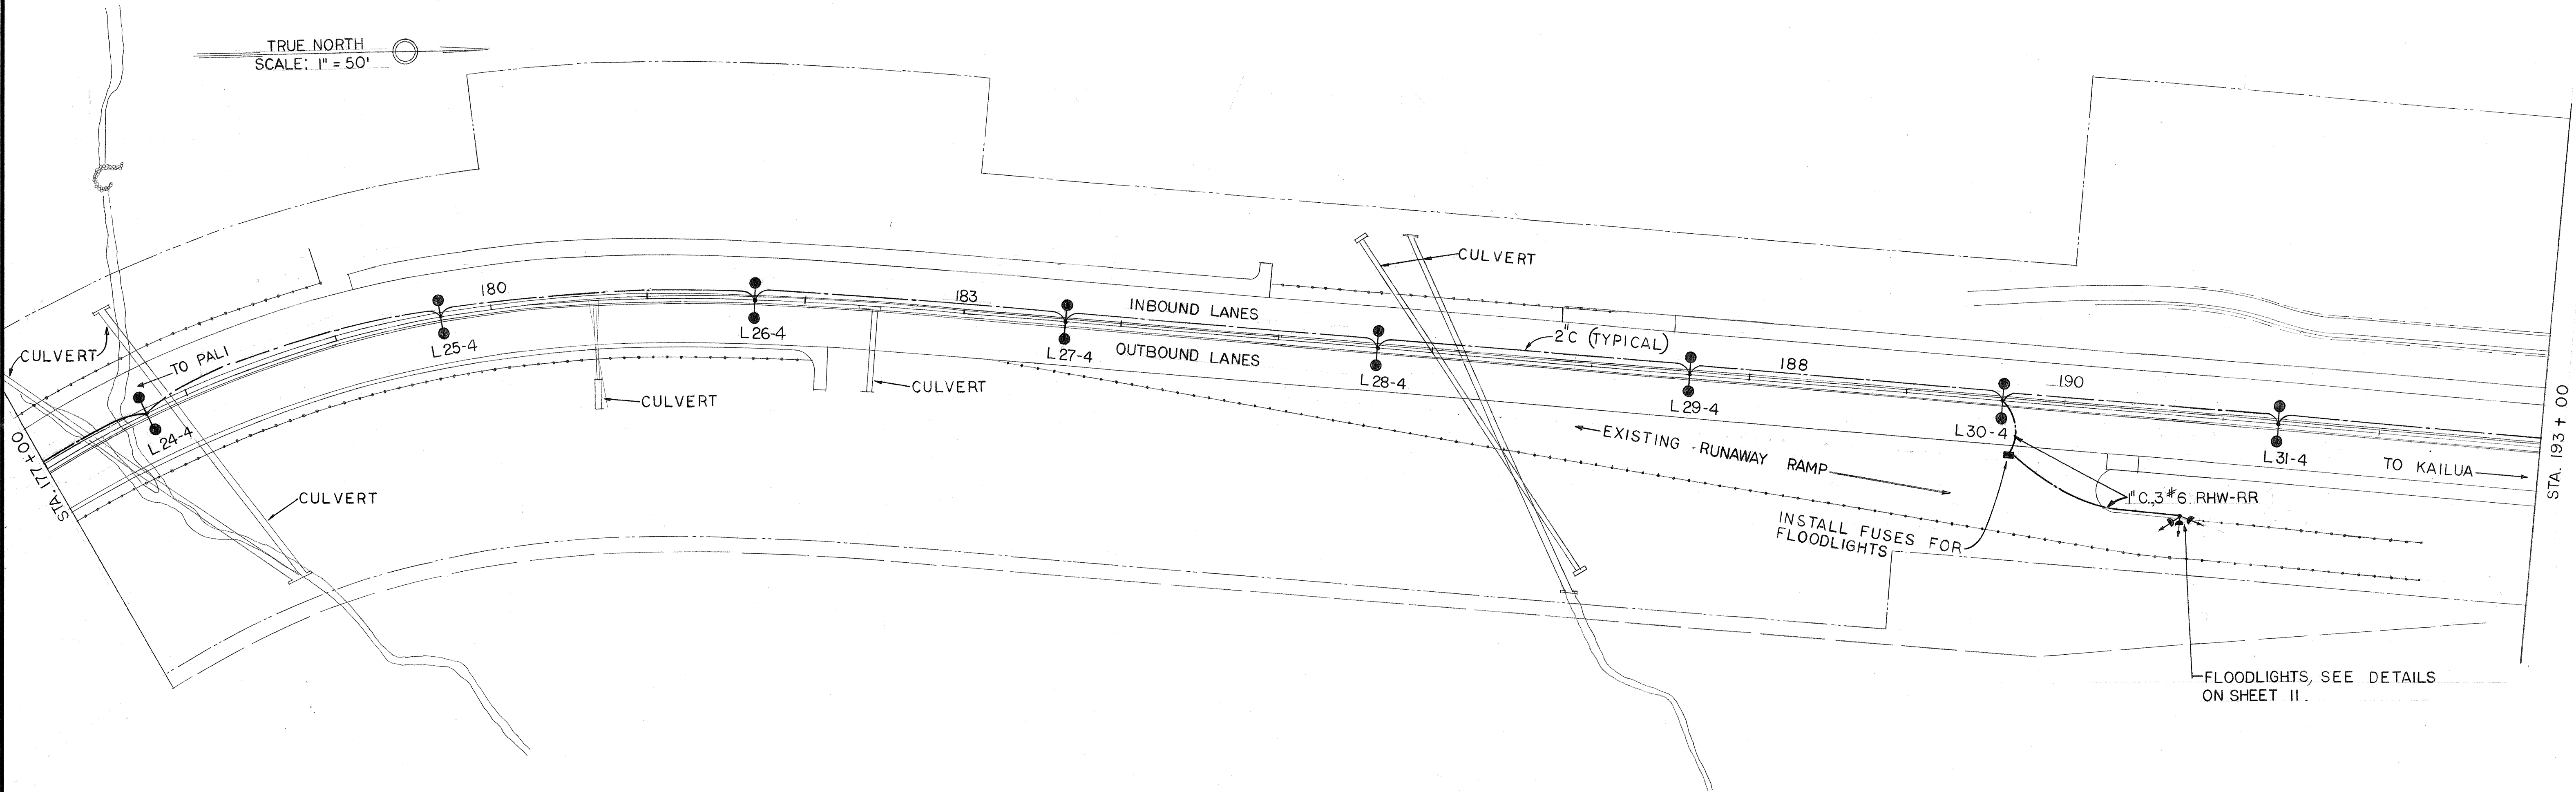

SURVEY PLOTTED BY	DATE
DRAWN BY	
DESIGNED BY	
QUANTITIES BY	
CHECKED BY	
ORIGINAL PLAN	
NOTE BOOK	
No.	



THIS WORK WAS PREPARED BY ME
OR UNDER MY SUPERVISION
Albert S. C. Chong
Albert S. C. Chong, PE


STATE OF HAWAII
DEPARTMENT OF TRANSPORTATION
HIGHWAYS DIVISION

HIGHWAY LIGHTING IMPROVEMENT


ON PALI HIGHWAY
BETWEEN PALI TUNNEL AND
WAIMANALO JUNCTION
PROJECT NO. 61B-02-72

SHEET No. 4 OF 13 SHEETS

FED. ROAD DIST. NO.	STATE	FED. AID PROJ. NO.	FISCAL YEAR	SHEET NO.	TOTAL SHEETS
HAWAII	HAW.	61B-02-72	1974	5	13

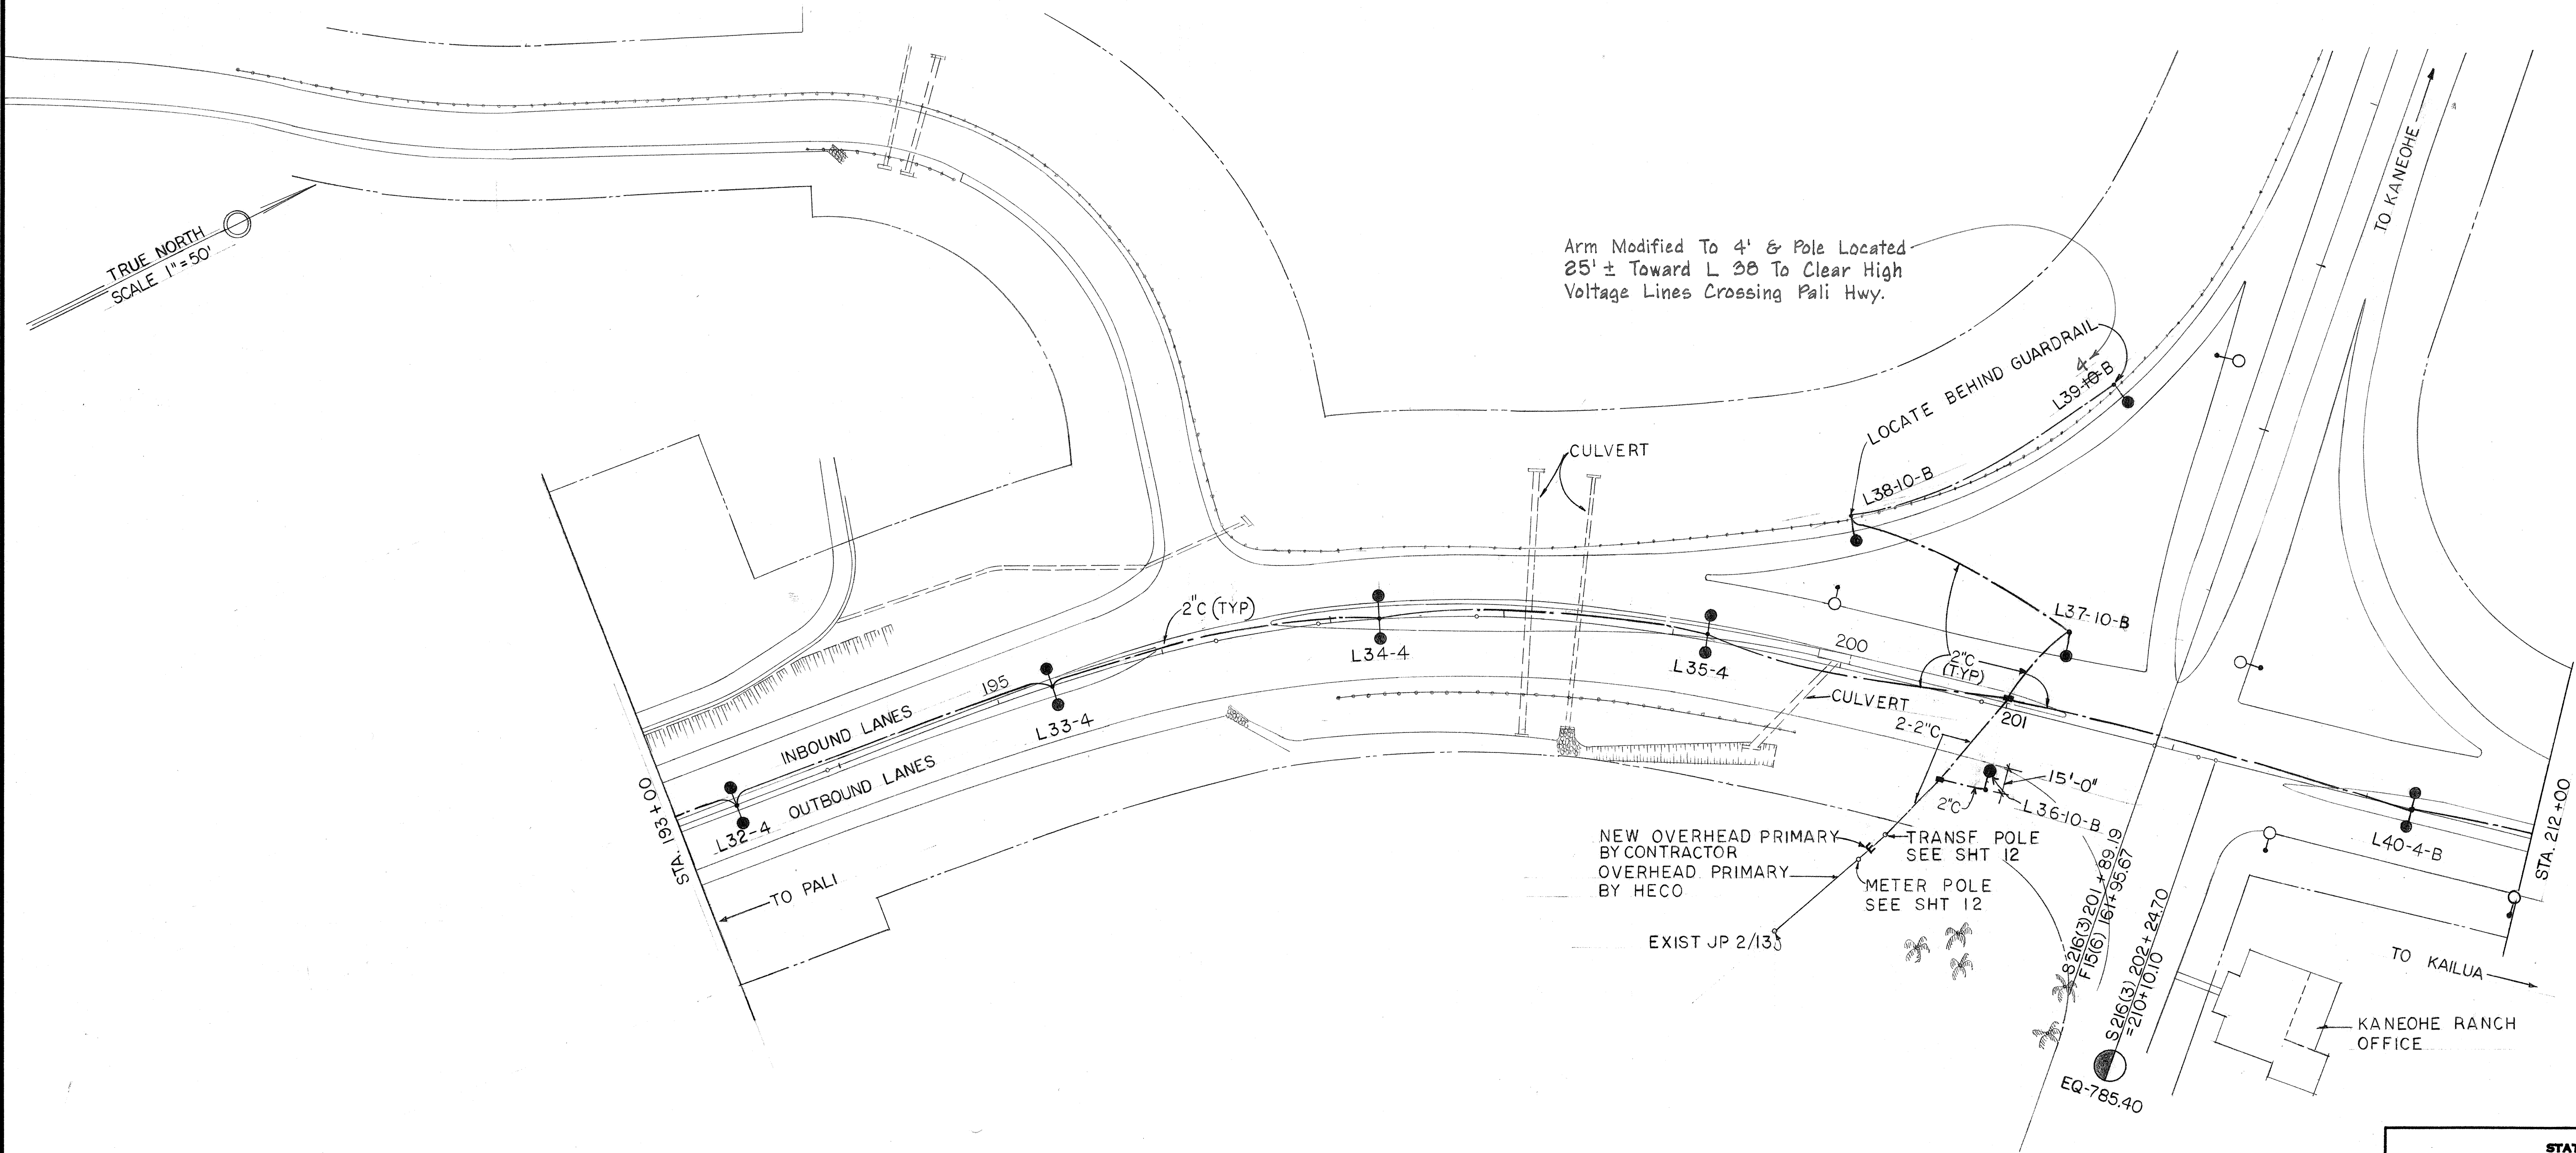

ORIGINAL PLAN	DATE
SURVEY PLOTTED BY	
DESIGNED BY	
QUANTITIES BY	
CHECKED BY	
NO.	

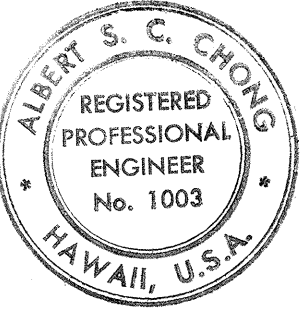


THIS WORK WAS PREPARED BY ME
OR UNDER MY SUPERVISION

Albert S. C. Chong
Albert S. C. Chong, PE

STATE OF HAWAII
DEPARTMENT OF TRANSPORTATION
HIGHWAYS DIVISION

HIGHWAY LIGHTING IMPROVEMENT
ON PALI HIGHWAY
BETWEEN PALI TUNNEL AND
WAIMANALO JUNCTION
PROJECT NO. 61B-02-72

FED. ROAD DIST. NO.	STATE	FED. AID PROJ. NO.	FISCAL YEAR	SHEET NO.	TOTAL SHEETS
HAWAII	HAW.	61B-02-72	1974	6	13

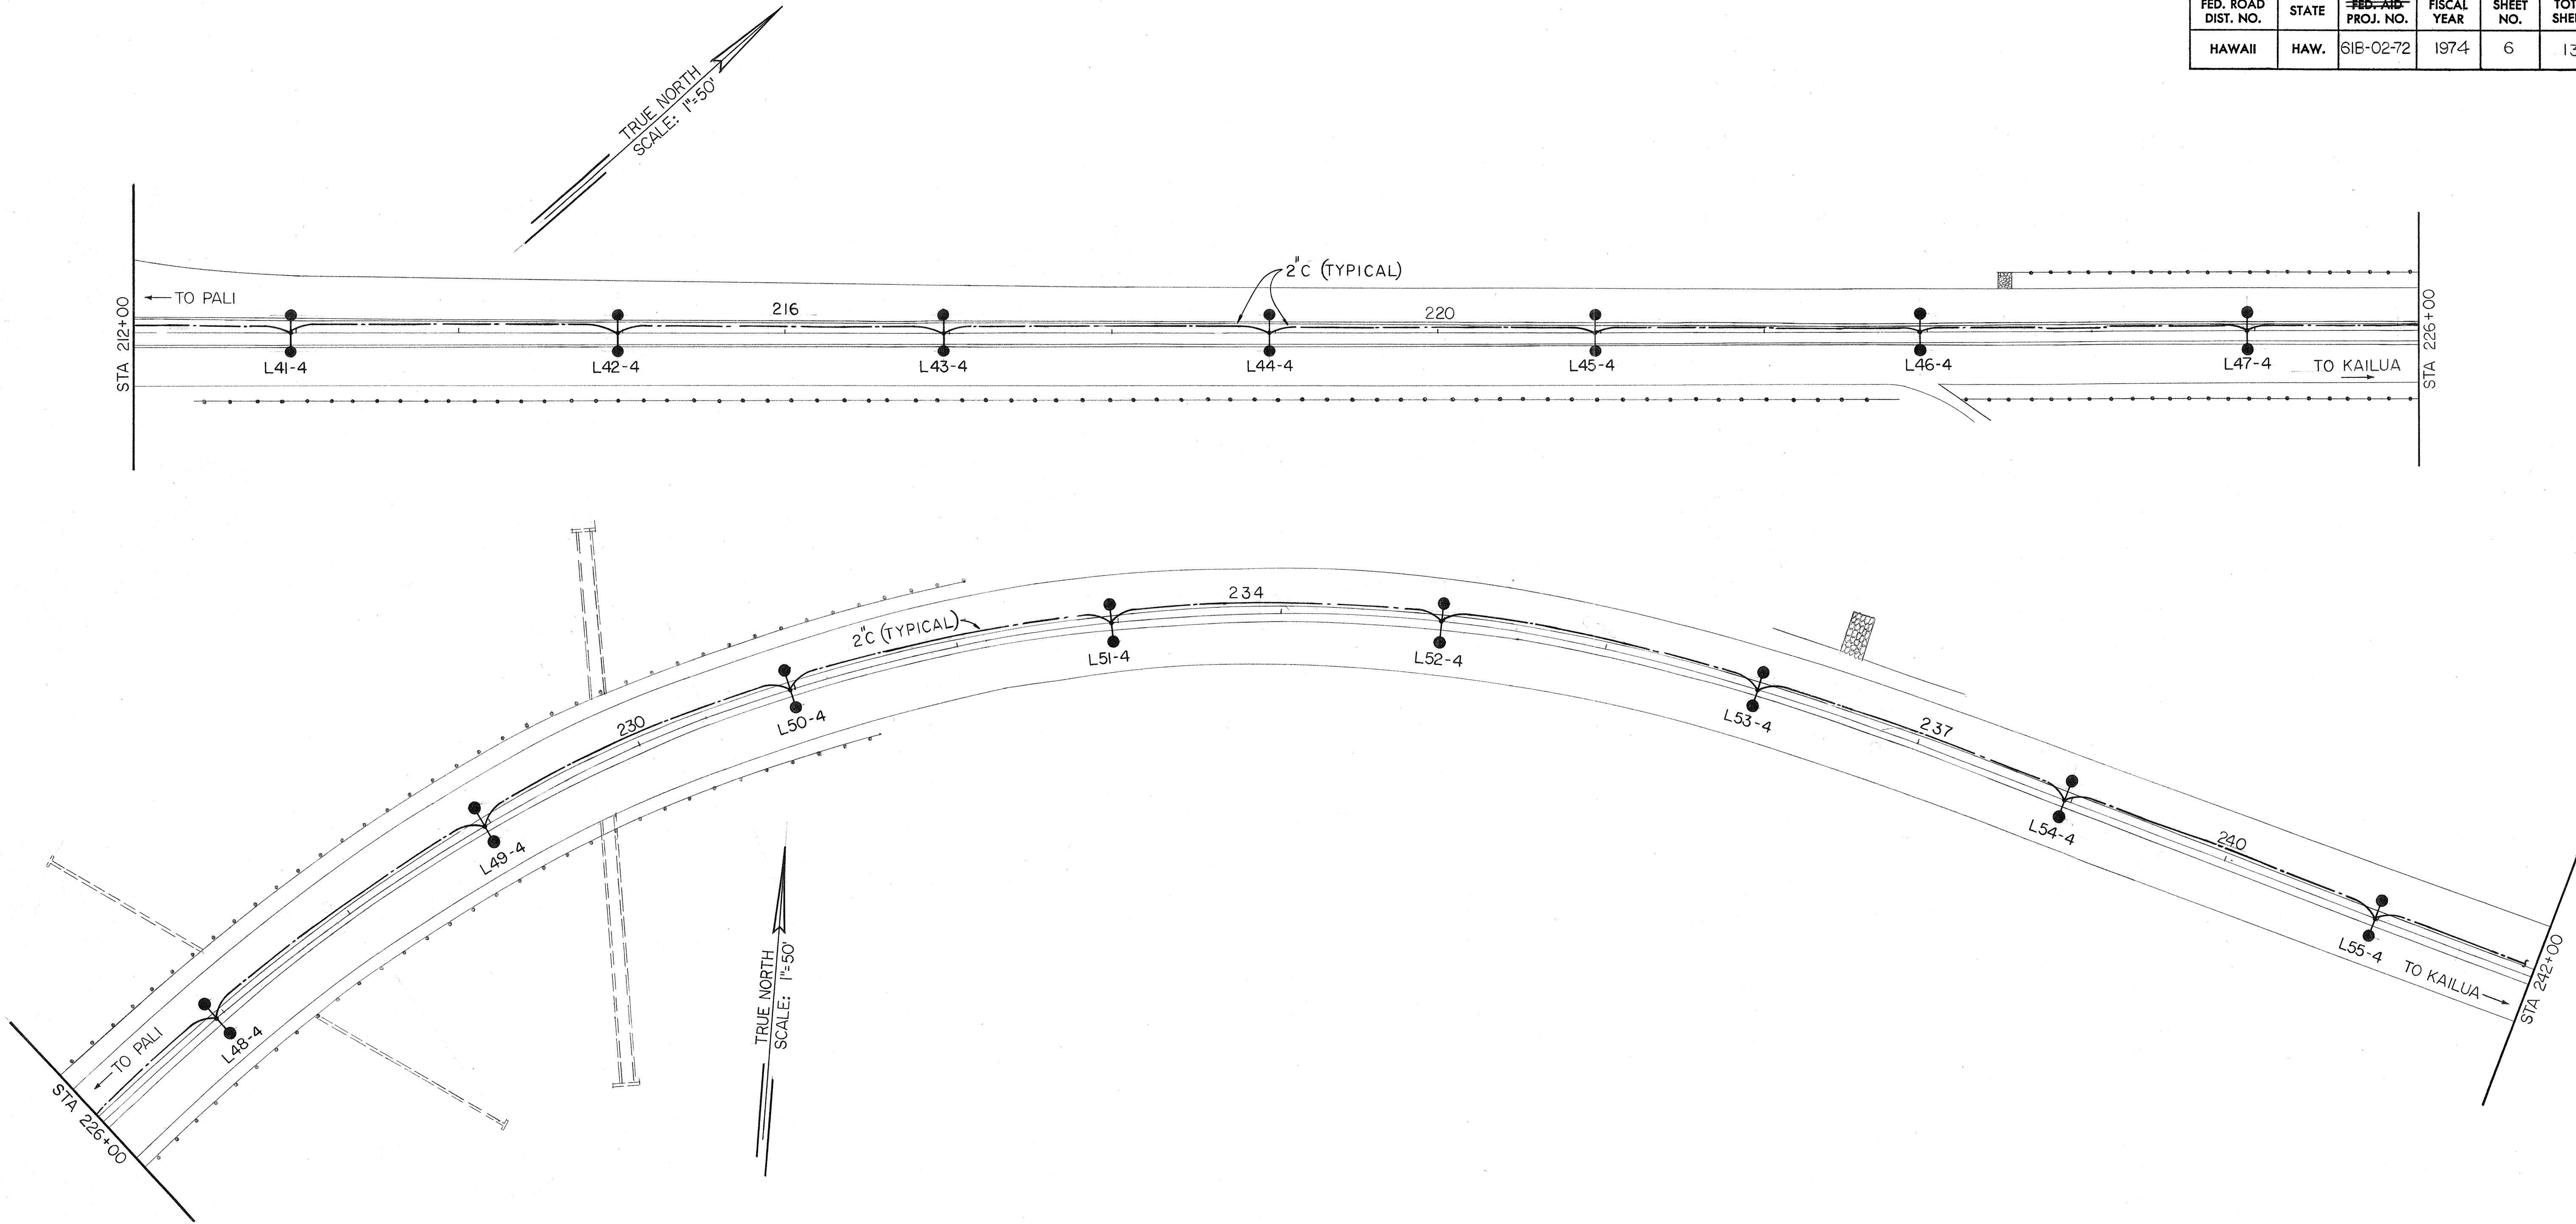

ORIGINAL PLAN	SURVEY PLOTTED BY	DATE
NOTE BOOK	DRAWN BY	
NO.	CHECKED BY	





THIS WORK WAS PREPARED BY ME
OR UNDER MY SUPERVISION
Albert S. C. Chong
Albert S. C. Chong, PE

STATE OF HAWAII
DEPARTMENT OF TRANSPORTATION
HIGHWAYS DIVISION

HIGHWAY LIGHTING IMPROVEMENT
ON PALI HIGHWAY
BETWEEN PALI TUNNEL AND
WAIMANALO JUNCTION
PROJECT NO. 61B-02-72

SHEET No. 6 OF 13 SHEETS

FED. ROAD DIST. NO.	STATE	FED. AID PROJ. NO.	FISCAL YEAR	SHEET NO.	TOTAL SHEETS
HAWAII	HAW.	61B-02-72	1974	7	13

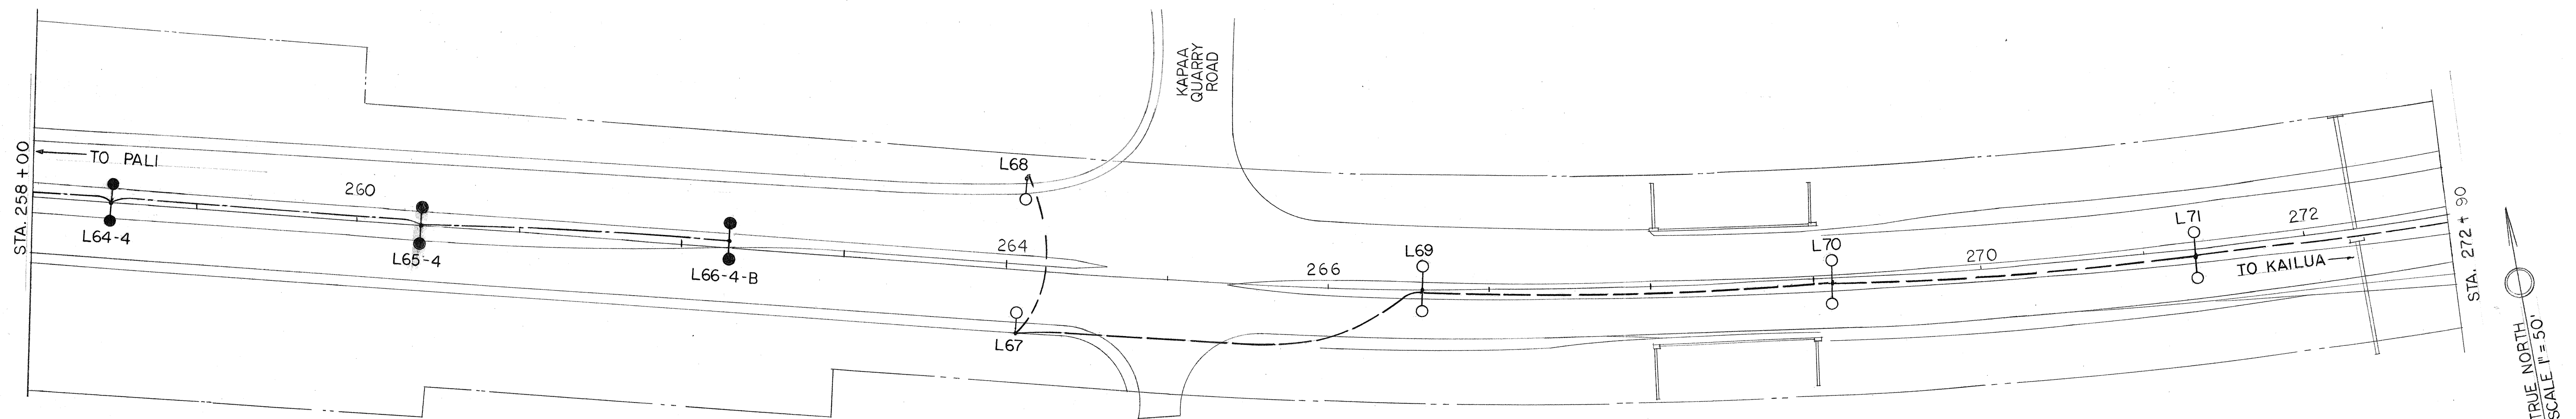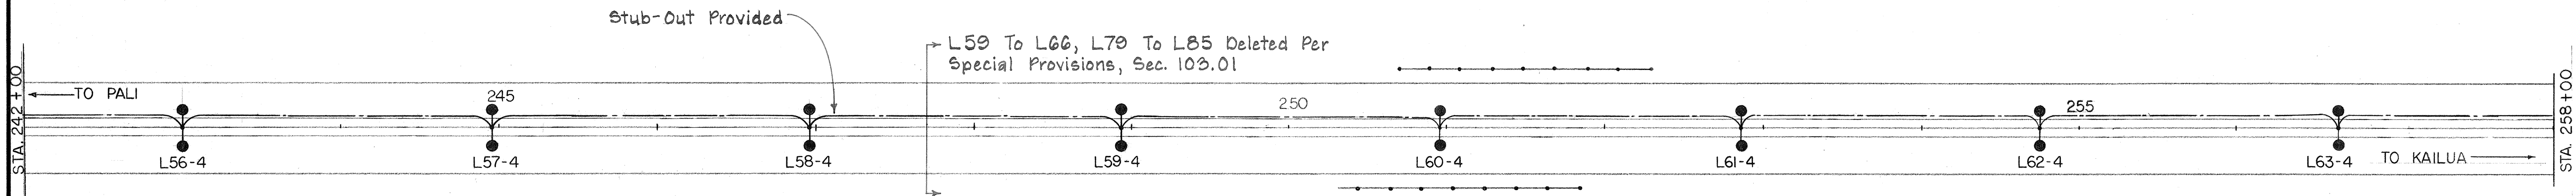

ORIGINAL PLAN	SURVEY PLOTTED BY	DATE
NOTE BOOK	DRAWN BY	
	DESIGNED BY	
	CHECKED BY	
No.		




THIS WORK WAS PREPARED BY ME
OR UNDER MY SUPERVISION
Albert S. C. Chong
Albert S. C. Chong, PE

STATE OF HAWAII
DEPARTMENT OF TRANSPORTATION
HIGHWAYS DIVISION

HIGHWAY LIGHTING IMPROVEMENT
ON PALI HIGHWAY
BETWEEN PALI TUNNEL AND
WAIMANALO JUNCTION
PROJECT NO. 61B-02-72


SHEET No. 7 OF 13 SHEETS

FED. ROAD DIST. NO.	STATE	FED. AID PROJ. NO.	FISCAL YEAR	SHEET NO.	TOTAL SHEETS
HAWAII	HAW.	61B-02-72	1974	8	13

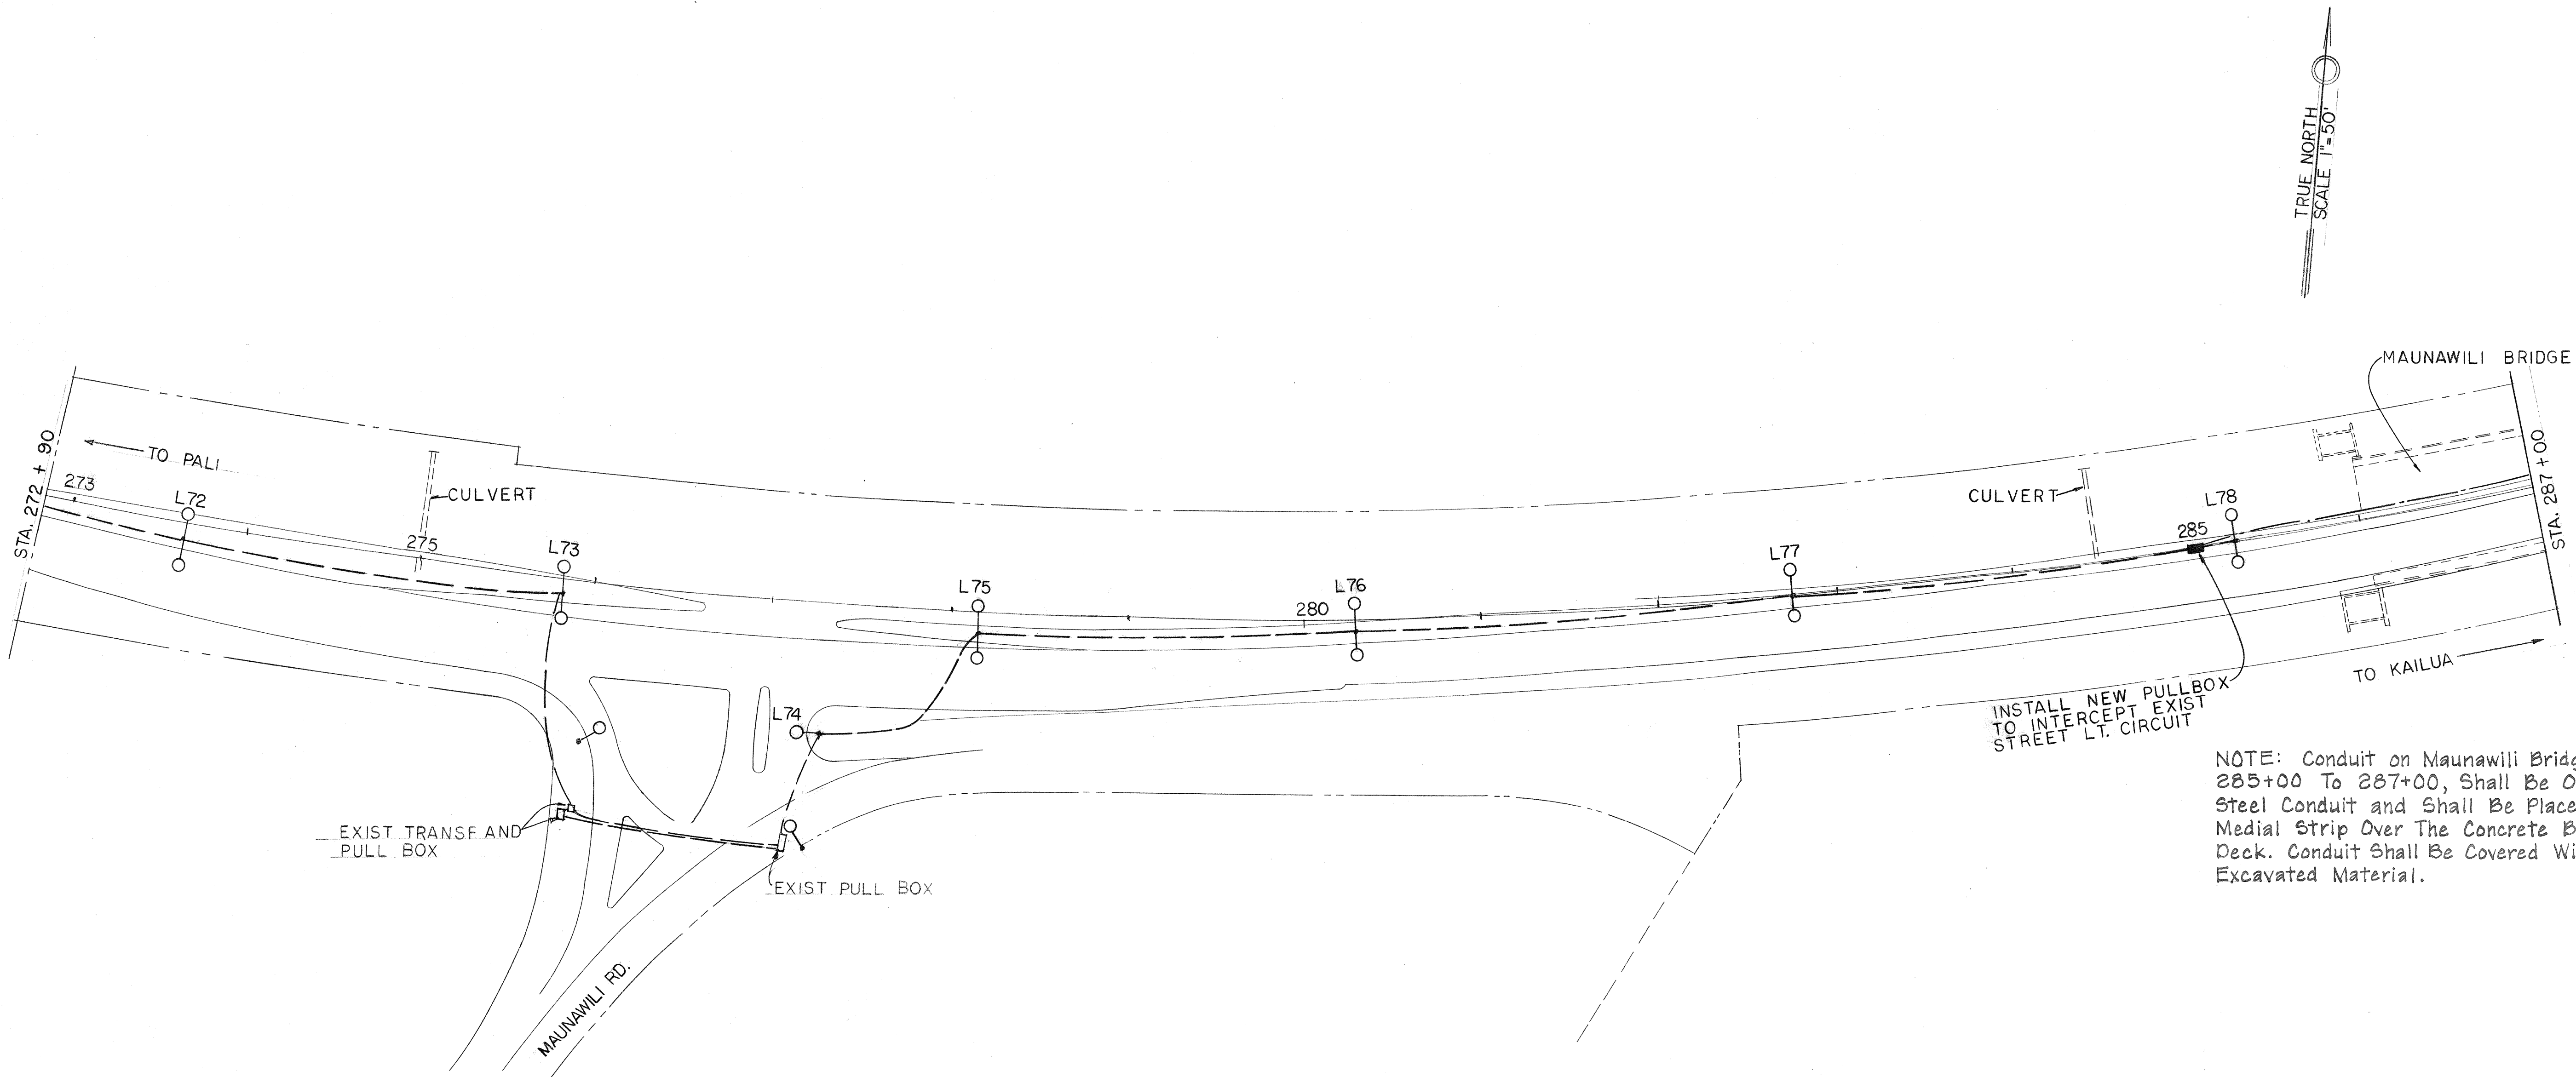

NOTE: Conduit on Maunawili Bridge, Station 285+00 To 287+00, Shall Be Of Galvanized Steel Conduit and Shall Be Placed In The Medial Strip Over The Concrete Bridge Deck. Conduit Shall Be Covered With Excavated Material.

SURVEY PLOTTED BY	DATE
DRAWN BY	
CHECKED BY	
NOTED BY	
NO.	

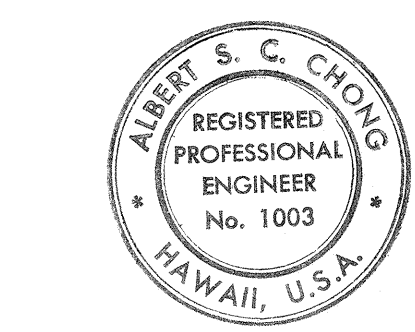


THIS WORK WAS PREPARED BY ME
OR UNDER MY SUPERVISION
Albert S. C. Chong
Albert S. C. Chong, P.E.


STATE OF HAWAII
DEPARTMENT OF TRANSPORTATION
HIGHWAYS DIVISION

HIGHWAY LIGHTING IMPROVEMENT
ON PALI HIGHWAY
BETWEEN PALI TUNNEL AND
WAIMANALO JUNCTION
PROJECT NO. 61B-02-72

FED. ROAD DIST. NO.	STATE	FED. AID PROJ. NO.	FISCAL YEAR	SHEET NO.	TOTAL SHEETS
HAWAII	HAW.	61B-02-72	1974	9	13

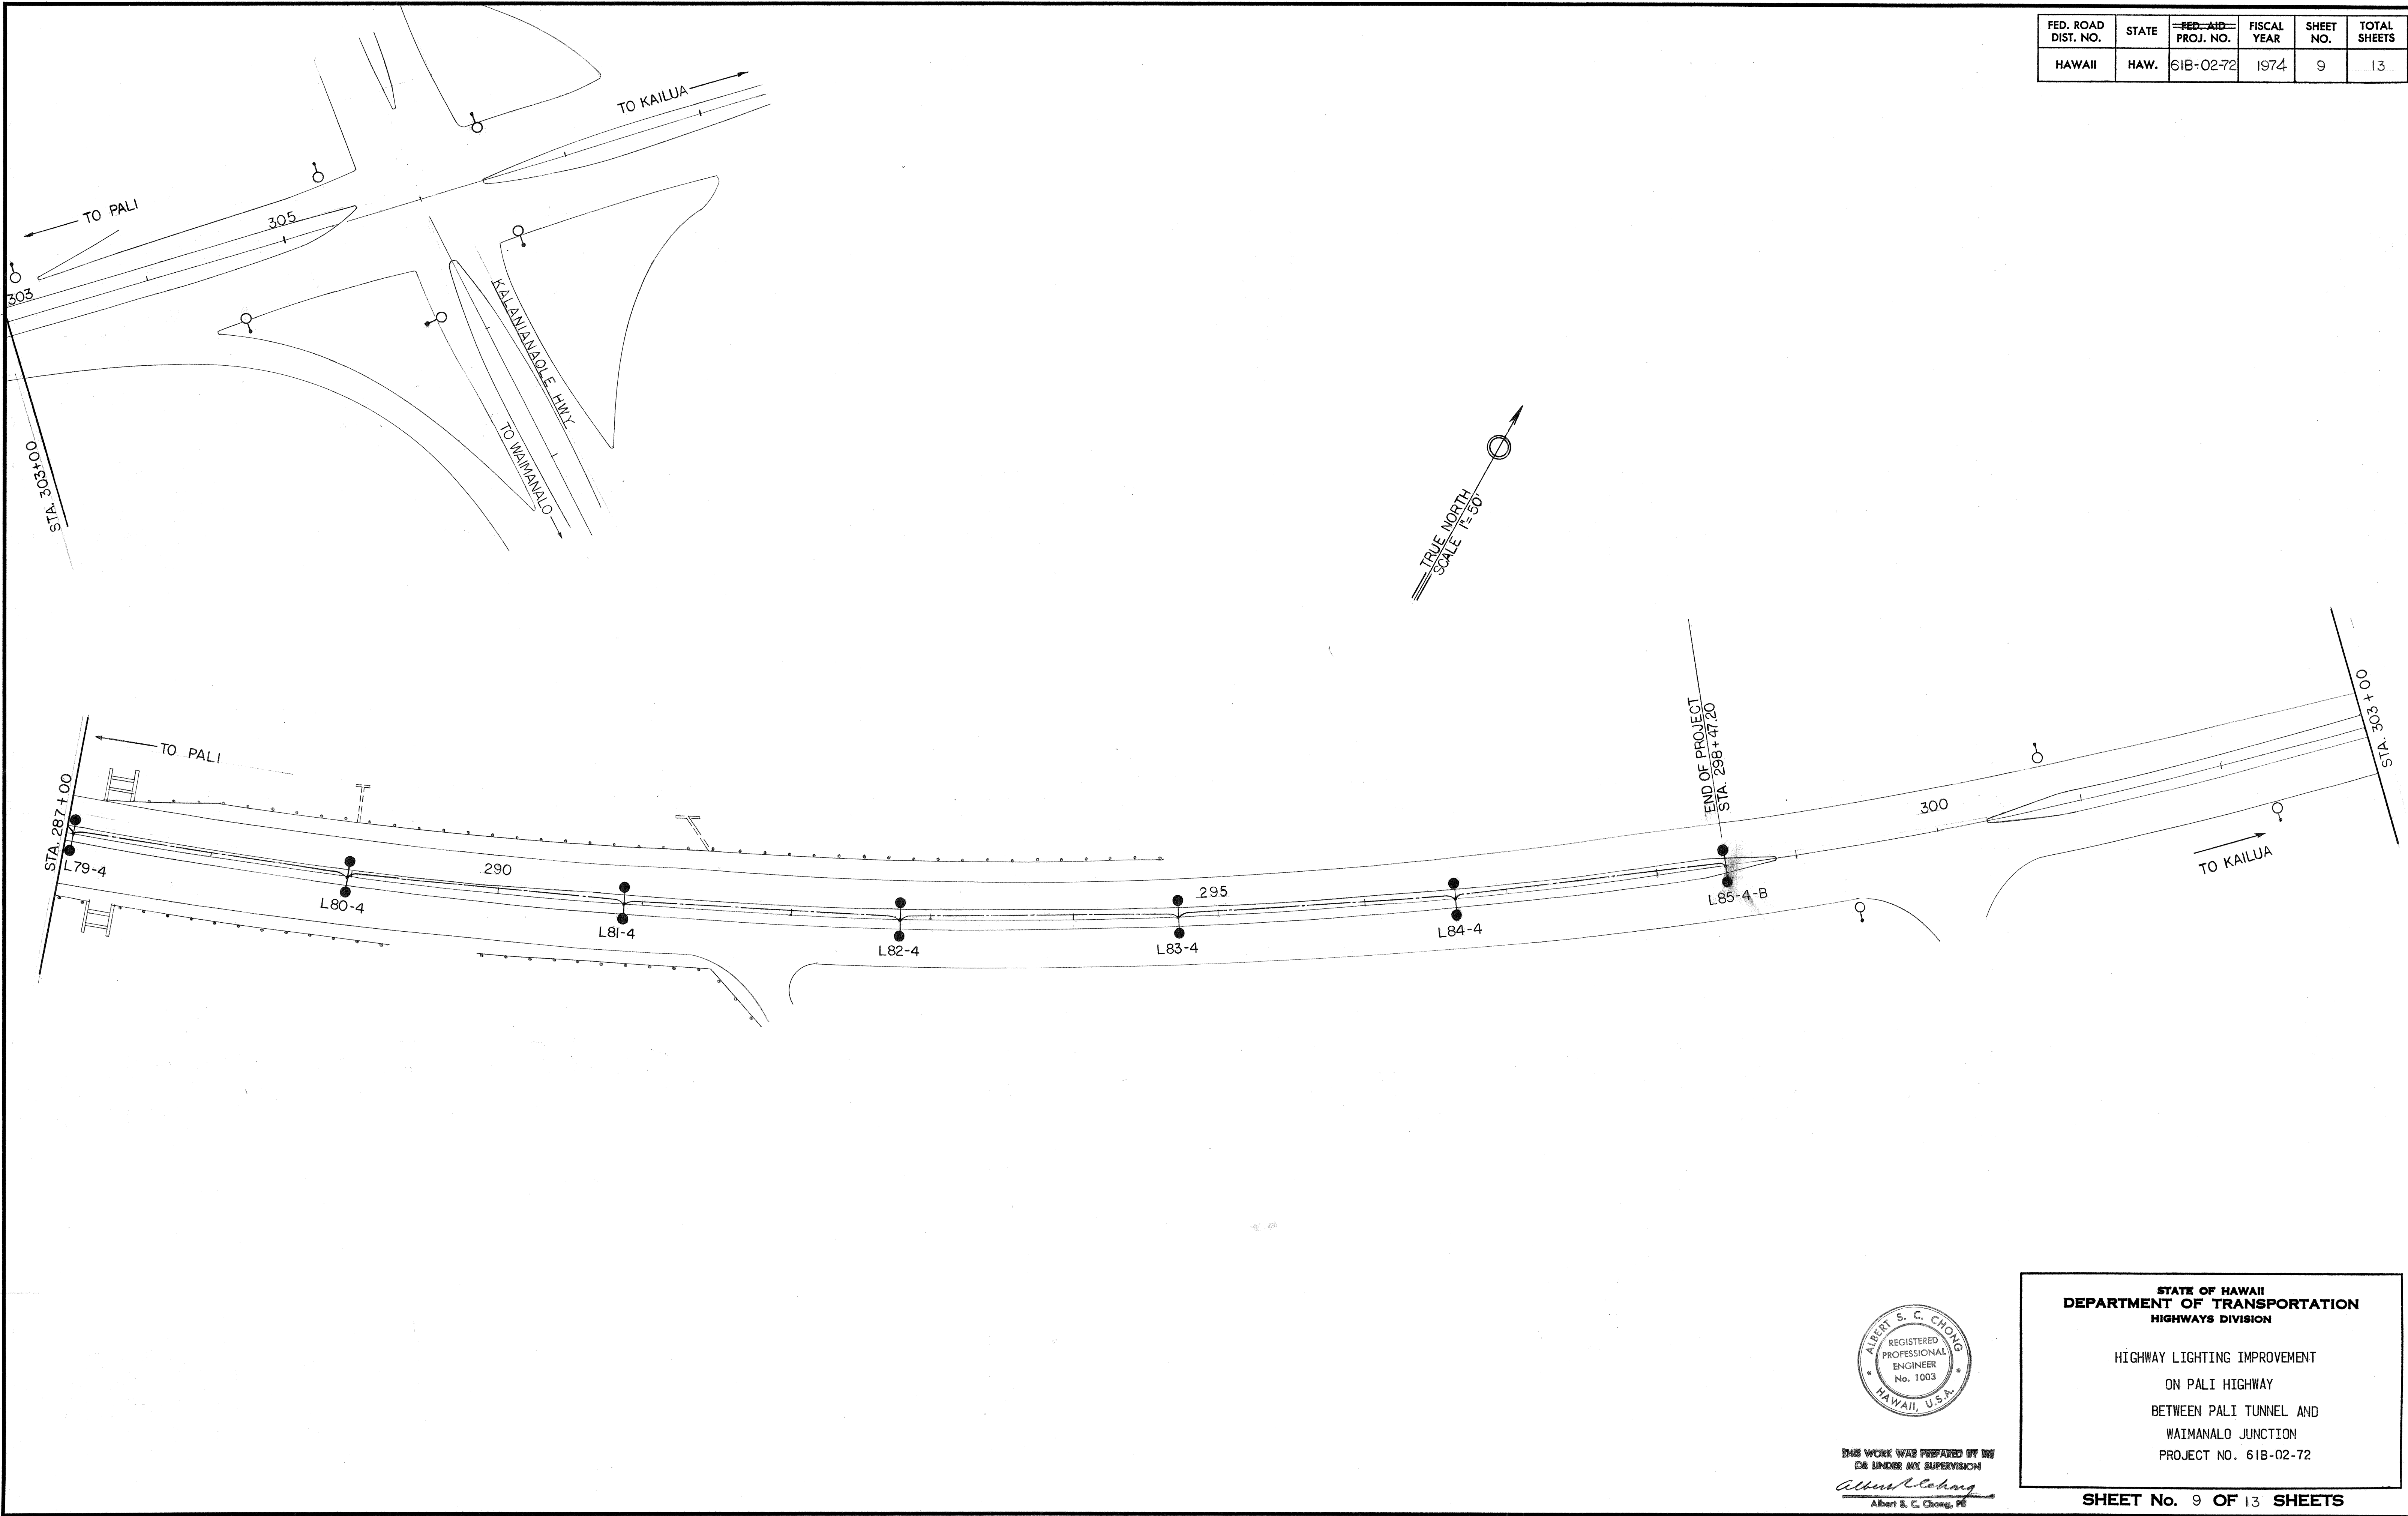

ORIGINAL PLAN	SURVEY PLOTTED BY	DATE
NOTE BOOK	DRAWN BY	
	DESIGNED BY	
	CHECKED BY	

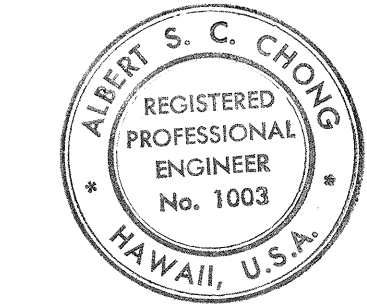

THIS WORK WAS PREPARED BY ME
OR UNDER MY SUPERVISION
Albert S. C. Chong
Albert S. C. Chong, P.E.

STATE OF HAWAII
DEPARTMENT OF TRANSPORTATION
HIGHWAYS DIVISION

HIGHWAY LIGHTING IMPROVEMENT
ON PALI HIGHWAY
BETWEEN PALI TUNNEL AND
WAIMANALO JUNCTION
PROJECT NO. 61B-02-72

SHEET No. 9 OF 13 SHEETS