


FINAL SURVEY	SURVEYED	BY	DATE
	PLOTTED		
	TEMPLATE		
	AREAS		
NOTE BOOK			
NO.			
	AREAS CHECKED		

ORIGINAL SURVEY	BY _____	DATE _____
NOTE BOOK		
SURVEYED _____		
PLOTTED _____		
TEMPLE		
AREAS		
AREAS CHECKED		
NO. _____		

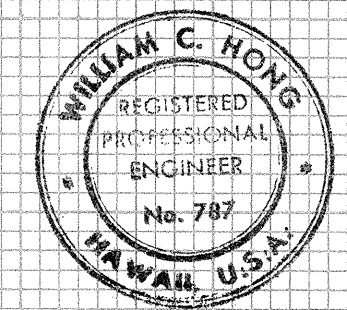


THIS WORK WAS PREPARED BY
ME OR UNDER MY SUPERVISION
William C. Ho

CROSS SECTIONS
Scale : Hor. & Vert. = 1" = 10'

FED. ROAD DIST. NO.	STATE	FED. AID PROJ. NO.	FISCAL YEAR	SHEET NO.	TOTAL SHEETS
HAWAII	HAW.	F-061-1(20)	1974	7	13


FINAL SURVEY NO.	SURVEYED	DATE
	PLOTTED	BY
	NOTE BOOK	
	AREAS CHECKED	

ORIGINAL SURVEY NO.	SURVEYED	DATE
	PLOTTED	BY
	NOTE BOOK	
	AREAS CHECKED	

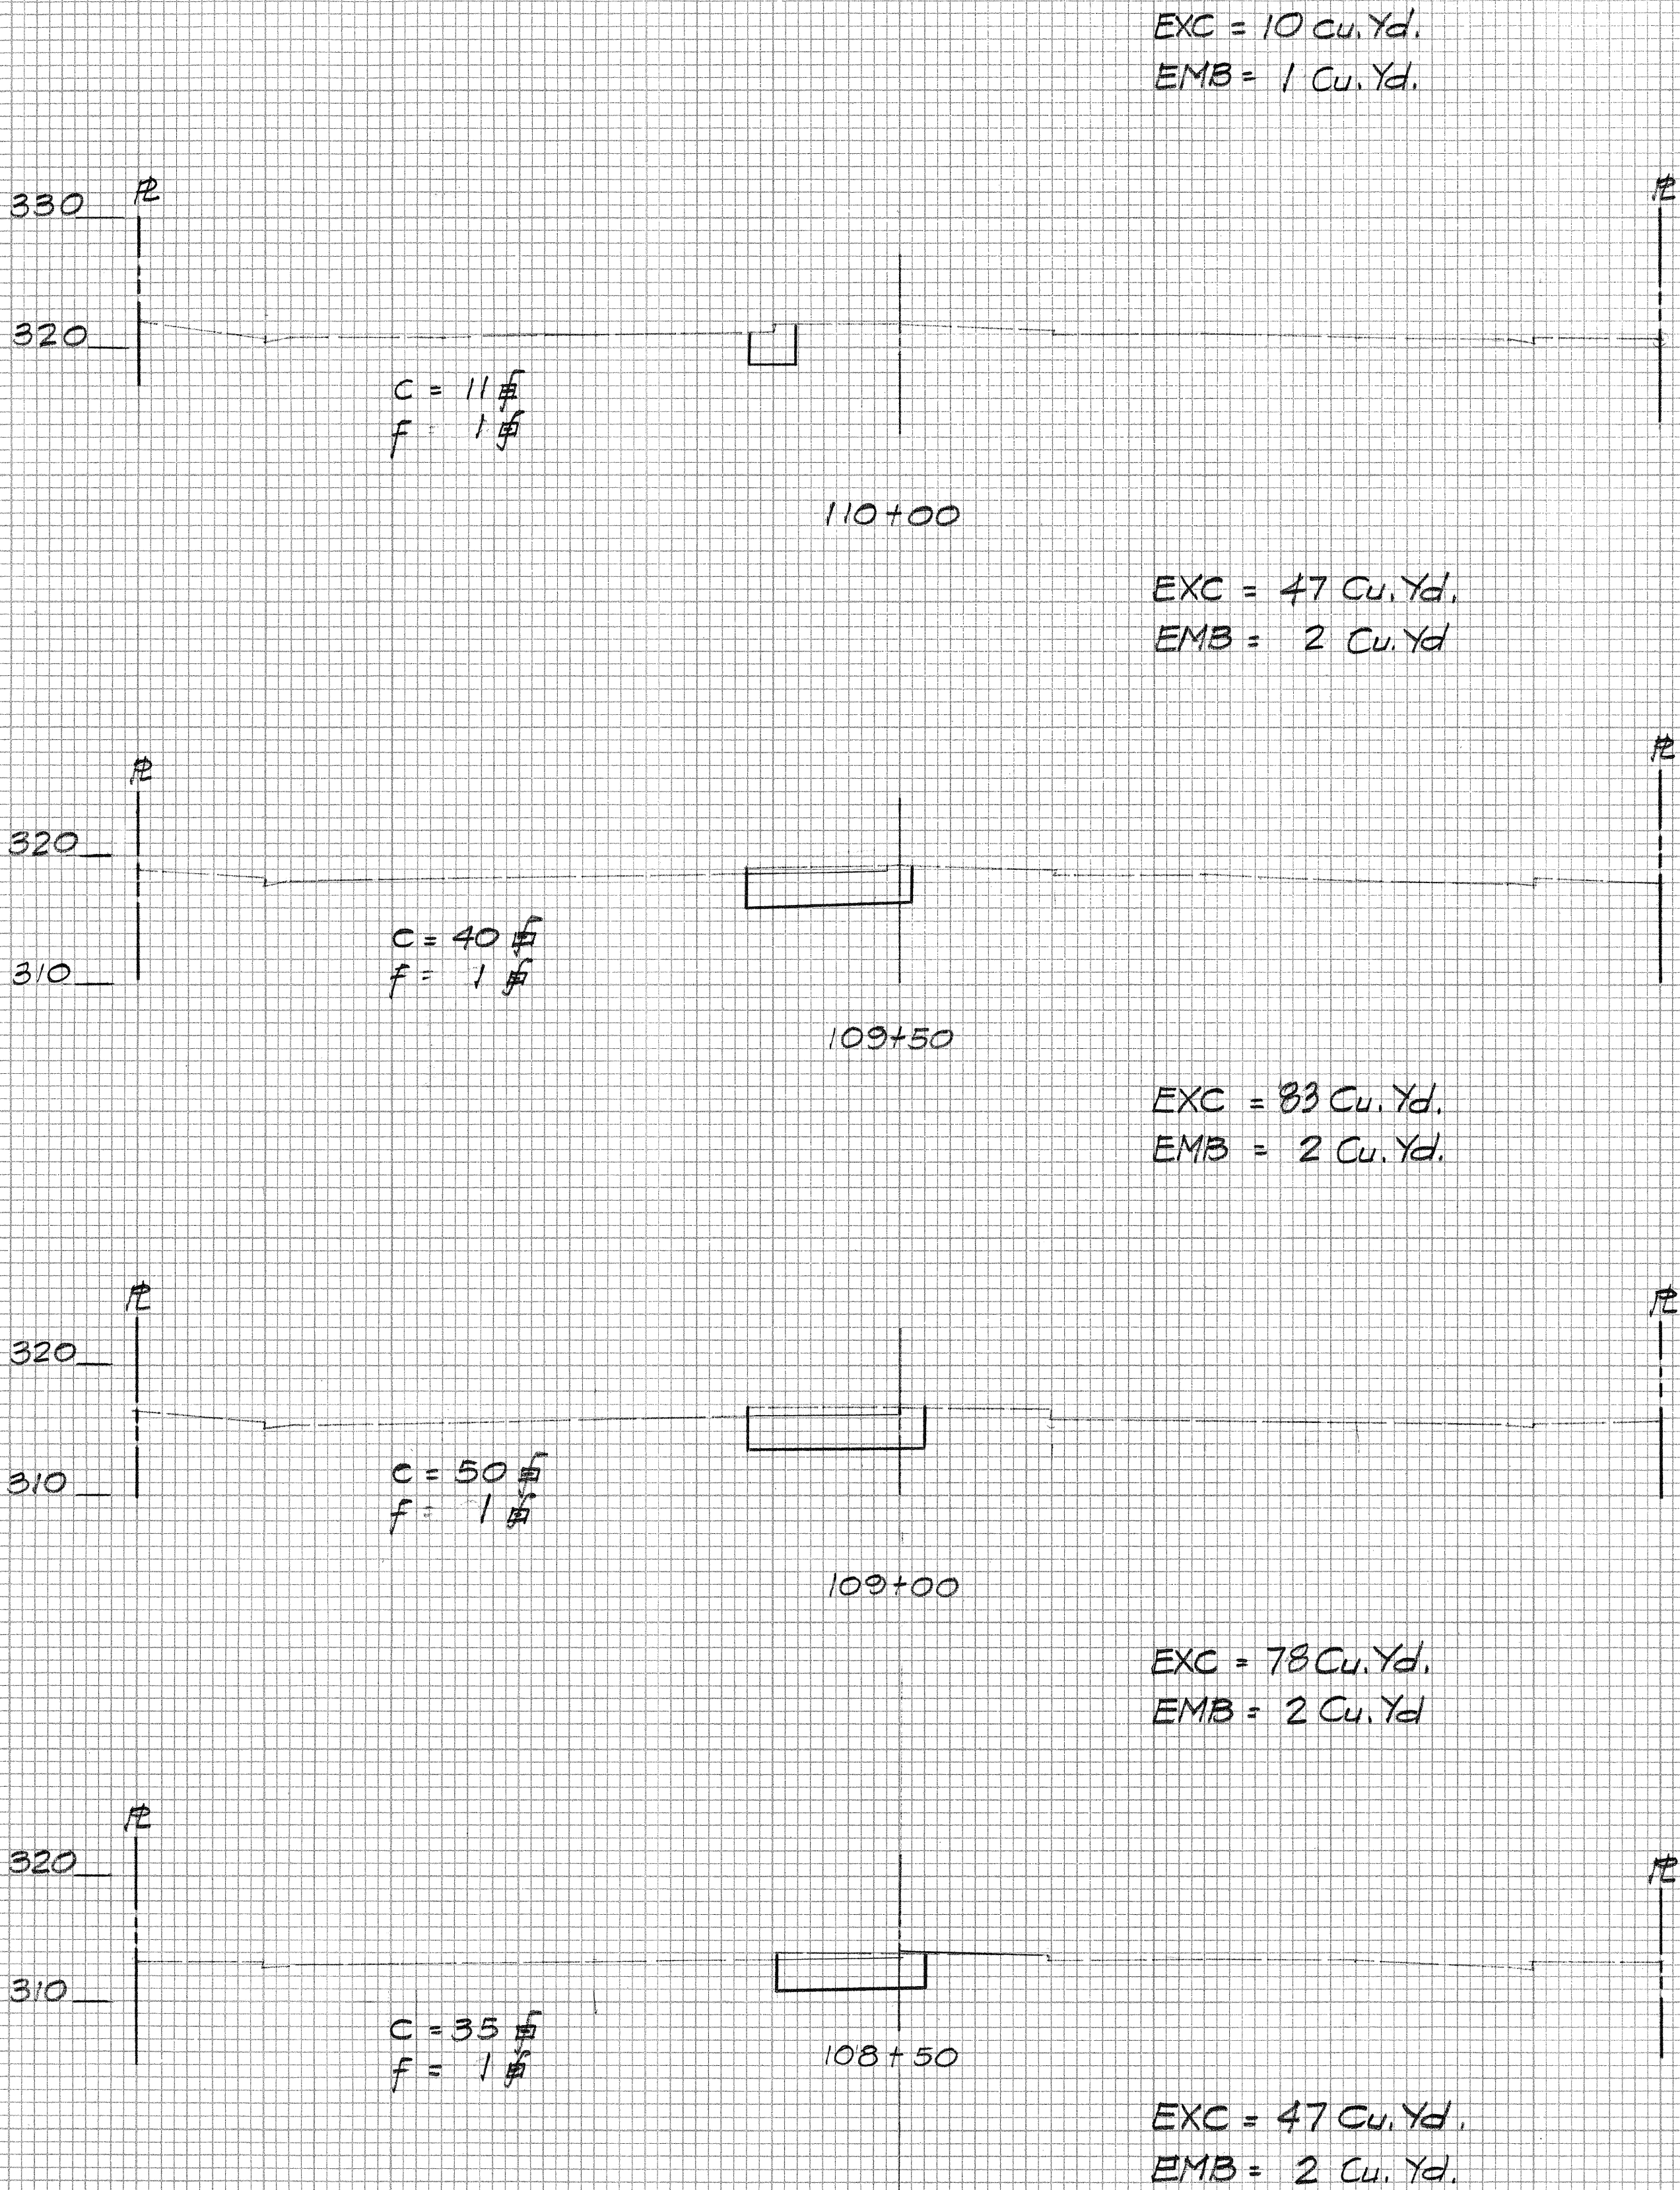

SUMMARY OF EARTHWORK

Total Excavation = 782 Cu. Yd.
 Total Embankment = 107 Cu. Yd.

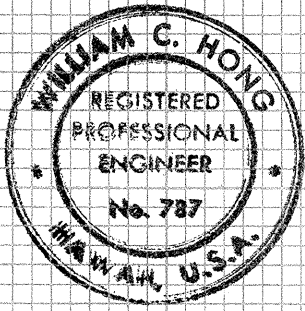

THIS WORK WAS PREPARED BY
 MEJOR UNDER MY SUPERVISION
William C. Hong

CROSS SECTIONS
 Scale: Hor. & Vert. 1" = 10'