



FED. ROAD DIST. NO.	STATE	PROJ. NO.	FISCAL YEAR	SHEET NO.	TOTAL SHEETS
HAWAII	HAW.	61B-01-75M	1975	8	14

GENERAL NOTES

1. Pavement markings shall conform to the "Manual On Uniform Traffic Control Devices For Streets And Highways", 1971, and as shown on the plans.
2. Layout of pavement markings shall be done by the Contractor and approved by the Engineer.

LEGEND

- ■ — Type "A" and "C" Raised Pavement Markers
- ■ — 4" White Stripe w/Type "C" Markers 20' O.C. (8" White When Indicated)
- ■ — 4" Yellow Edge Stripe w/Type "H" Markers 40' O.C.
- ■ — White Crosswalk Marking (3 Lanes Shown)
- ■ — 12" White Stop Line
- ▼ White Pavement Arrow (See Detail, Sht. No. 10)

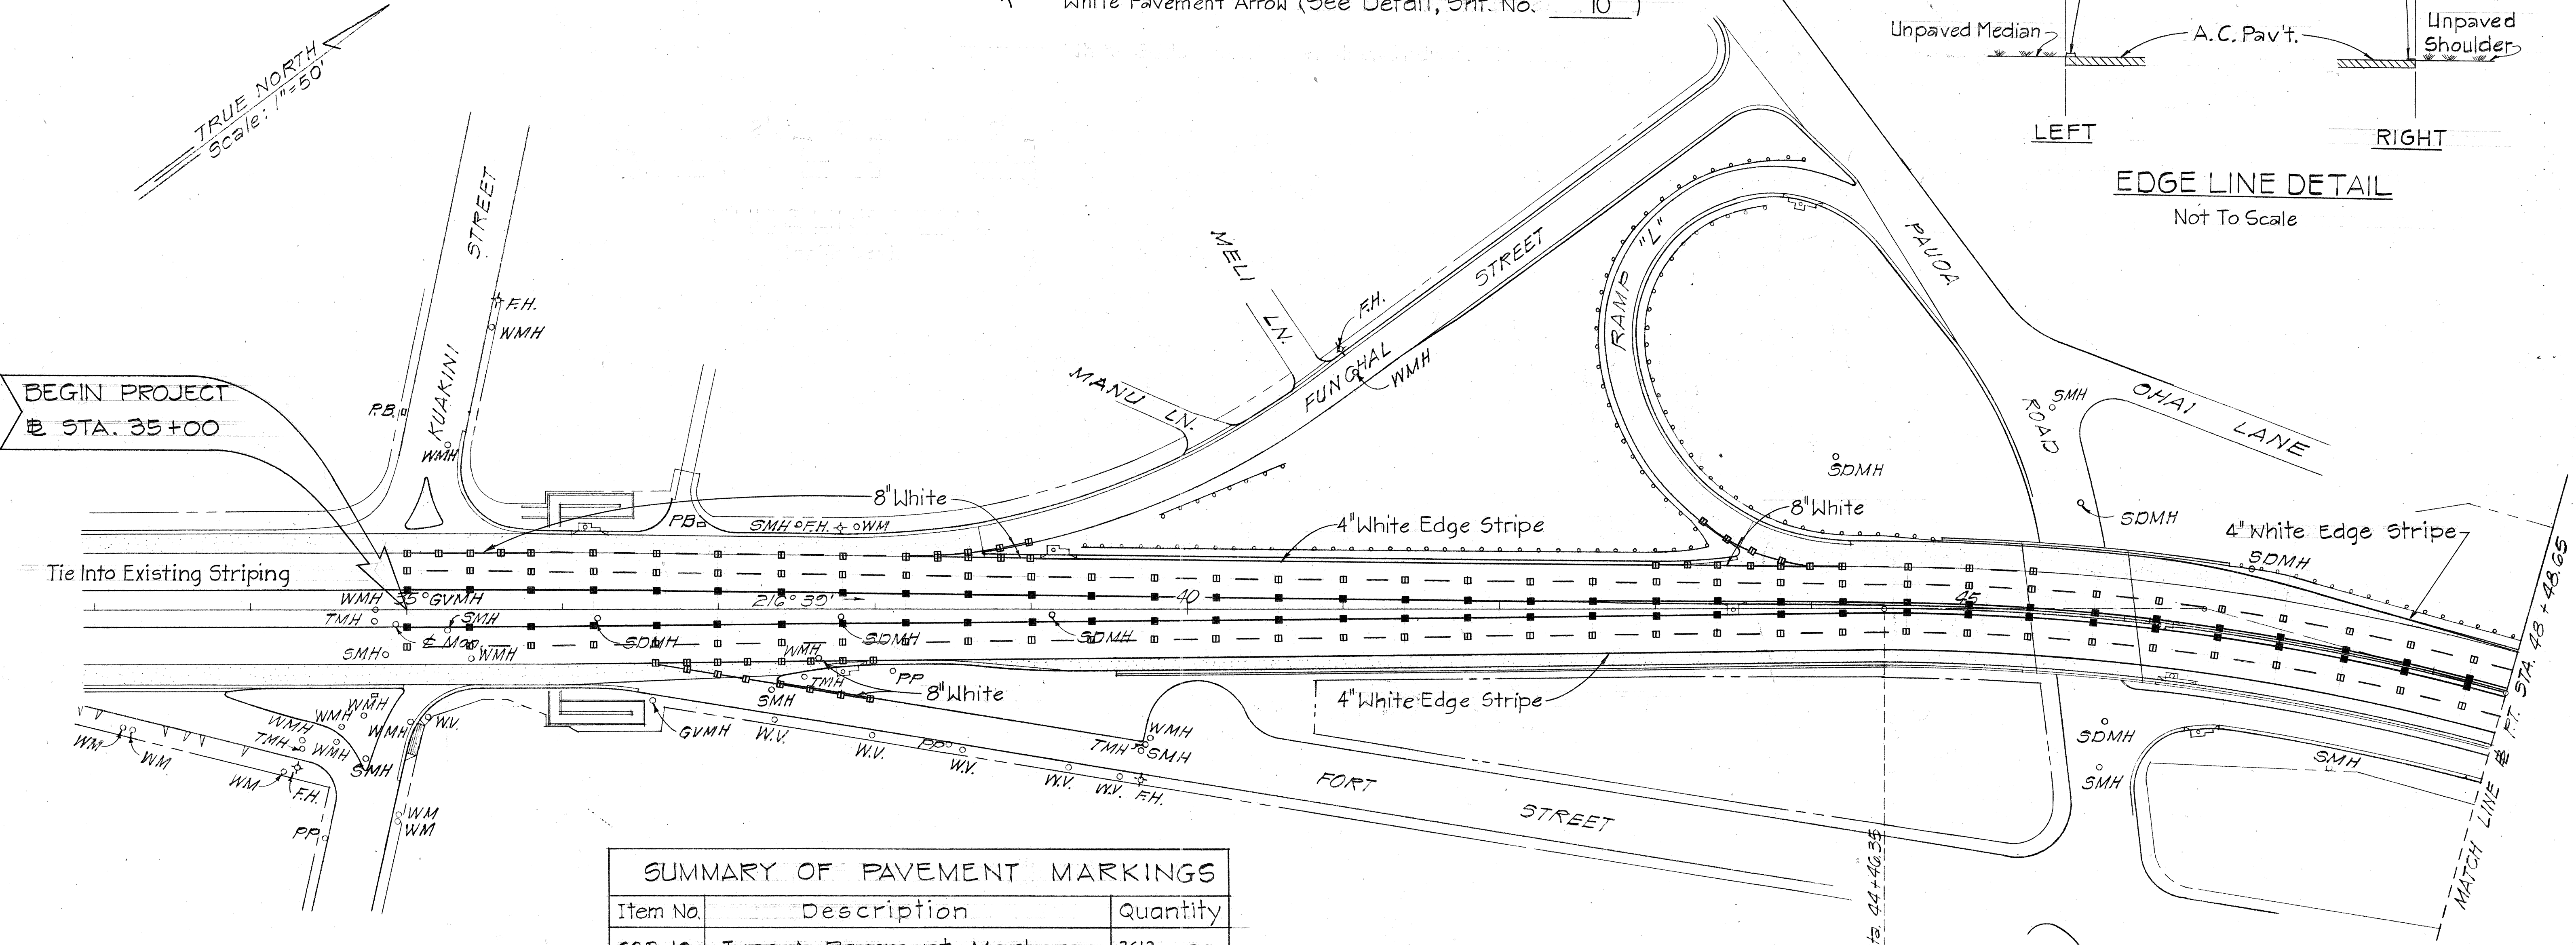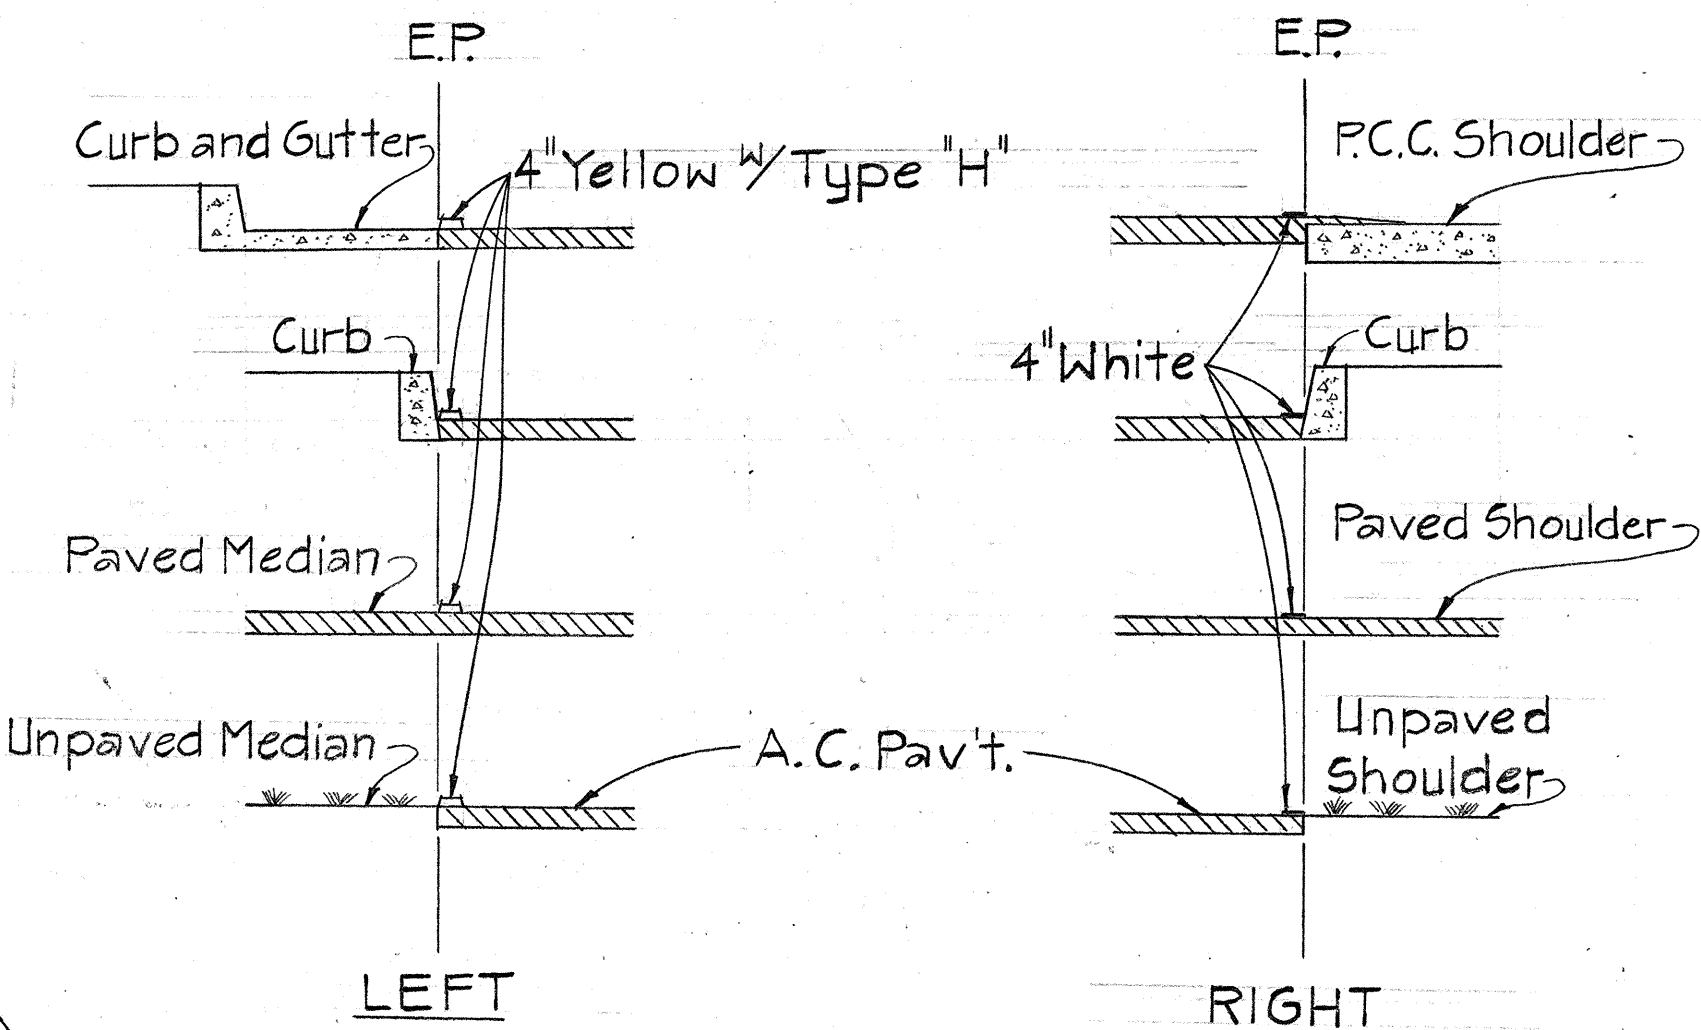

SUMMARY OF PAVEMENT MARKINGS		
Item No.	Description	Quantity
G29.10	Type A Pavement Markers	3612 ea.
G29.30	Type C Pavement Markers	950 ea.
G29.80	Type H Pavement Markers	402 ea.
G42.10	Pavement Striping	3,270 L.F.
G42.20	Pavement Arrow	11 ea.
G42.30	Crosswalk Marking	40 in.

CURVE DATA
 $\Delta = 15^{\circ}22'$
 $R = 1500'$
 $T = 202.36'$
 $L = 401.00'$


7-11-75	ADD NOTE, COMPLETE LEGEND, REVISE SUMMARY.
DATE	REVISION

STATE OF HAWAII
DEPARTMENT OF TRANSPORTATION
HIGHWAYS DIVISION


PAVEMENT MARKINGS
PALI HIGHWAY RESURFACING
KUAKINI ST. TO HINALO PL
PROJ. NO. 61B-01-75M

SCALE: AS SHOWN
DATE: JAN. 1975
SHEET No. 1 OF 5 SHEETS

FED. ROAD DIST. NO.	STATE	PROJ. NO.	FISCAL YEAR	SHEET NO.	TOTAL SHEETS
HAWAII	HAW.	61B-01-75M	1975	9	14

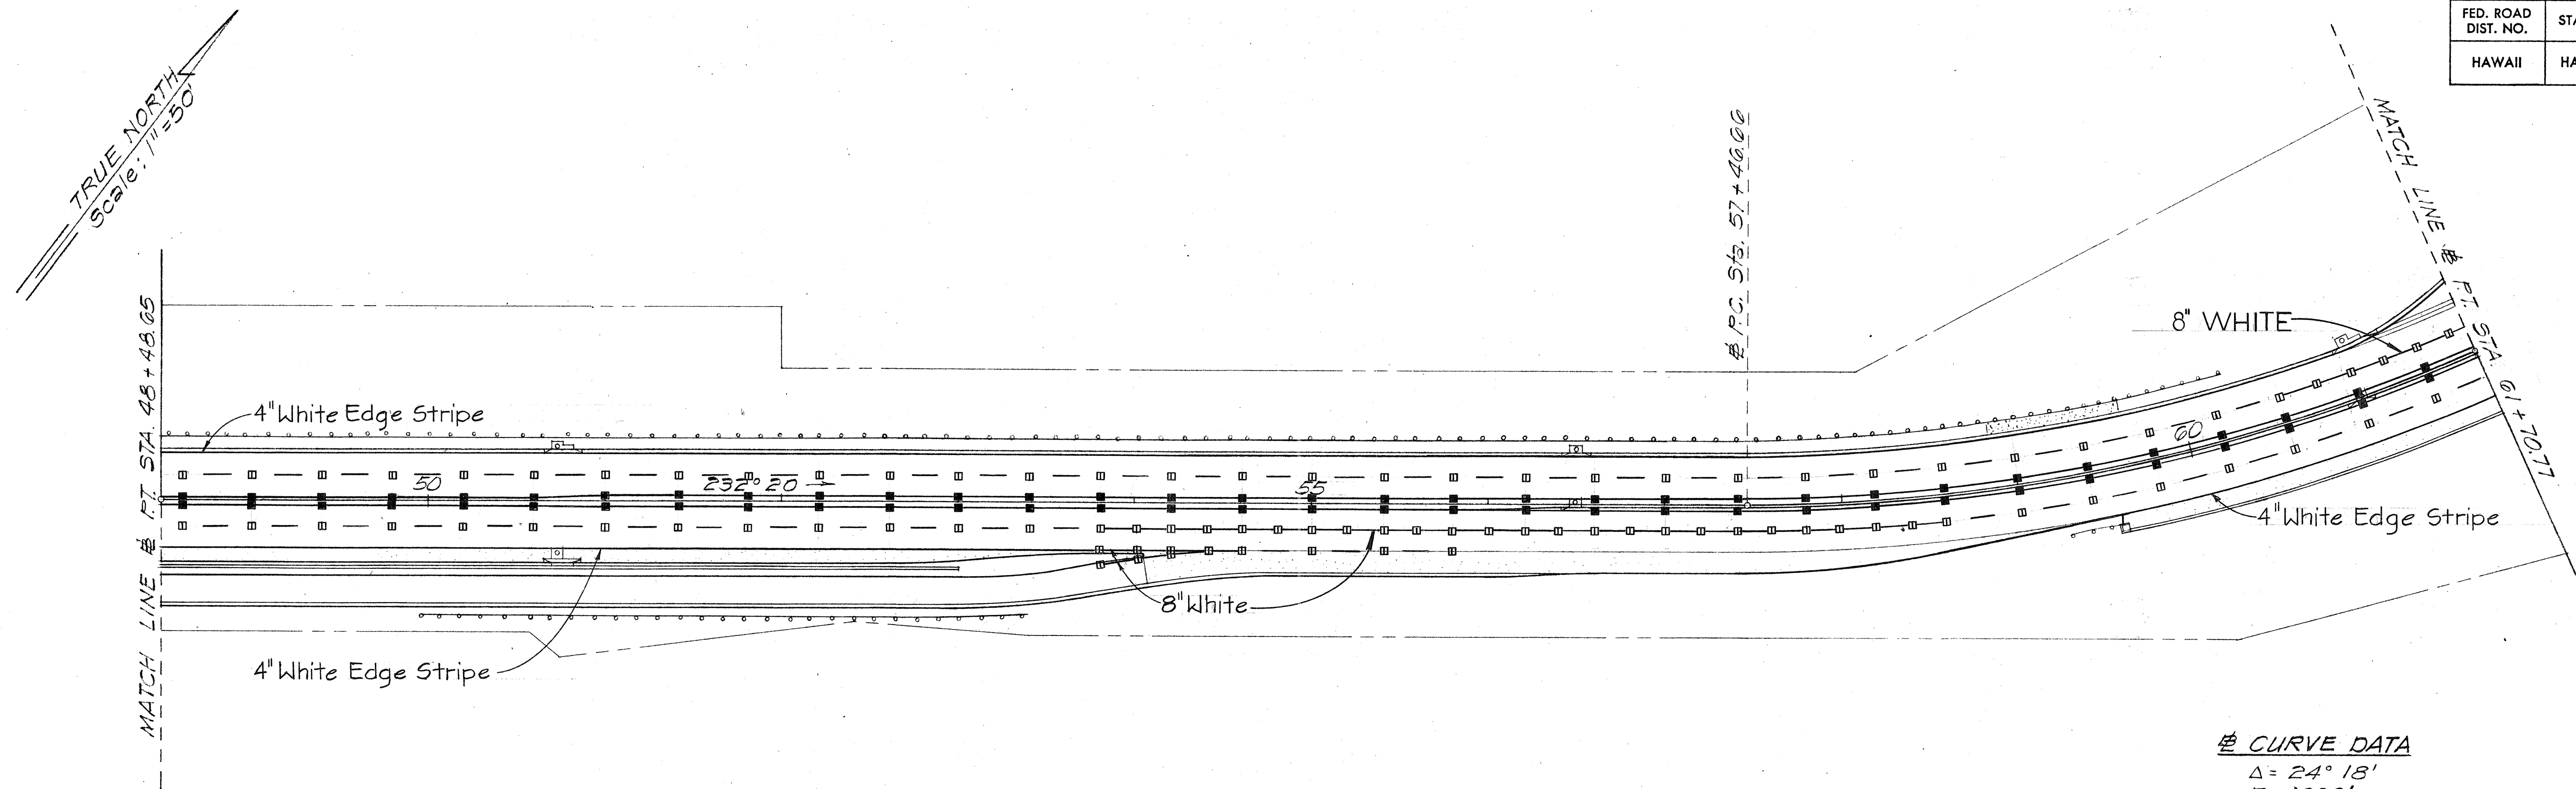

CURVE DATA
 $\Delta = 24^\circ 18'$
 $R = 1000'$
 $T = 215.20'$
 $L = 420.04'$

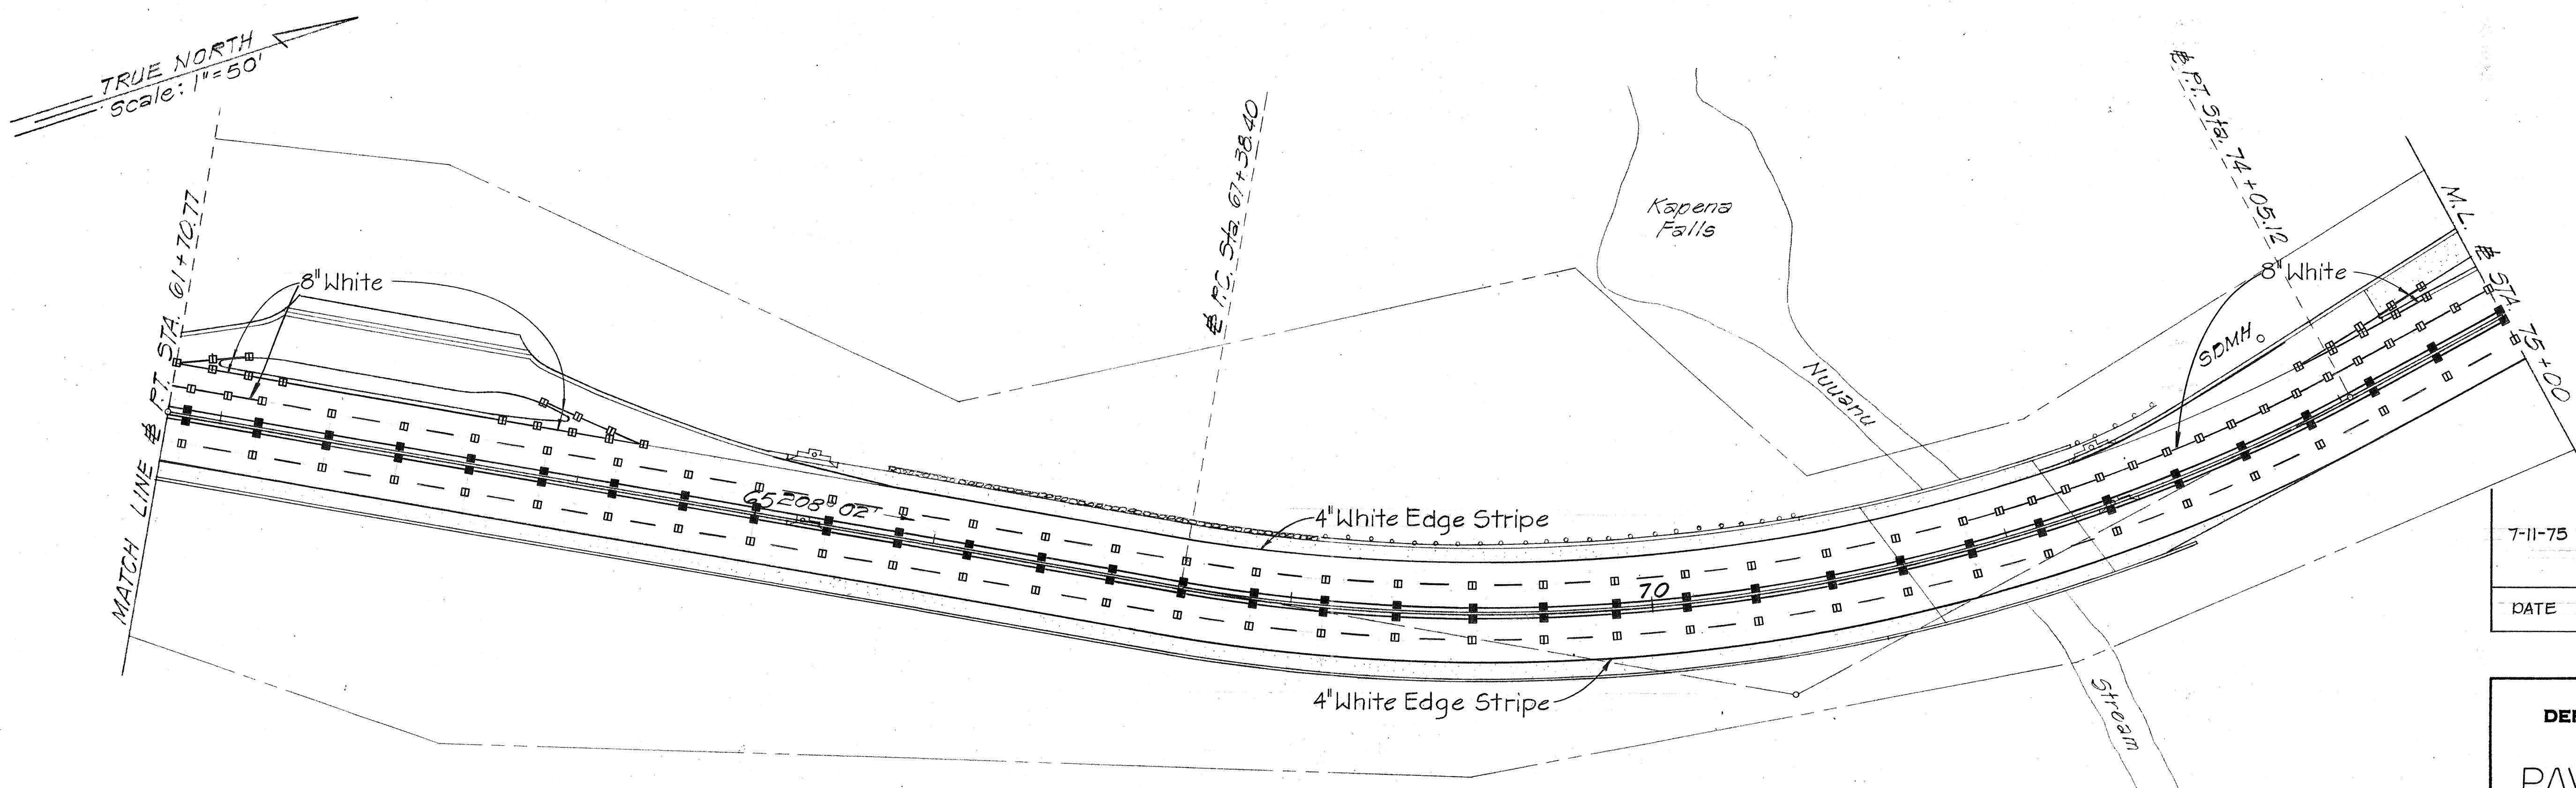

CURVE DATA
 $\Delta = 38^\circ 12'$
 $R = 1000'$
 $T = 346.28'$
 $L = 654.44'$

7-11-75	REVISE STRIPING
DATE	REVISION

STATE OF HAWAII
DEPARTMENT OF TRANSPORTATION
HIGHWAYS DIVISION


PAVEMENT MARKINGS

PALI HIGHWAY RESURFACING
KUAKINI ST. TO HINALO PL.
PROJ. NO. 61B-01-75M


SCALE: AS SHOWN DATE: JAN. 1975
SHEET No. 2 OF 5 SHEETS

DATE	
SURVEY PLOTTED BY	
ORIGINAL PLAN	
DRAWN BY	
TRACED BY	
DESIGNED BY	
CHECKED BY	
NO.	


FED. ROAD DIST. NO.	STATE	PROJ. NO.	FISCAL YEAR	SHEET NO.	TOTAL SHEETS
HAWAII	HAW.	61B-01-75M	1975	10	14

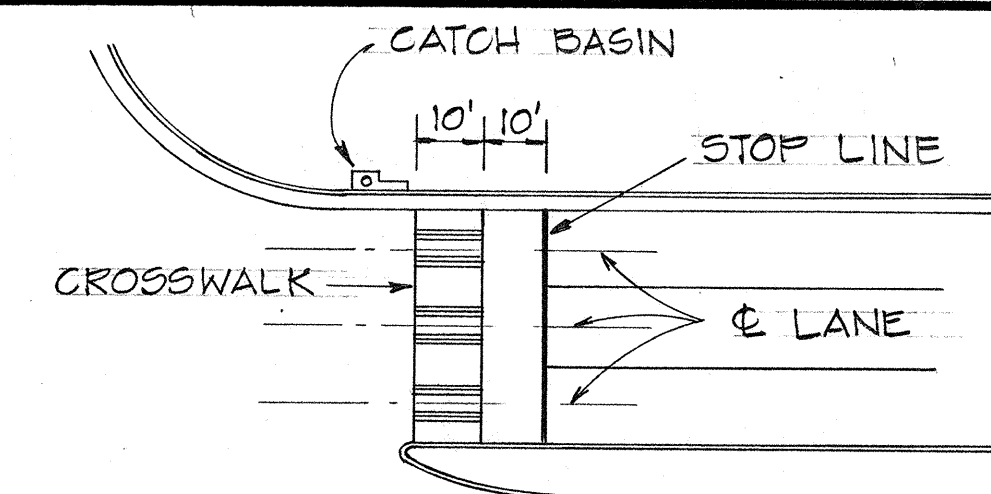


NOTE: SET ALL CROSSWALKS AWAY FROM CATCH BASINS

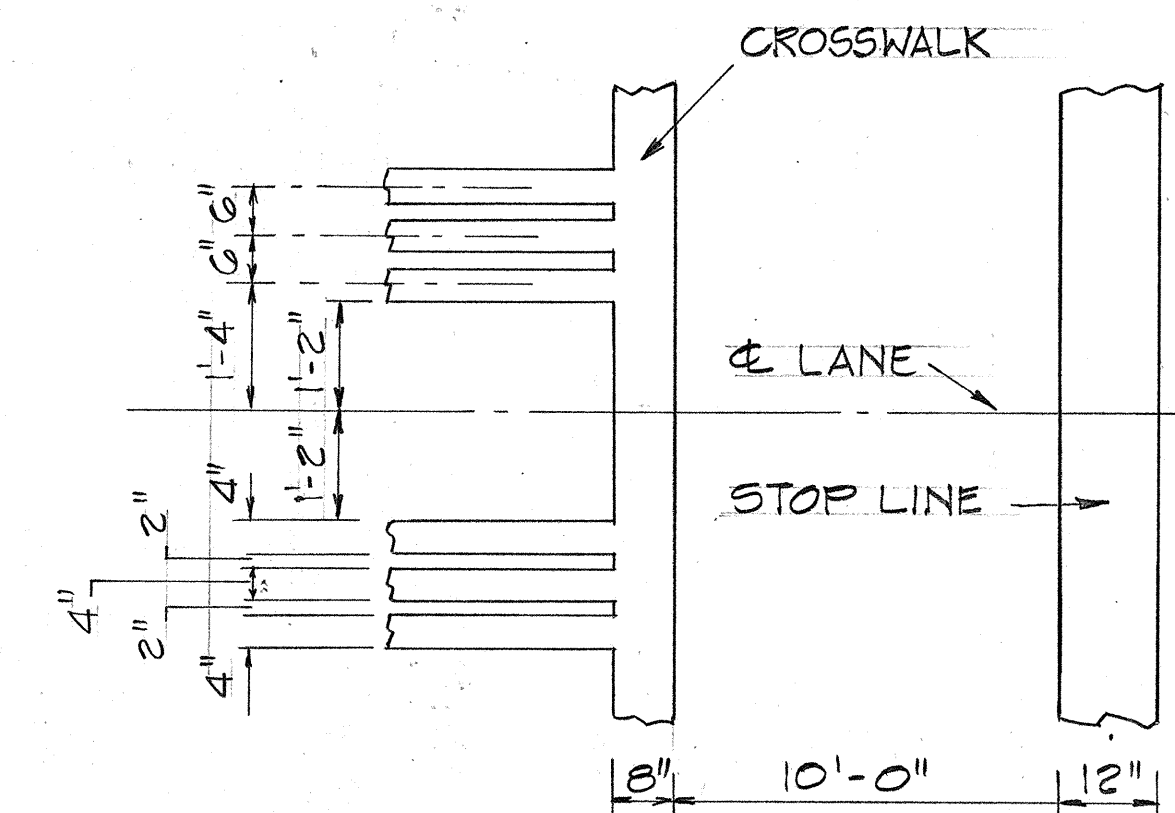

CROSSWALK DETAIL
NOT TO SCALE

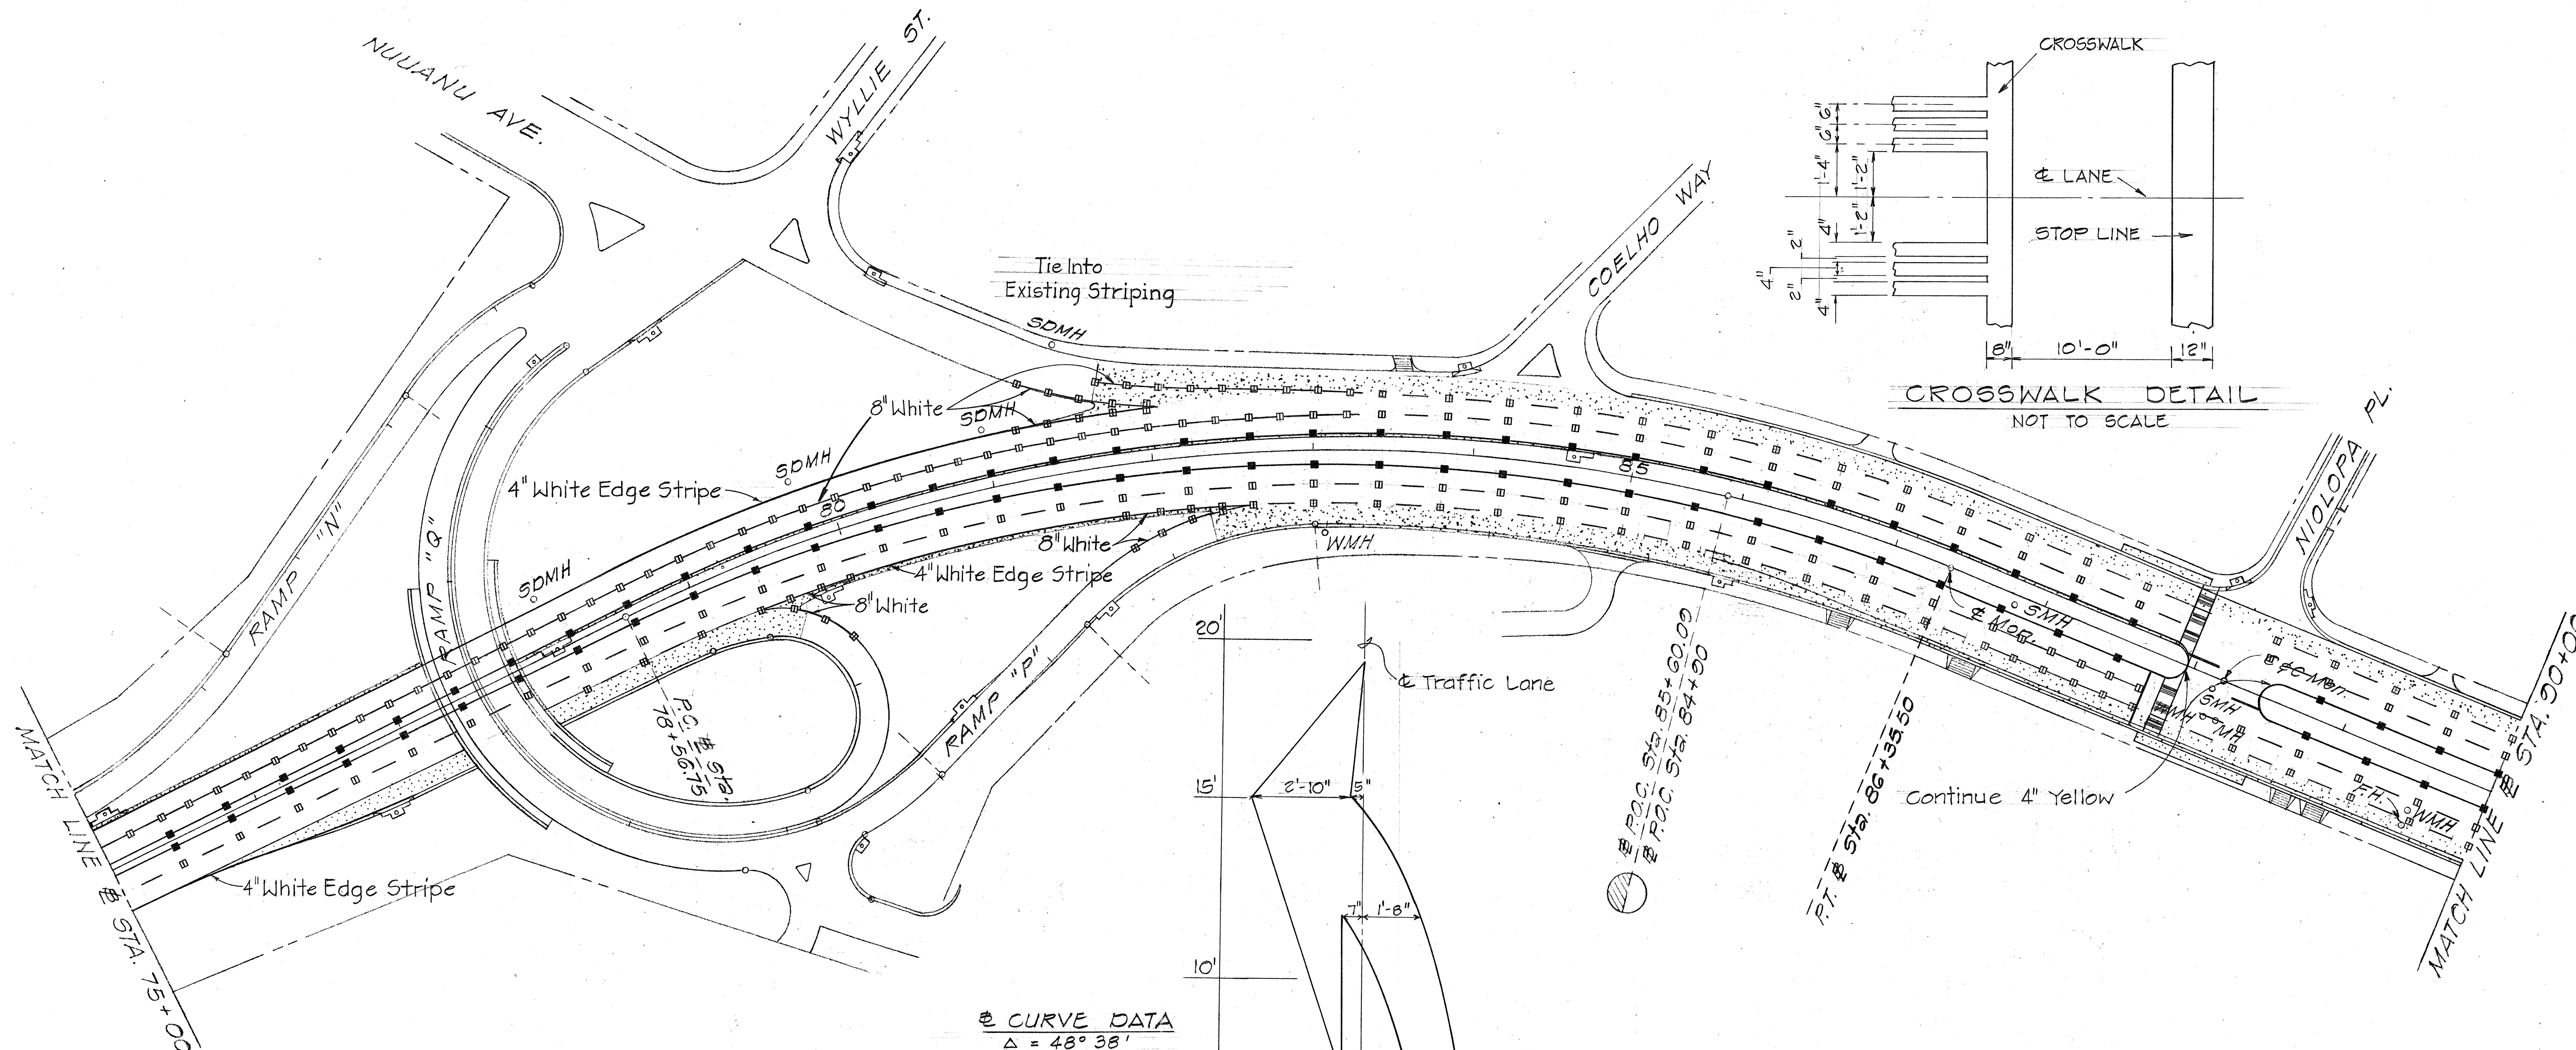

CURVE DATA	
Δ	$48^{\circ} 38'$
R	$1000'$
T	$451.87'$
L	$848.81'$

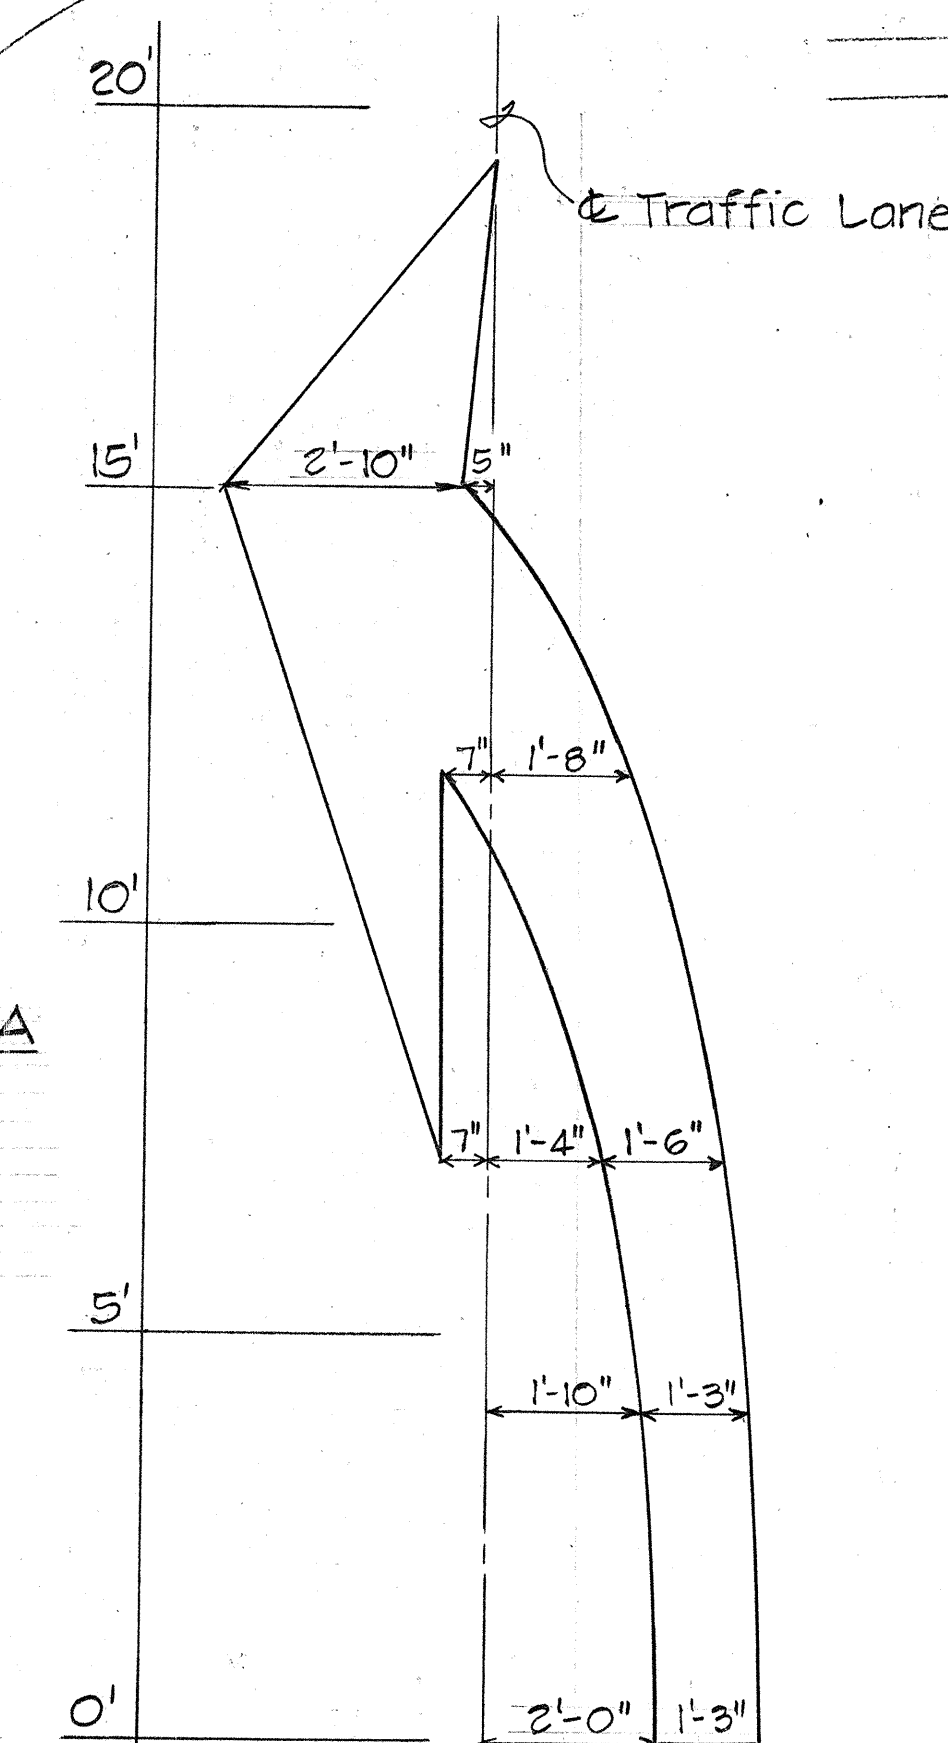

PAVEMENT ARROW DETAIL
Not to scale

DATE	REVISION
7-11-75	REVISE STRIPING

STATE OF HAWAII
DEPARTMENT OF TRANSPORTATION
HIGHWAYS DIVISION

PAVEMENT MARKINGS

PALI HIGHWAY RESURFACING
KUAKINI ST. TO HINALO PL.
PROJ. NO. 61B-01-75M

SCALE: AS SHOWN DATE: JAN. 1975
SHEET No. 3 OF 5 SHEETS



C.O.10

FED. ROAD DIST. NO.	STATE	PROJ. NO.	FISCAL YEAR	SHEET NO.	TOTAL SHEETS
HAWAII	HAW.	61B-01-75M	1975	11	14

CURVE DATA

$\Delta = 3^{\circ} 29'$
 $R = 10,000'$
 $T = 304.07'$
 $L = 607.96'$

P.T. # Sta. 102+83
R=10,000

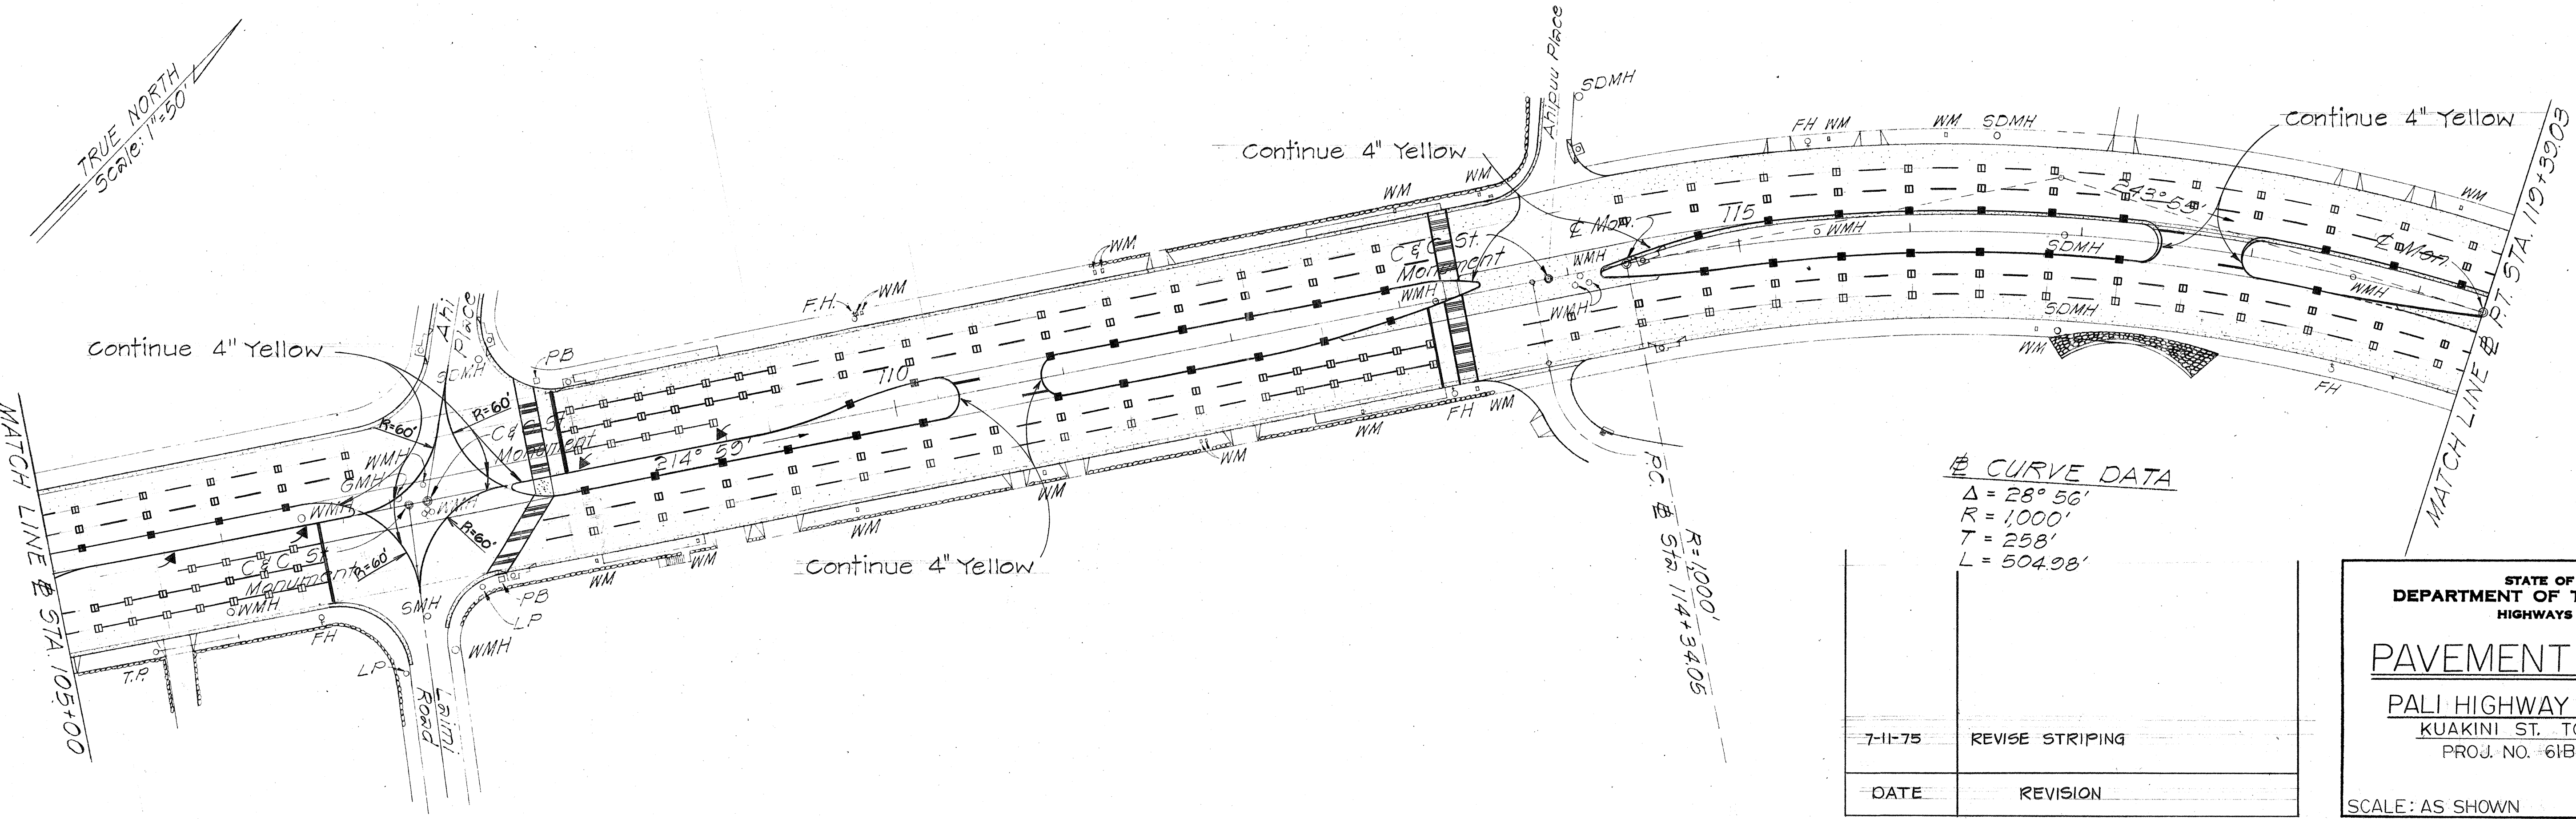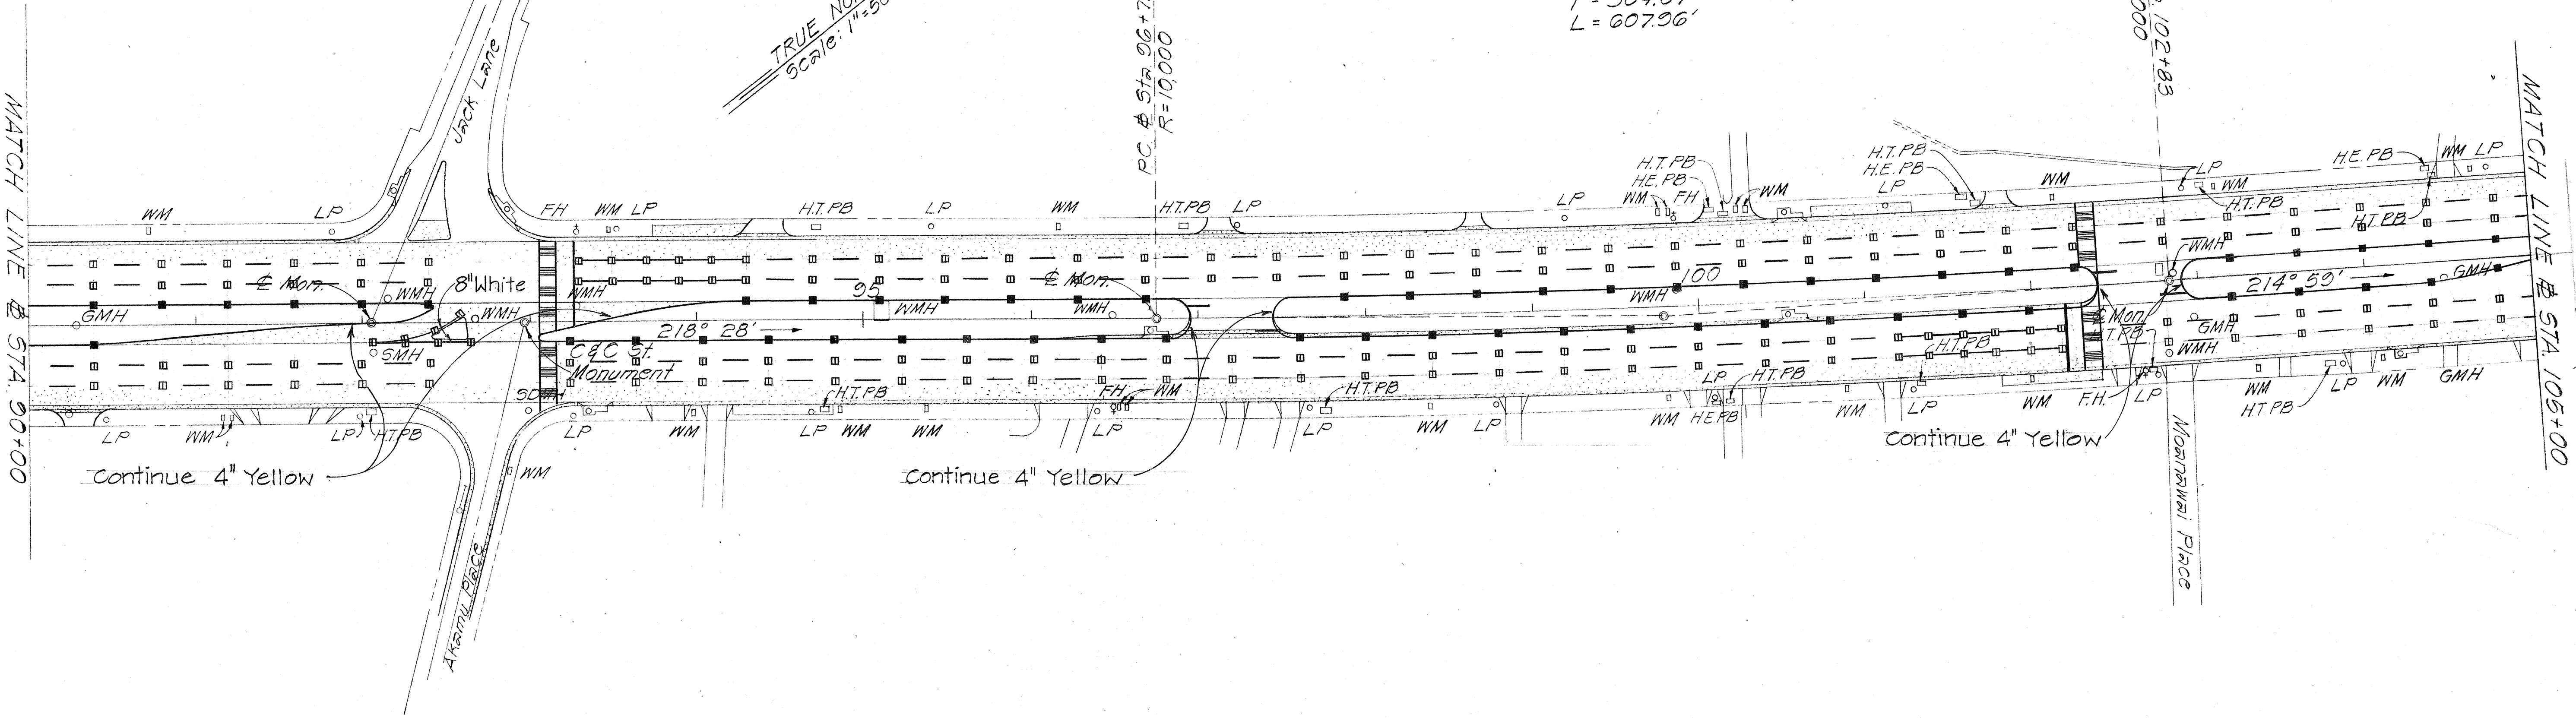

CURVE DATA

$\Delta = 28^{\circ} 56'$
 $R = 1,000'$
 $T = 258'$
 $L = 504.98'$

7-11-75	REVISE STRIPING
DATE	REVISION

STATE OF HAWAII
DEPARTMENT OF TRANSPORTATION
HIGHWAYS DIVISION



PAVEMENT MARKINGS

PALI HIGHWAY RESURFACING
KUAKINI ST. TO HINALO PL.
PROJ. NO. 61B-01-75M

SCALE: AS SHOWN DATE: JAN. 1975
SHEET No. 4 OF 5 SHEETS

C.O.II

FED. ROAD DIST. NO.	STATE	PROJ. NO.	FISCAL YEAR	SHEET NO.	TOTAL SHEETS
HAWAII	HAW.	61B-01-75M	1975	12	14

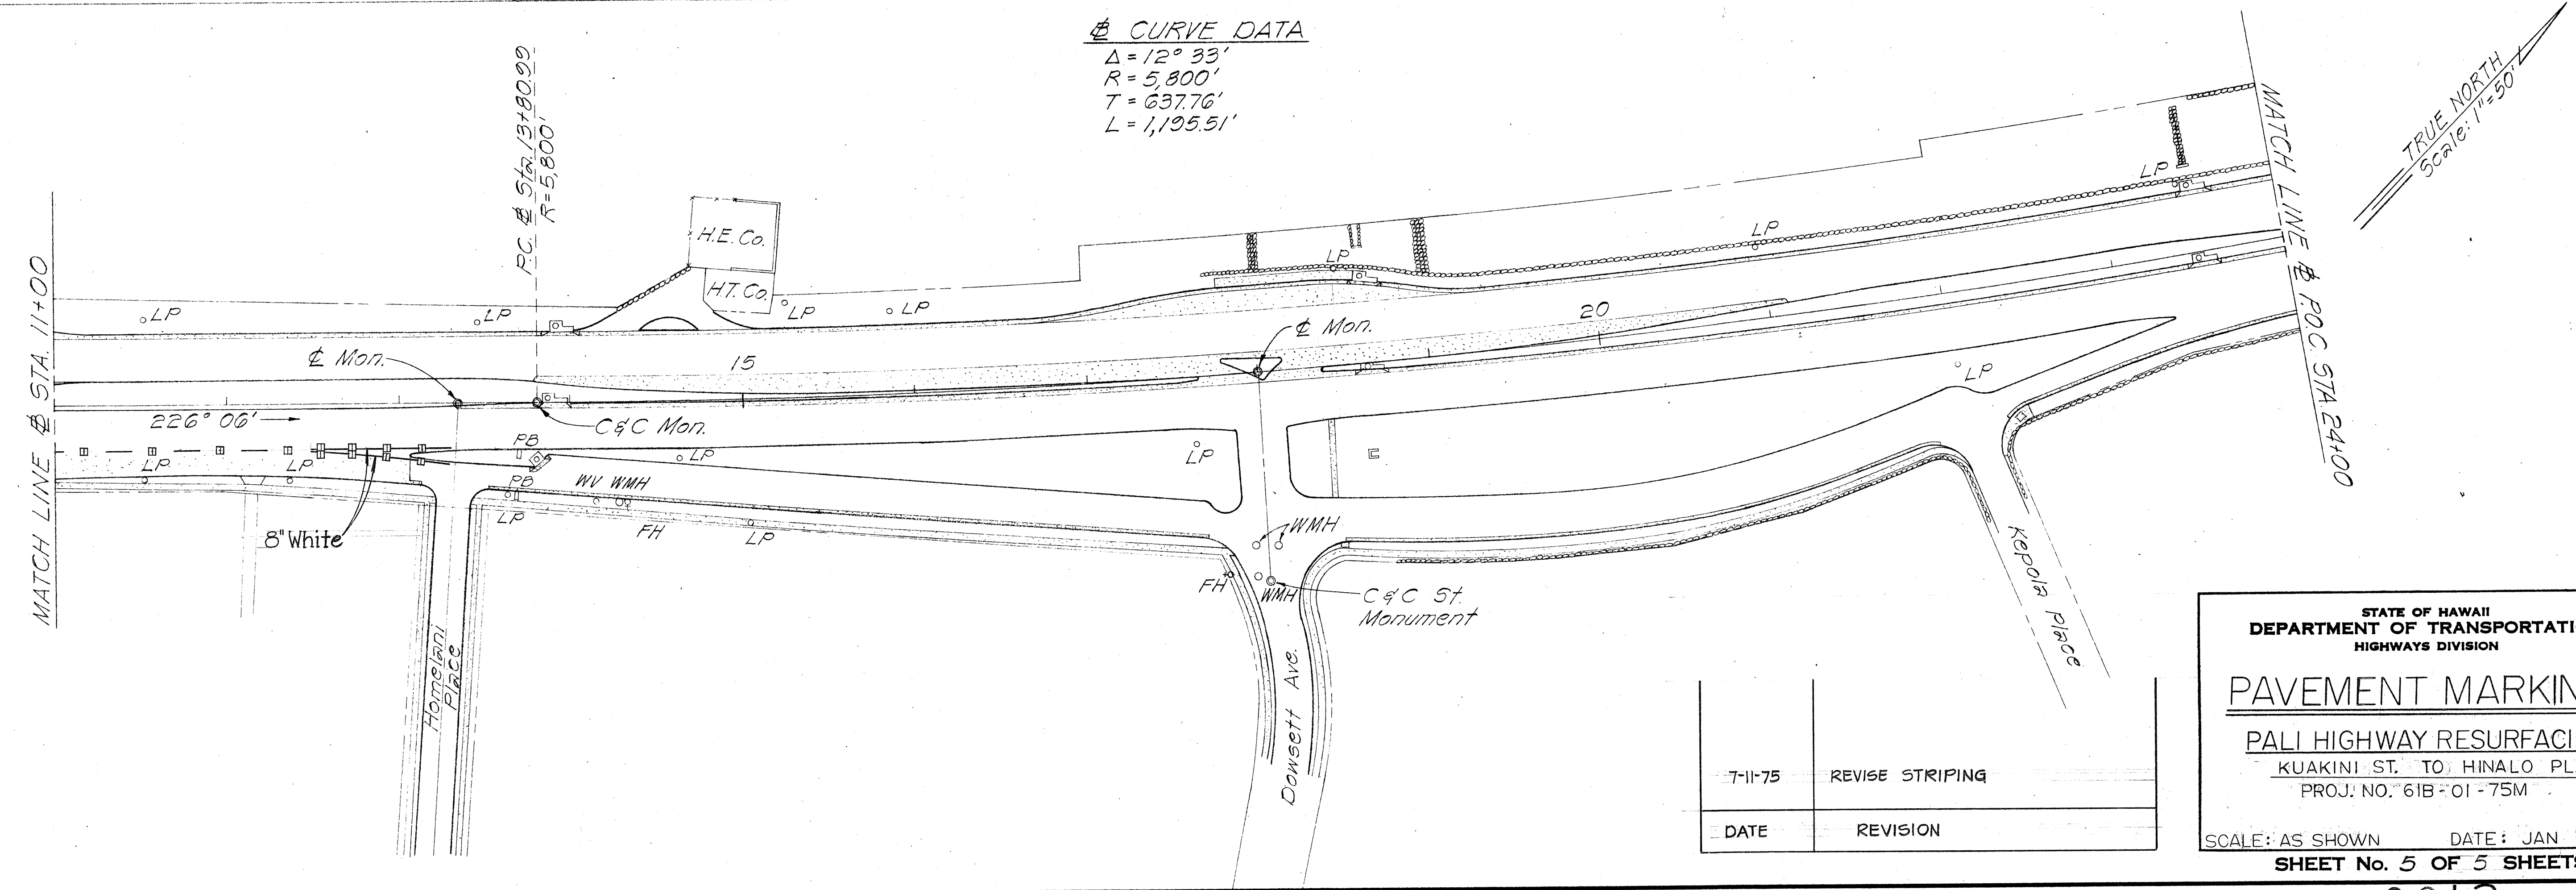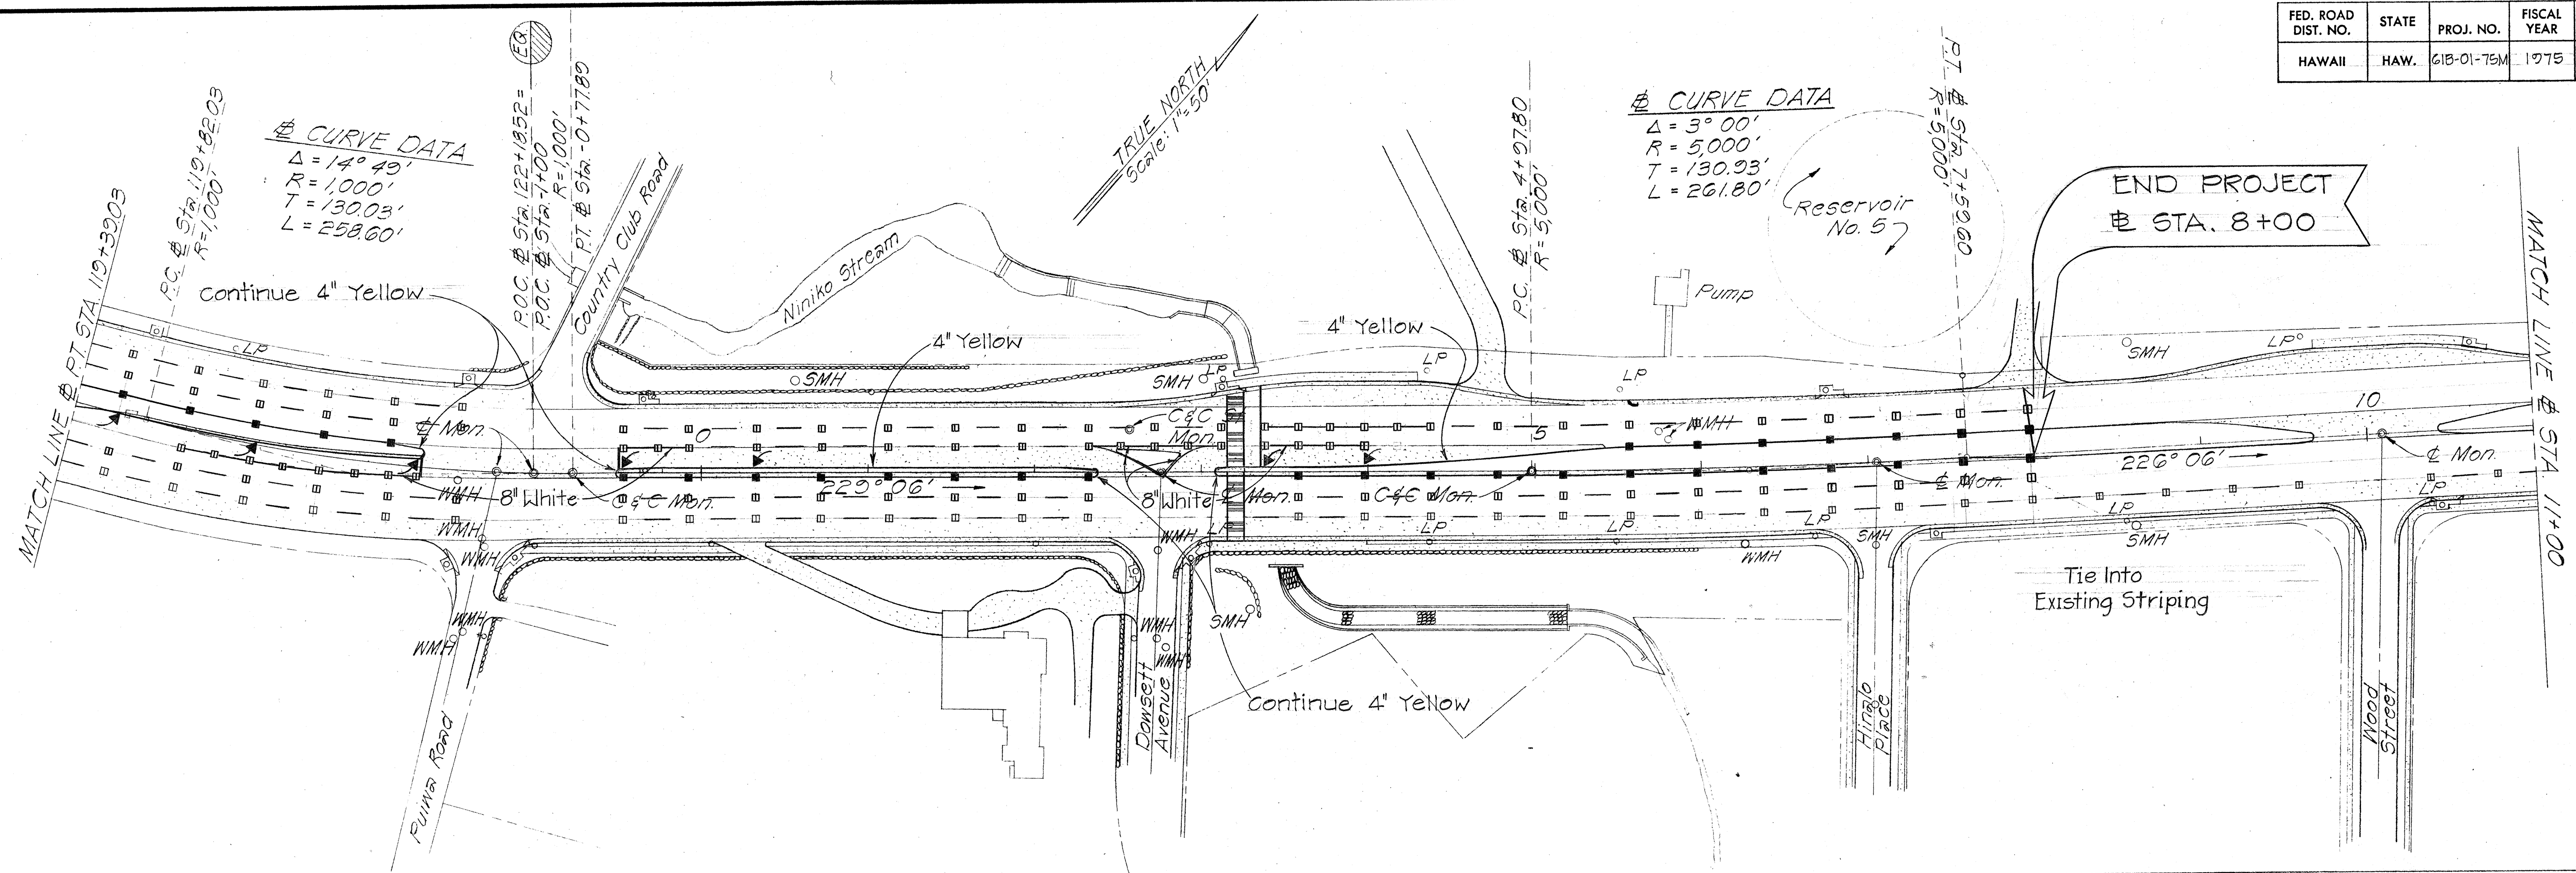

DATE	
SURVEY PLOTTED BY	
DRAWN BY	
TRACED BY	
NOTED BY	
CHECKED BY	
ORIGINAL PLAN	
NOTE BOOK	
No.	

7-11-75	REVISE STRIPING
DATE	REVISION

STATE OF HAWAII
DEPARTMENT OF TRANSPORTATION
HIGHWAYS DIVISION

PAVEMENT MARKINGS

PALI HIGHWAY RESURFACING
KUAKINI ST. TO HINALO PL.
PROJ. NO. 61B-01-75M

SCALE: AS SHOWN DATE: JAN 1975
SHEET No. 5 OF 5 SHEETS

C.O.12