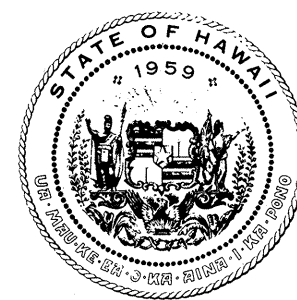


[illegible]

STATE OF HAWAII

DEPARTMENT OF TRANSPORTATION
HIGHWAYS DIVISION

HONOLULU, HAWAII



"AS BUILT"
PLANS FOR

PALI HIGHWAY RESURFACING
KUAKINI STREET TO HINALO PLACE

PROJECT NO. 61B-01-75M

DISTRICT OF HONOLULU
ISLAND OF OAHU

FED. ROAD DIST. NO.	STATE	PROJ. NO.	FISCAL YEAR	SHEET NO.	TOTAL SHEETS
HAWAII	HAW.	618-01-75M	1975	1	14

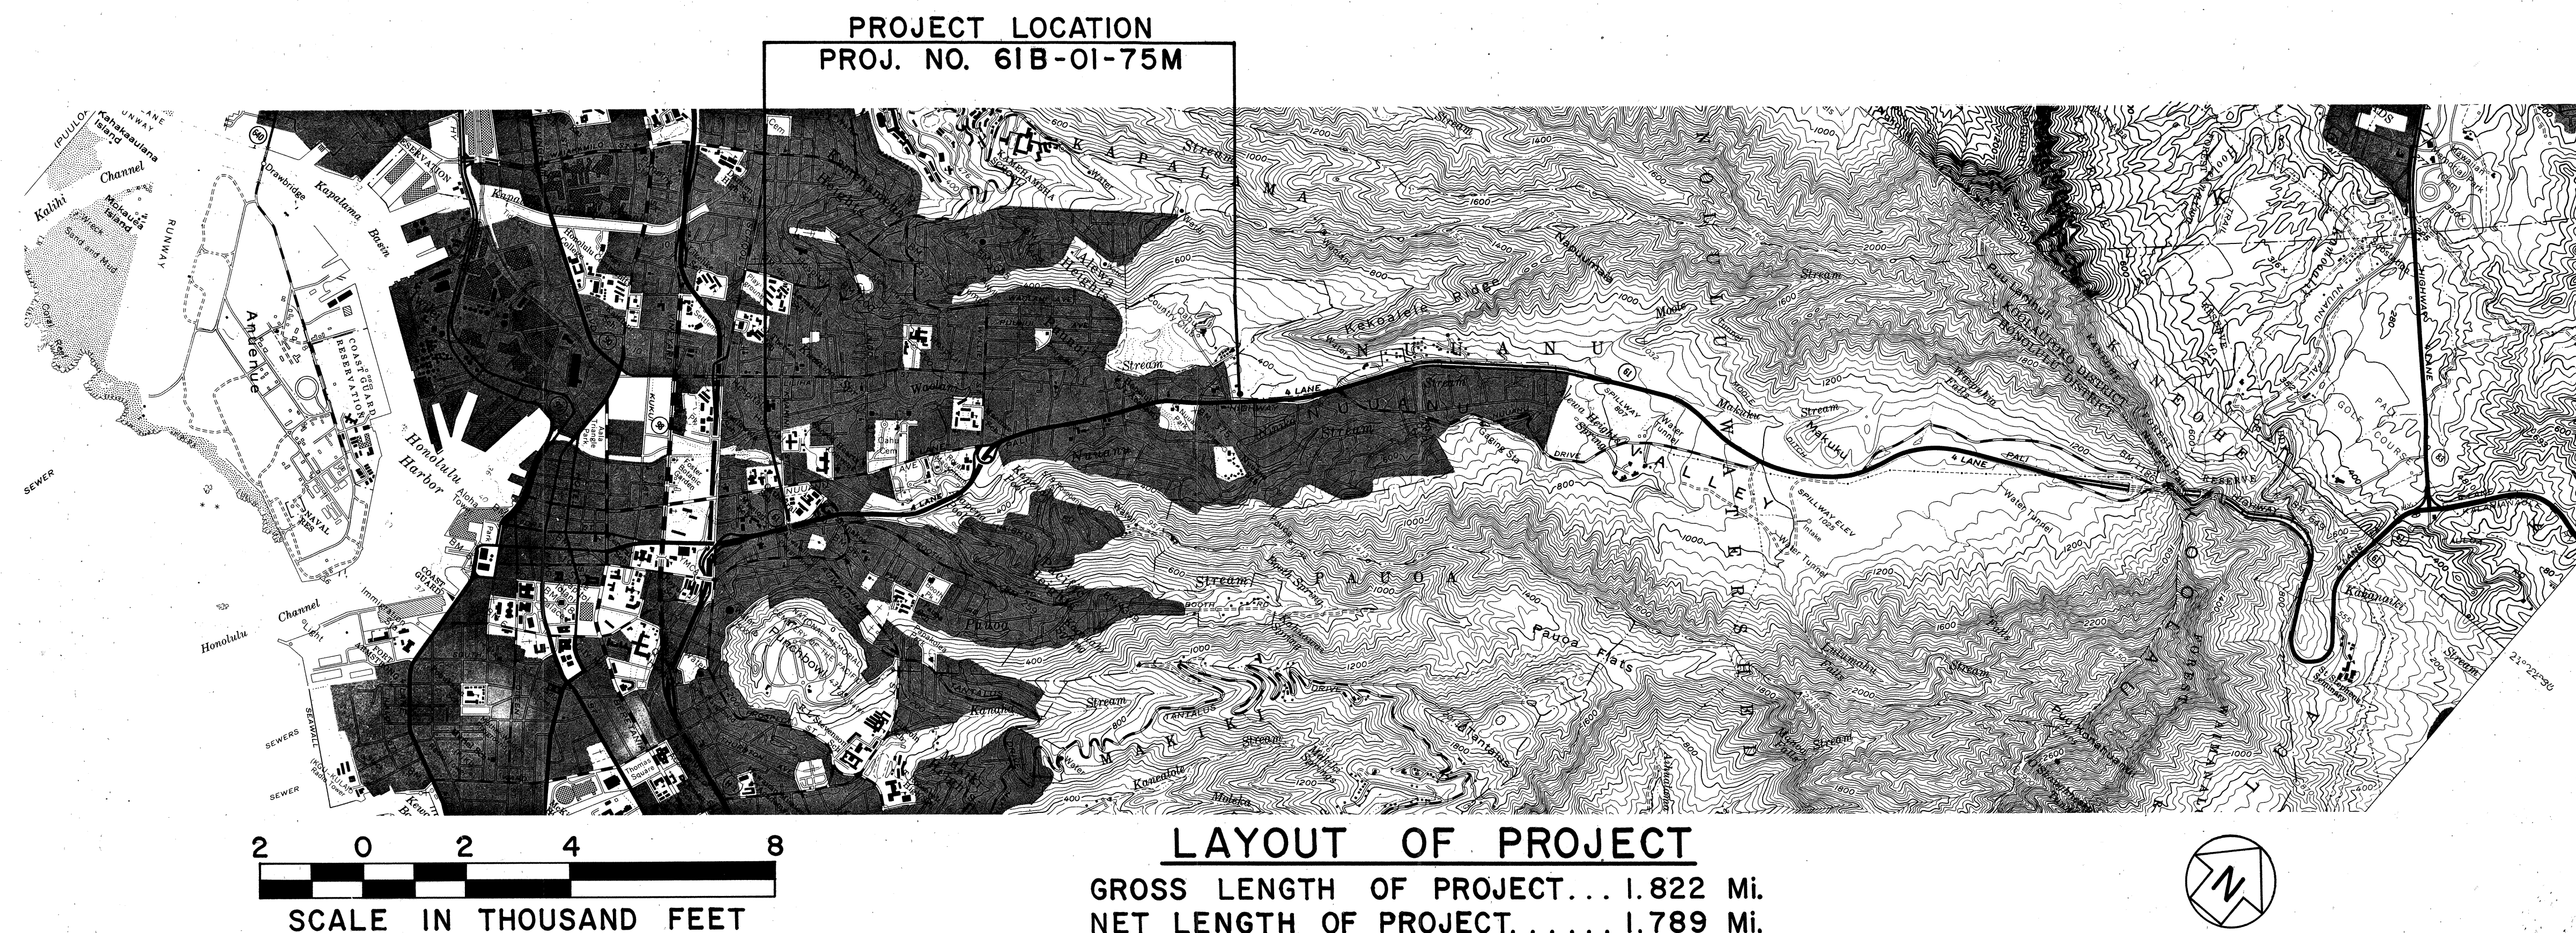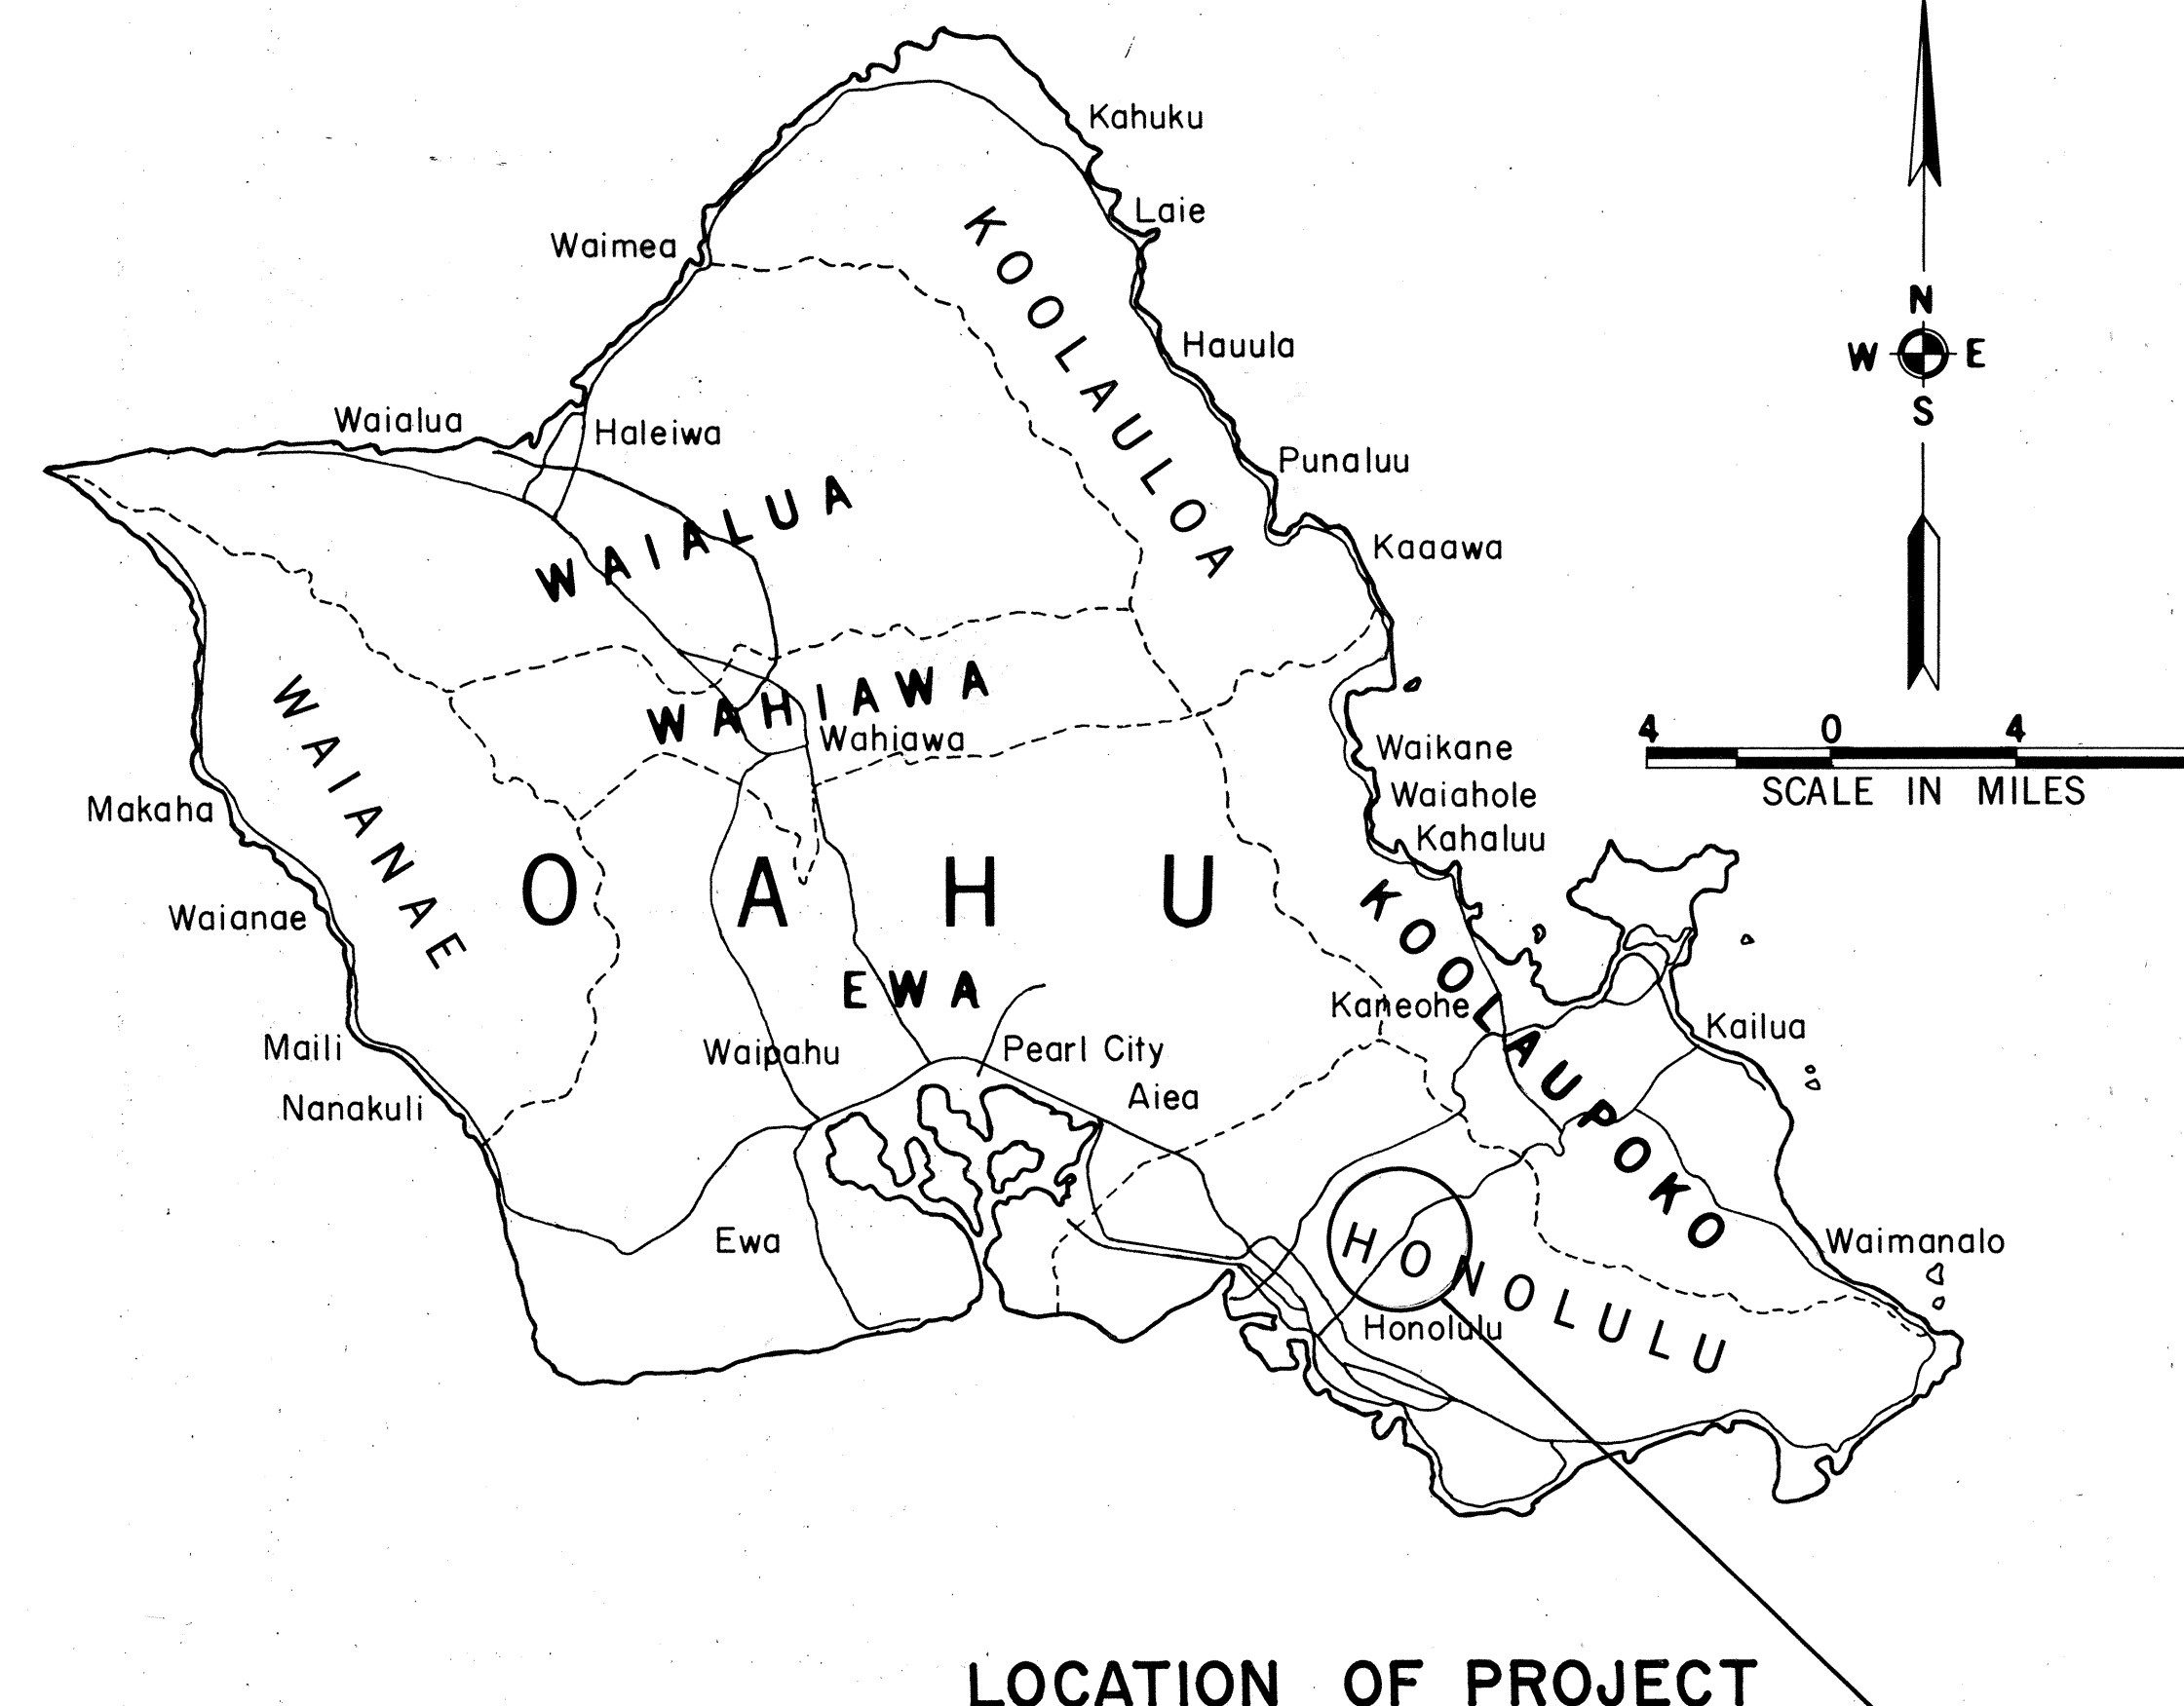

NOTE:
ALL CHANGES MADE DURING CONSTRUCTION
HAVE BEEN NOTED IN RED ON THESE
TRACINGS AND CHECKED BY:

Mike Upshaw 9/1/76
PROJECT ENGINEER DATE

DEPARTMENT OF TRANSPORTATION STATE OF HAWAII	
APPROVED:	
<i>E. Alvey Knight</i>	4/9/71
DIRECTOR OF TRANSPORTATION	DATE