


FED. ROAD DIST. NO.	STATE	PROJ. NO.	FISCAL YEAR	SHEET NO.	TOTAL SHEETS
HAWAII	HAW.	61BC-01-77M	1978	3	15

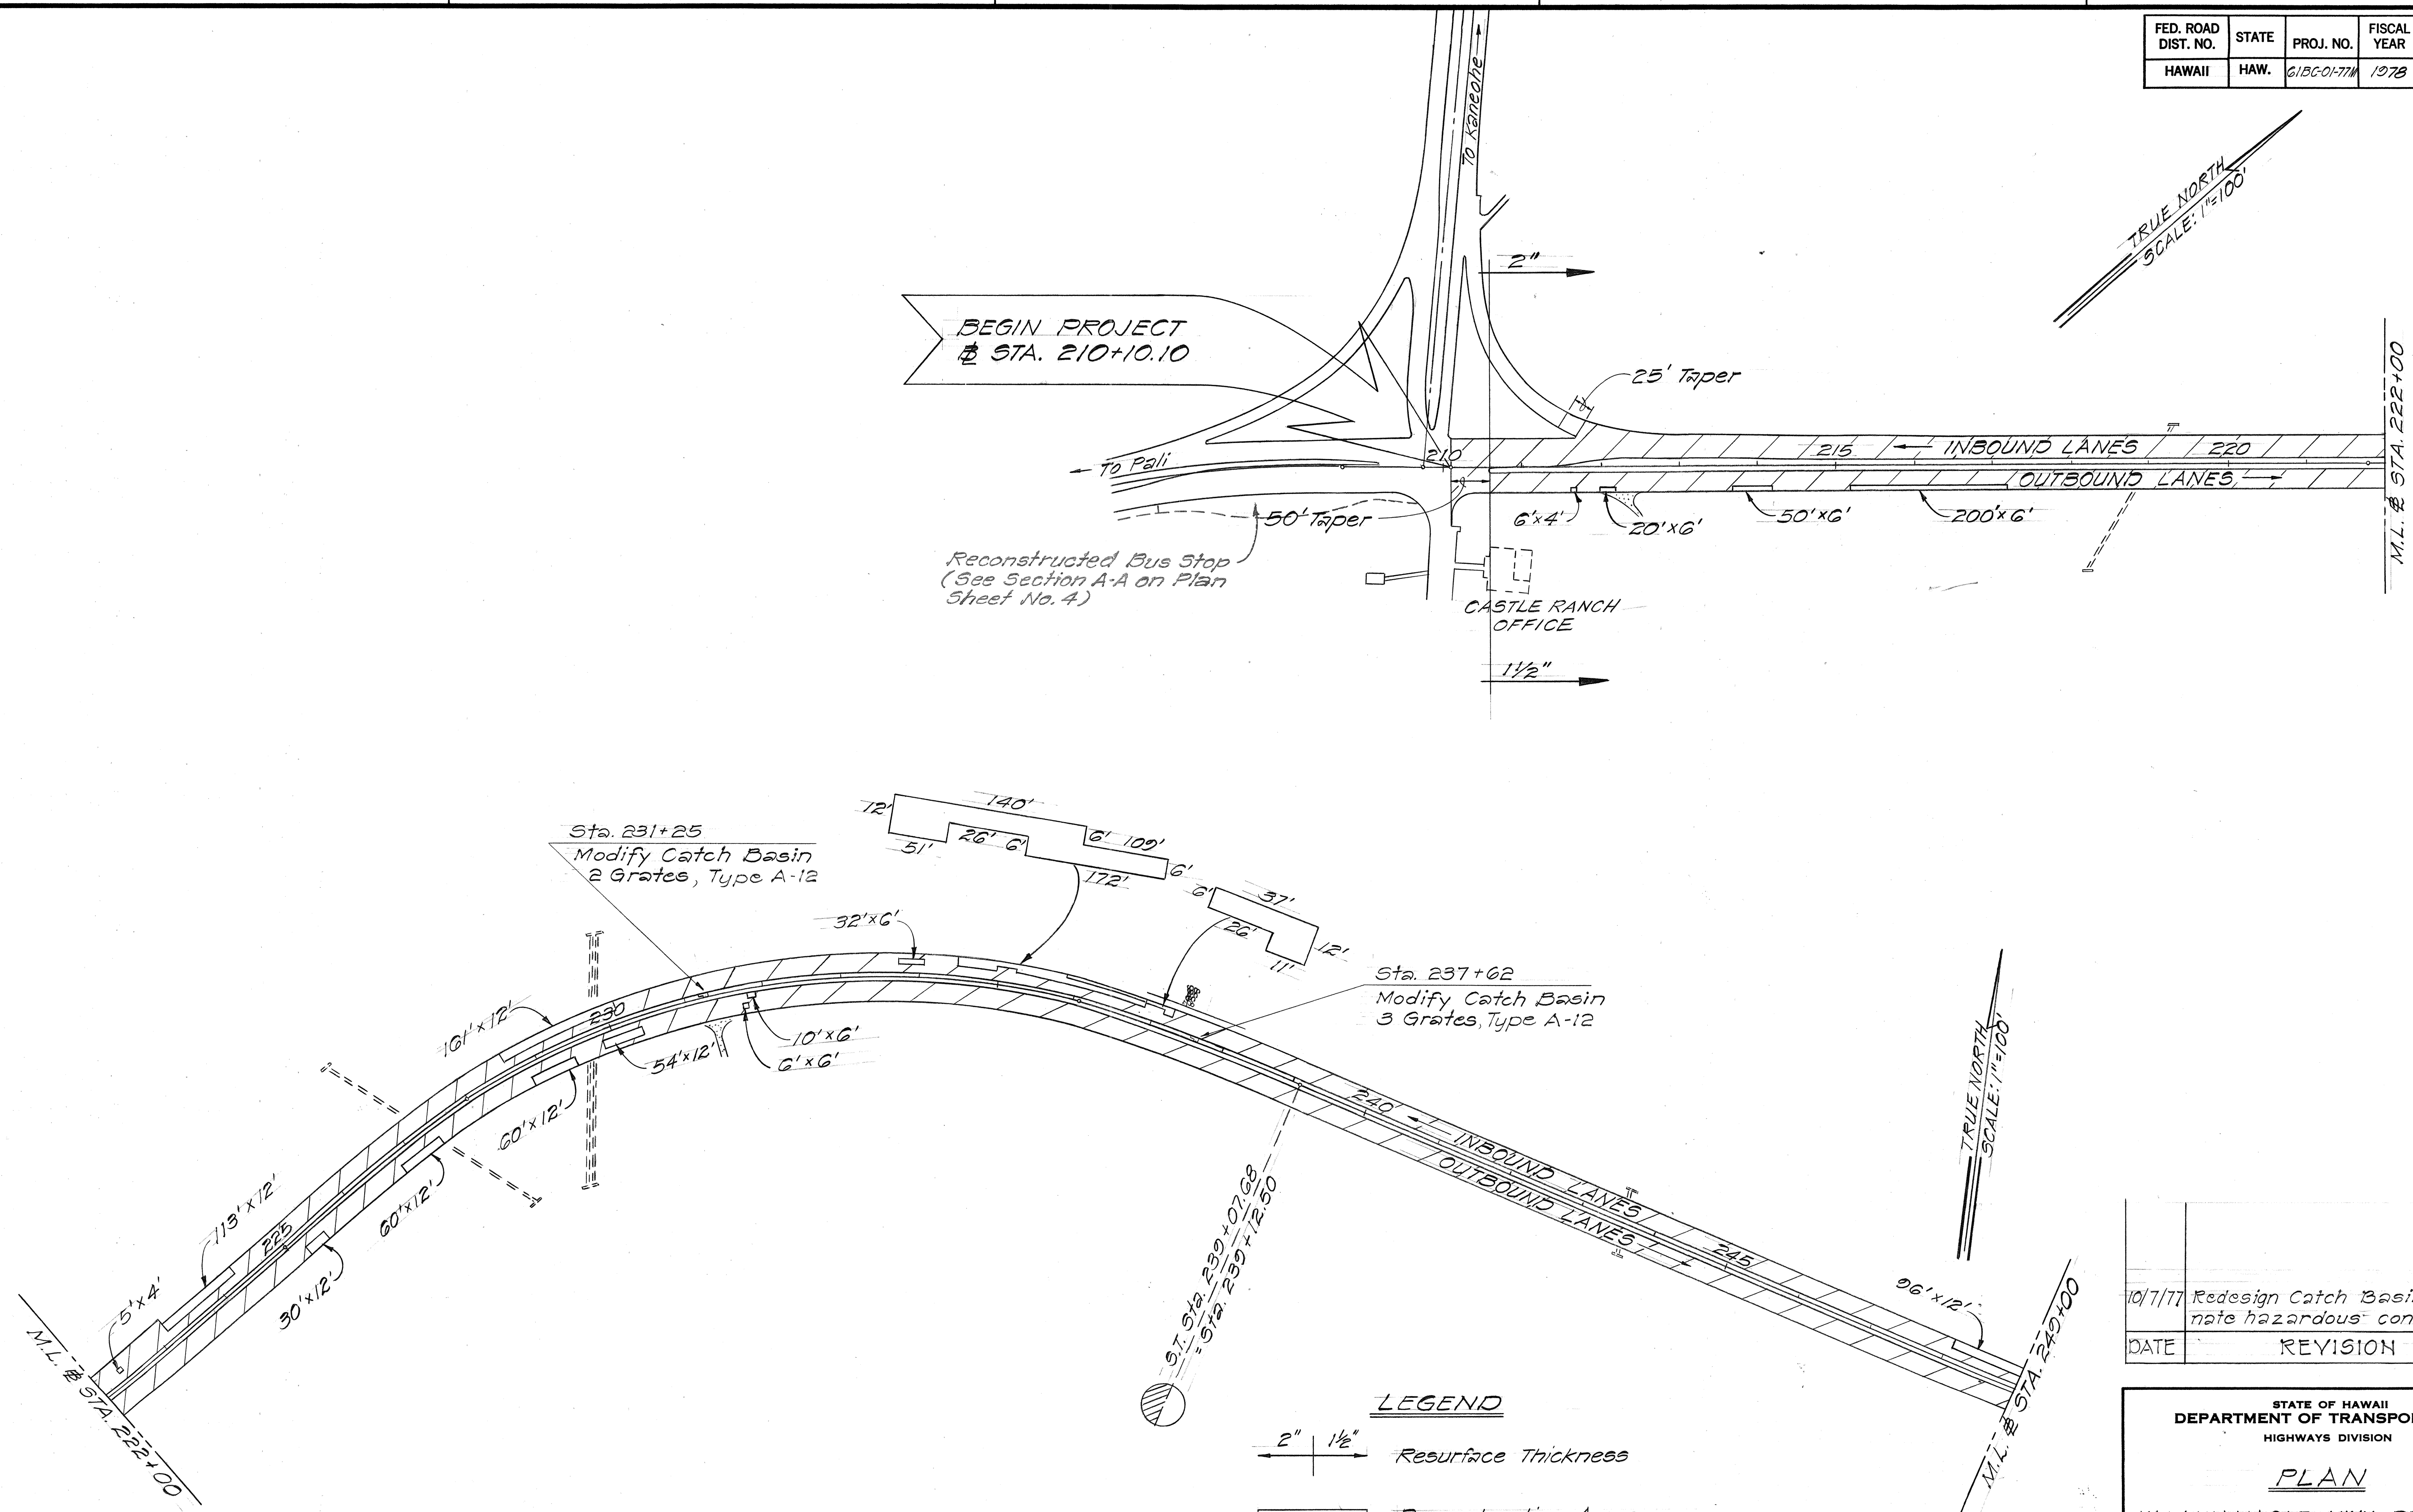

ORIGINAL PLAN	SURVEY PLOTTED BY	DATE
NO. 1	DRAWN BY	
	TRACED BY	
	DESIGNED BY	
	CHECKED BY	
	APPROVED BY	

10/7/77	Redesign Catch Basin to eliminate hazardous conditions
DATE	REVISION

STATE OF HAWAII
DEPARTMENT OF TRANSPORTATION
HIGHWAYS DIVISION


PLAN

KALANIANAʻOLE HWY. RESURFACING
PROJECT NO. 61BC-01-77M

Scale: 1"=100' Date: Sept., 1977

SHEET No. 1 OF 3 SHEETS

FED. ROAD DIST. NO.	STATE	PROJ. NO.	FISCAL YEAR	SHEET NO.	TOTAL SHEETS
HAWAII	HAW.	61BC-01-77M	1978	4	15

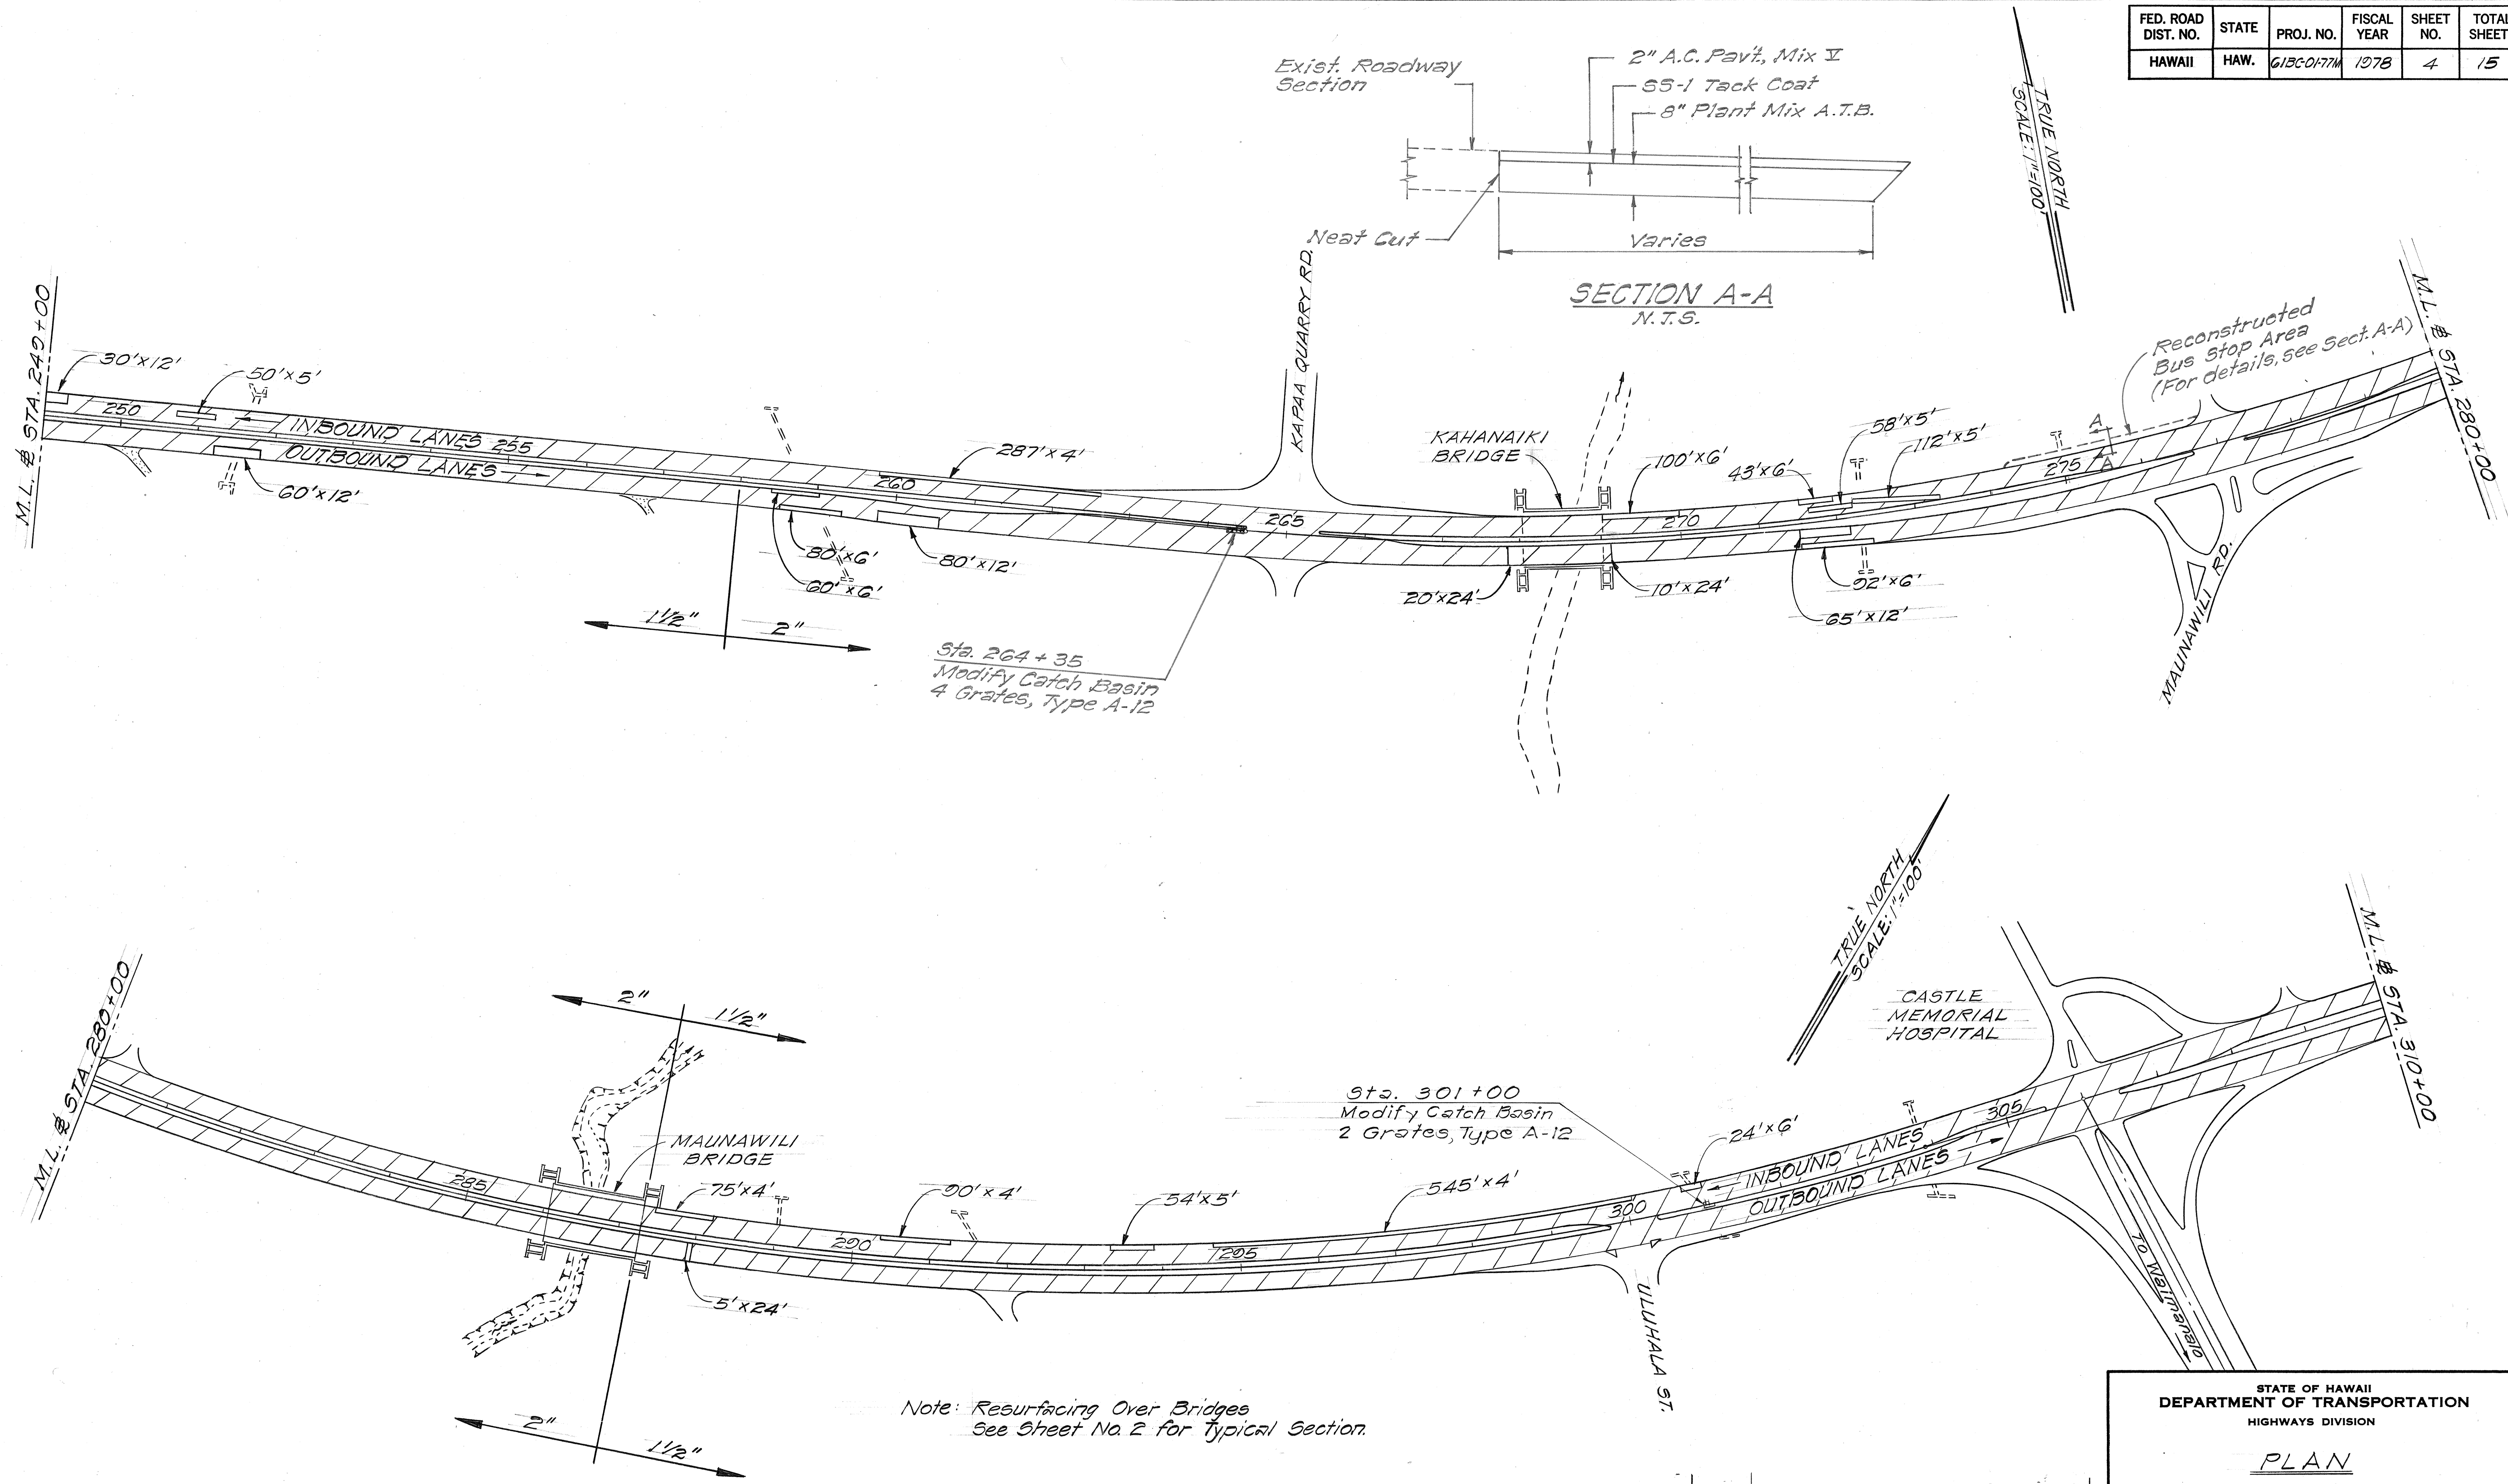

Note: Resurfacing Over Bridges
See Sheet No. 2 for Typical Section.

DATE	REVISION
10/7/77	Redesign Catch Basin to eliminate hazardous conditions

STATE OF HAWAII
DEPARTMENT OF TRANSPORTATION
HIGHWAYS DIVISION

PLAN

KALANIANAʻOLE HWY. RESURFACING
PROJECT NO. 61BC-01-77M


Scale: 1"=100' Date: Sept., 1977

SHEET NO. 2 OF 3 SHEETS

ORIGINAL PLAN	SURVEY PLOTTED BY	DATE
DESIGNED BY	DRAWN BY	"
NOTED BY	TRACED BY	"
QUANTITIES BY	DESIGNED BY	"
CHECKED BY	NOTED BY	"

FED. ROAD DIST. NO.	STATE	PROJ. NO.	FISCAL YEAR	SHEET NO.	TOTAL SHEETS
HAWAII	HAW.	61BC-01-77M	1976	5	15

TRUE NORTH
SCALE: 1"=100'

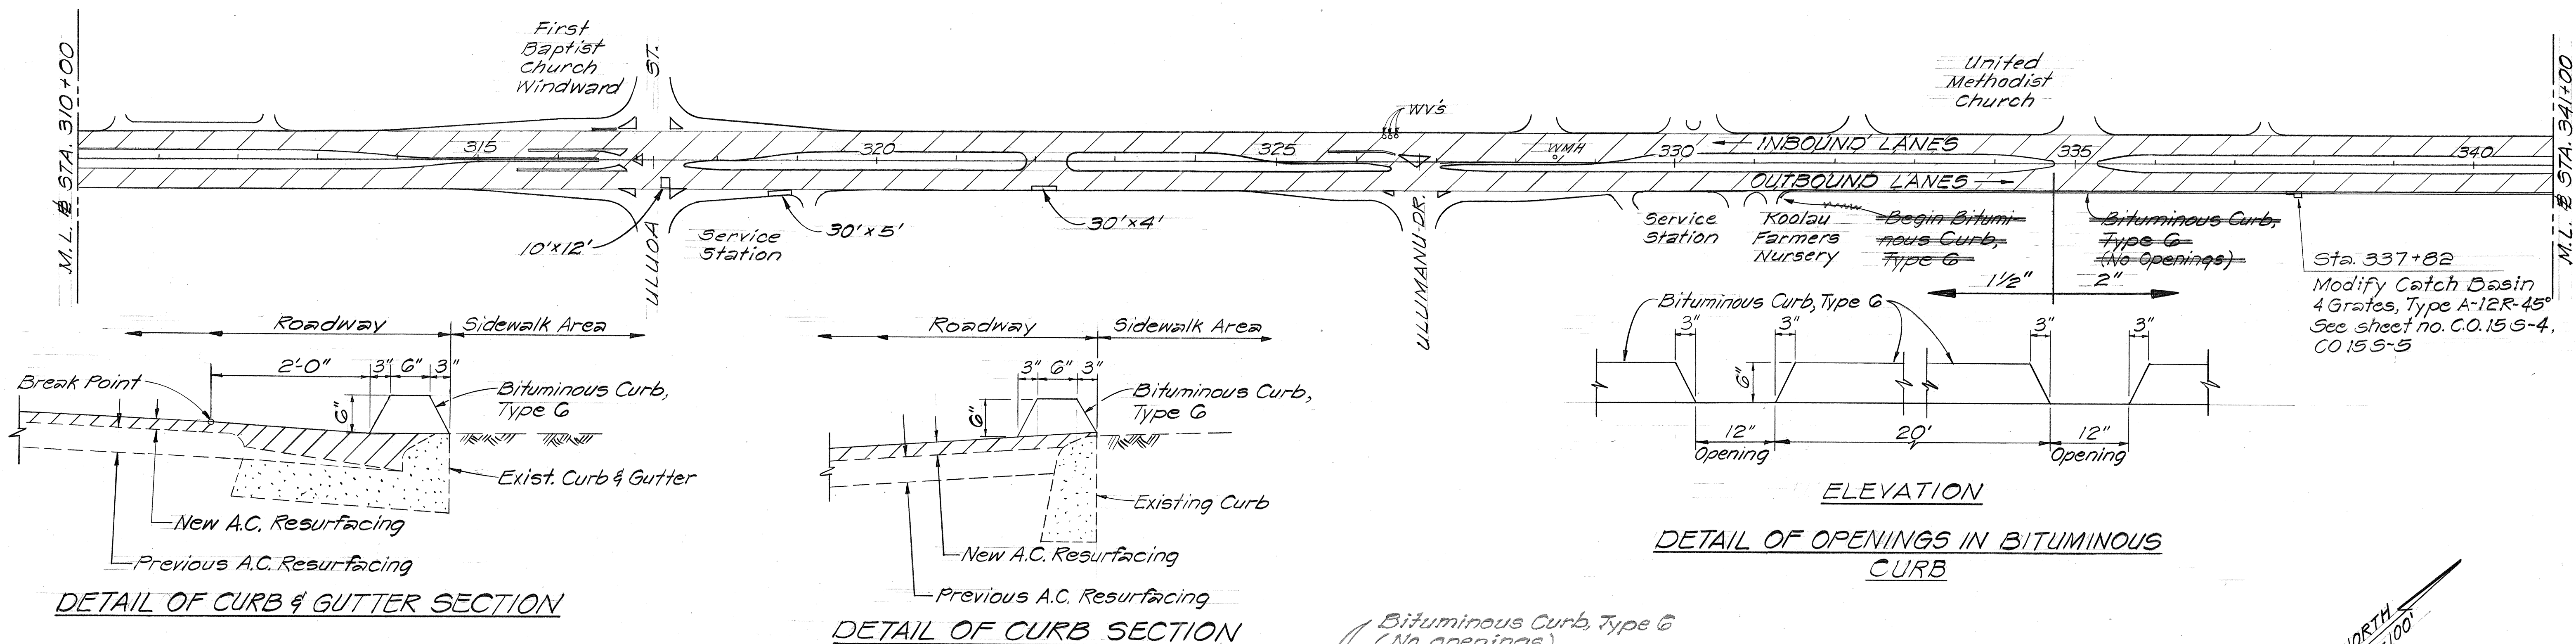


ELEVATION
DETAIL OF OPENINGS IN BITUMINOUS CURB

DETAIL OF CURB & GUTTER SECTION

DETAIL OF CURB SECTION

NOTE: The Top and Roadway Side of the Bituminous Curb shall be painted white in accordance with "Section 642 - Pavement Striping" of the Standard Specifications.

BITUMINOUS CURB DETAILS
Scale: 1"=1'-0"

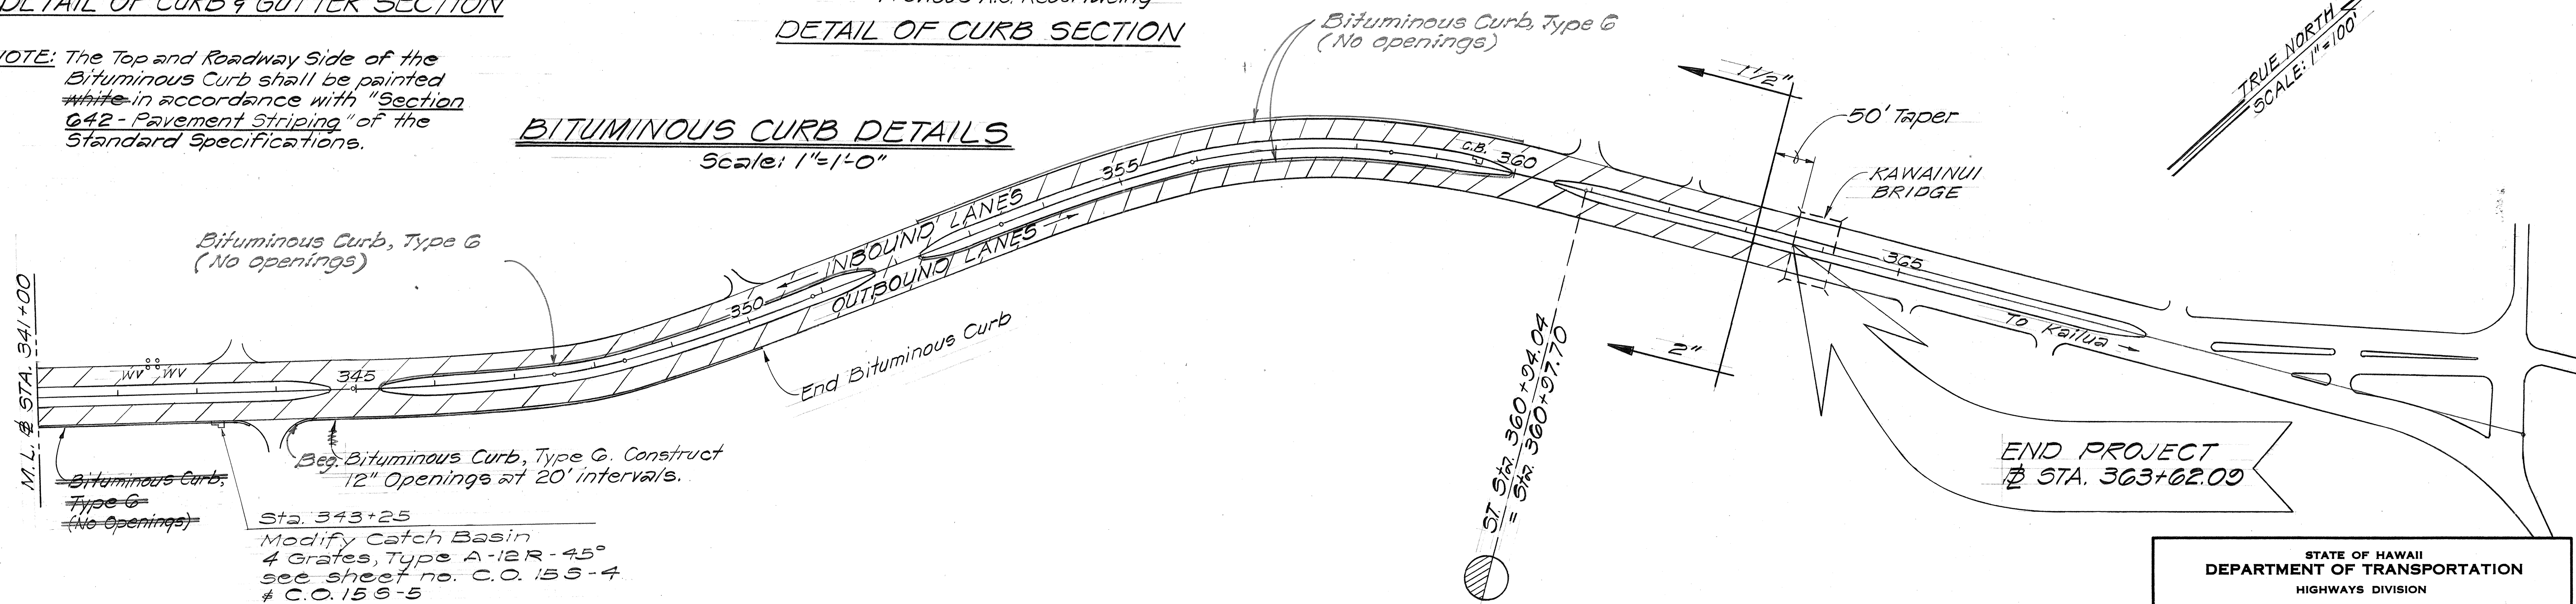

TRUE NORTH
SCALE: 1"=100'

DATE	REVISION
10/19/77	Design of Bituminous Curb and Redesign Catch Basins to eliminate hazardous conditions

STATE OF HAWAII
DEPARTMENT OF TRANSPORTATION
HIGHWAYS DIVISION

PLAN

KALANIANA'OLE HWY. RESURFACING
PROJECT NO. 61BC-01-77M

Scale: 1"=100' Date: Sept, 1977

SHEET No. 3 OF 3 SHEETS

SURVEY PLOTTED BY	DATE
DRAWN BY	
DESIGNED BY	
QUANTITIES BY	
CHECKED BY	