· IN	DEX TO DRAWINGS
SHEET NO.	DESCRIPTION
	TITLE SHEET
· · ·	TYP SECTIONS, GEN. NOTES
2	8 MONUMENT ADJUSTMENT
	DETAILS
3-5	PLAN
6 -15	PAV'T MARKINGS & DETAILS
CO 15 S-1	
TO CO 15 S-5	DRAINAGE DETAILS
•	
The state of the s	

TOTAL SHEET COUNT AFTER "AS BUILT" POSTINGS. 20 SHEETS



STATE OF HAWAII



DEPARTMENT OF TRANSPORTATION LAND TRANSPORTATION FACILITIES DIVISION

HONOLULU, HAWAII


"AS BUILT"

PLANS FOR


KALANIANAOLE HIGHWAY RESURFACING CASTLE JUNCTION TO KAWAINUI BRIDGE

PROJECT NO. 61BC-01-77M

DISTRICT OF KOOLAUPOKO ISLAND OF OAHU

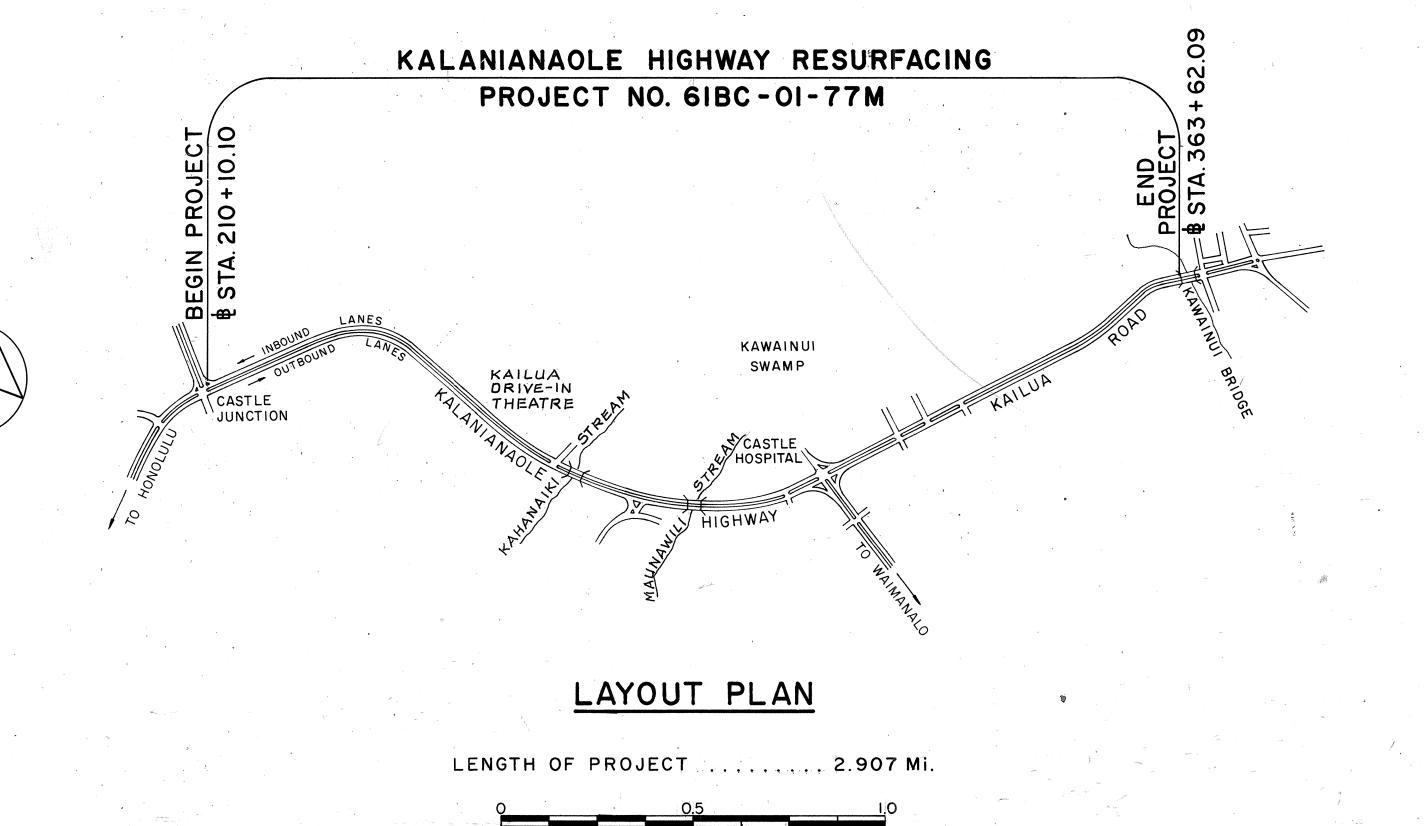

SCALE IN MILES

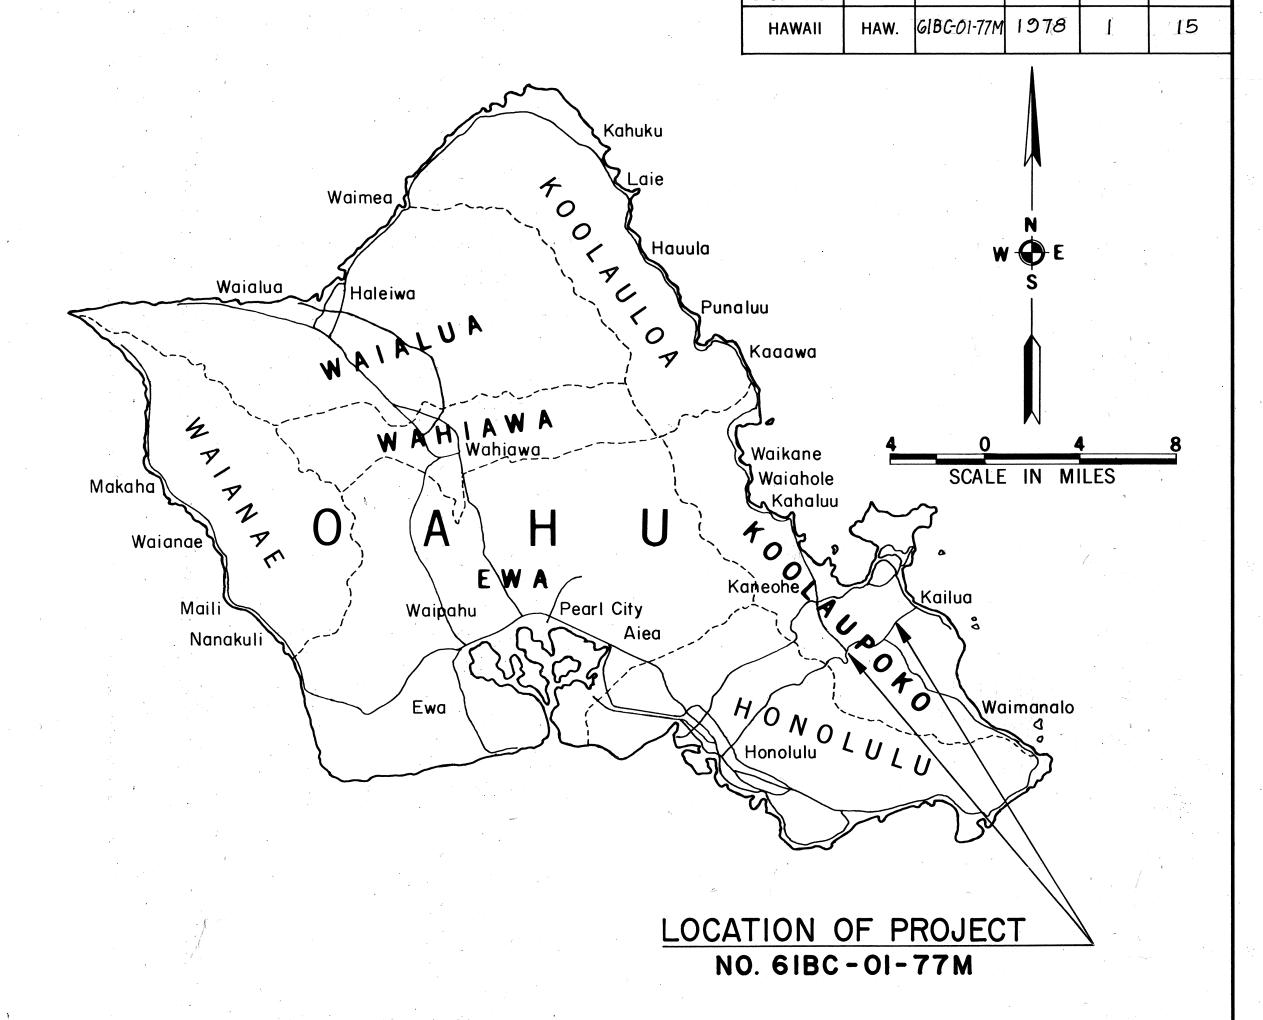

ALL CHANGES MADE DURING CONSTRUCTION HAVE BEEN INCORPORATED ON THESE PLANS IN RED EXCEPT CHANGES IN THE ORIGINAL THEORETICAL QUANTITIES. FOR ACTUAL QUANTITIES, REFER TO PROJECT LEDGER AND OR COMPUTATION BOOK.

Robert Y. Muronaka RESIDENT ENGINEER

11-22-78 DATE

DEPARTMENT OF TRANSPORTATION
STATE OF HAWAII

DIR. OF TRANSPORTATION

DATE