	INDEX TO DRAWINGS
SHEET NO.	DESCRIPTION
	TITLE SHEET
2	PLAN SHEET
3	TYPICAL SECTION AND DETAILS
4-7	STANDARD DETAILS
,	
·	
•	



LAND

STATE OF HAWAII

TRANSPORTATION DEPARTMENT OF TRANSPORTATION **FACILITIES**


DIVISION


HONOLULU, HAWAII
"AS-BUILT" PLANS FOR

HIGHWAY PALI

WALKWAY AT WYLLIE STREET OVERPASS PROJECT NO. 61B-02-79

> DISTRICT OF HONOLULU ISLAND OF OAHU

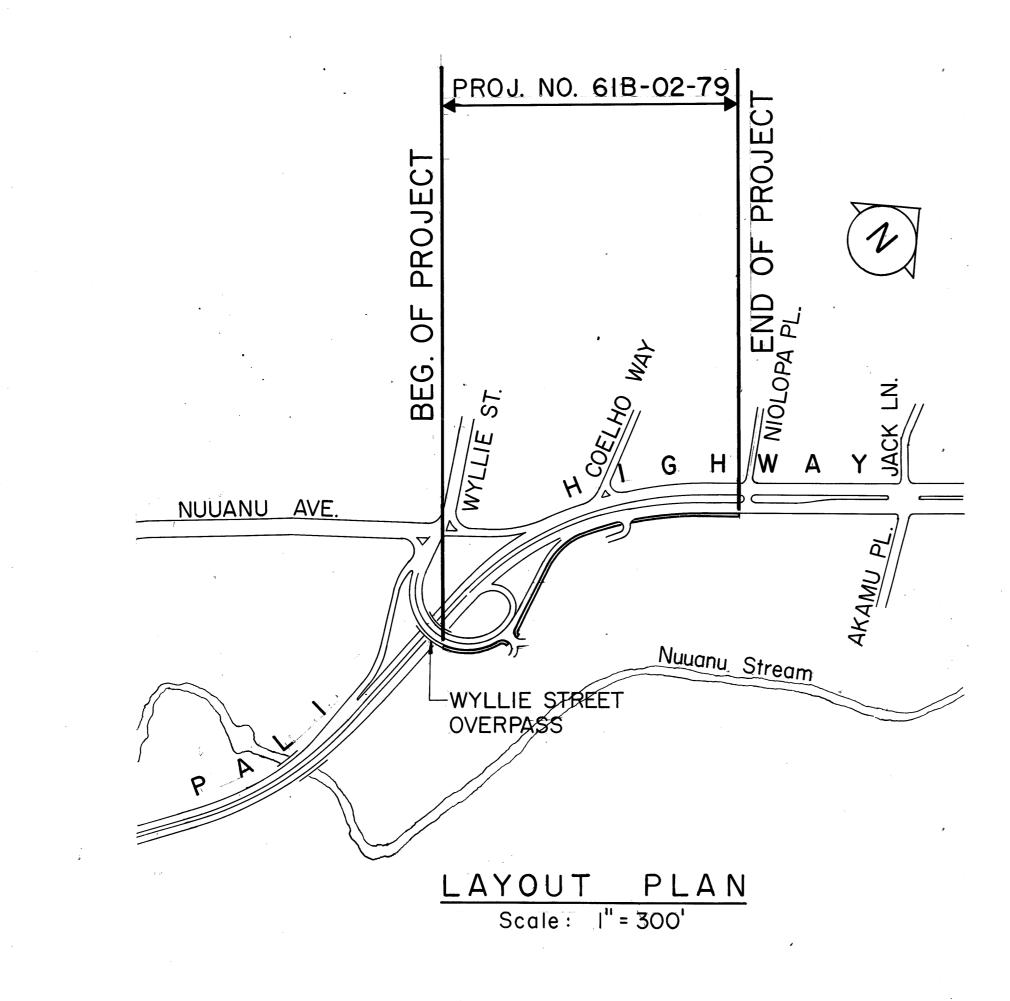

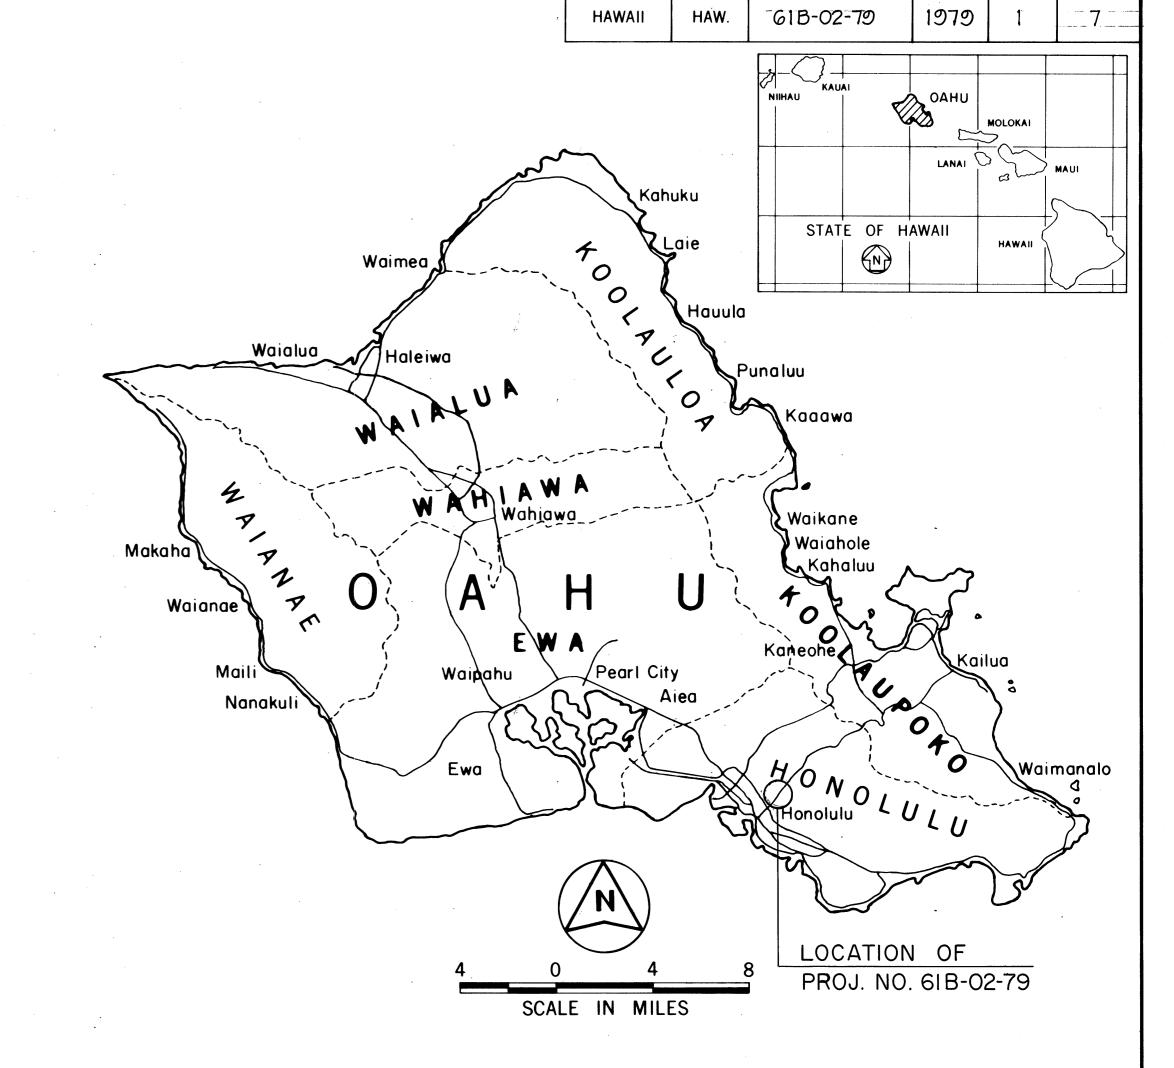

FED. ROAD DIST. NO.

ALL CHANGES MADE DURING CONSTRUCTION HAVE BEEN INCORPORATED ON THESE PLANS EXCEPT CHANGES IN THE ORIGINAL THEORETICAL QUANTITIES.

FISCAL SHEET YEAR NO.

PROJ. NO.

DEPARTMENT OF TRANSPORTATION STATE OF HAWAII