

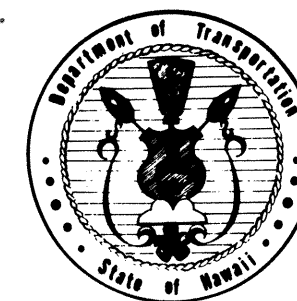
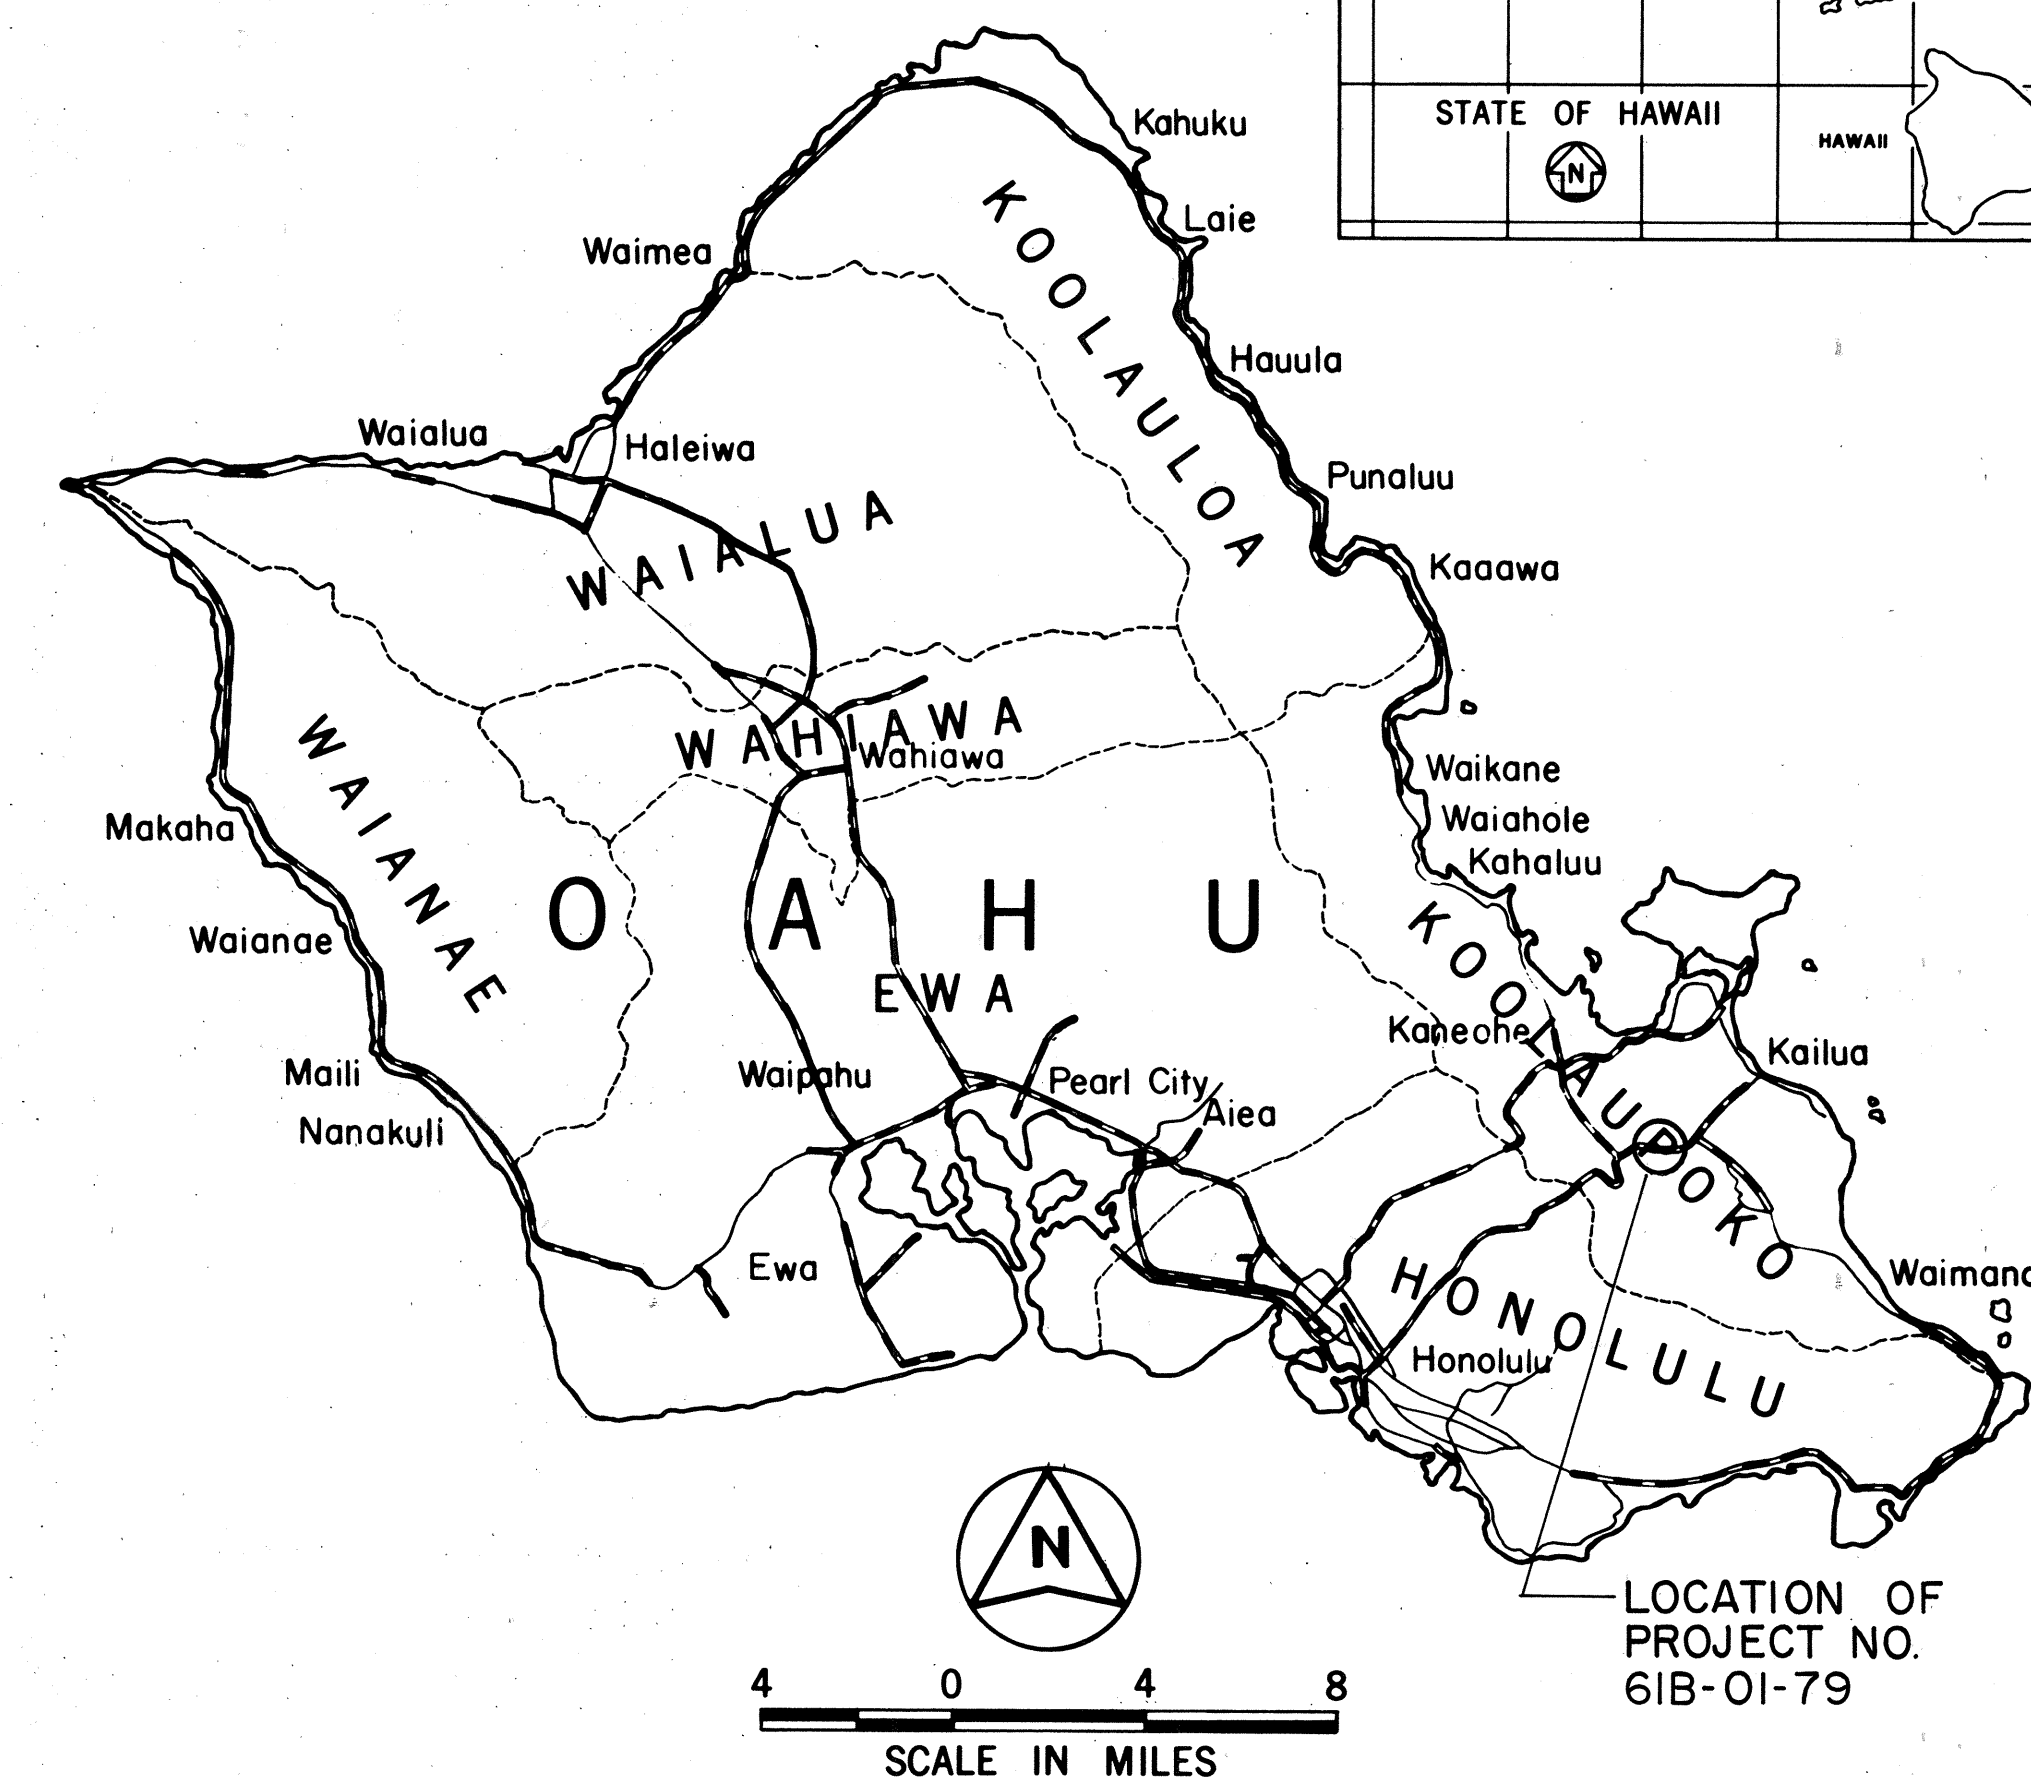


Design Unit "E"	A. Yamaguchi	548-7537	1/5/79
DESIGNED BY	P. S. & E. BY	PHONE	DATE

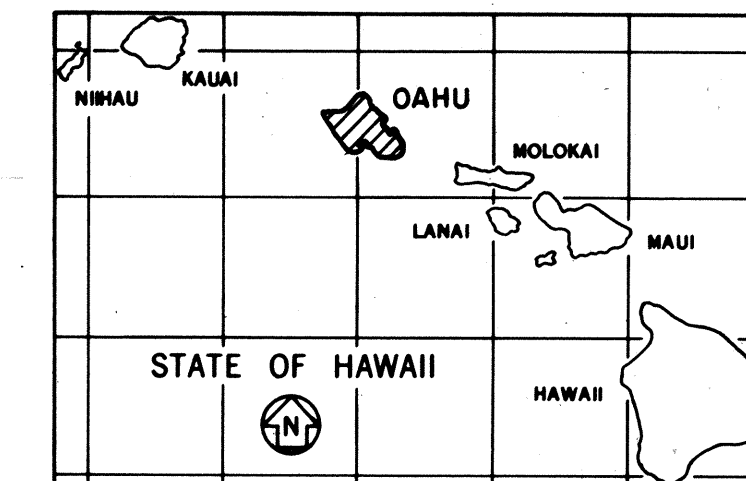


FED. ROAD DIST. NO.	STATE	PROJ. NO.	FISCAL YEAR	SHEET NO.	TOTAL SHEETS
HAWAII	HAW.	61B-01-79	1979	1	24

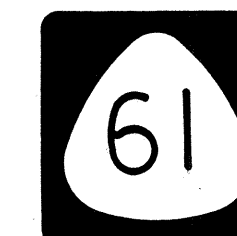

ALL CHANGES MADE DURING CONSTRUCTION  
HAVE BEEN INCORPORATED ON THESE  
PLANS EXCEPT CHANGES IN THE ORIGINAL  
THEORETICAL QUANTITIES.

Robert Y. Muroaka  
PROJECT ENGINEER

2/3/8.  
DATE

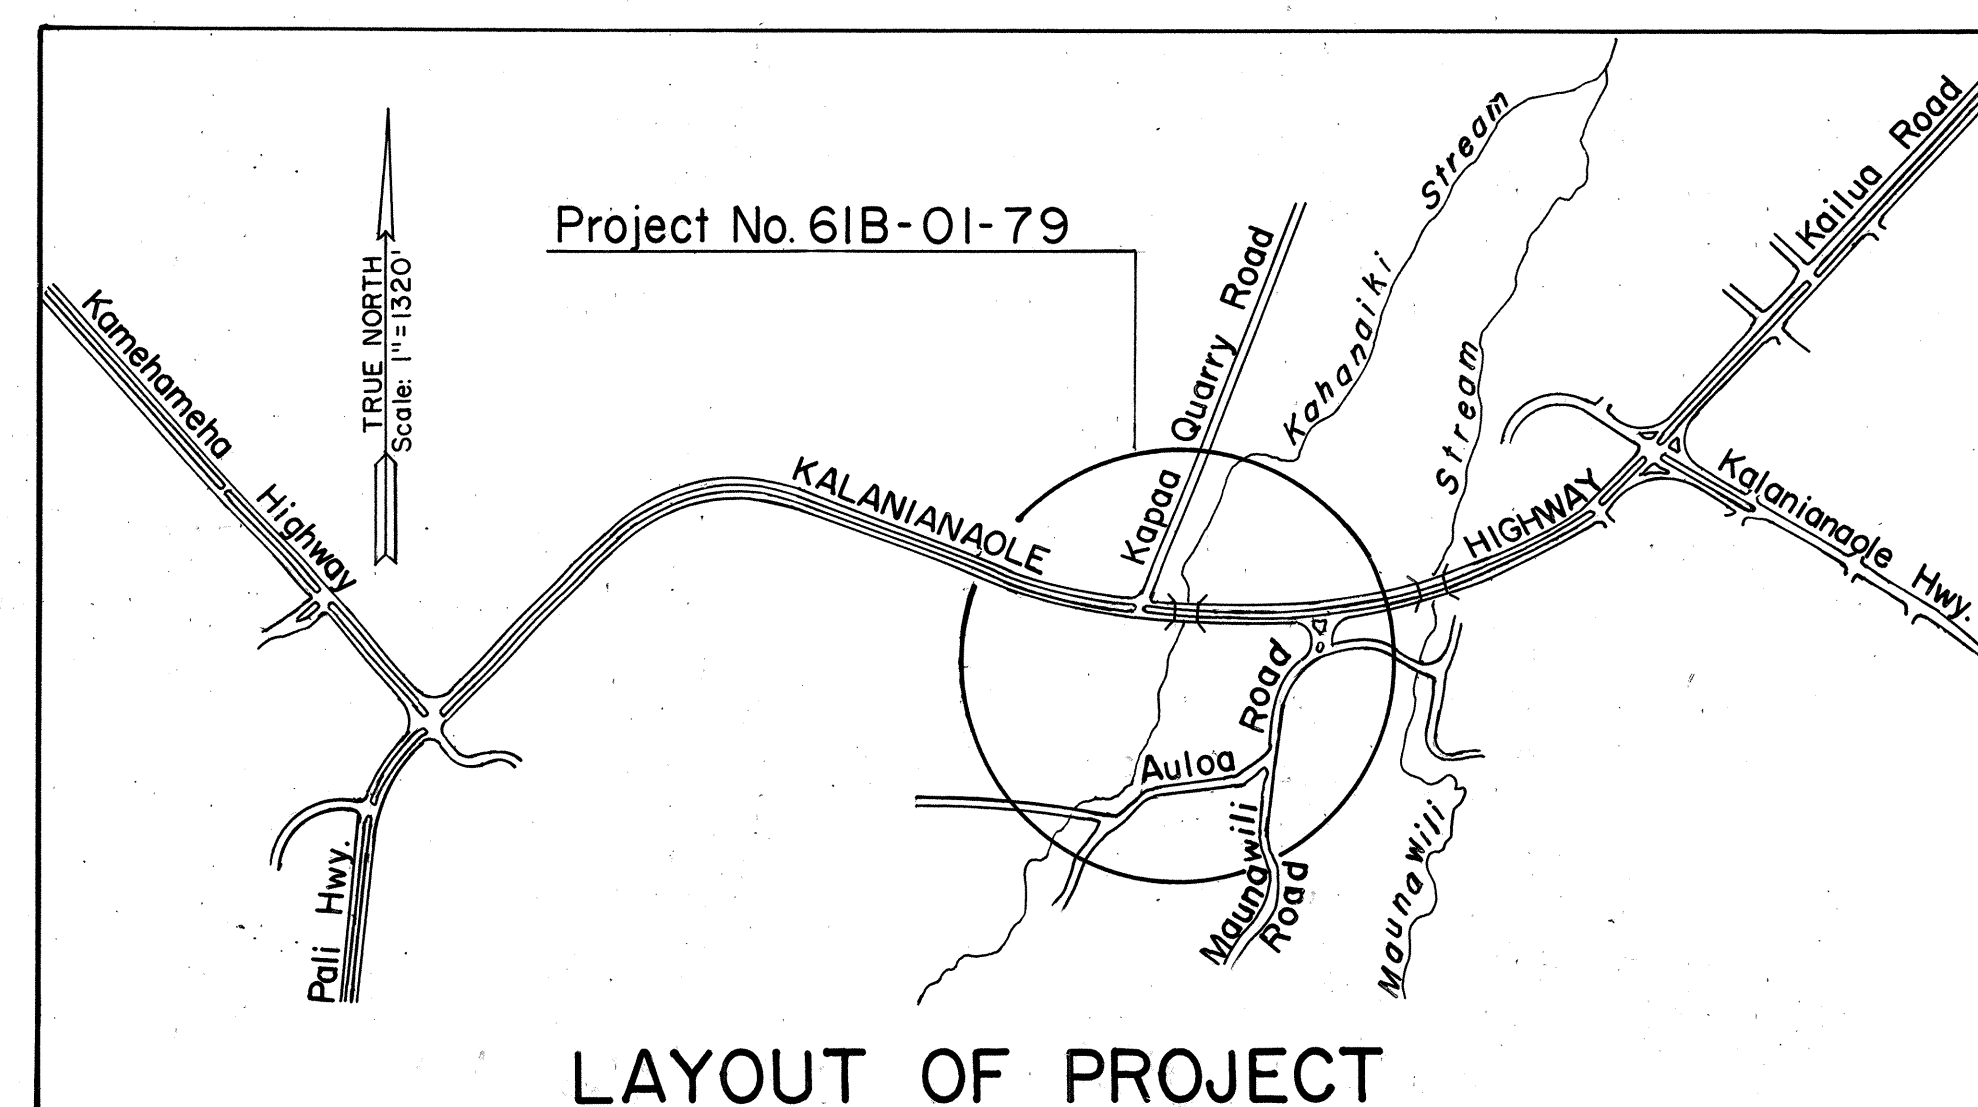

DEPARTMENT OF TRANSPORTATION STATE OF HAWAII	
APPROVED: <i>Ryohichi Higashionna</i>	<i>Jan 5, 1968</i>
DIR. OF TRANSPORTATION	DATE