


FED. ROAD DIST. NO.	STATE	PROJ. NO.	FISCAL YEAR	SHEET NO.	TOTAL SHEETS
HAWAII	HAW.	618-01-79	1979	4	24



ORIGINAL PLAN	SURVEY PLOTTED BY	DATE
NOTE BOOK	DRAWN BY	"
No.	DESIGNED BY	"
	QUANTITIES BY	"
	CHECKED BY	"

STATE OF HAWAII
DEPARTMENT OF TRANSPORTATION
LAND TRANSPORTATION FACILITIES DIVISION
TRAFFIC SIGNAL INSTALLATION
KALANIANA'OLE HWY.
BET KAPAA QUARRY RD
E AULOA RD
PROJ. NO. 618-01-79
SCALE: 1" = 20' AUG. 1978
SHEET No. 4 OF 24 SHEETS

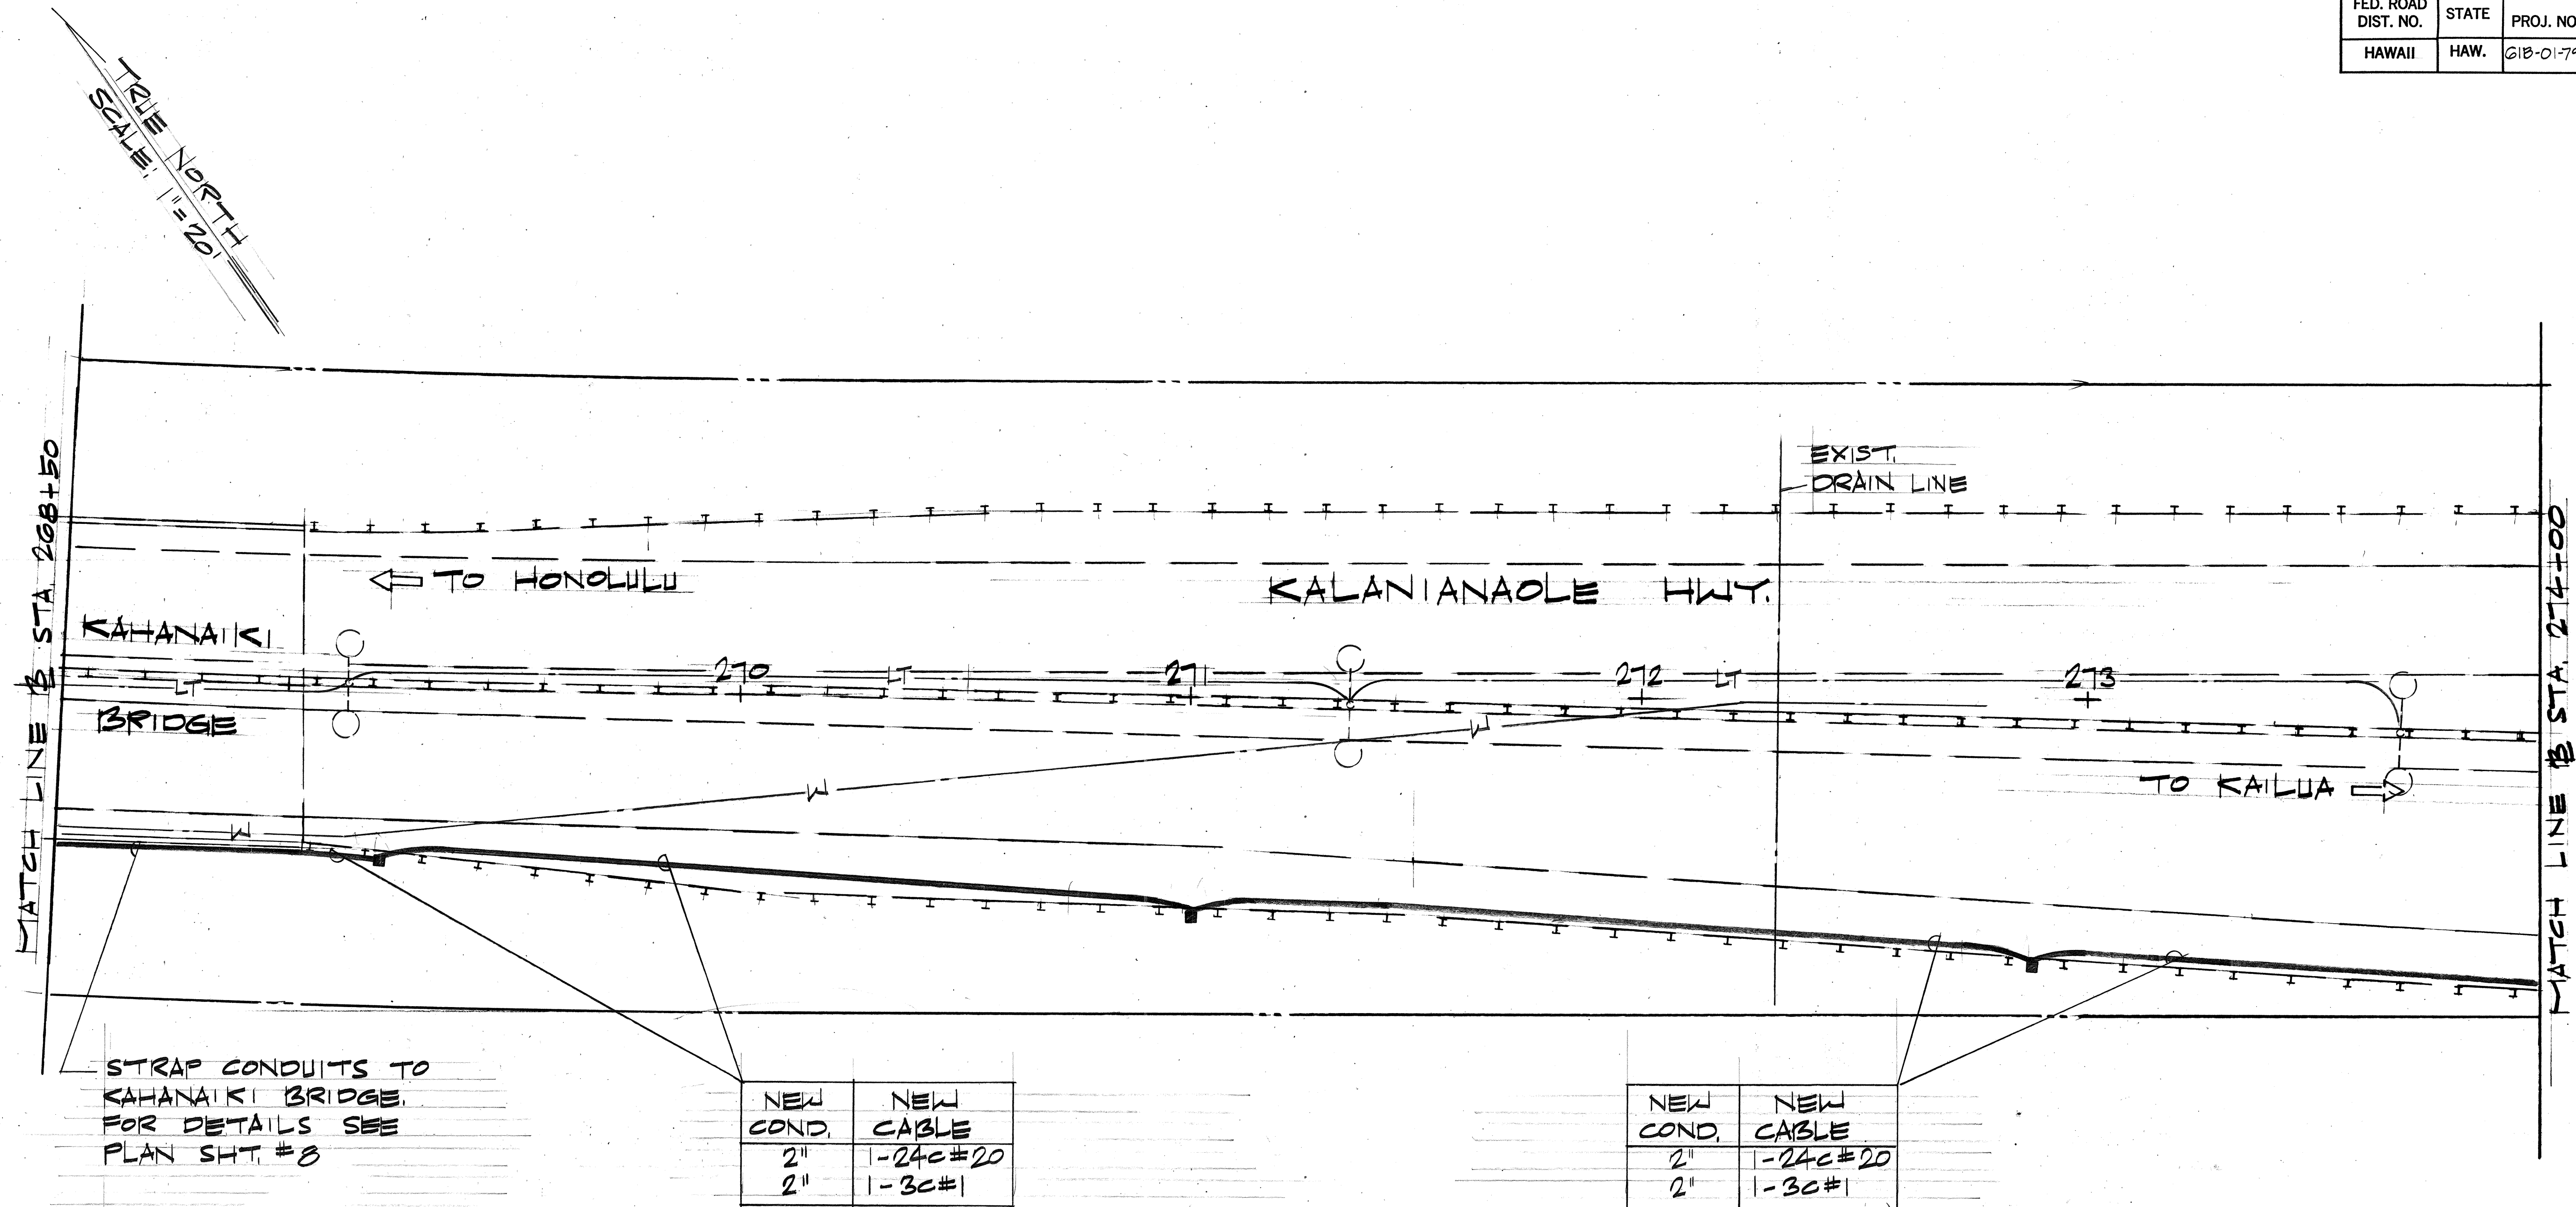