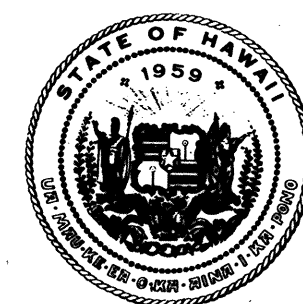


[illegible]

STATE OF HAWAII

DEPARTMENT OF TRANSPORTATION

HIGHWAYS DIVISION

HONOLULU, HAWAII

"AS BUILT"

PLANS FOR

PALI HIGHWAY


CLEAN AND PAINT PALI TUNNELS

PROJECT NO. 61D-01-80M

DISTRICTS OF HONOLULU & KOOLAUPOKO

ISLAND OF OAHU

FED. ROAD DIST. NO.	STATE	PROJ. NO.	FISCAL YEAR	SHEET NO.	TOTAL SHEET.
HAWAII	HAW.	61D-01-80M	1980	1	8

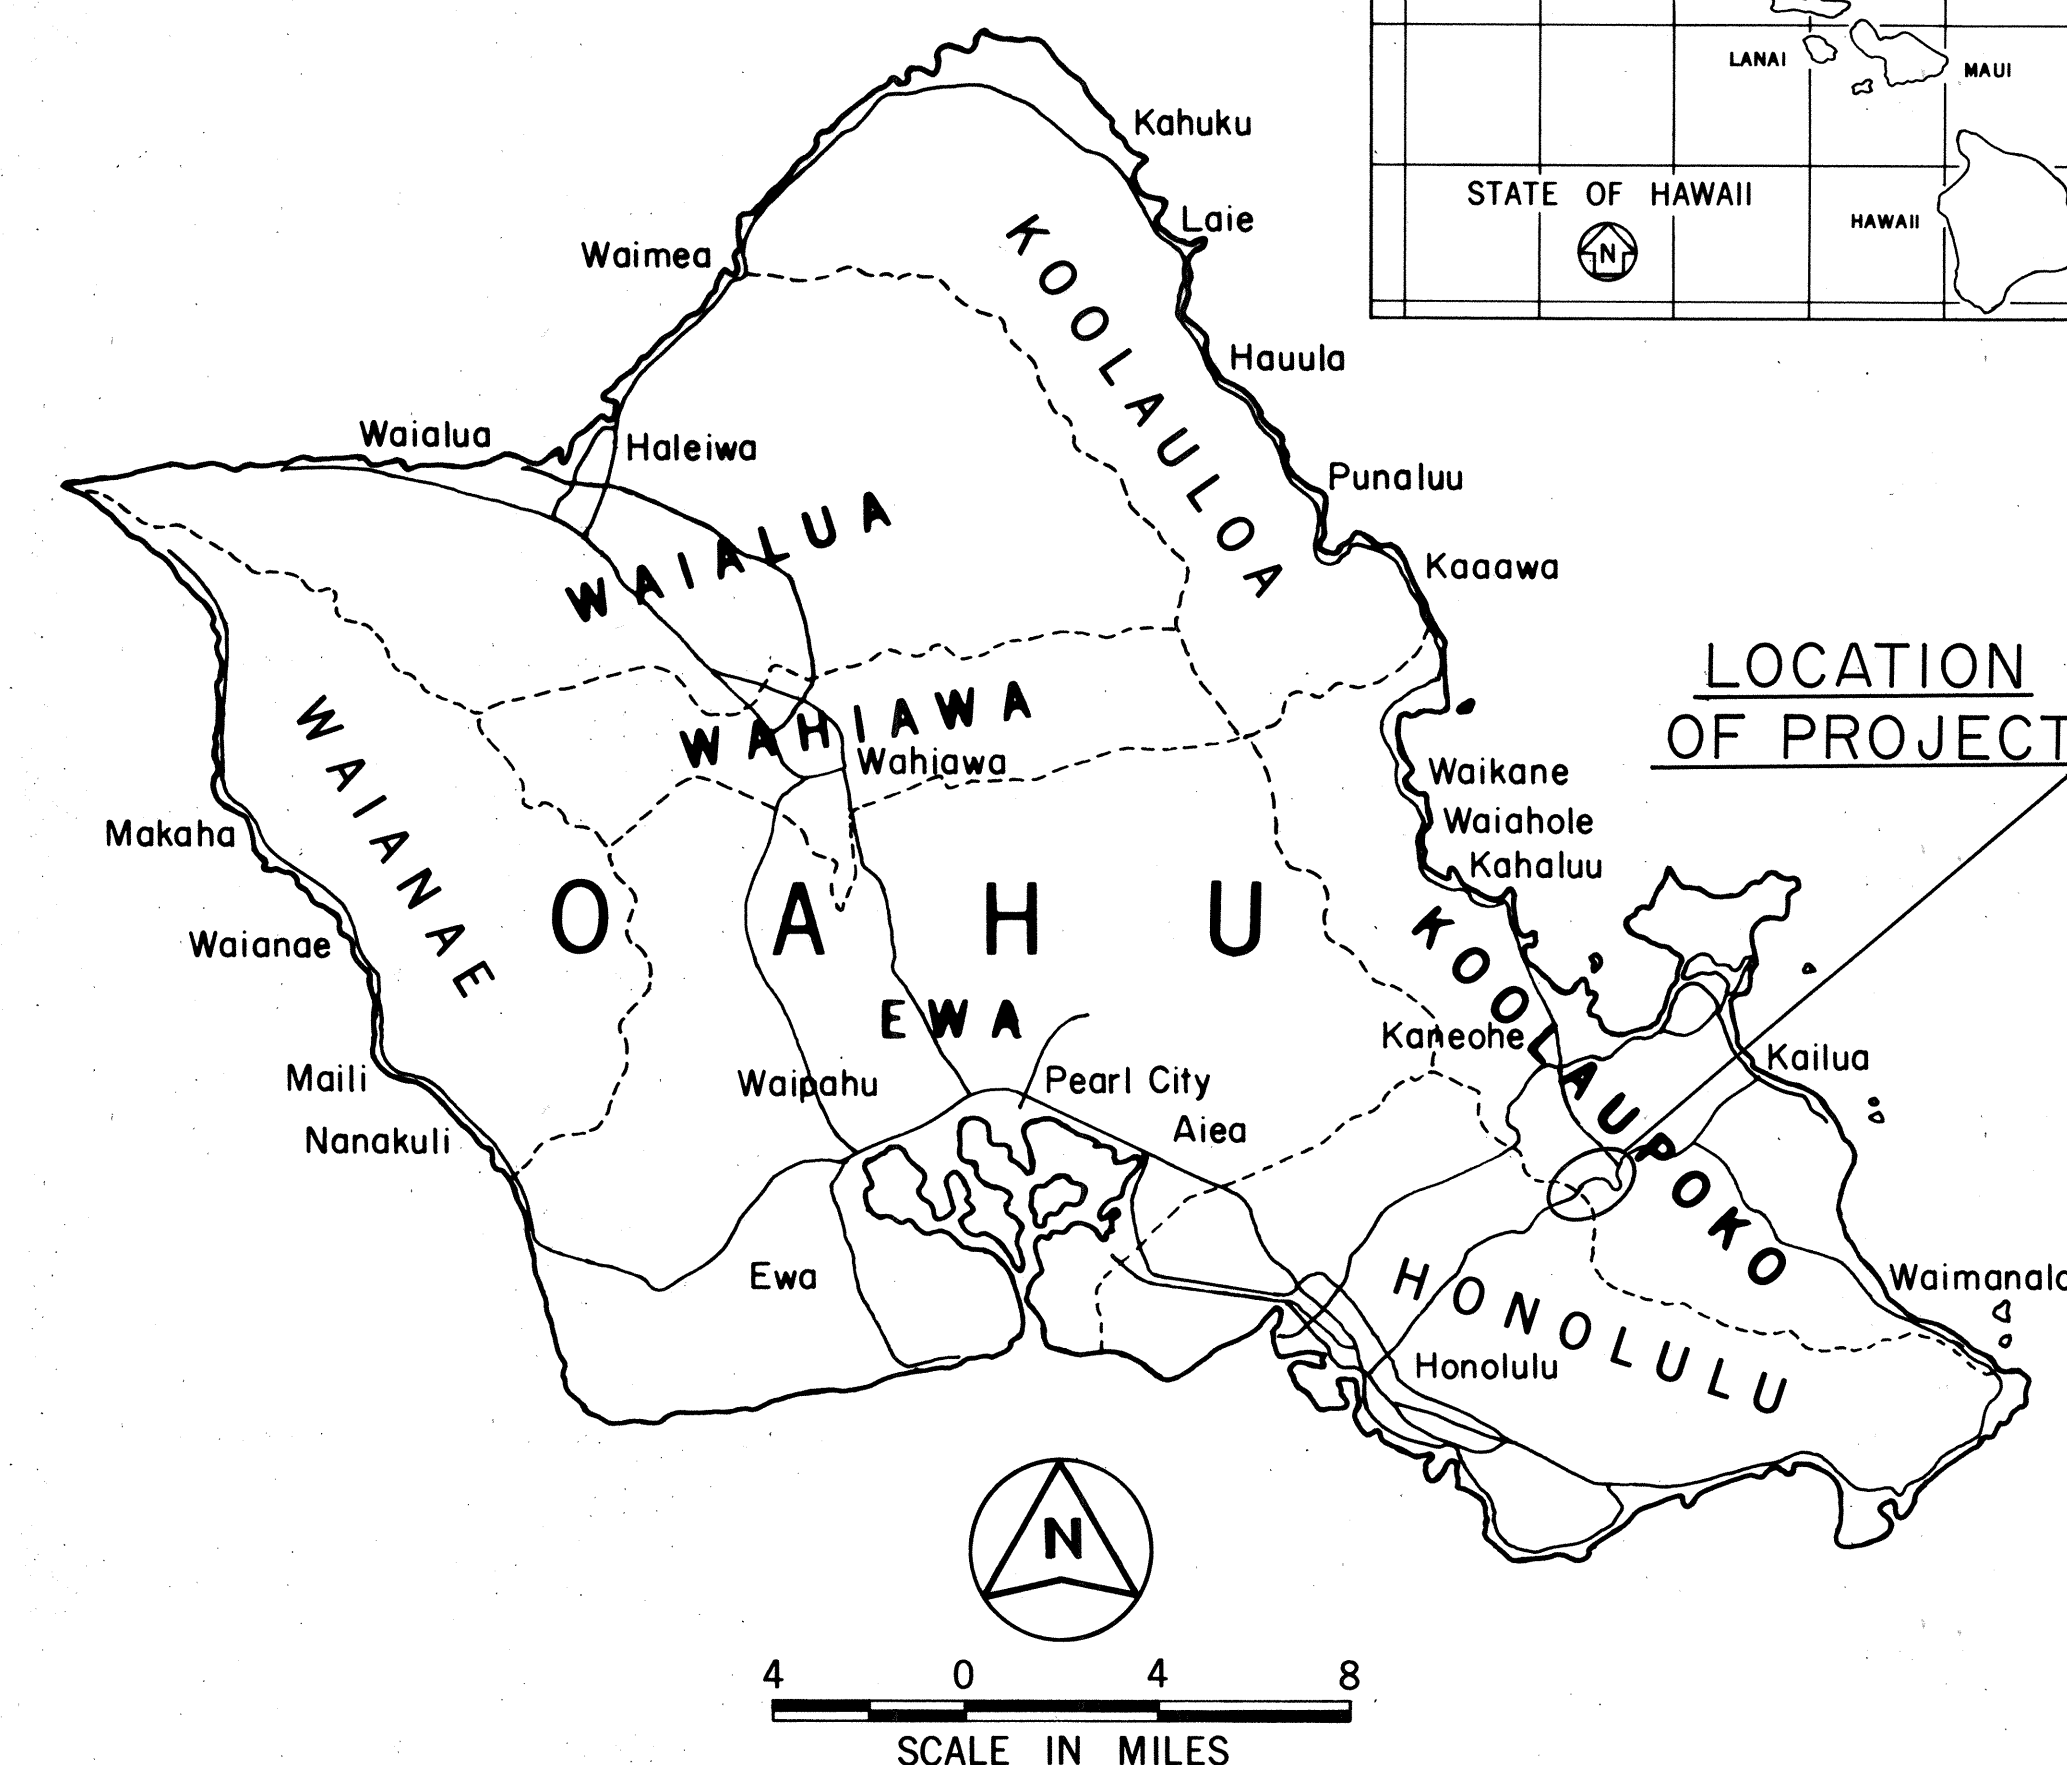

ALL CHANGES MADE DURING CONSTRUCTION
HAVE BEEN INCORPORATED ON THESE PLANS
EXCEPT CHANGES IN THE ORIGINAL THEORETICAL
QUANTITIES.

DEPARTMENT OF TRANSPORTATION STATE OF HAWAII	
APPROVED:	
<i>James R. Casas</i>	<i>5/6/68</i>
DIR. OF TRANSPORTATION	DATE