

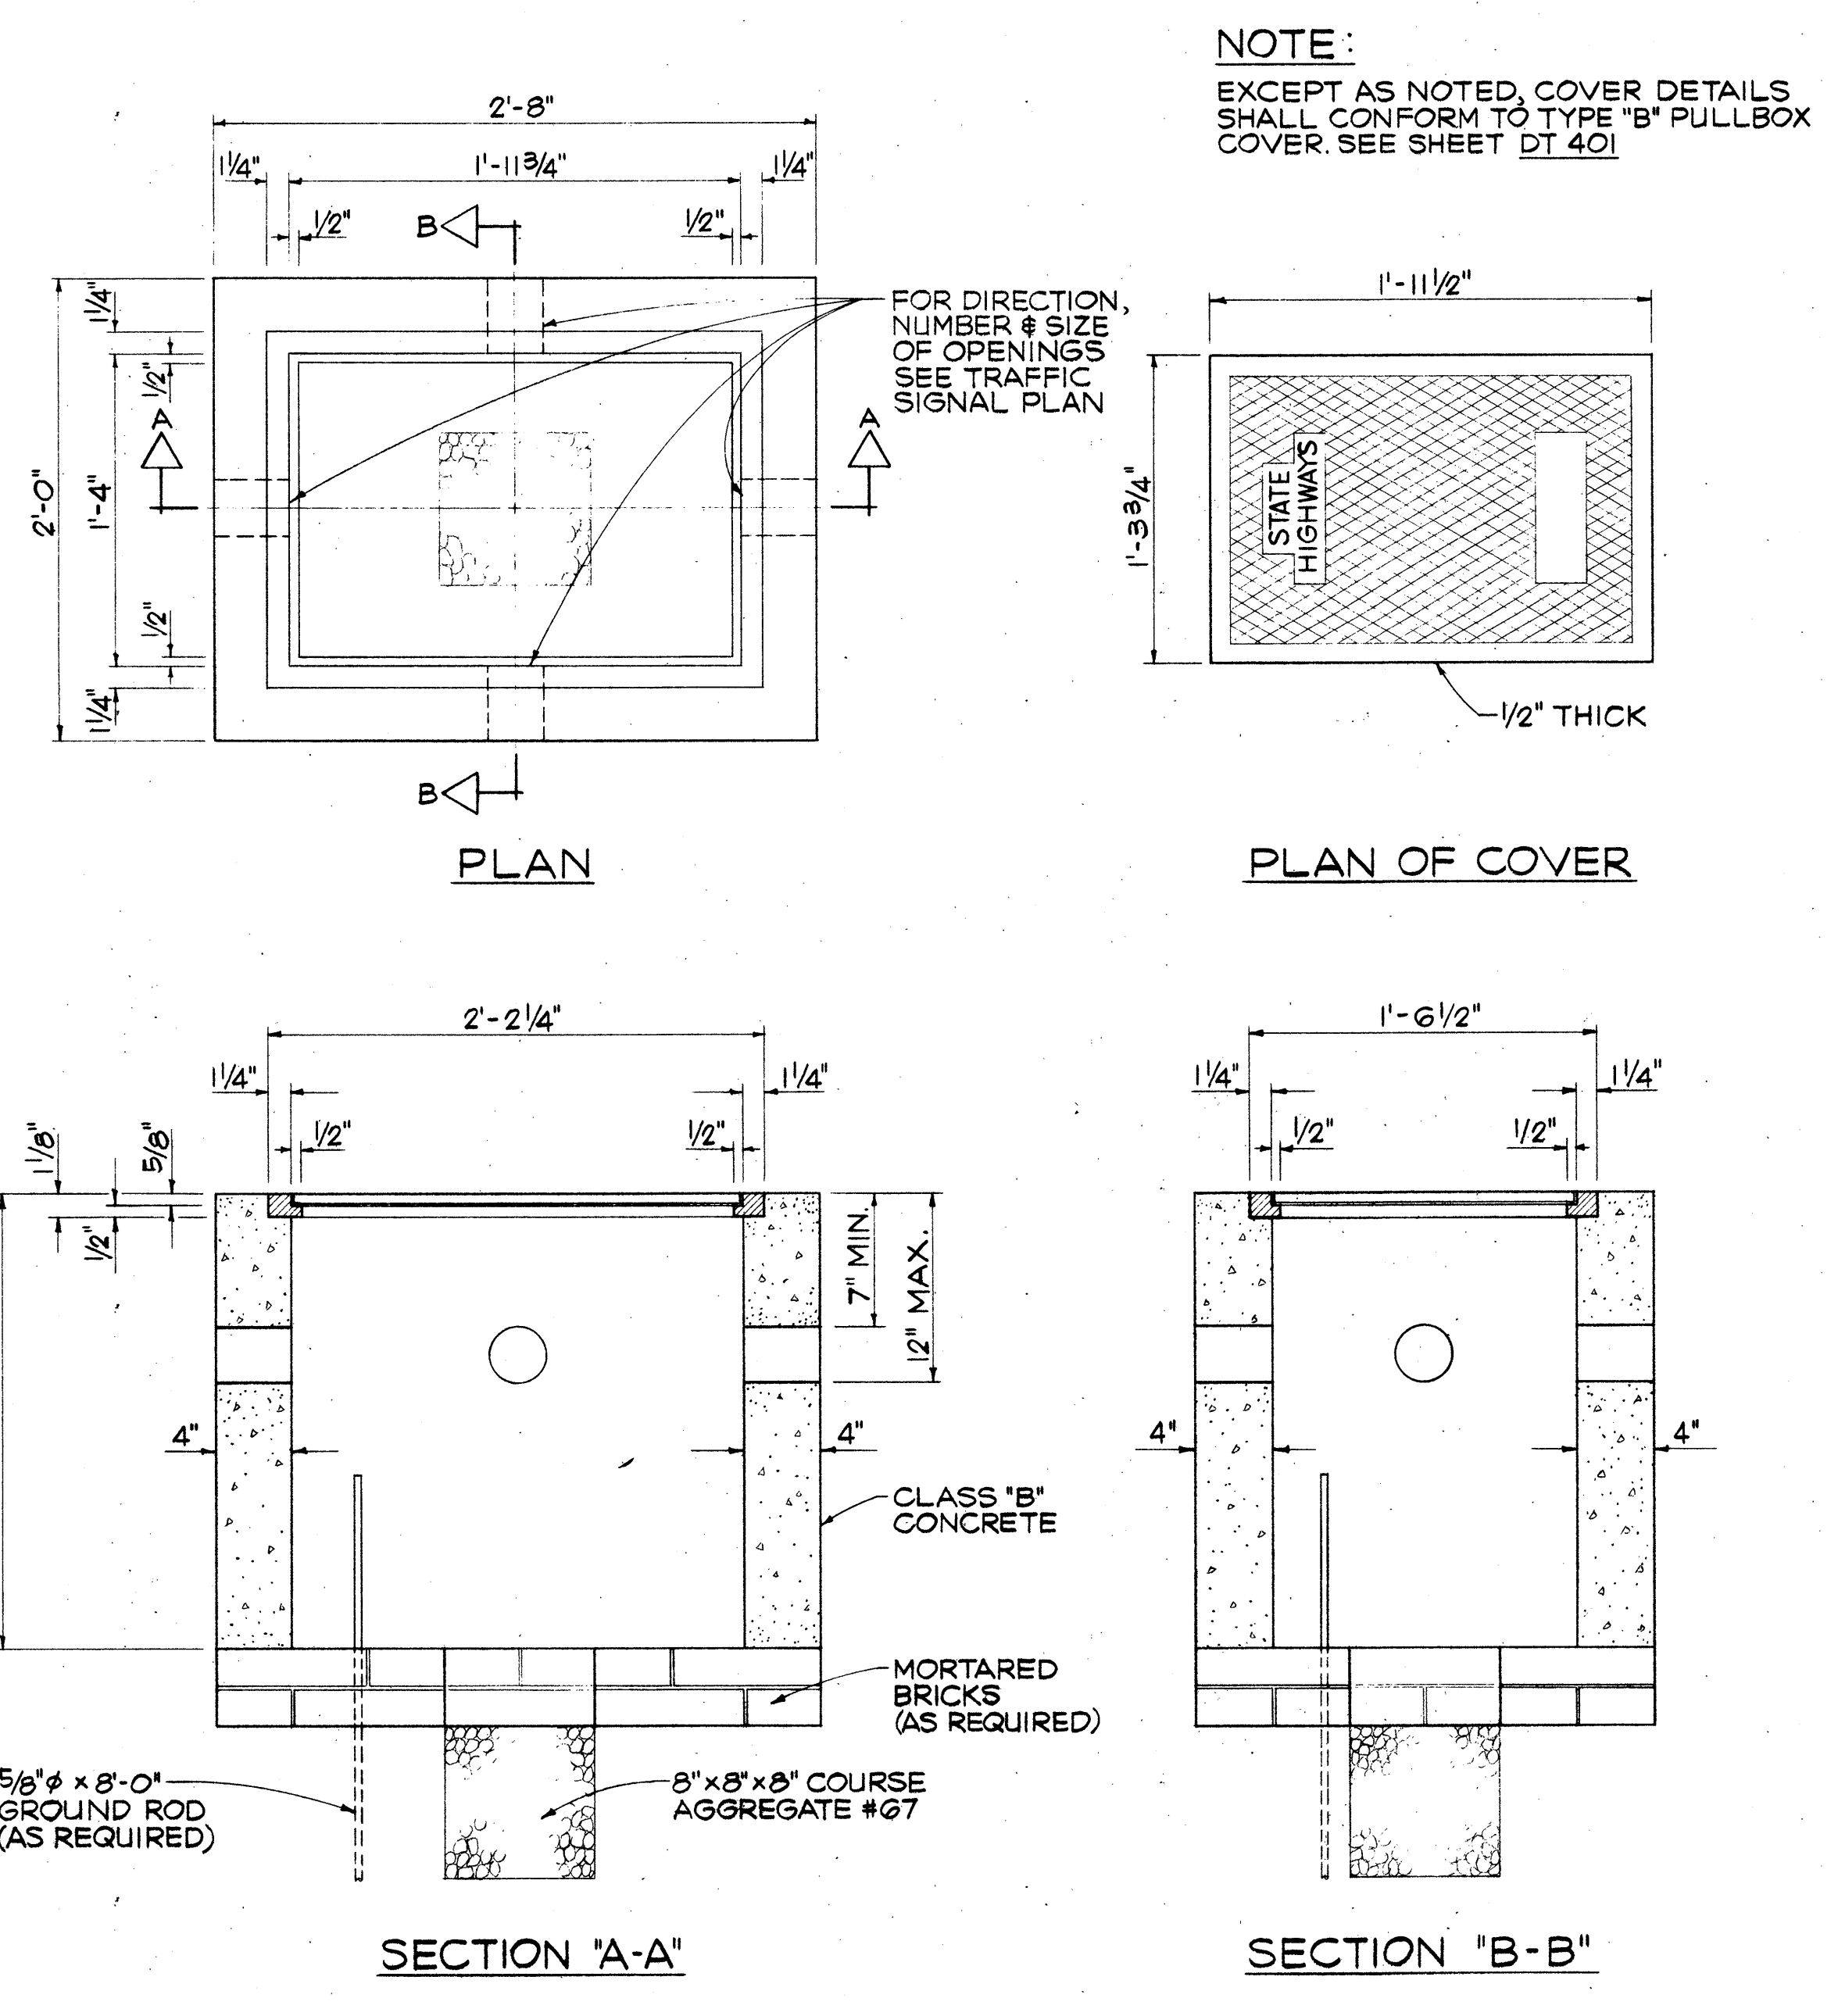



FED. ROAD DIST. NO.	STATE	PROJ. NO.	FISCAL YEAR	SHEET NO.	TOTAL SHEETS
HAWAII	HAW.	G1B-02-81	1981	5	18

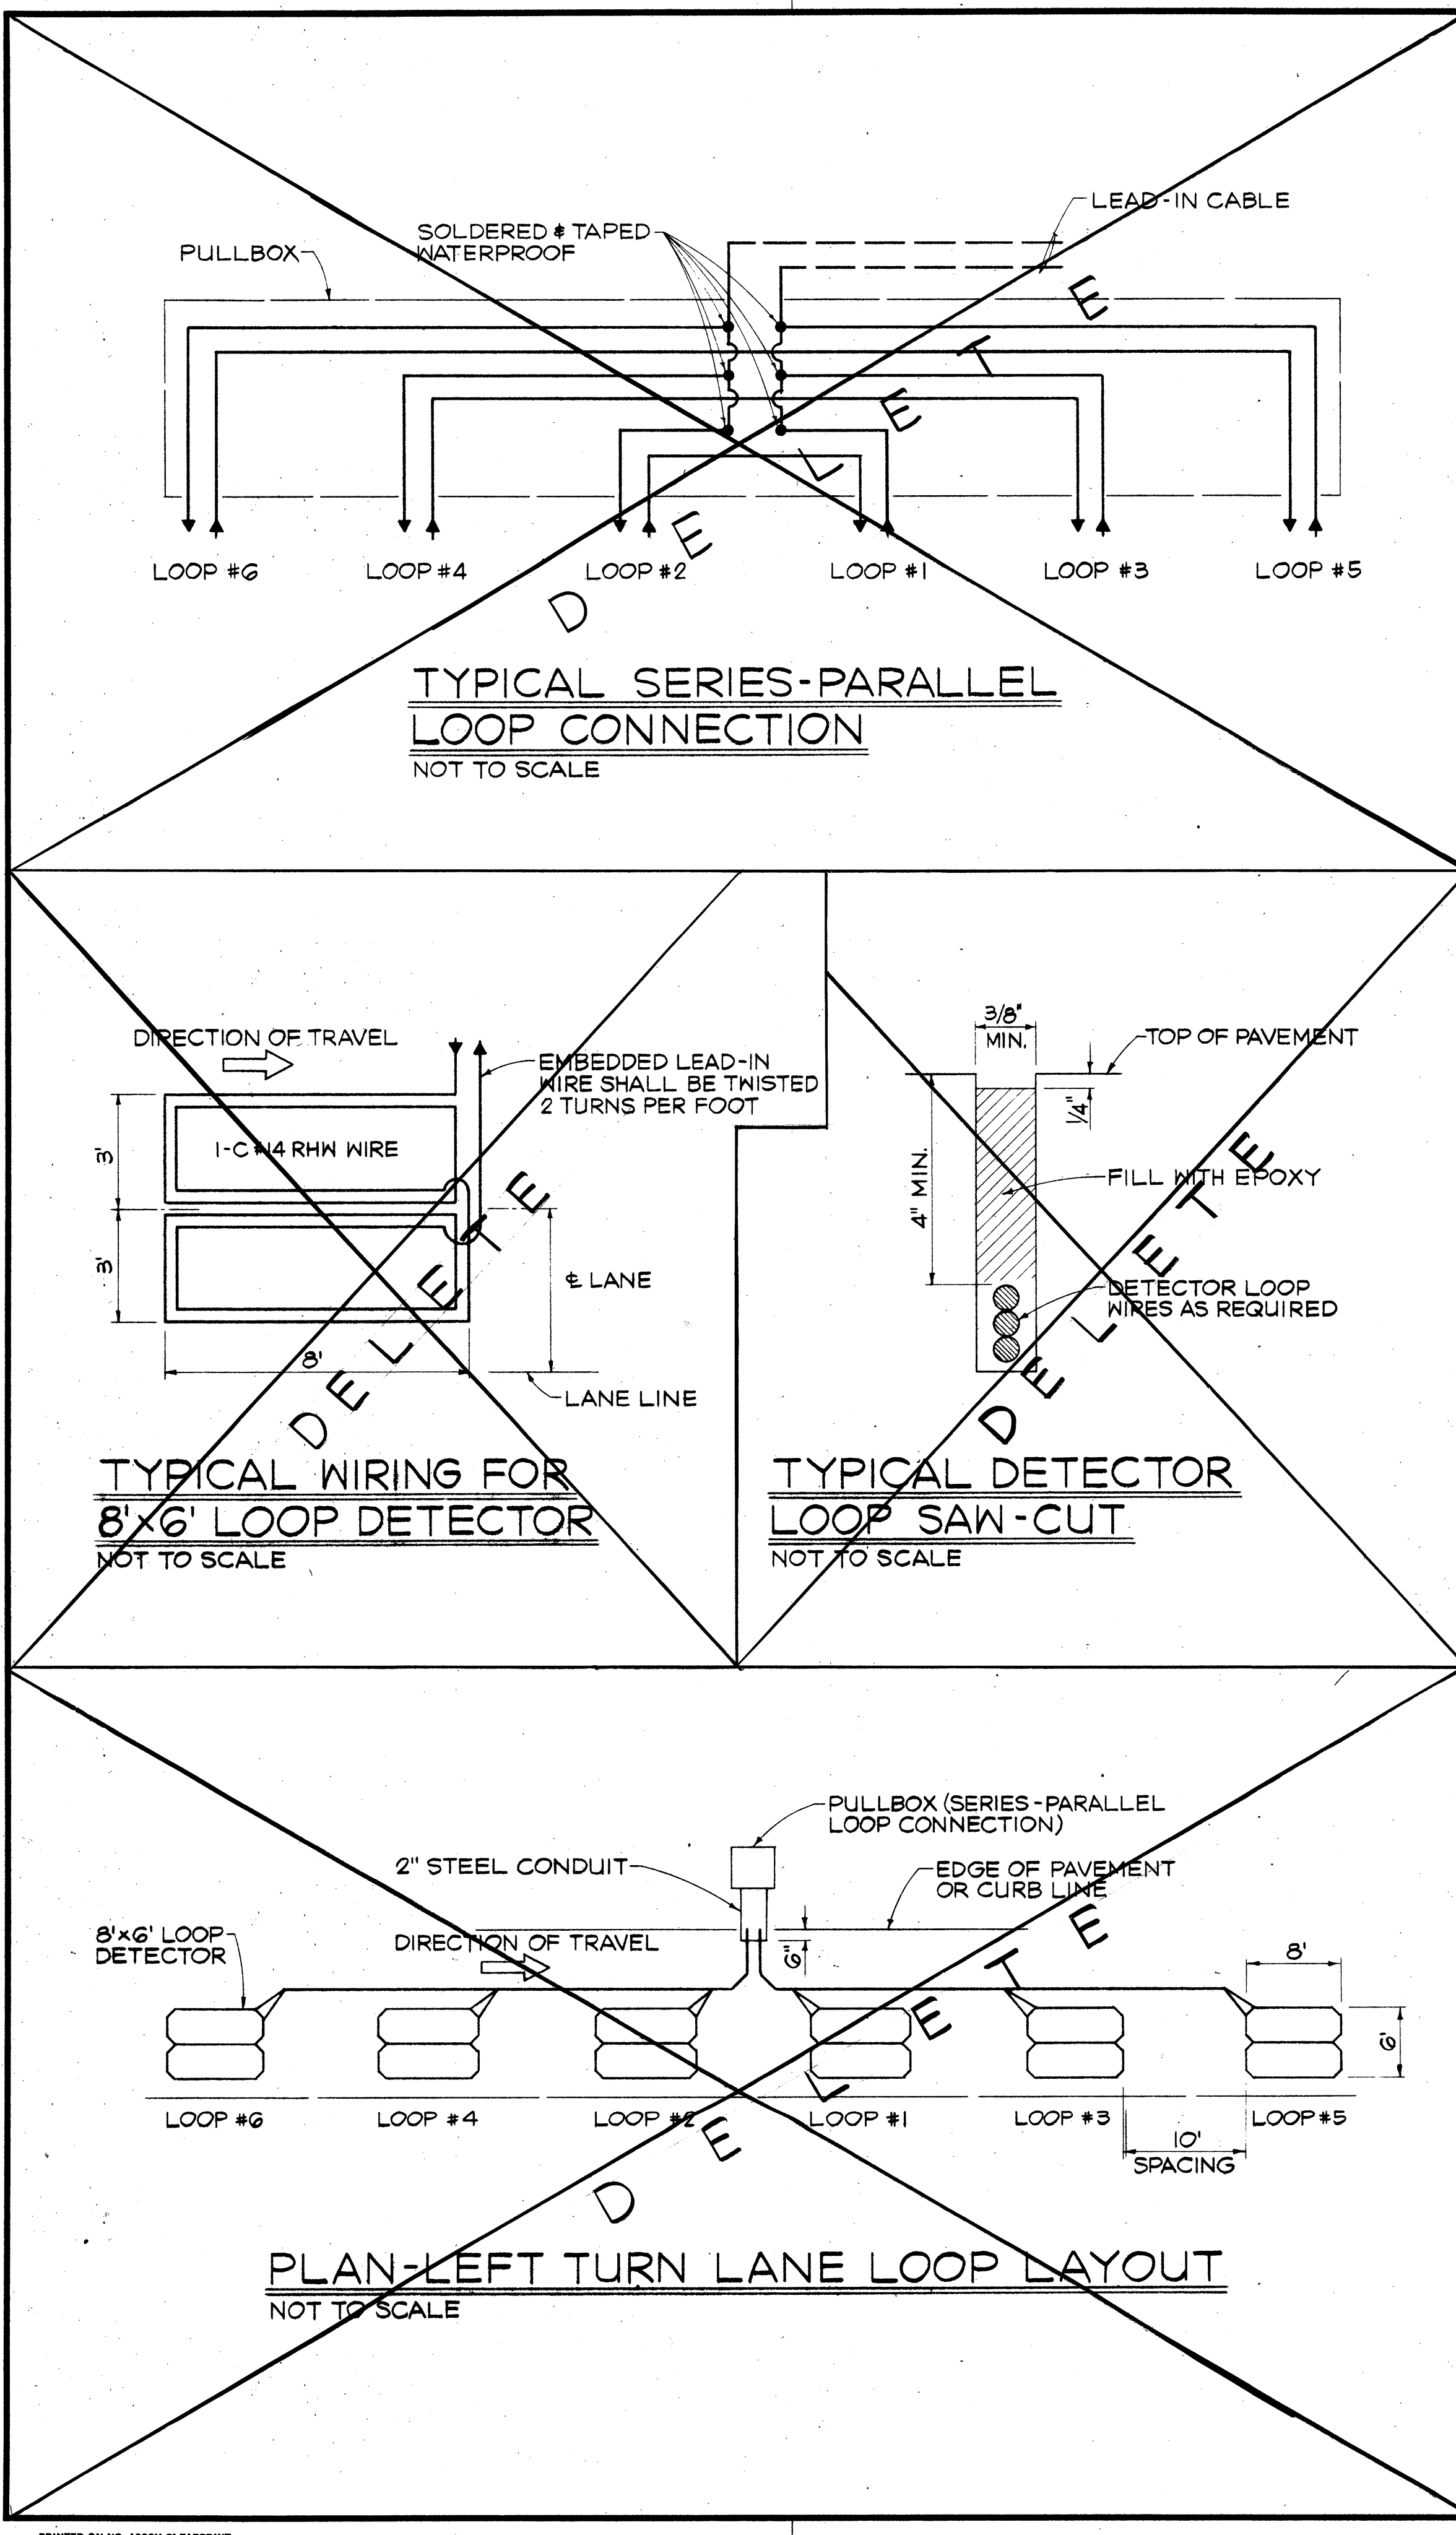

NOTE:
EXCEPT AS NOTED, COVER DETAILS SHALL CONFORM TO TYPE "B" PULLBOX COVER. SEE SHEET DT 401

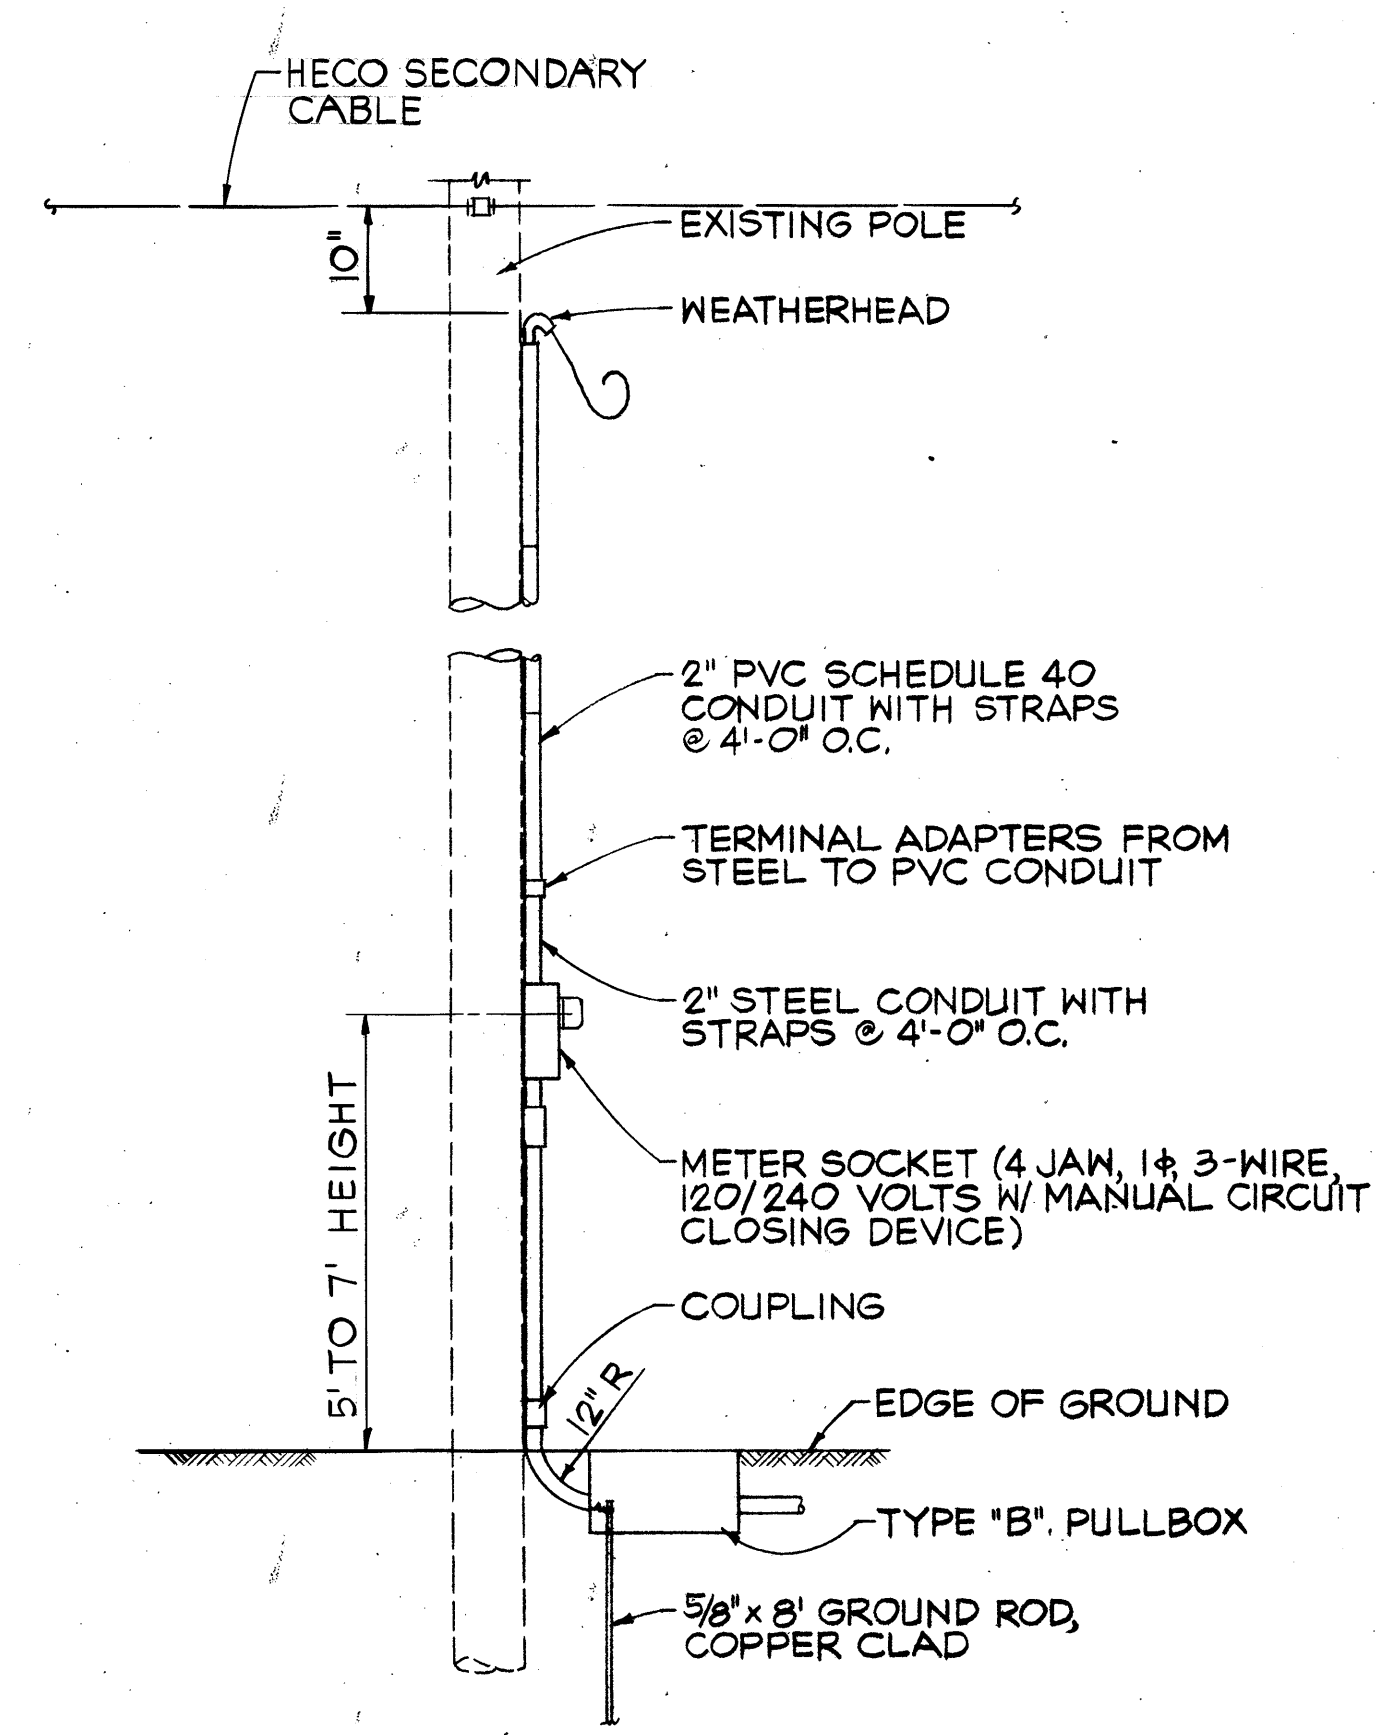


SERVICE POLE DETAIL
NOT TO SCALE

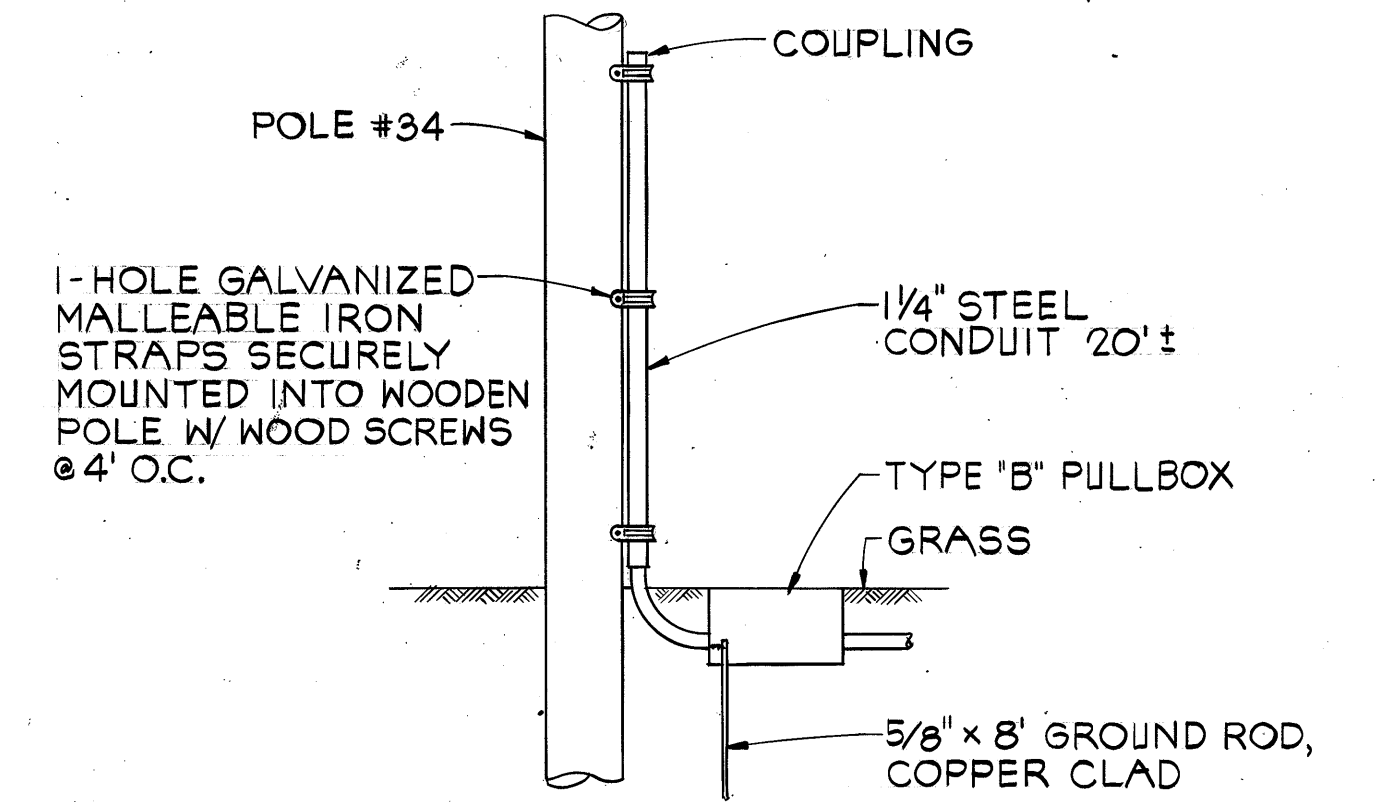


RISER DETAIL FOR FIRE PRE-EMPTION CABLE
NOT TO SCALE

TYPE "D" PULLBOX
SCALE: 1/2" = 1'-0"

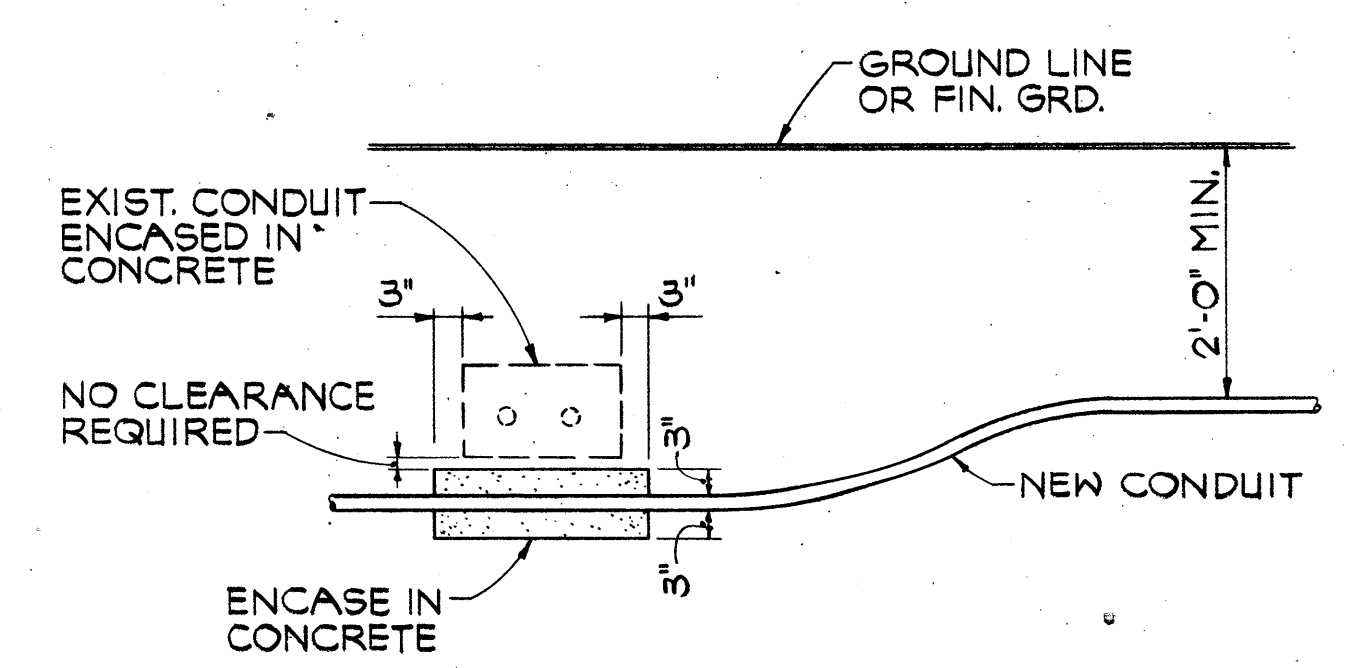

CONDUIT BY-PASS DETAIL
NOT TO SCALE

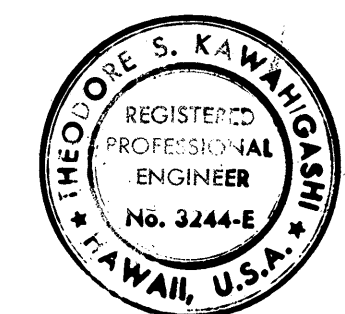

THIS WORK WAS PREPARED BY ME OR UNDER MY SUPERVISION
Theodore S. Kawahara
Signature

STATE OF HAWAII
DEPARTMENT OF TRANSPORTATION
HIGHWAYS DIVISION

PALI HIGHWAY
TRAFFIC SIGNALS AT
WYLLIE STREET
PROJ. NO. G1B-02-81

MISCELLANEOUS DETAILS
SCALE: AS SHOWN
DATE: 12-17-80
SHEET NO. 1 OF 1 SHEETS

5