

[illegible]

STATE OF HAWAII

DEPARTMENT OF TRANSPORTATION

HIGHWAYS DIVISION

"AS BUILT"

PLANS FOR

KALANIANA'OLE HIGHWAY

SAFETY IMPROVEMENTS

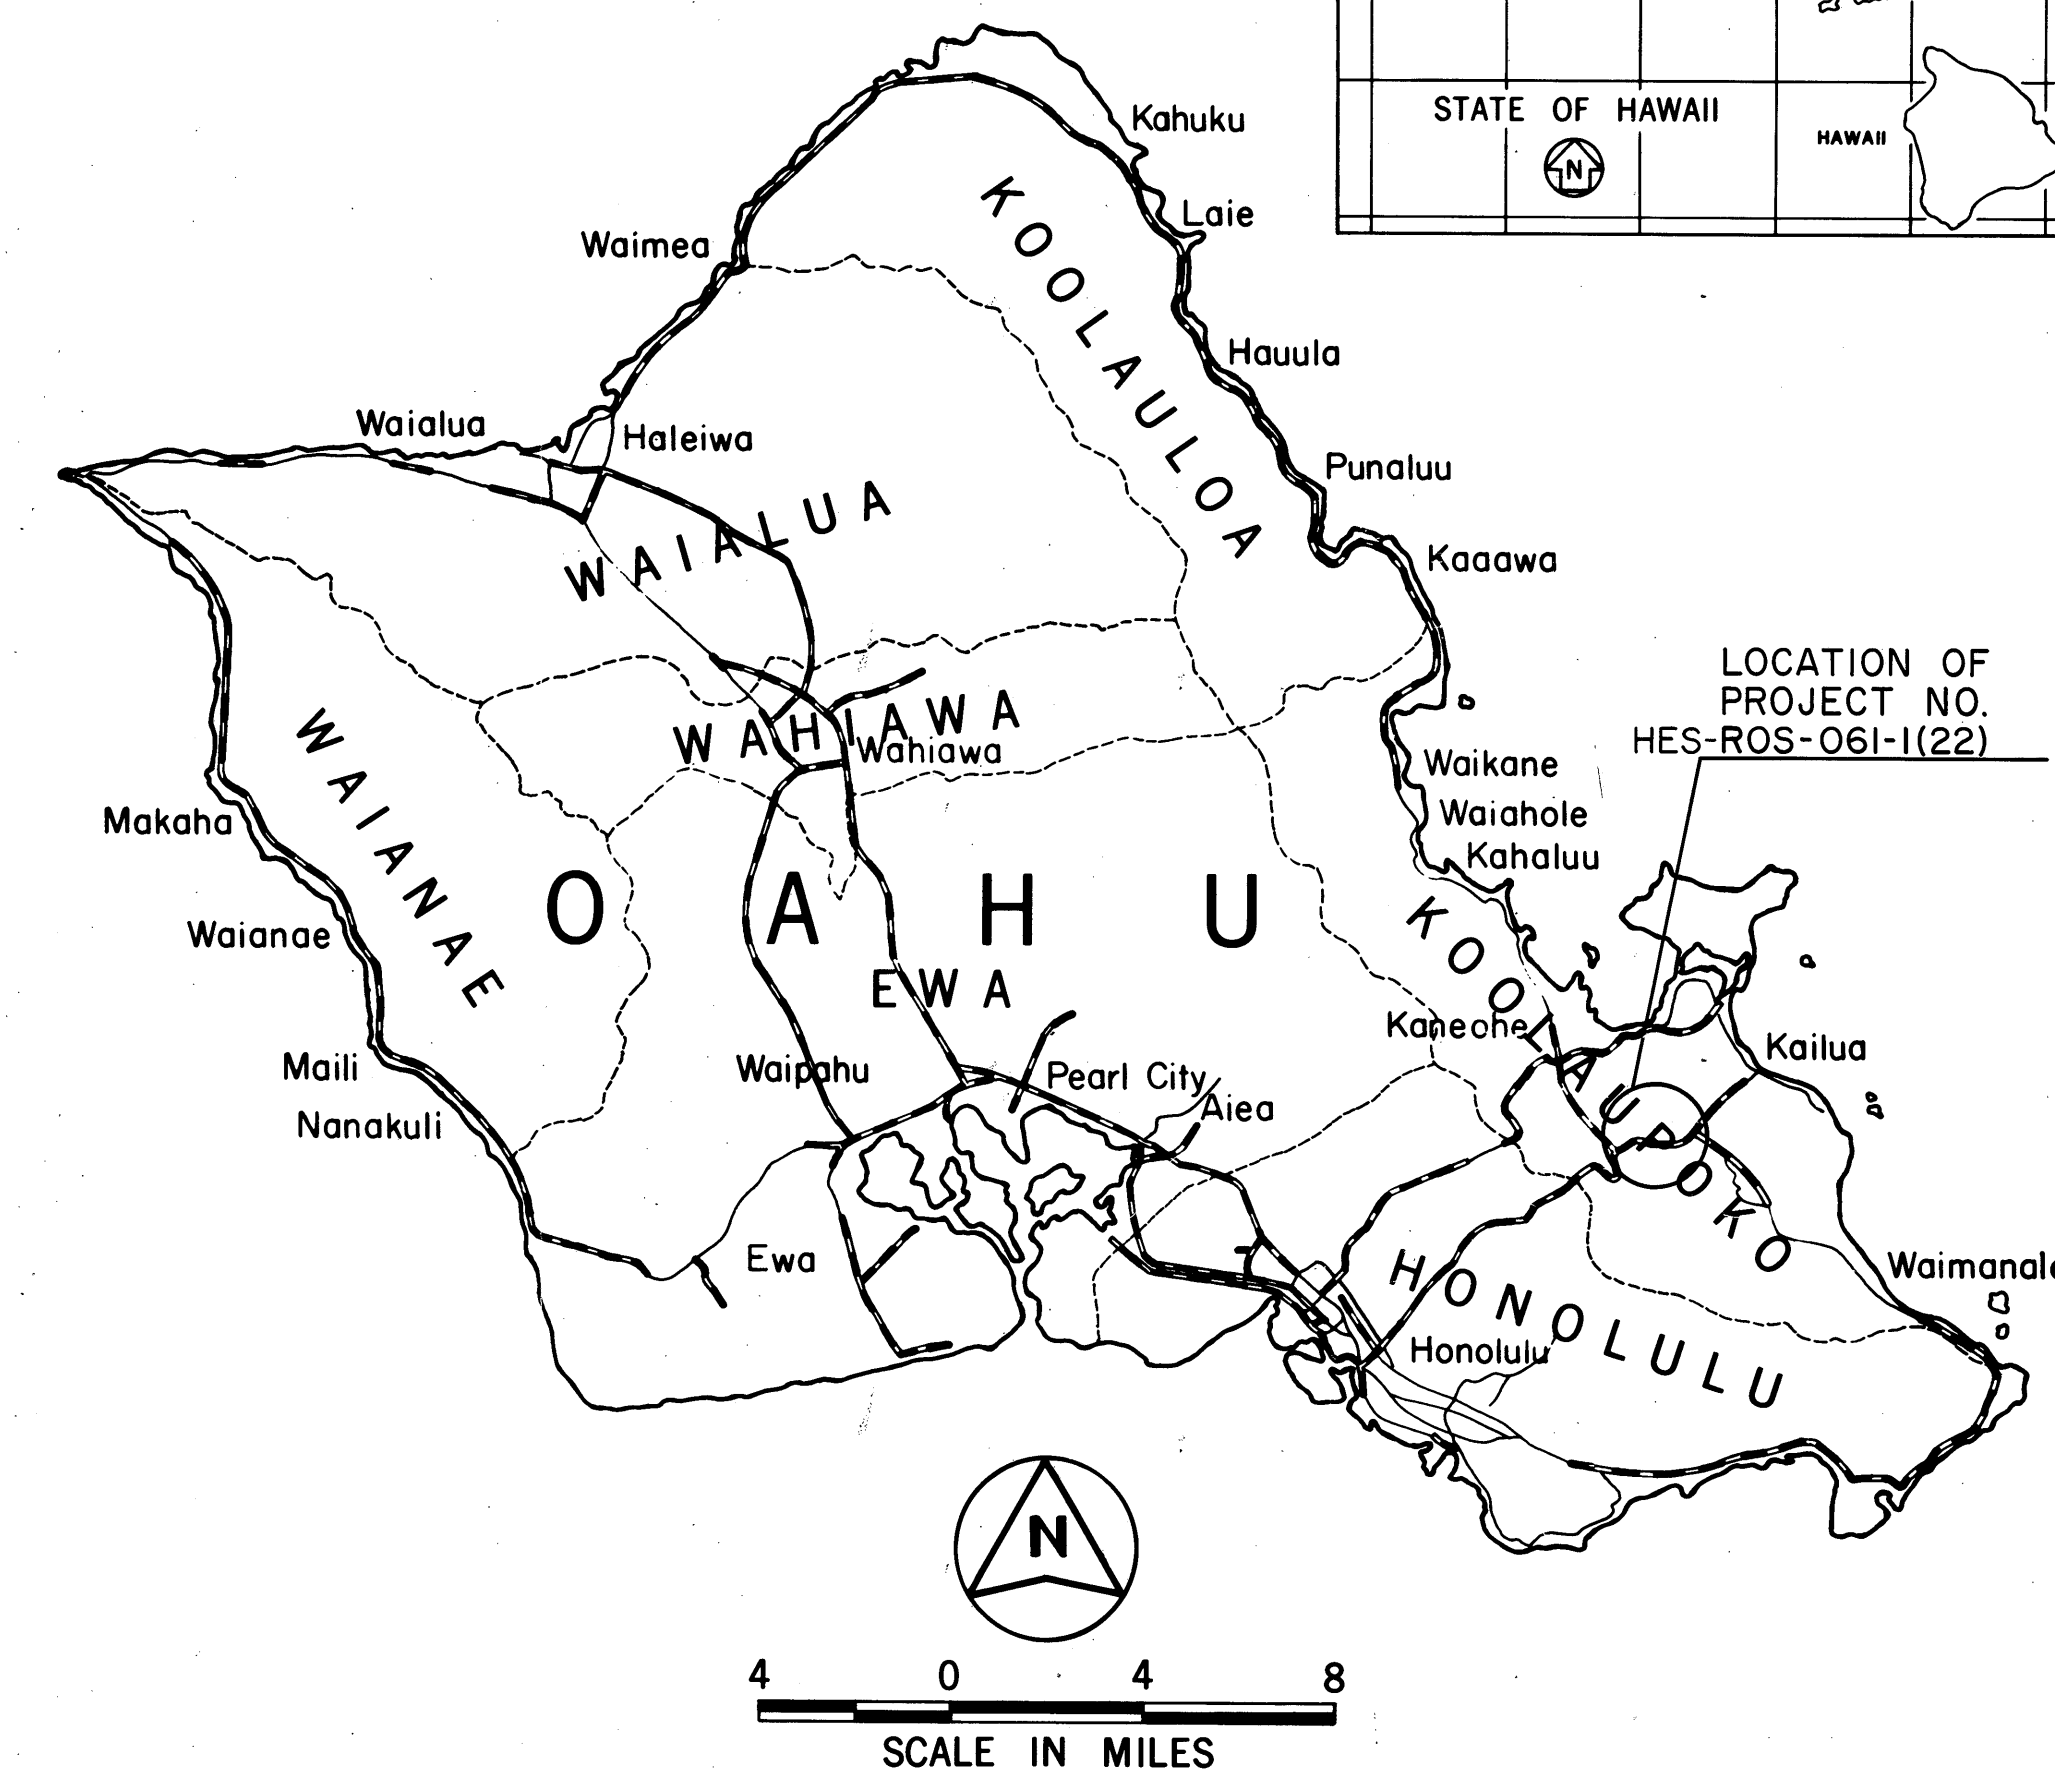
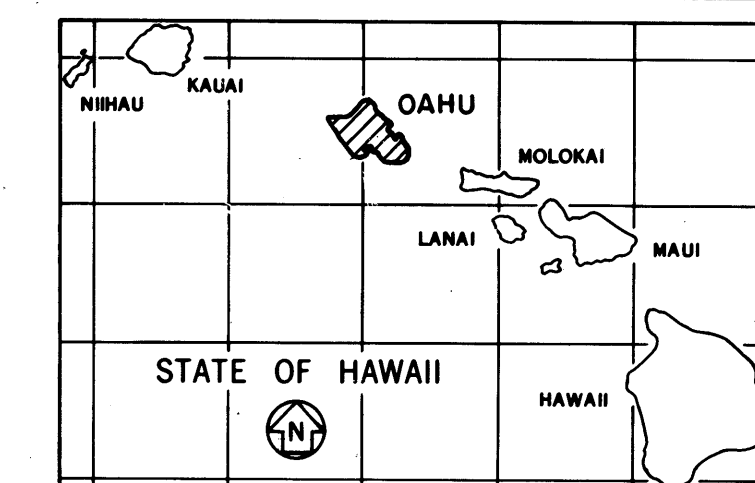
KAMEHAMEHA HIGHWAY TO KAILUA ROAD

FEDERAL AID PROJECT NO. HES-ROS-061-1(22)

DISTRICT OF KOOLAUPOKO

ISLAND OF OAHU

FED. ROAD DIST. NO.	STATE	FED. AID PROJ. NO.	FISCAL YEAR	SHEET NO.	TOTAL SHEET
HAWAII	HAW.	HES-ROS-061-1(22)	1982	1	51


FEDERAL AID PROJECTS PREVIOUSLY CONSTRUCTED
OR UNDER CONSTRUCTION

ADT (1979)	45,050
ADT (1999)	42,250
DHV	4,900
D	75/25
T	4.0%
V	45MPH

CHANGES MADE DURING CONSTRUCTION HAVE
BEEN INCORPORATED ON THESE PLANS EXCEPT
CHANGES IN THE ORIGINAL THEORETICAL
QUANTITIES.

Robert Y Murooka
RESIDENT ENGINEER

11/14/83
DATE

DEPARTMENT OF TRANSPORTATION FEDERAL HIGHWAY ADMINISTRATION	
APPROVED:	
	11-23-88
DIVISION ADMINISTRATOR	DATE

DEPARTMENT OF TRANSPORTATION STATE OF HAWAII	
APPROVED:	
<i>James R. Carras</i>	<i>4/18/88</i>
DIR. OF TRANSPORTATION	DATE