



FED. ROAD DIST. NO.	STATE	PROJ. NO.	FISCAL YEAR	SHEET NO.	TOTAL SHEETS
HAWAII	HAW.	61B-02-83	1983	4	19

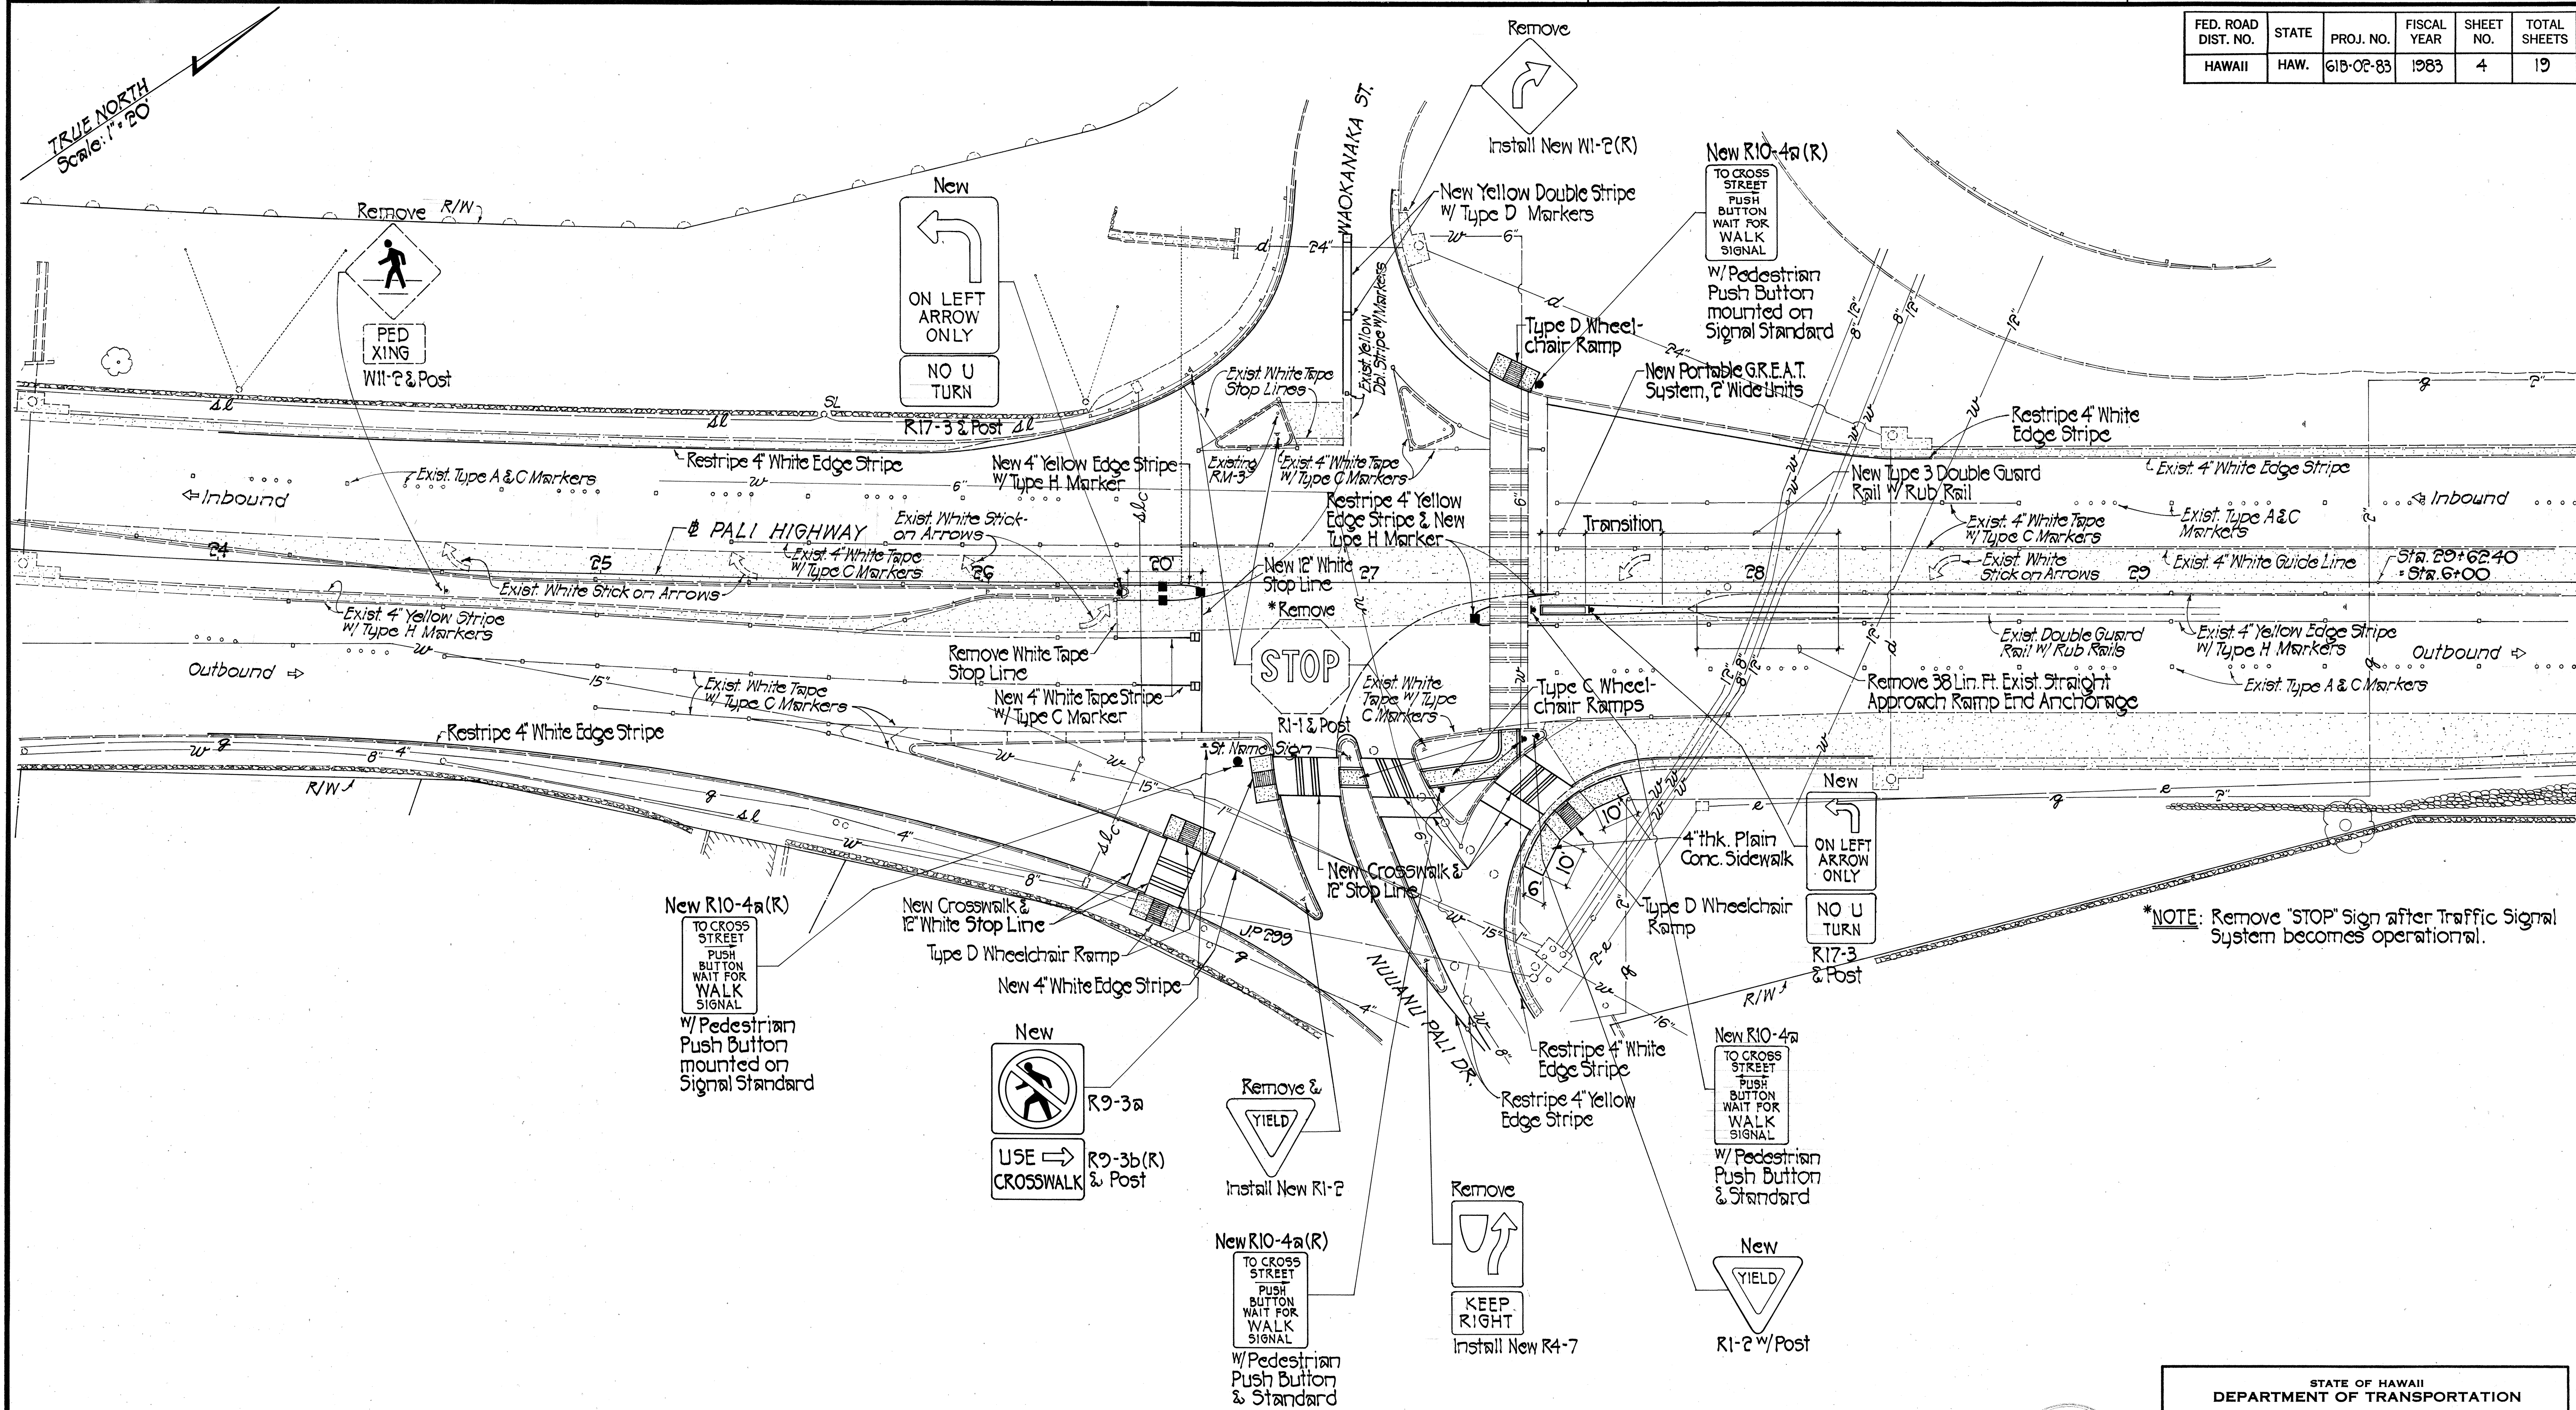

PLAN
Scale: 1"=20'

*NOTE: Remove "STOP" sign after Traffic Signal System becomes operational.

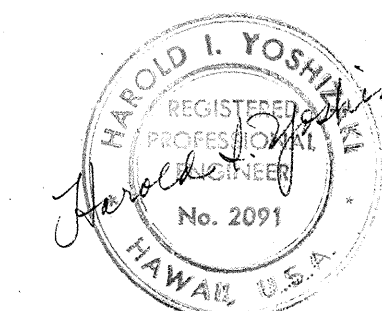

STATE OF HAWAII
DEPARTMENT OF TRANSPORTATION
HIGHWAYS DIVISION

SIGNS, PAVEMENT MARKINGS & MISCELLANEOUS IMPROVEMENTS

PALI HIGHWAY
TRAFFIC SIGNALS AT WAOKANAKA STREET

PROJECT NO. 61B-02-83
SCALE: AS SHOWN DATE: APRIL 20, 1983

SHEET NO. 1 OF 1 SHEETS

ORIGINAL PLAN	DATE
SURVEY PLOTTED BY	
DRAWN BY	
TRACED BY	
NOTE BOOK	
DESIGNED BY	
QUANTITIES BY	
CHECKED BY	