


[illegible]




STATE OF HAWAII

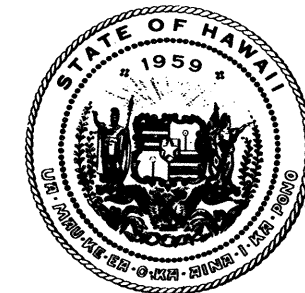

DEPARTMENT OF TRANSPORTATION

HIGHWAYS DIVISION

DISTRICT OF HONOLULU
ISLAND OF OAHU

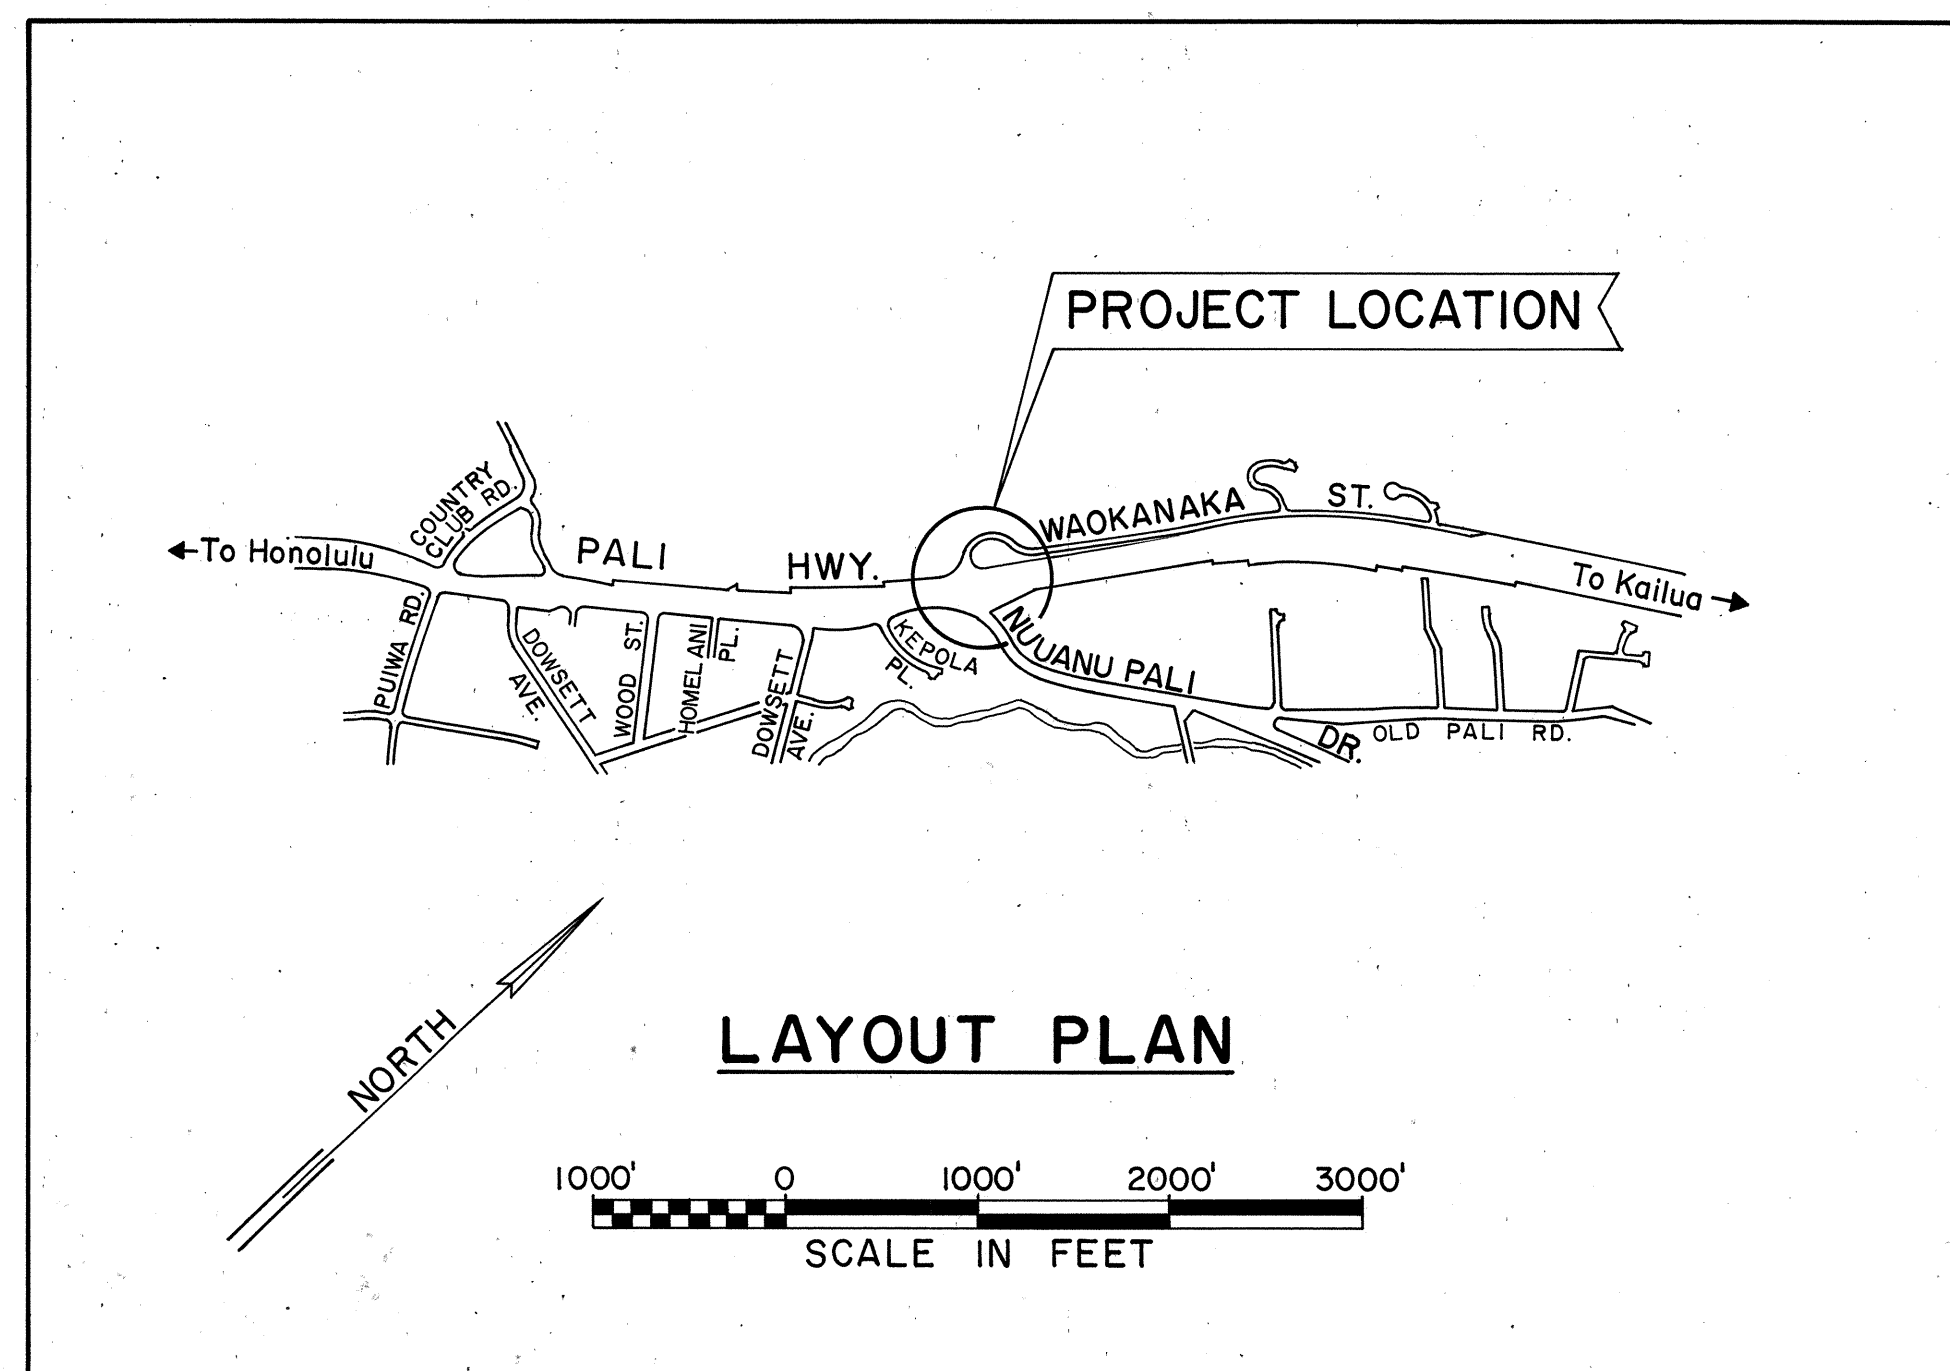

Darin D. Surban 6/14/84
Acting RESIDENT ENGINEER DATE

STANLEY S. SHIMABUKURO & ASSOC., INC.
1126 12TH AVENUE - HONOLULU, HI.

DESIGNED BY	HERBERT TAO	548-6932	APRIL 20, 1983
	P. S. & E. BY	PHONE	DATE