


FED. ROAD DIST. NO.	STATE	FED. AID PROJ. NO.	FISCAL YEAR	SHEET NO.	TOTAL SHEETS
HAWAII	HAW.	HES-061-1(26)	1984	5	10

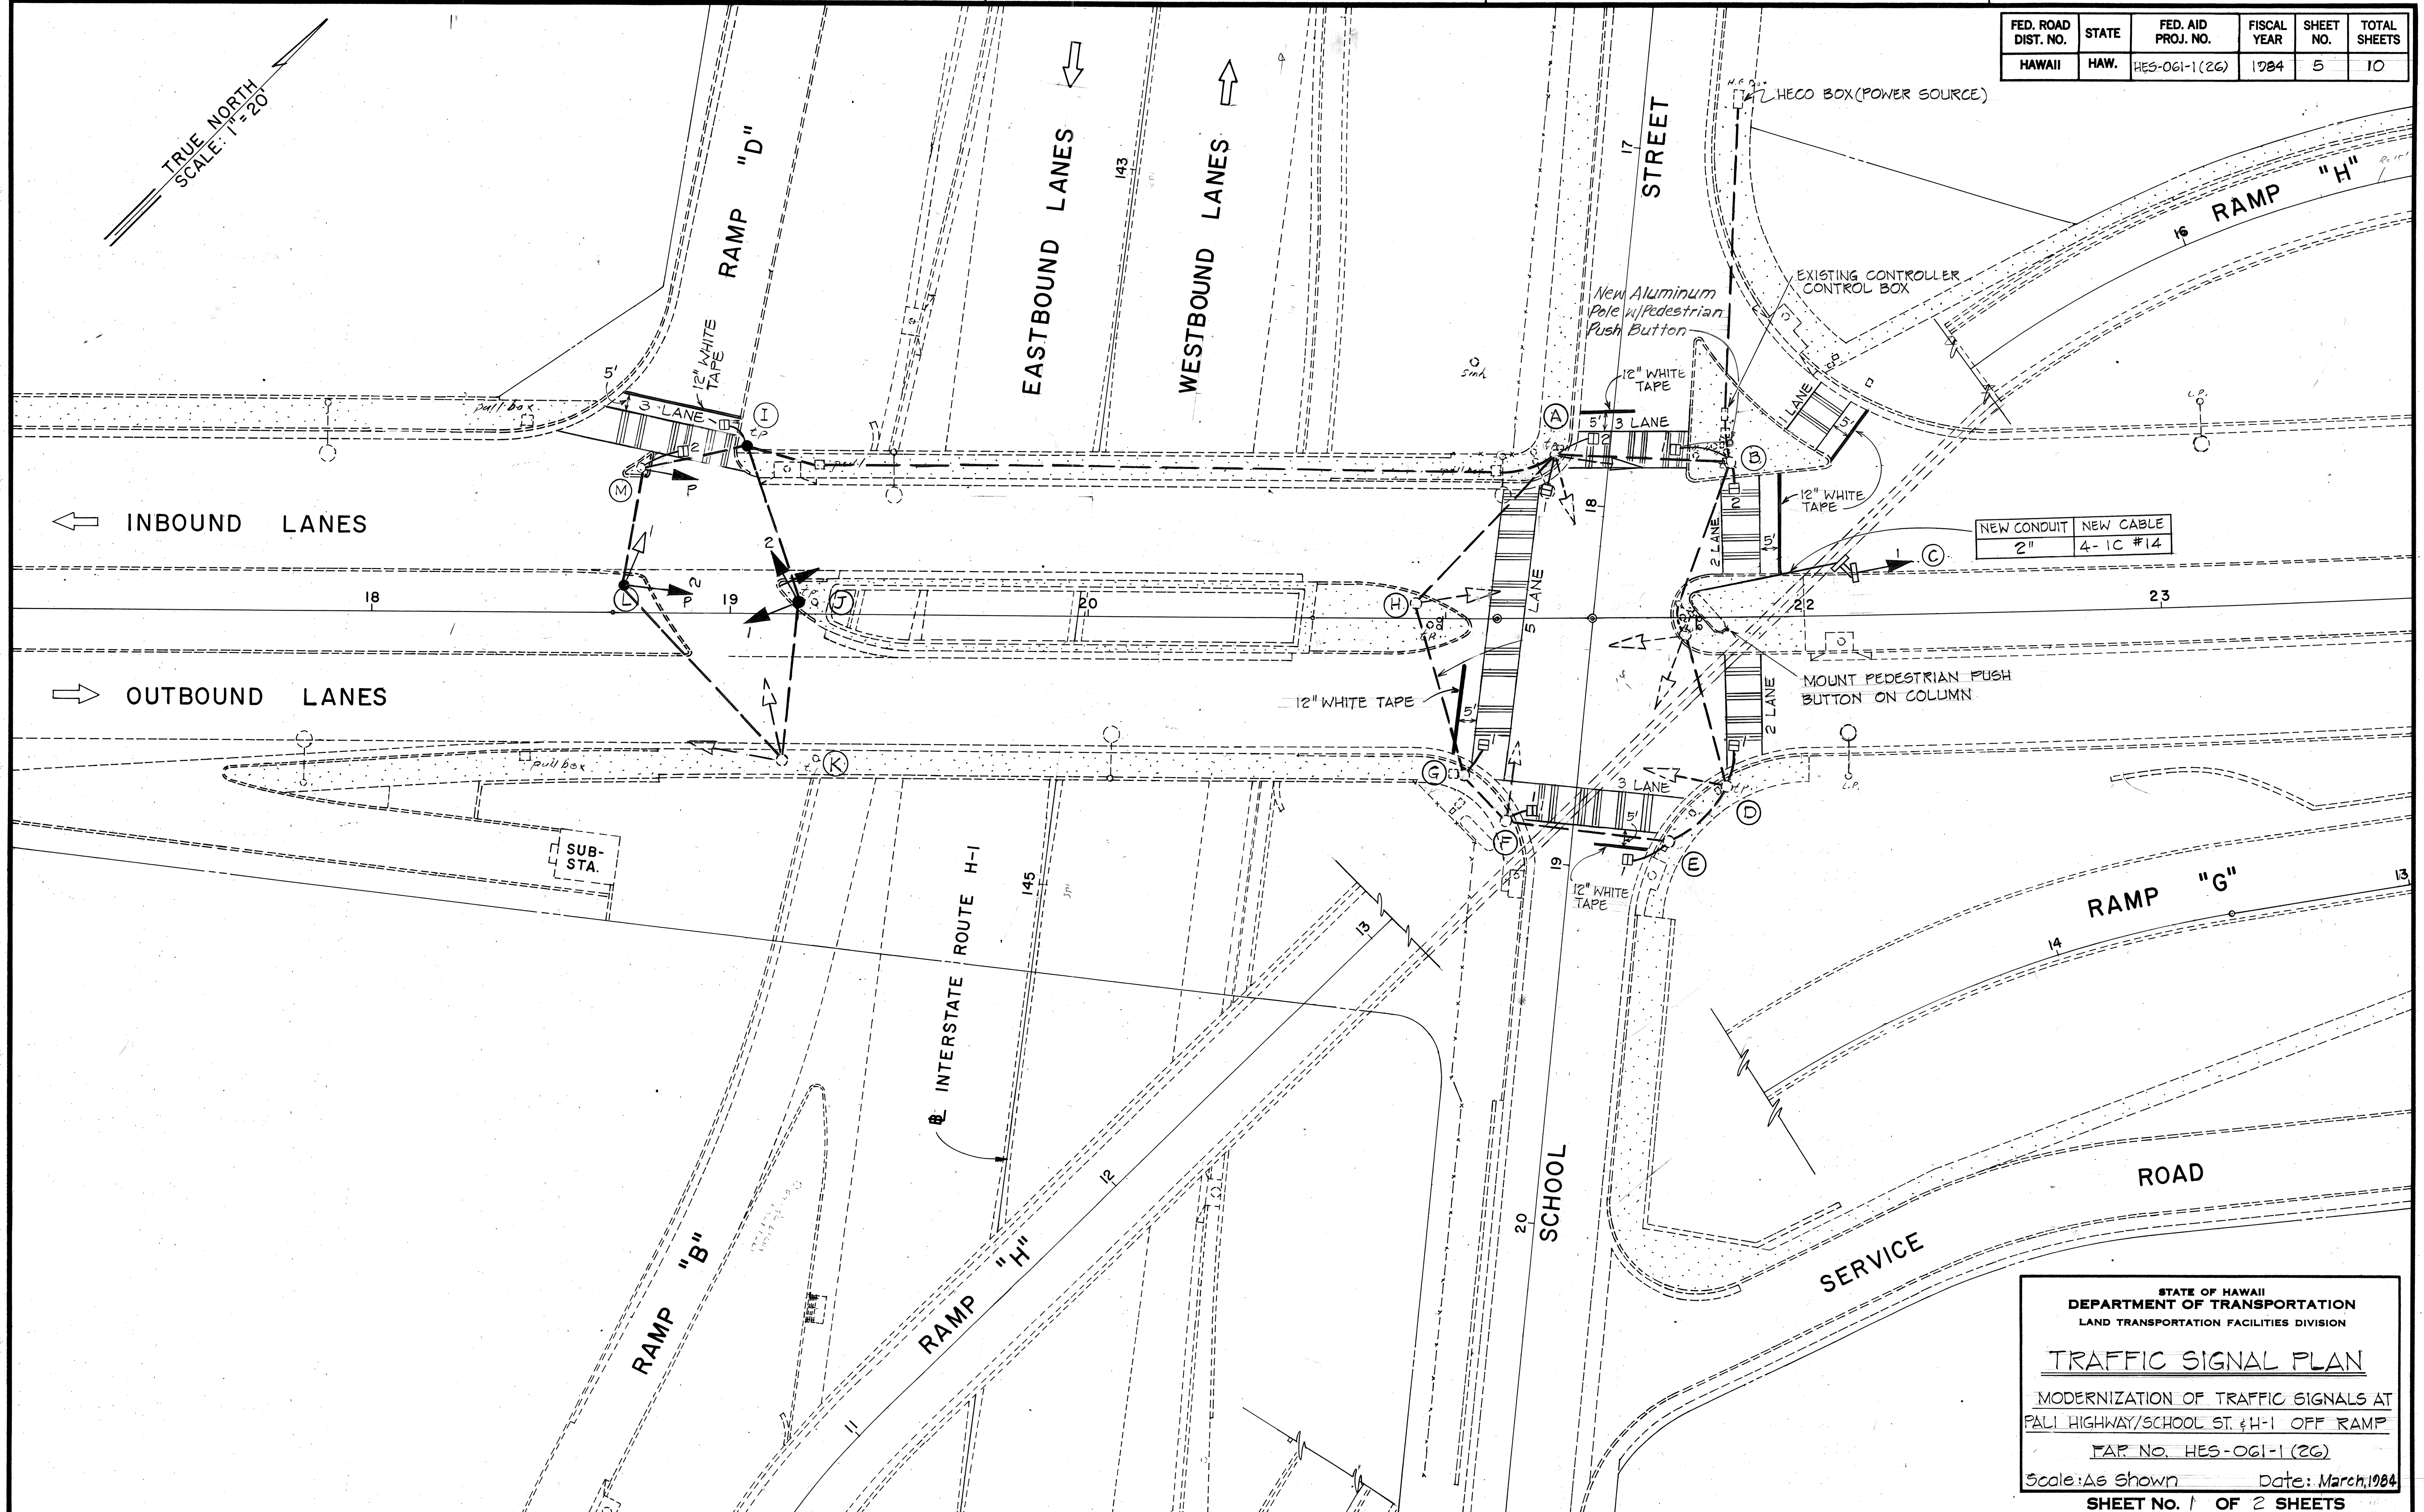

ORIGINAL PLAN	SURVEY PLOTTED BY	DATE
NOTE BOOK	DRAWN BY	
QUANTITIES BY	DESIGNED BY	
CHECKED BY	CHECKED BY	

STATE OF HAWAII
DEPARTMENT OF TRANSPORTATION
LAND TRANSPORTATION FACILITIES DIVISION

TRAFFIC SIGNAL PLAN
MODERNIZATION OF TRAFFIC SIGNALS AT
PALL HIGHWAY/SCHOOL ST. & H-1 OFF RAMP
FAP No. HES-061-1(26)
Scale: As Shown Date: March, 1984
SHEET NO. 1 OF 2 SHEETS