	INDEX TO DRAWINGS
SHEET NO.	DESCRIPTION
	TITLE SHEET
2	UTILITY GENERAL NOTES
3	PLAN, TYPICAL SECTION AND GENERAL NOTES
4-6	ROADWAY STANDARD DETAILS
7-16	SIGNING AND PAVEMENT MARKINGS PLAN AND DETAILS
·	

STATE OF HAWAII

DEPARTMENT OF TRANSPORTATION


HIGHWAYS DIVISION

"AS-BUILT"

PLANS FOR

PALI HIGHWAY LEFT TURN STORAGE LANE AT NIOLOPA PLACE PROJECT NO. 6IA-0I-85

> DISTRICT OF HONOLULU ISLAND OF OAHU

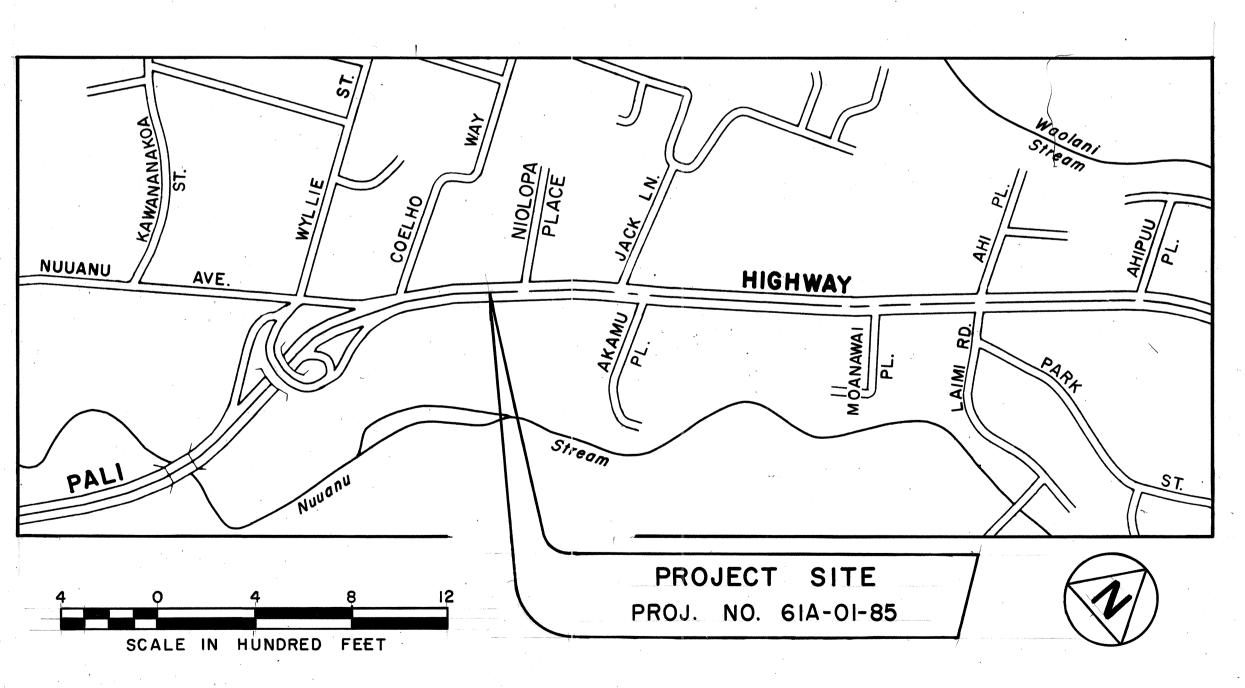

CHANGES MADE DURING CONSTRUCTION HAVE BEEN INCORPORATED ON THESE PLANS EXCEPT CHANGES IN THE ORIGINAL THEORETICAL QUANTITIES. FOR ACTUAL QUANTITIES, REFER TO PROJECT LEDGER AND/OR COMPUTATION BOOK.

Resident Engineer

2-20-86 Date

SCALE IN MILES

FEDERAL AID PROJECTS PREVIOUSLY CONSTRUCTED

OR UNDER CONSTRUCTION

LAYOUT PLAN

DEPARTMENT OF TRANSPORTATION STATE OF HAWAII APPROVED: Chengl & form 6/5/85 DIR. OF TRANSPORTATION

OF PROJECT

FISCAL SHEET NO.

PROJ. NO.

61A-01-85

STATE OF HAWAII

548-2456 PHONE R.T. Nagasako P. S. & E. BY

R. T. Nagasako DESIGNED BY