



FED. ROAD DIST. NO.	STATE	PROJ. NO.	FISCAL YEAR	SHEET NO.	TOTAL SHEETS
HAWAII	HAW.	GIC-01-87	1987	5	7

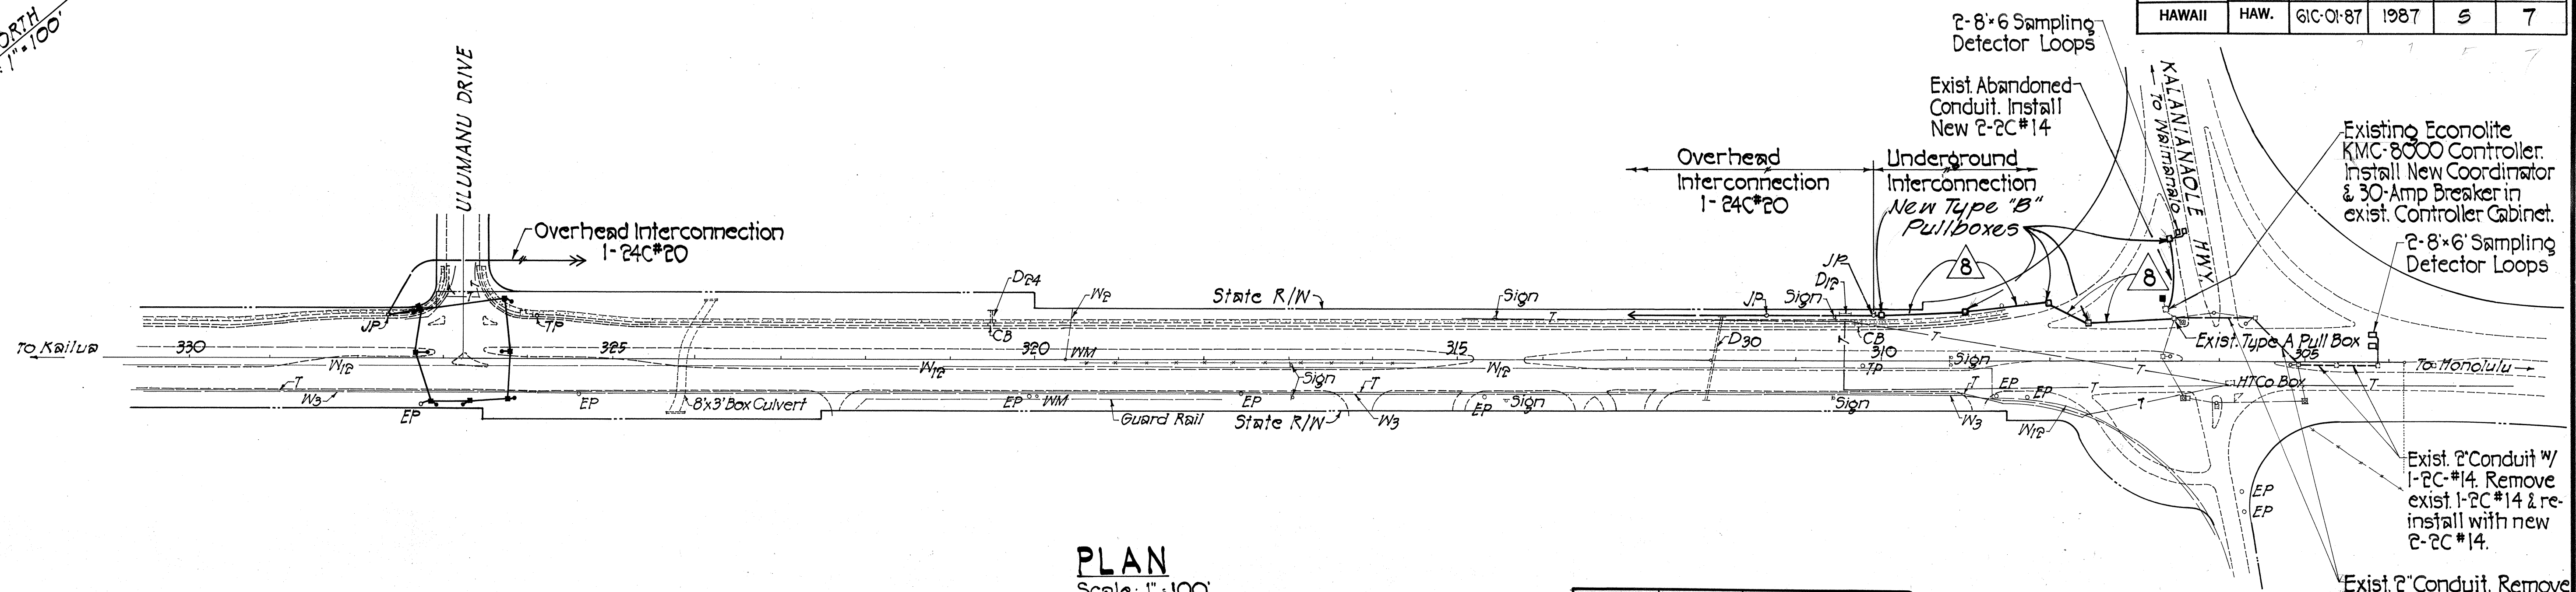

PLAN
Scale: 1" = 100'

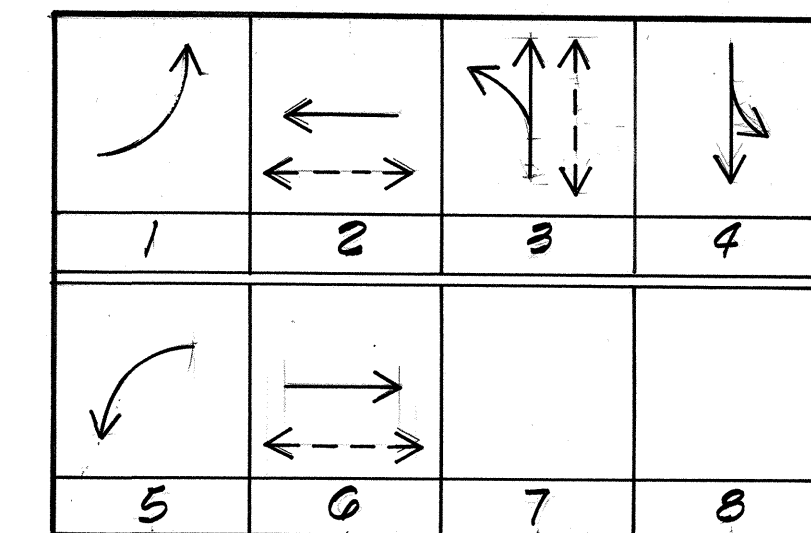

EXISTING PHASE DIAGRAM

ORIGINAL PLAN	SURVEY PLOTTED BY	DATE
NOTE BOOK	DESIGNED BY	
NO.	CHECKED BY	

STATE OF HAWAII
DEPARTMENT OF TRANSPORTATION
HIGHWAYS DIVISION
**INTERCONNECTION ~ ULLUMANU DRIVE
TO KALANIANA'OLE HWY/KAILUA RD.
INTERSECTION**
**KAILUA ROAD
TRAFFIC SIGNALS AT ULLUMANU DRIVE
PROJ. No. GIC-01-87**
SCALE: 1" = 100' DATE: May, 1987
SHEET NO. 5 OF 7 SHEETS