


FED. ROAD DIST. NO.	STATE	PROJ. NO.	FISCAL YEAR	SHEET NO.	TOTAL SHEETS
HAWAII	HAW.	61C-01-87	1987	6	7

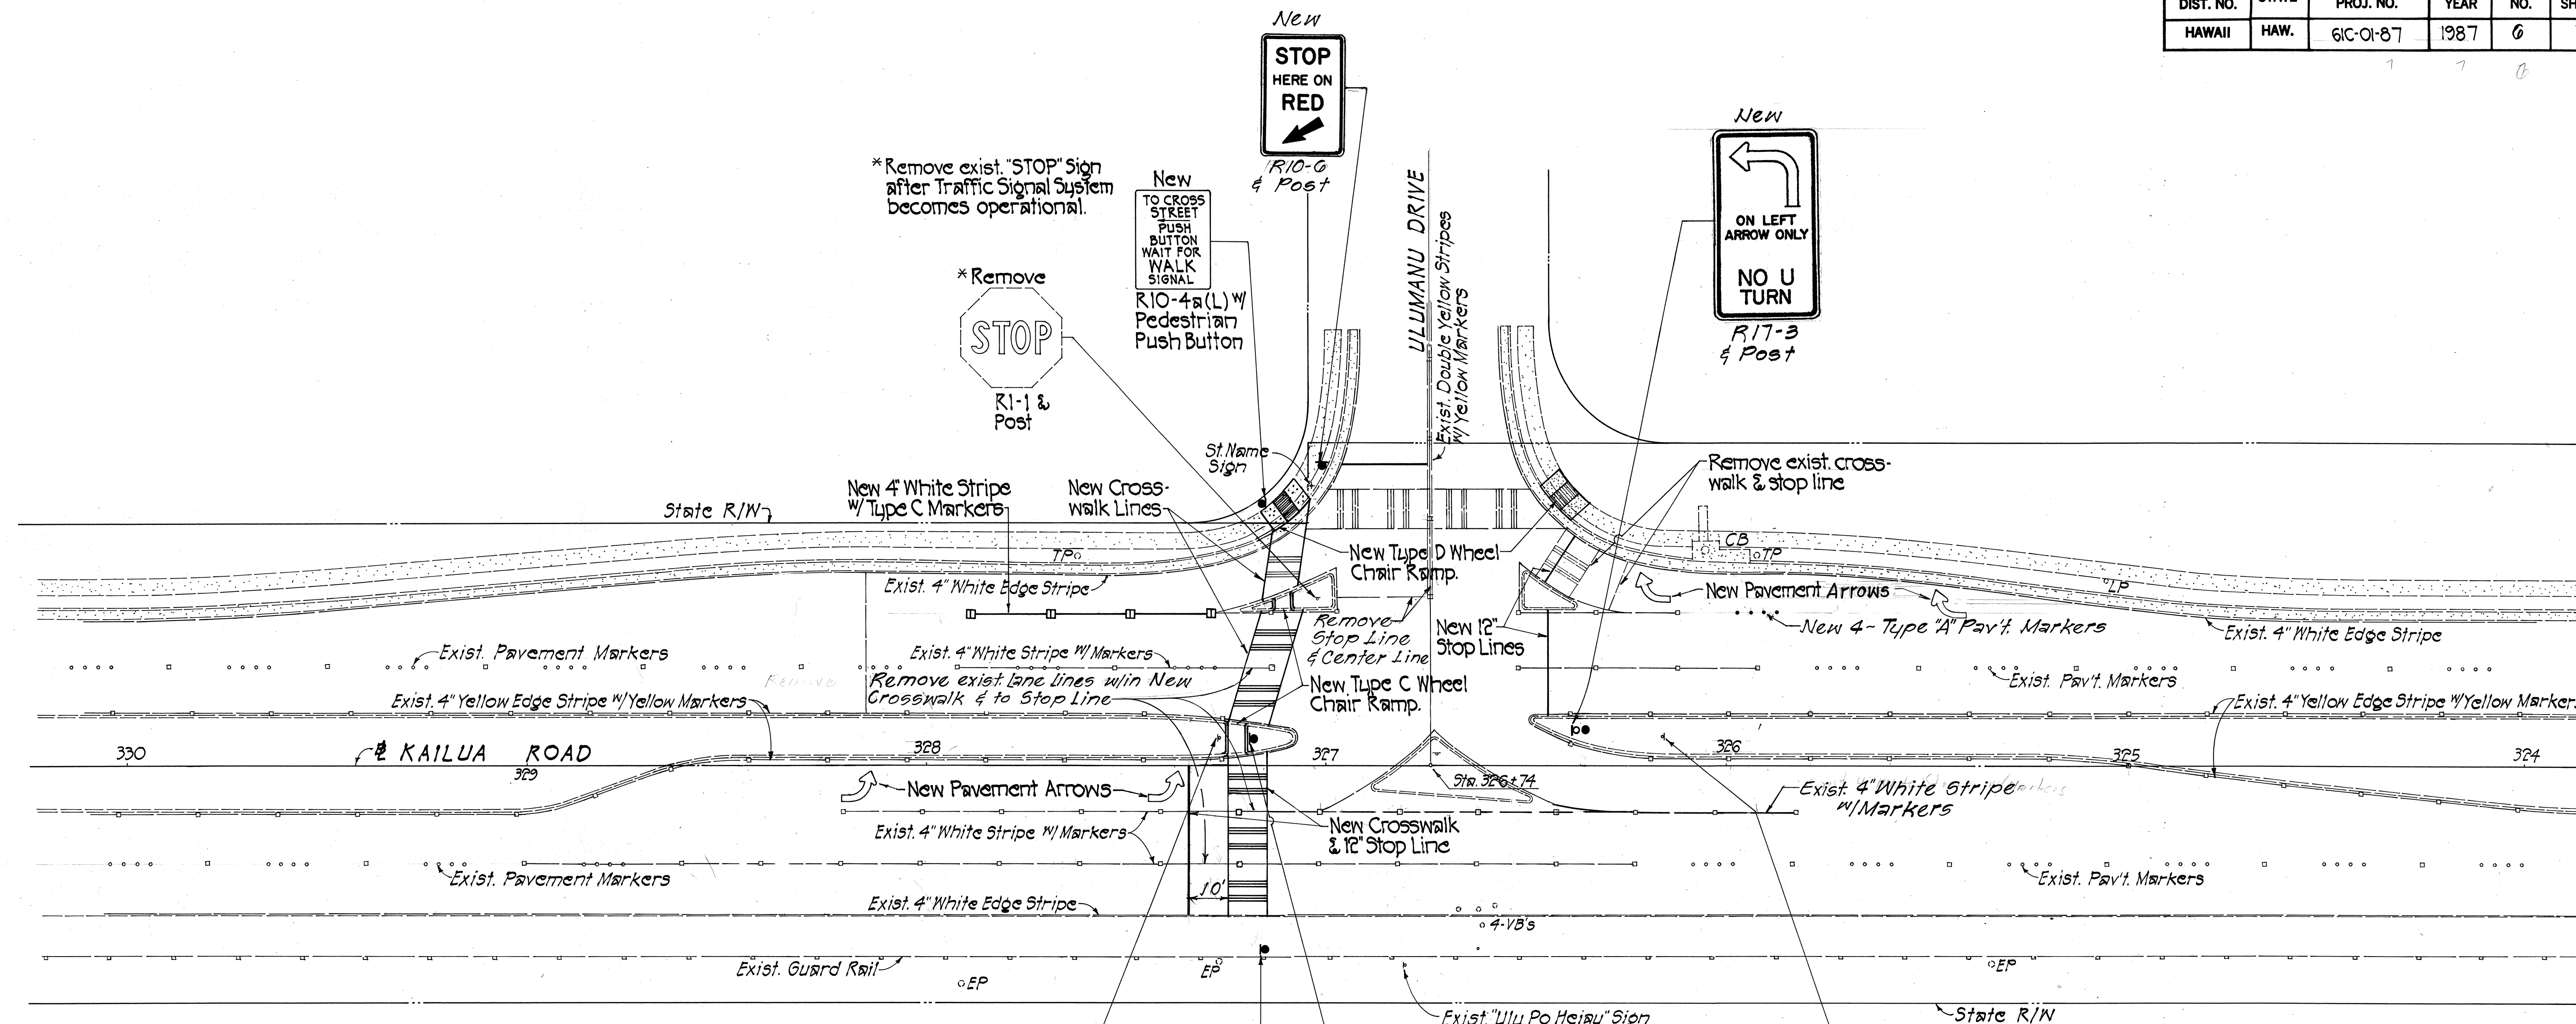

PLAN
Scale: 1" = 20'
TMK: 4-2-13, 32 & 33

APPROVED:

[Signature] 4/20/87
CHIEF, DIVISION OF ENGINEERING, DPW
(APPROVED FOR CONSTRUCTION WITH CITY R/W ONLY)

STATE OF HAWAII
DEPARTMENT OF TRANSPORTATION
HIGHWAYS DIVISION

SIGNS & PAYEMENT MARKINGS

KAILUA ROAD
TRAFFIC SIGNALS AT ULUMANU DRIVE
PROJ. NO. 61C-01-87

SCALE: 1" = 20' DATE: May, 1987
SHEET No. 6 OF 7 SHEETS

ORIGINAL PLAN	DATE
DESIGNED BY	
TRACED BY	
NOTED BY	
CHECKED BY	