

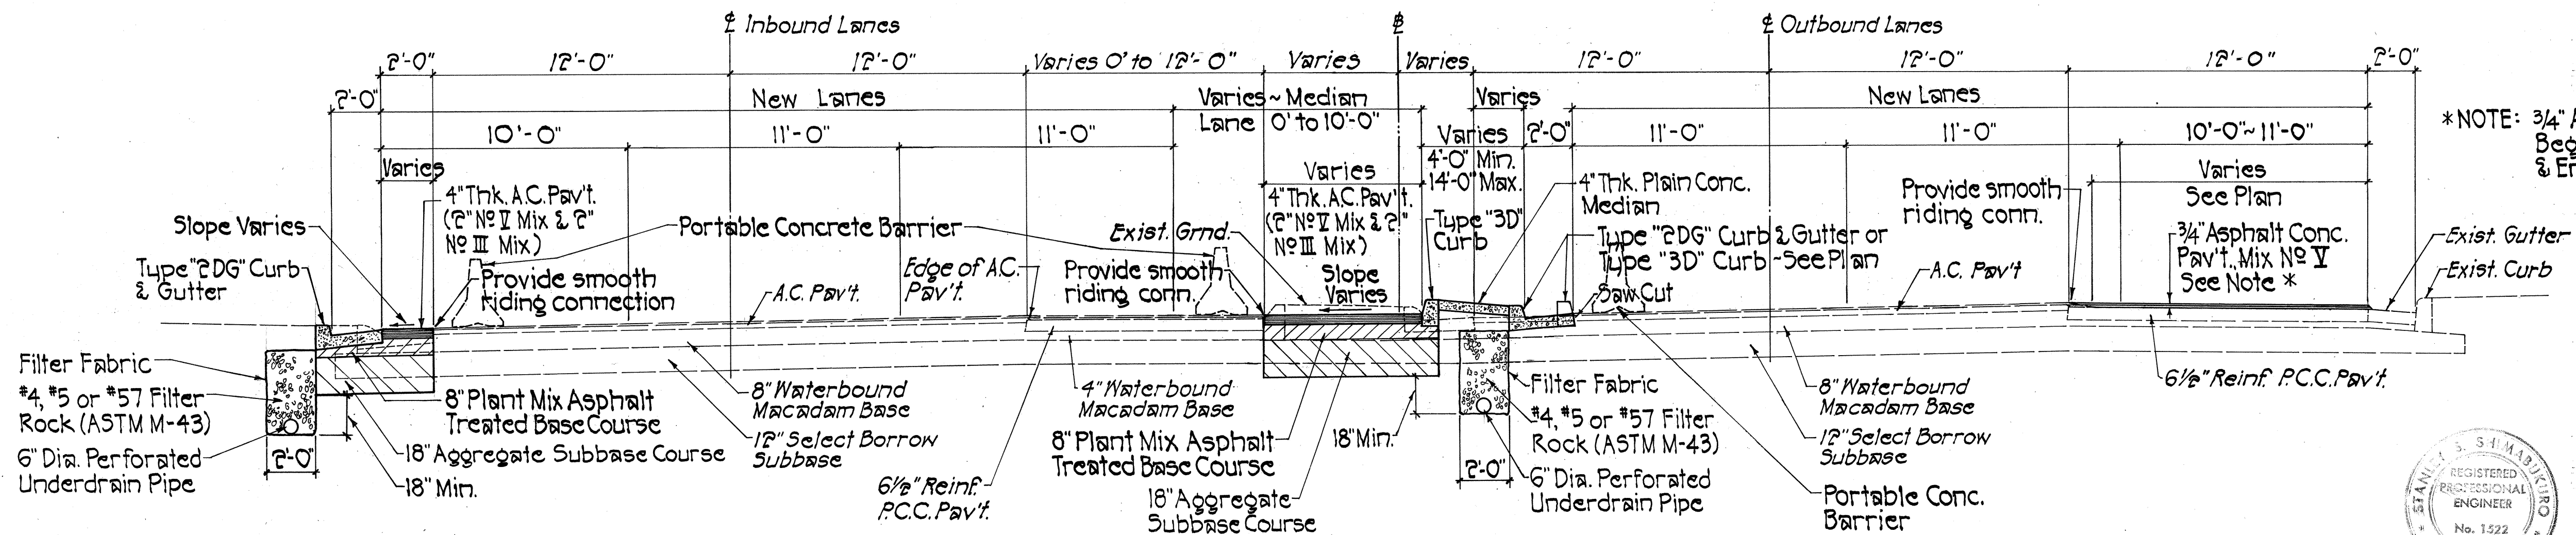
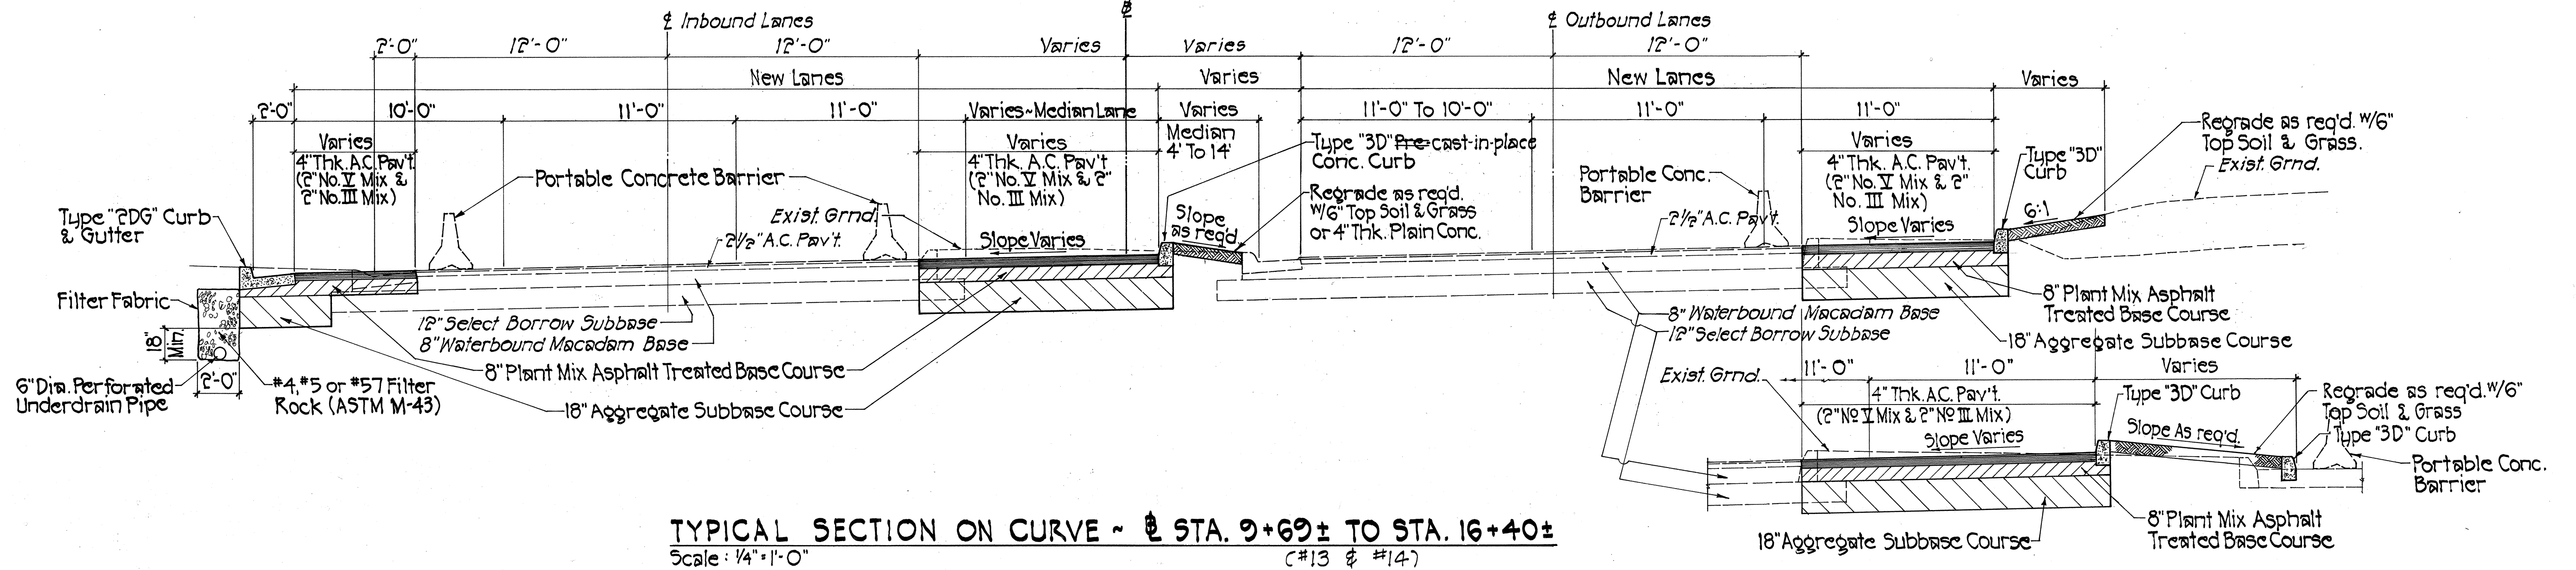
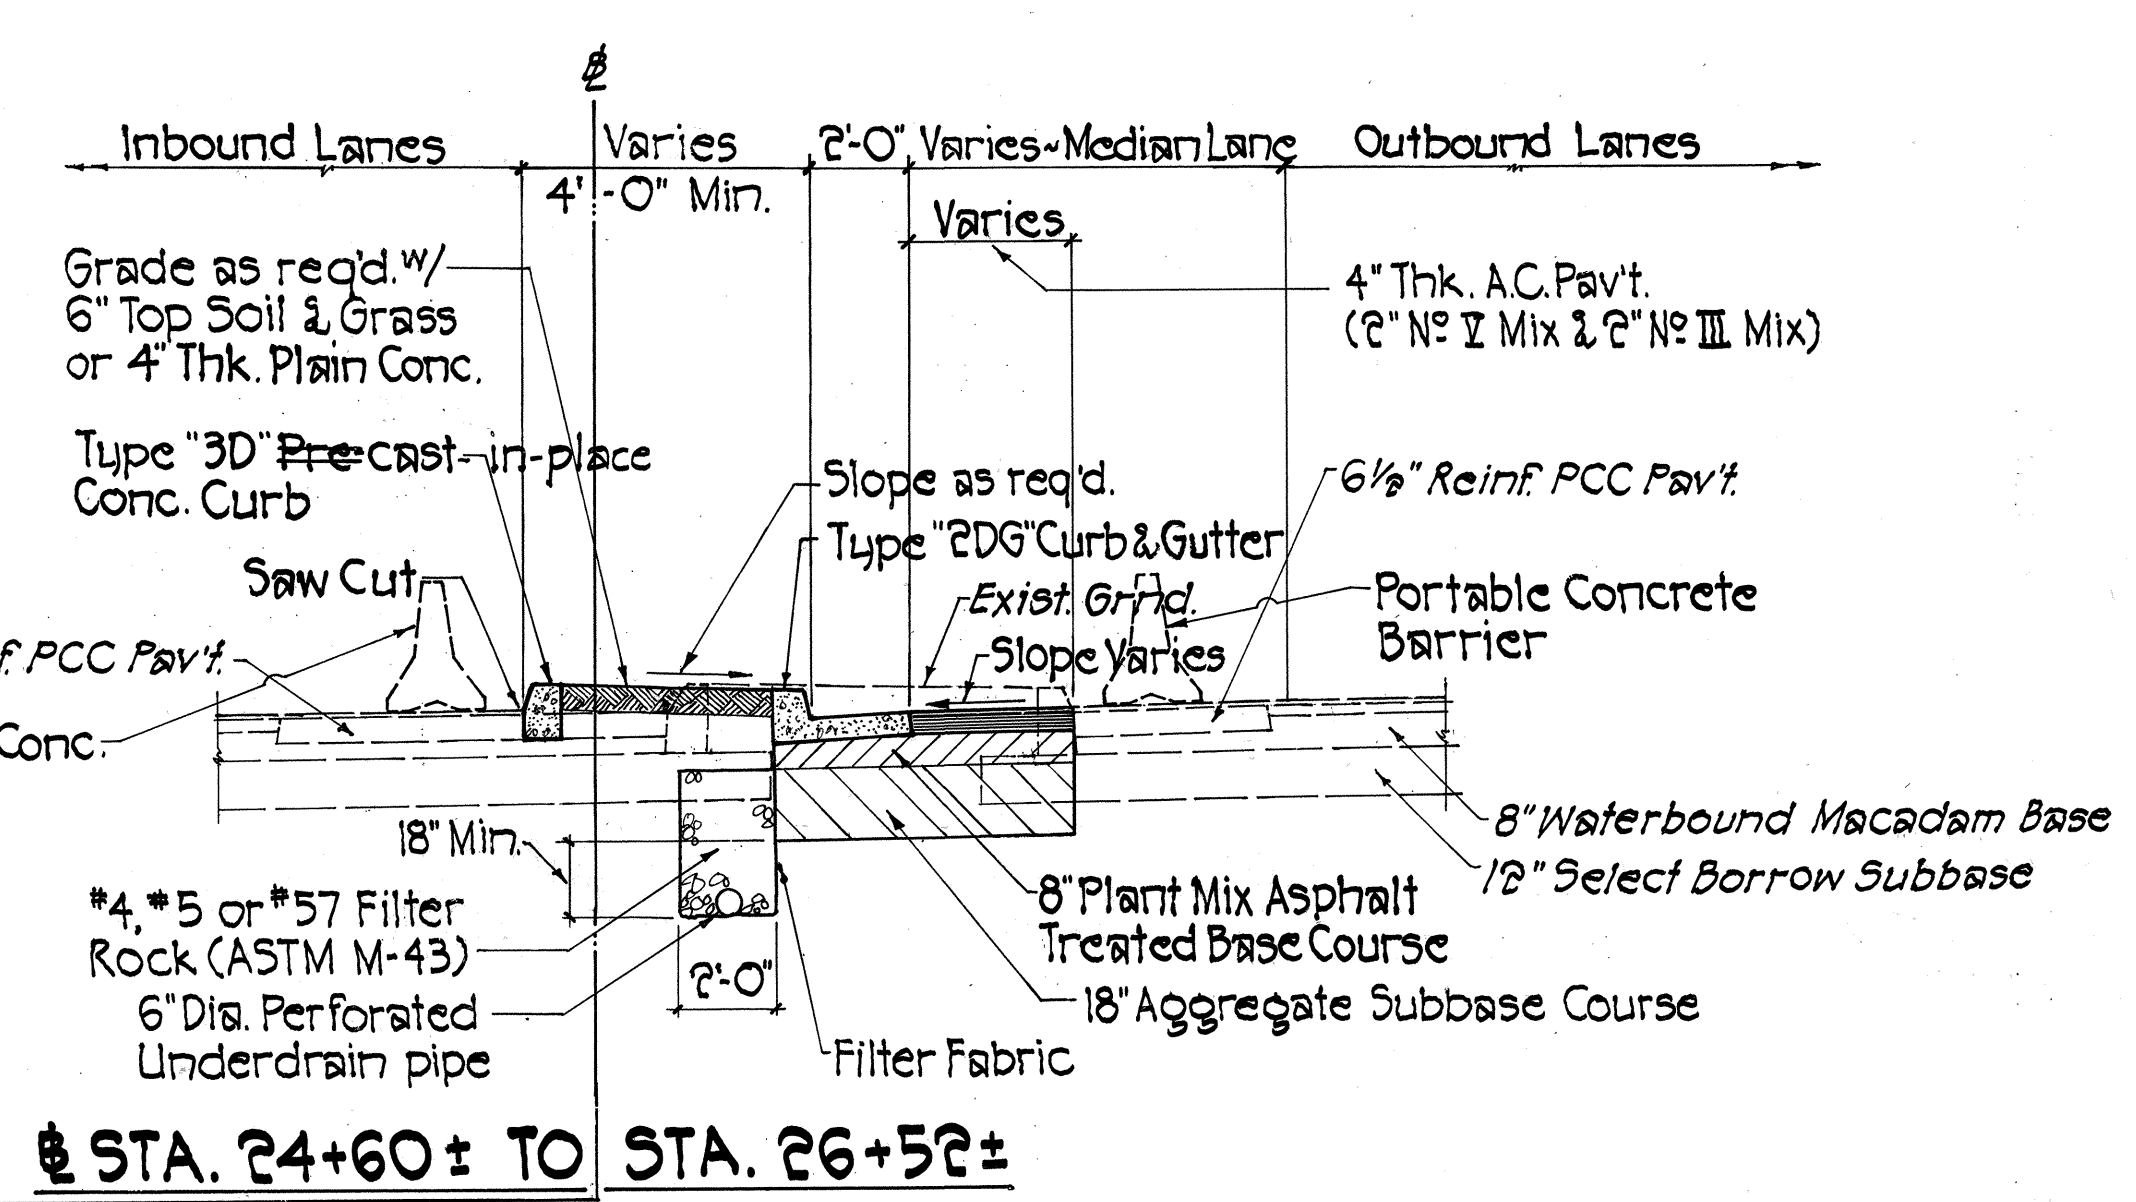


FED. ROAD DIST. NO.	STATE	FED. AID PROJ. NO.	FISCAL YEAR	SHEET NO.	TOTAL SHEETS
HAWAII	HAW.	F-061-1(23)	1988	4	49

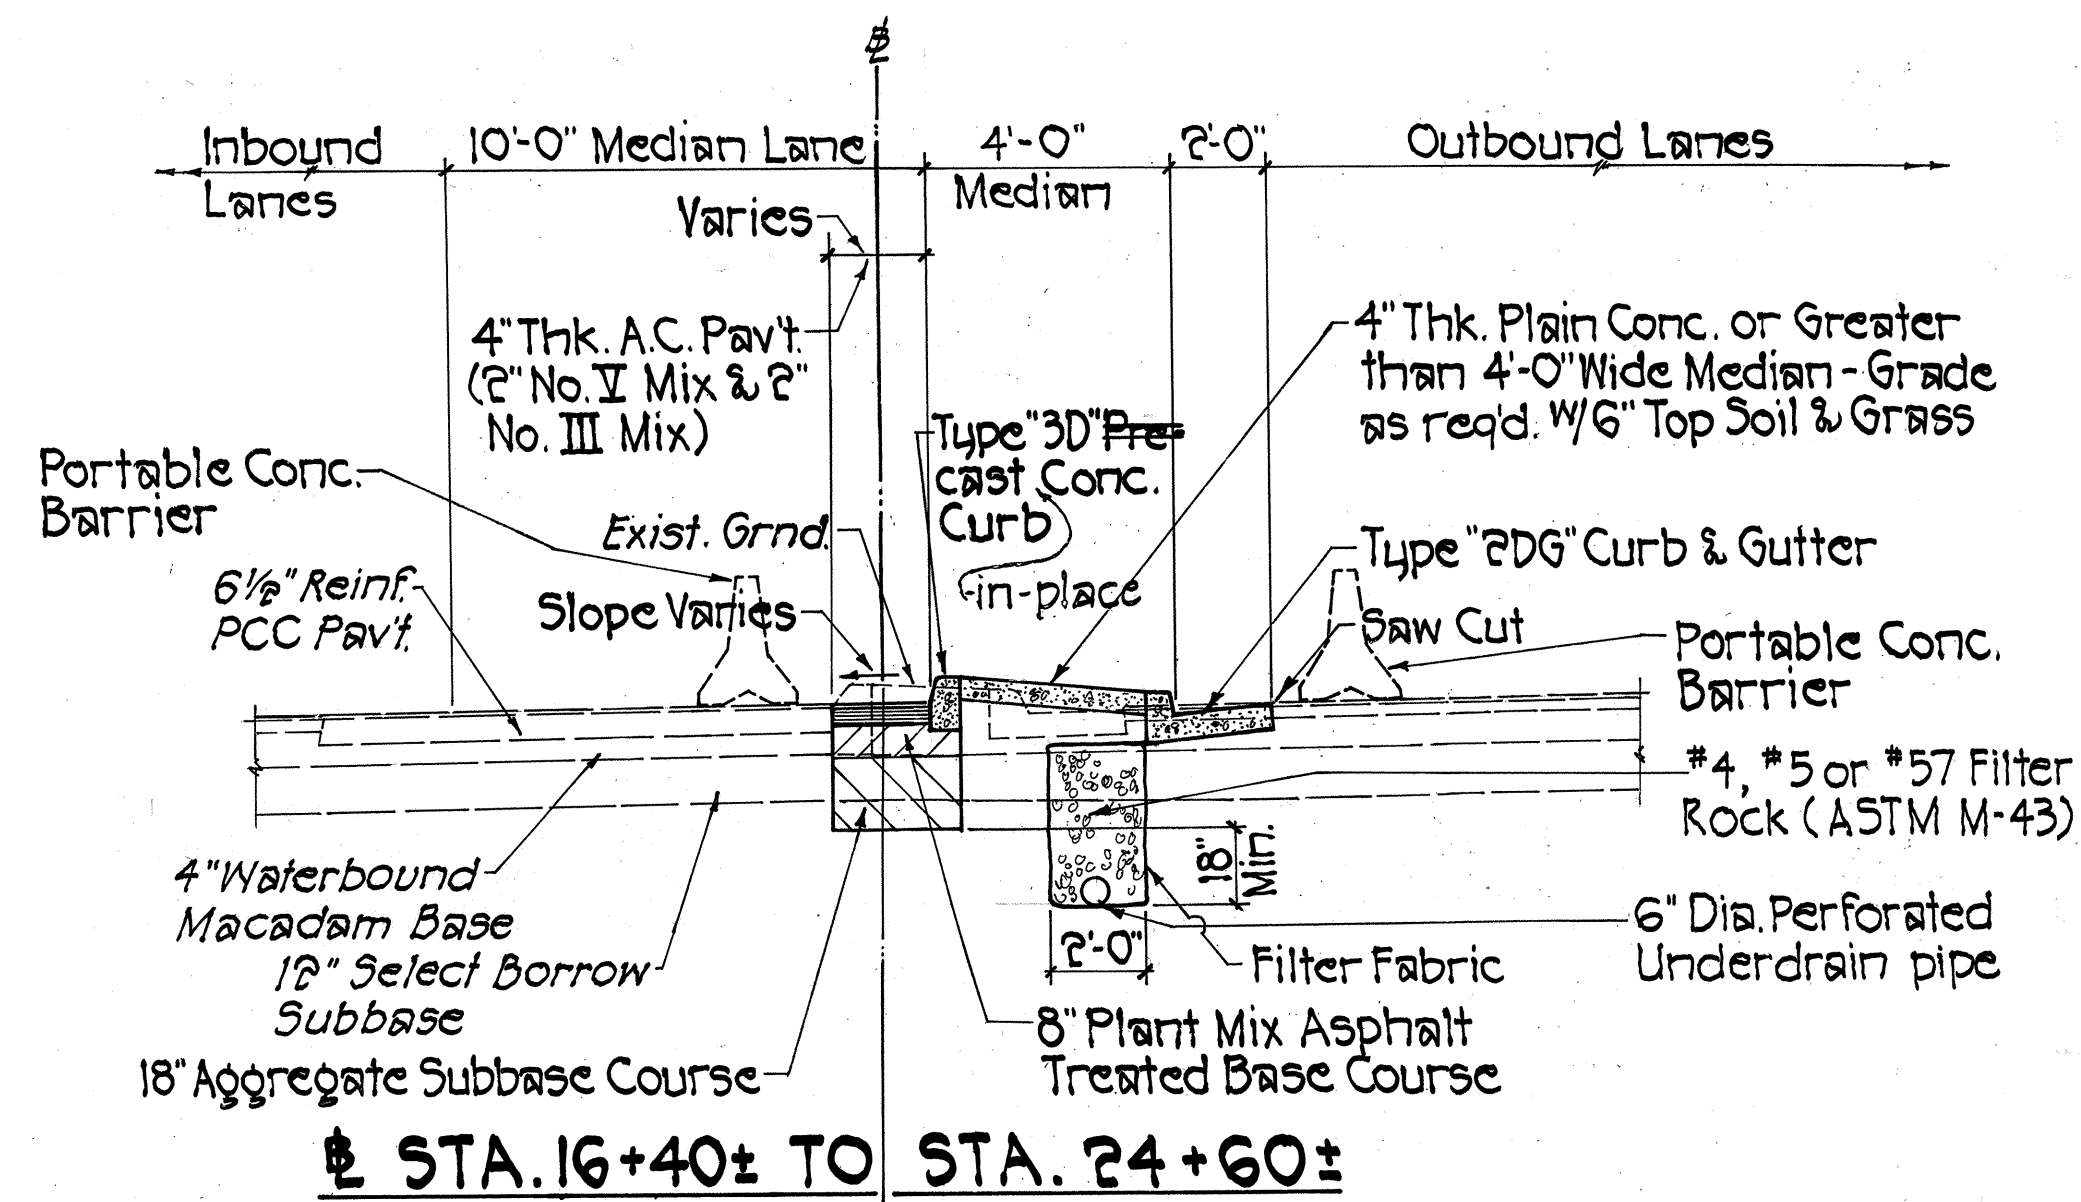

*NOTE: 3/4" A.C. Pavement, Mix No. V Begins @ Sta. 8+00± & Ends @ Sta. 13+05±

SURVEY PLOTTED BY	DATE
DRAWN BY	
DESIGNED BY	
QUANTITIES BY	
CHECKED BY	
ORIGINAL PLAN	
NOTE BOOK	
No.	

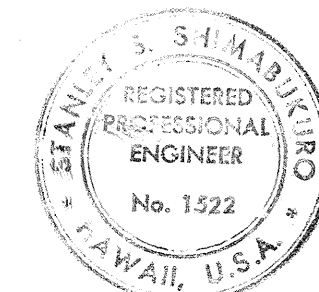

THIS WORK WAS PREPARED BY ME OR UNDER MY SUPERVISION.
Stanley D. Chumalubun


STATE OF HAWAII
DEPARTMENT OF TRANSPORTATION
HIGHWAYS DIVISION

TYPICAL ROADWAY
SECTIONS


IMPROVEMENTS ALONG PALI HIGHWAY
BETWEEN NIOLOPA PL. & WAOKANAKA ST.
PROJECT NO. F-061-1(23)

SHEET NO. 2 OF 3 SHEETS


FED. ROAD DIST. NO.	STATE	FED. AID PROJ. NO.	FISCAL YEAR	SHEET NO.	TOTAL SHEETS
HAWAII	HAW.	F-061-1(23)	1988	5	49

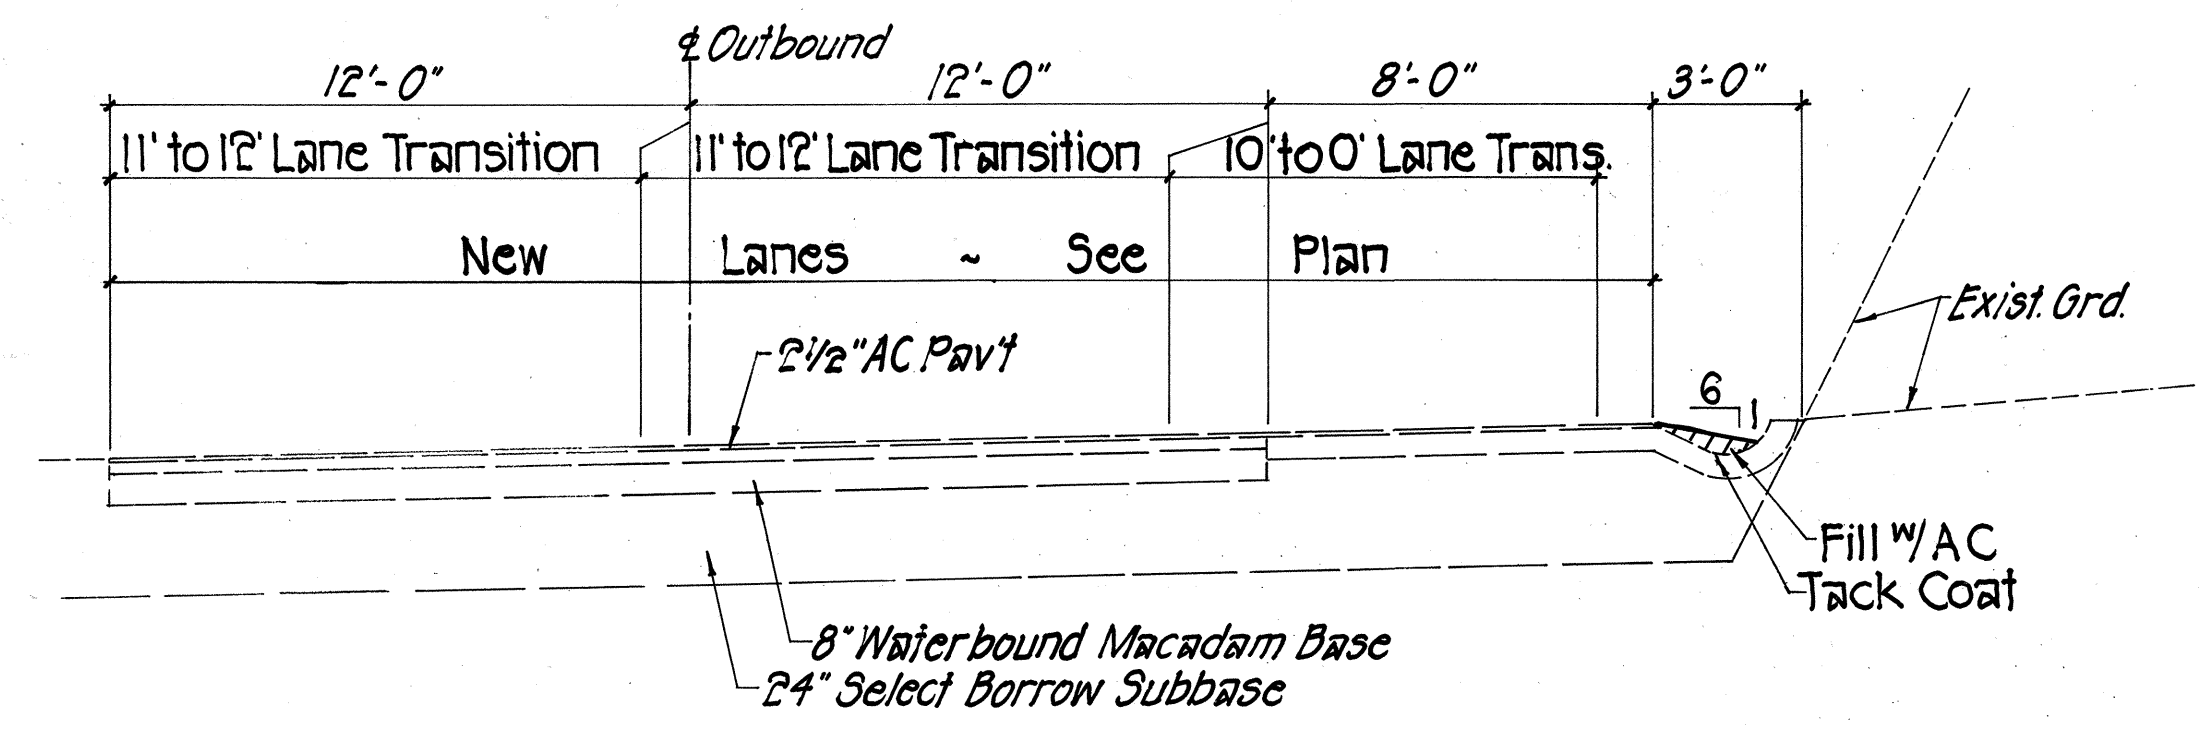


TYPICAL SECTION - OB STA. 80+42 TO STA. 88+00
Scale: 1/4" = 1'-0"

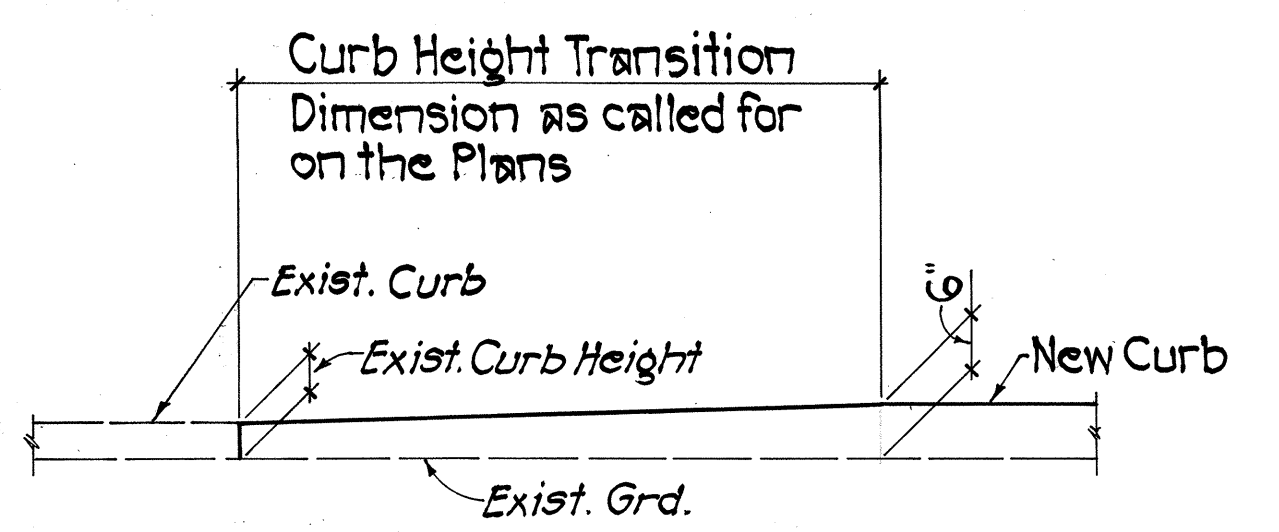


TYPICAL CURB TRANSITION
Not To Scale

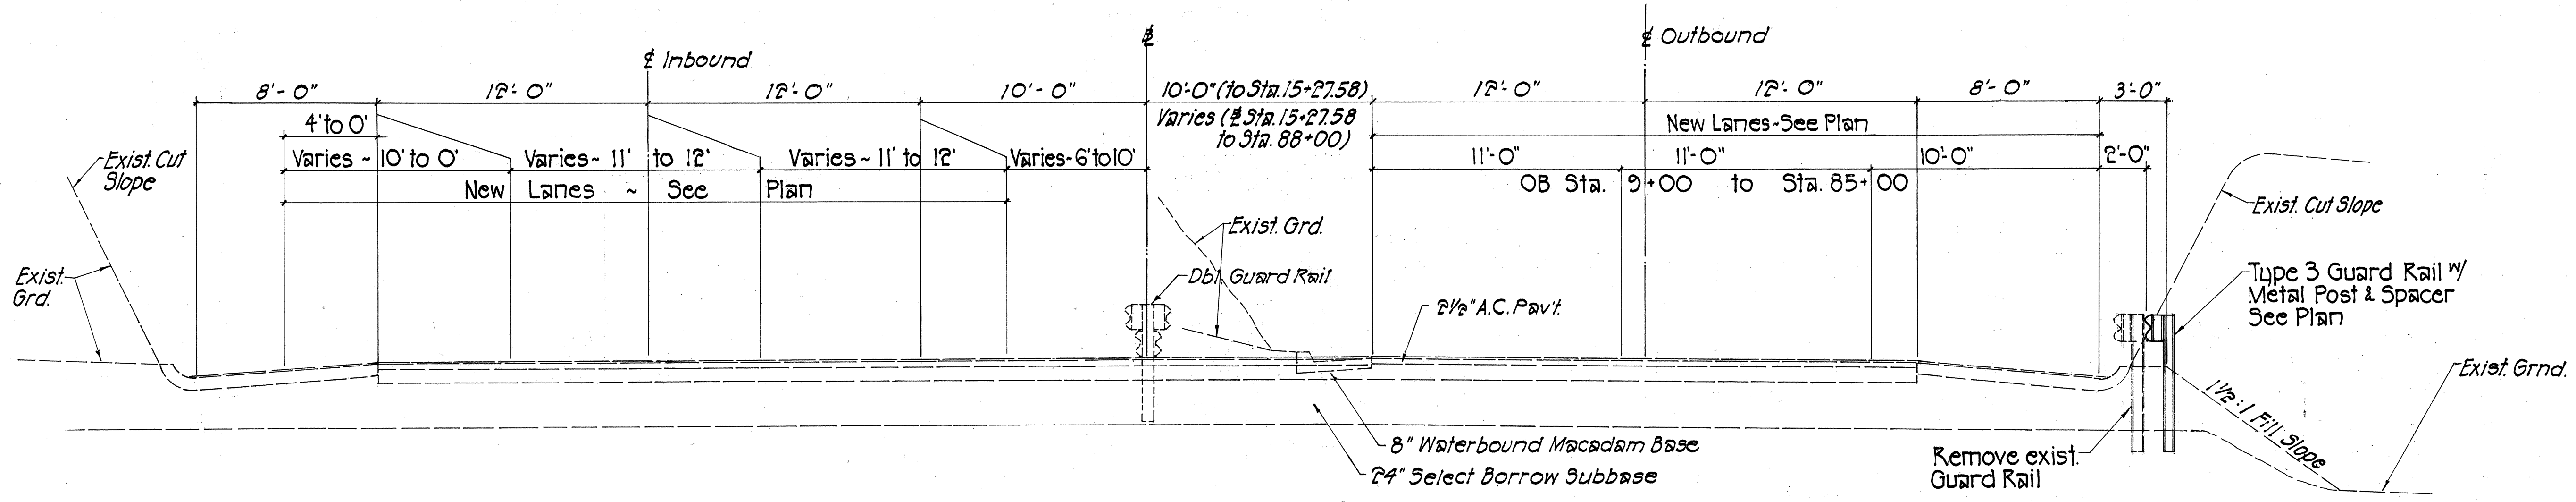

TYPICAL SECTION - OUTBOUND - OB STA. 9+00 TO OB STA. 85+00
Scale: 1/4" = 1'-0"

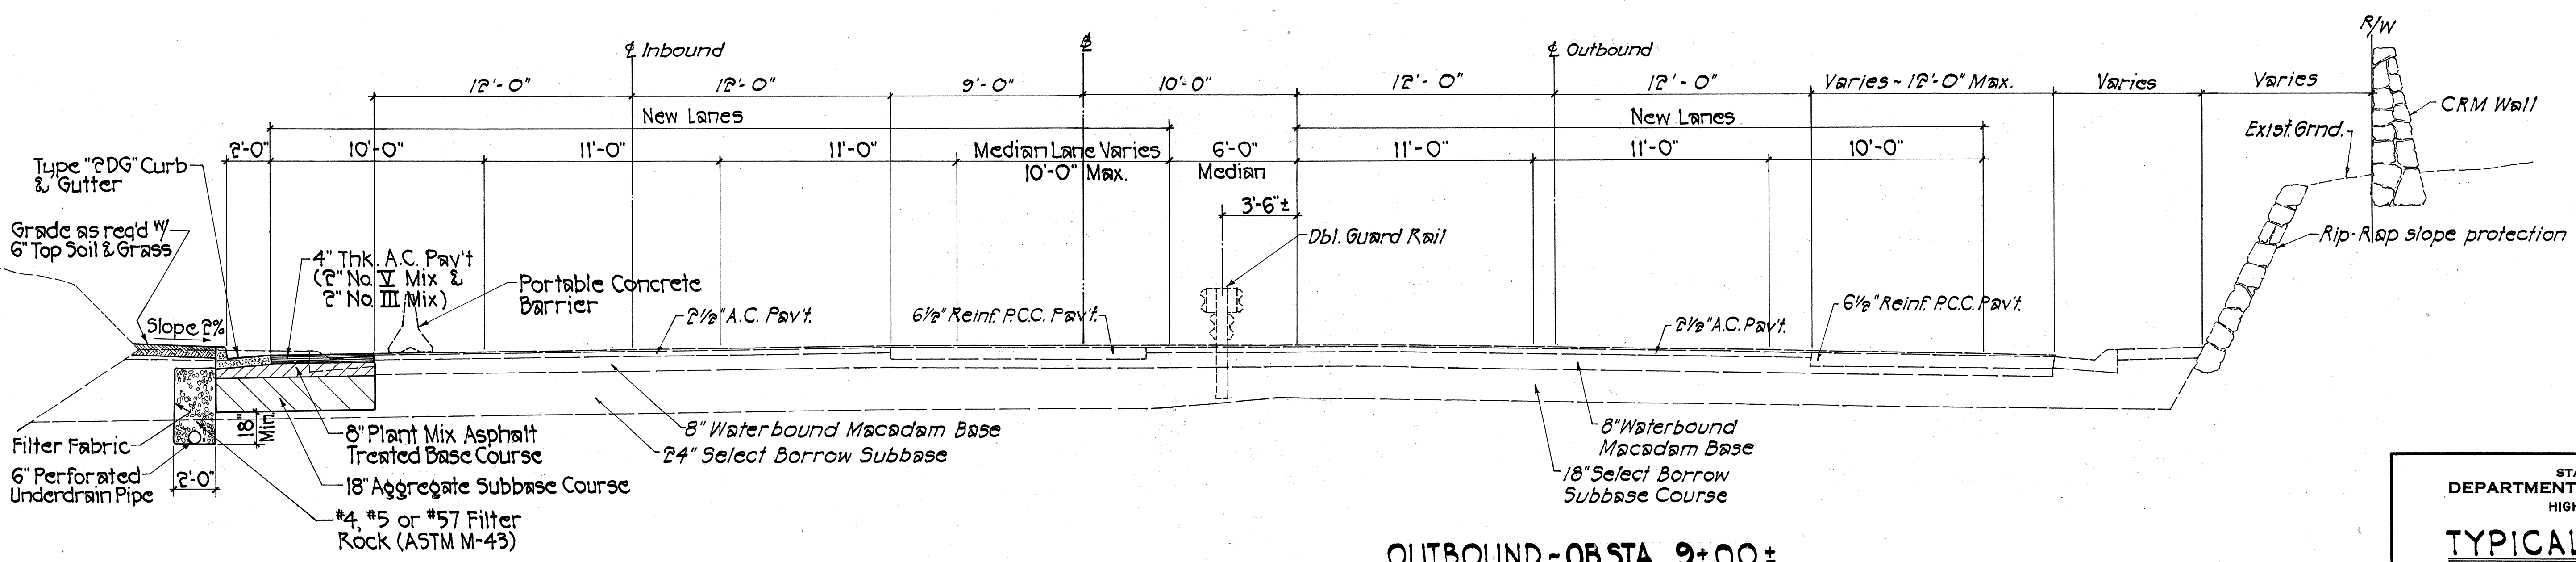


TYPICAL SECTION - INBOUND - STA. 10+25 TO OB STA. 15+39.27
Scale: 1/4" = 1'-0"

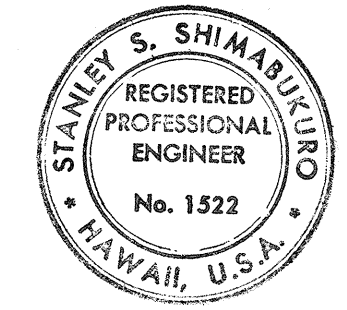


THIS WORK WAS PREPARED BY ME OR UNDER MY SUPERVISION.
Stanley S. Shimamura

STATE OF HAWAII
DEPARTMENT OF TRANSPORTATION
HIGHWAYS DIVISION
TYPICAL ROADWAY SECTIONS
IMPROVEMENTS ALONG PALI HIGHWAY
BETWEEN NIOLOPA PL. & WAOKANAKA ST.
PROJECT NO. F-061-1(23)

FED. ROAD DIST. NO.	STATE	FED. AID PROJ. NO.	FISCAL YEAR	SHEET NO.	TOTAL SHEETS
HAWAII	HAW.	F-061-1(23)	1988	55-1	49

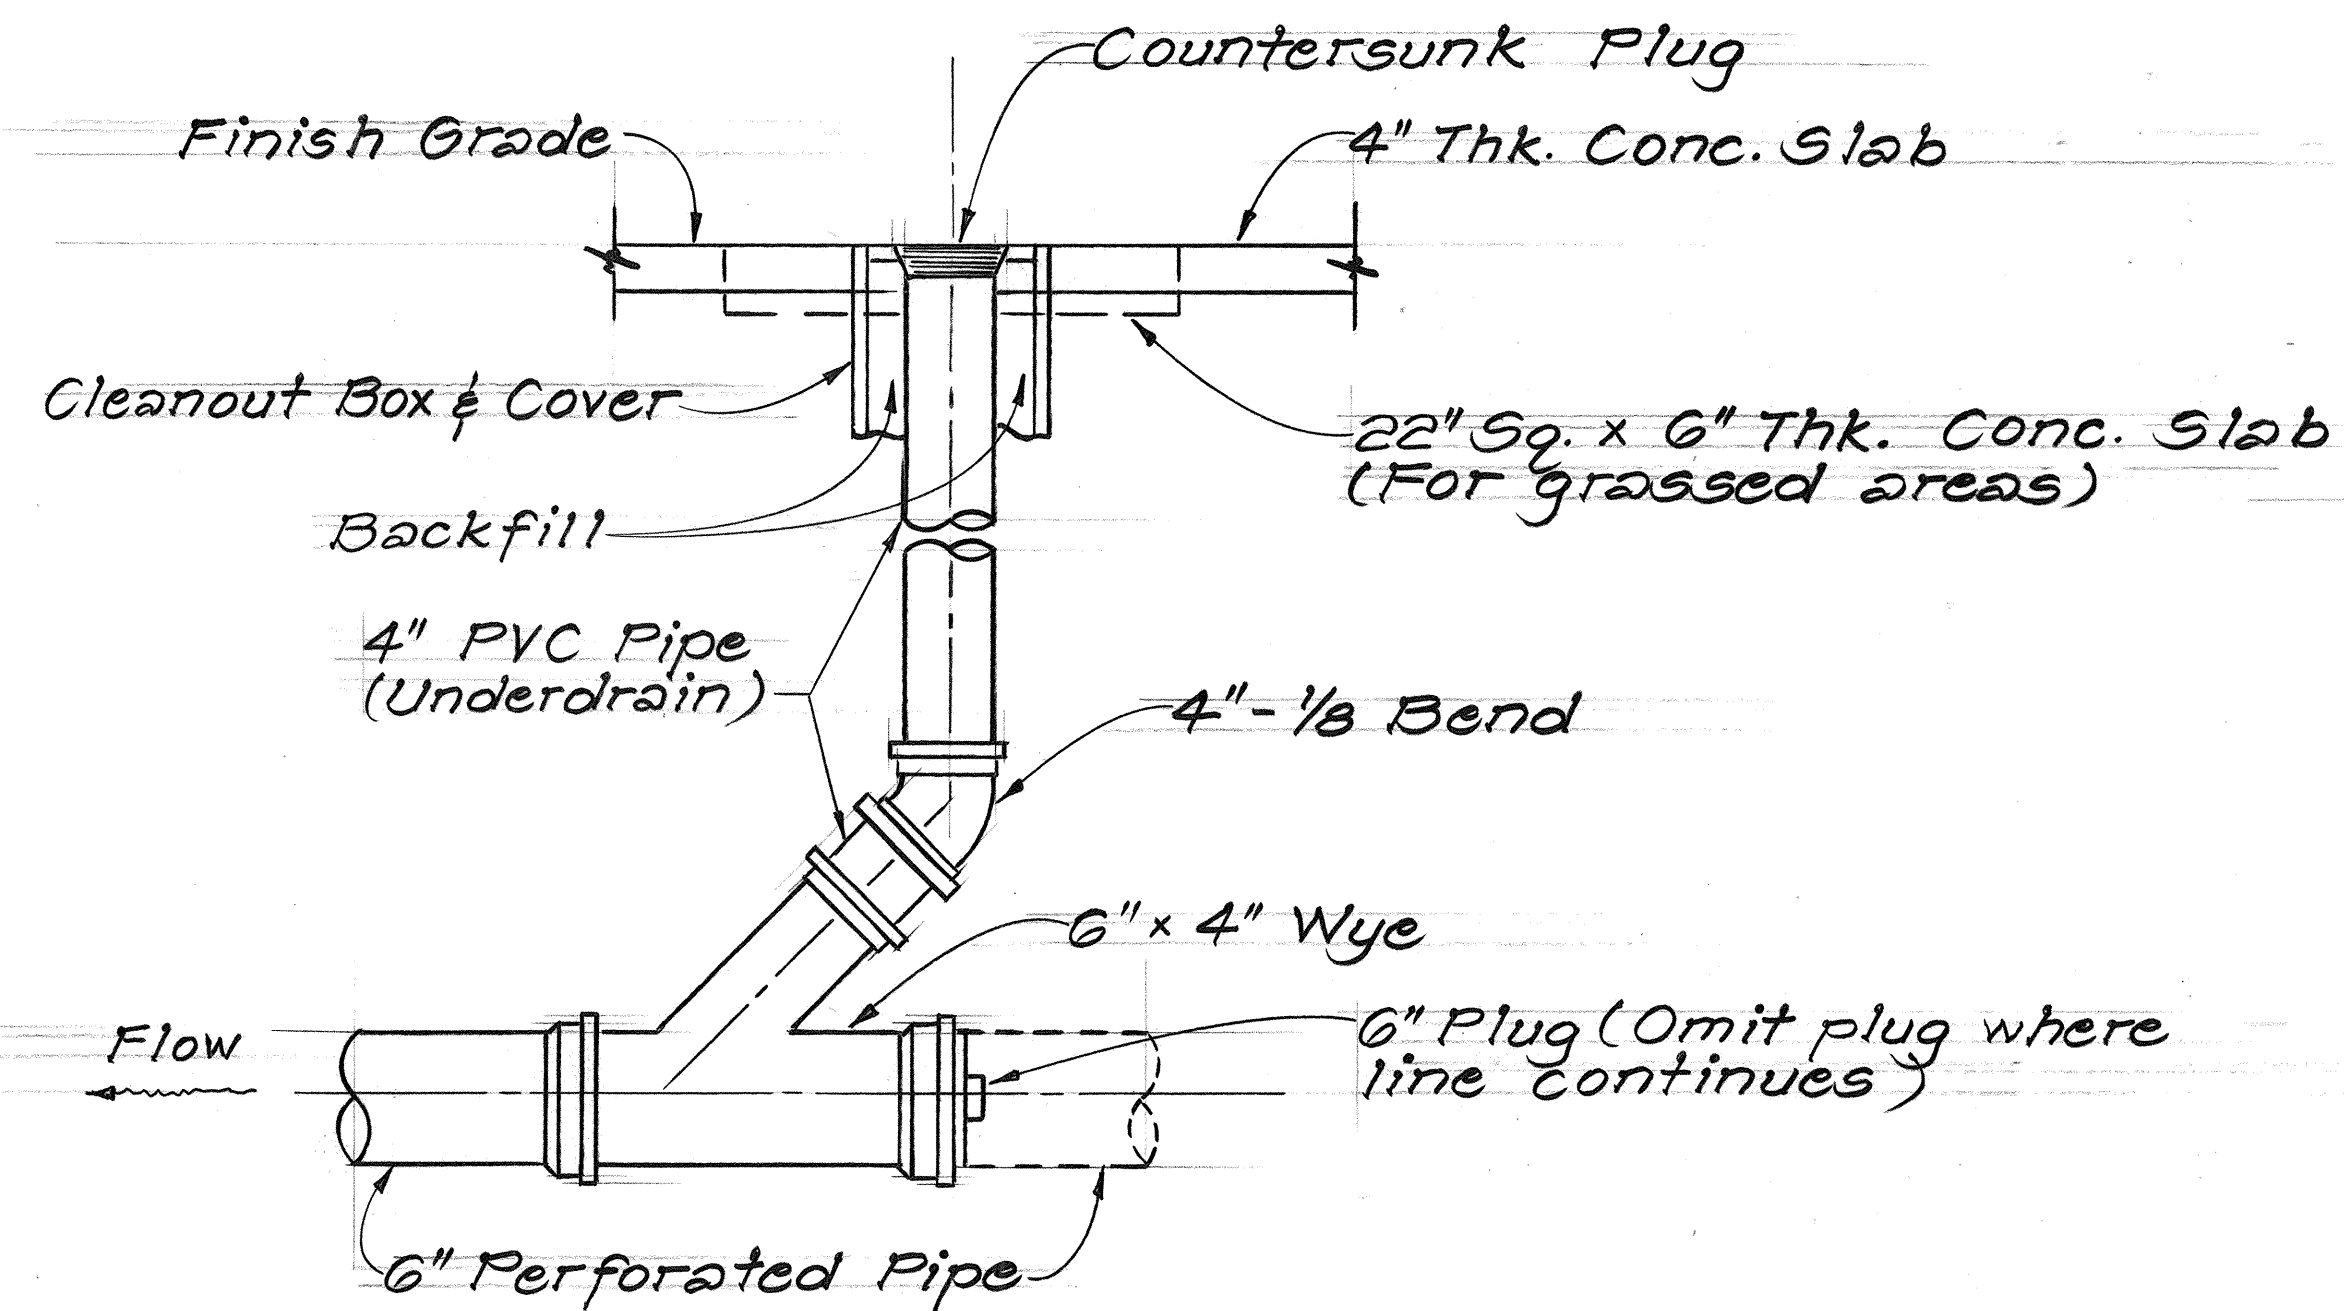

CLEANOUT TO GRADE
Not to Scale

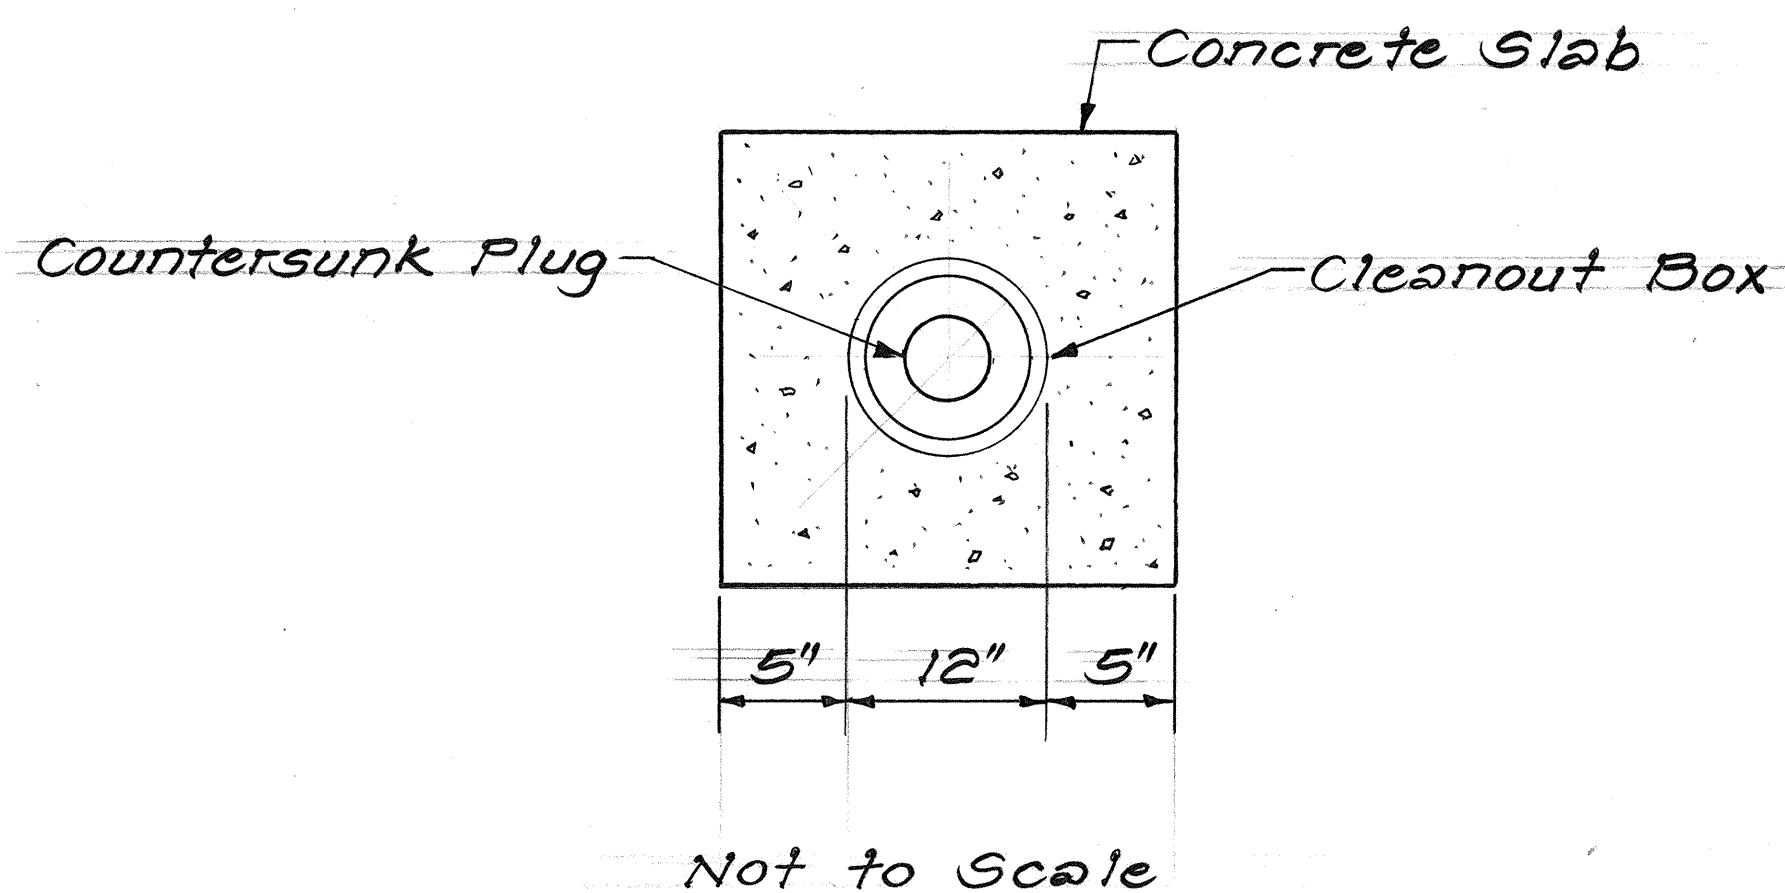

DETAIL FOR CLEANOUT AND LOCATION

SUMMARY OF CLEANOUT LOCATIONS			
	STATION	LOCATION	PLAN SHEET NO.
1.	116+82	Median	10
2.	118+00	Median	10
3.	119+65	Median	10
4.	121+40	Median	11
5.	1+45	Left Shoulder	12
6.	1+70	Median	12
7.	2+94	Left Shoulder	12
8.	3+40	Median	12
9.	4+75	Median	12
10.	5+05	Left Shoulder	12
11.	6+15	Median	12
12.	6+68	Left Shoulder	13
13.	7+60	Median	13
14.	8+30	Left Shoulder	13
15.	9+70	Left Shoulder	13
16.	12+25	Left Shoulder	14
17.	13+81	Left Shoulder	14
18.	15+35	Left Shoulder	14
19.	16+40	Left Shoulder	14
20.	16+40	Median	14
21.	17+64	Median	15
22.	17+76	Left Shoulder	15
23.	21+00	Left Shoulder	15
24.	21+08	Median	15
25.	23+40	Median	16
26.	23+42	Left Shoulder	16
27.	25+00	Median	16
28.	26+10	Left Shoulder	17
29.	26+50	Median	17
30.	6+90	Left Shoulder	17
31.	8+75	Left Shoulder	18
32.	10+25	Left Shoulder	18
33.	9+00	Inbound Shoulder	Not On Plan

SURVEY PLOTTED BY	DATE
DRAWN BY	
DESIGNED BY	
QUANTITIES BY	
CHECKED BY	
ORIGINAL PLAN	
NOTE BOOK	
No.	

STATE OF HAWAII
DEPARTMENT OF TRANSPORTATION
HIGHWAYS DIVISION
DRAINAGE DETAILS
IMPROVEMENTS ALONG PALI HWY.
BETWEEN NIOLOPA PLACE AND
WAOKANAKA ST.
PROJECT NO. F-061-1(23)

SHEET No. OF SHEETS

AS-BUILT 55-1