


| INDEX TO DRAWINGS | |
|-------------------|---------------------------------------|
| SHEET NO. | DESCRIPTION |
| 1 | TITLE SHEET |
| 2 | STANDARD PLANS SUMMARY |
| 3 | GENERAL NOTES |
| 4 | ELEC. SITE PLAN & ELEC. SYMB. |
| 5 | NOTES |
| 6 | SINGLE LINE DIAGRAM |
| 7 | DISTR. PNLBD. "DSPB-1" |
| 8 | ELEC. BLDG. SITE PLAN & ELEV. |
| 9 | TUNNEL ELEC. DEMO. PART. PLANS I & II |
| 10 | TUNNEL NEW ELEC. DISTR. PLAN |
| 11 | TUNNEL NEW LTG. PARTIAL PLAN I |
| 12 | TUNNEL NEW LTG. PARTIAL PLAN II |
| 13 | TUNNEL NEW LTG. PARTIAL PLAN III |
| | EXST. TUNNEL BLDG. ELEC. DEMO & |
| 14 | ELEC. PLAN |
| 15 | PART. HWY. LTG. PLAN - I |
| 16 | PART. HWY. LTG. PLAN - II & III |
| 17 | PART. HWY. LTG. PLAN - IV & V |
| 18 | PART. HWY. LTG. PLAN - VI & VII |
| 19 | PALI HWY. LTG. DIAGRAM - I |
| 20 | PALI HWY. LTG. DIAGRAM - II |
| 21 | TUNNEL SECTIONS & DIAGRAMS |
| 22 | STREET LIGHT DETAILS |
| 23 | STREET LIGHT DETAILS |
| 24 | DETAILS |
| 25 | ELEVATIONS & FLOODLIGHT DETAILS |
| 26 | PNL. & FIXTR. SCHEDULES |
| 27 | SITE PLAN - NEW SWITCHGEAR STA. & |
| | TRANSFORMER PAD |
| 28 | ELEV., NOTES, DETAILS |
| 29 | DOOR & LOUVER SCHED., PAINT SCHED. |
| | & MISC. ARCHITECTURAL DETAILS |

STATE OF HAWAII
DEPARTMENT OF TRANSPORTATION
HIGHWAYS DIVISION
HONOLULU, HAWAII
PLANS FOR
"AS-BUILT"
PALI HIGHWAY TUNNELS
HIGHWAY LIGHTING IMPROVEMENTS
PROJECT NO. 61D-01-85

DISTRICTS OF HONOLULU AND KOOLAUPOKO


ISLAND OF OAHU

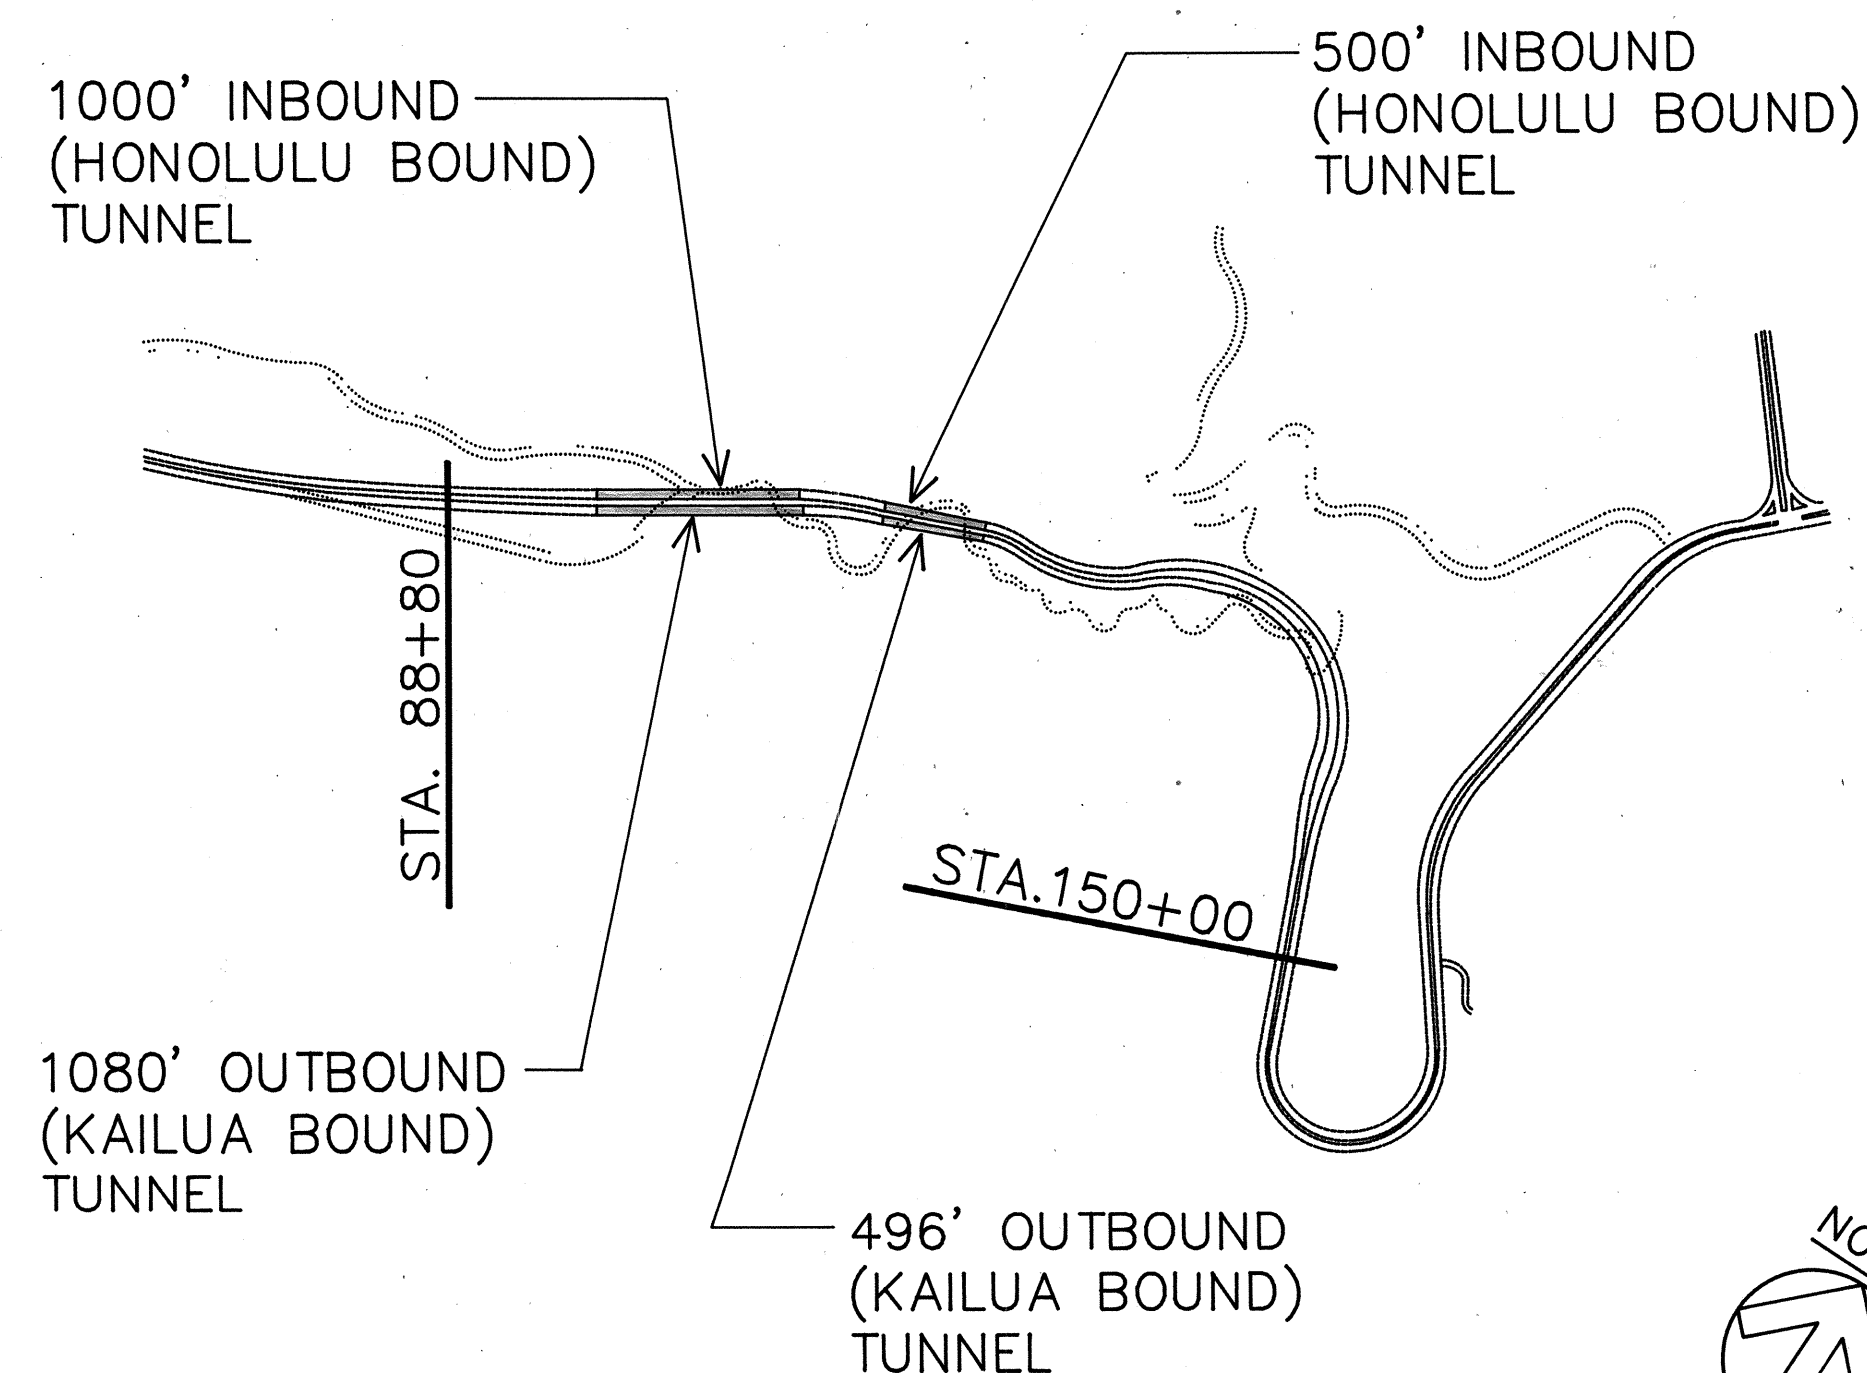

PROJECT LIMITS:
STA. 88+80 TO STA. 150+00

LAYOUT PLAN
SCALE: 1" = 1000'-0"


| FED. ROAD DIST. NO. | STATE | PROJ. NO. | FISCAL YEAR | SHEET NO. | TOTAL SHEETS |
|------------------------|-------|-----------|----------------|--------------|-----------------|
| HAWAII | HAW. | 61D-01-85 | 1988 | 1 | 29 |

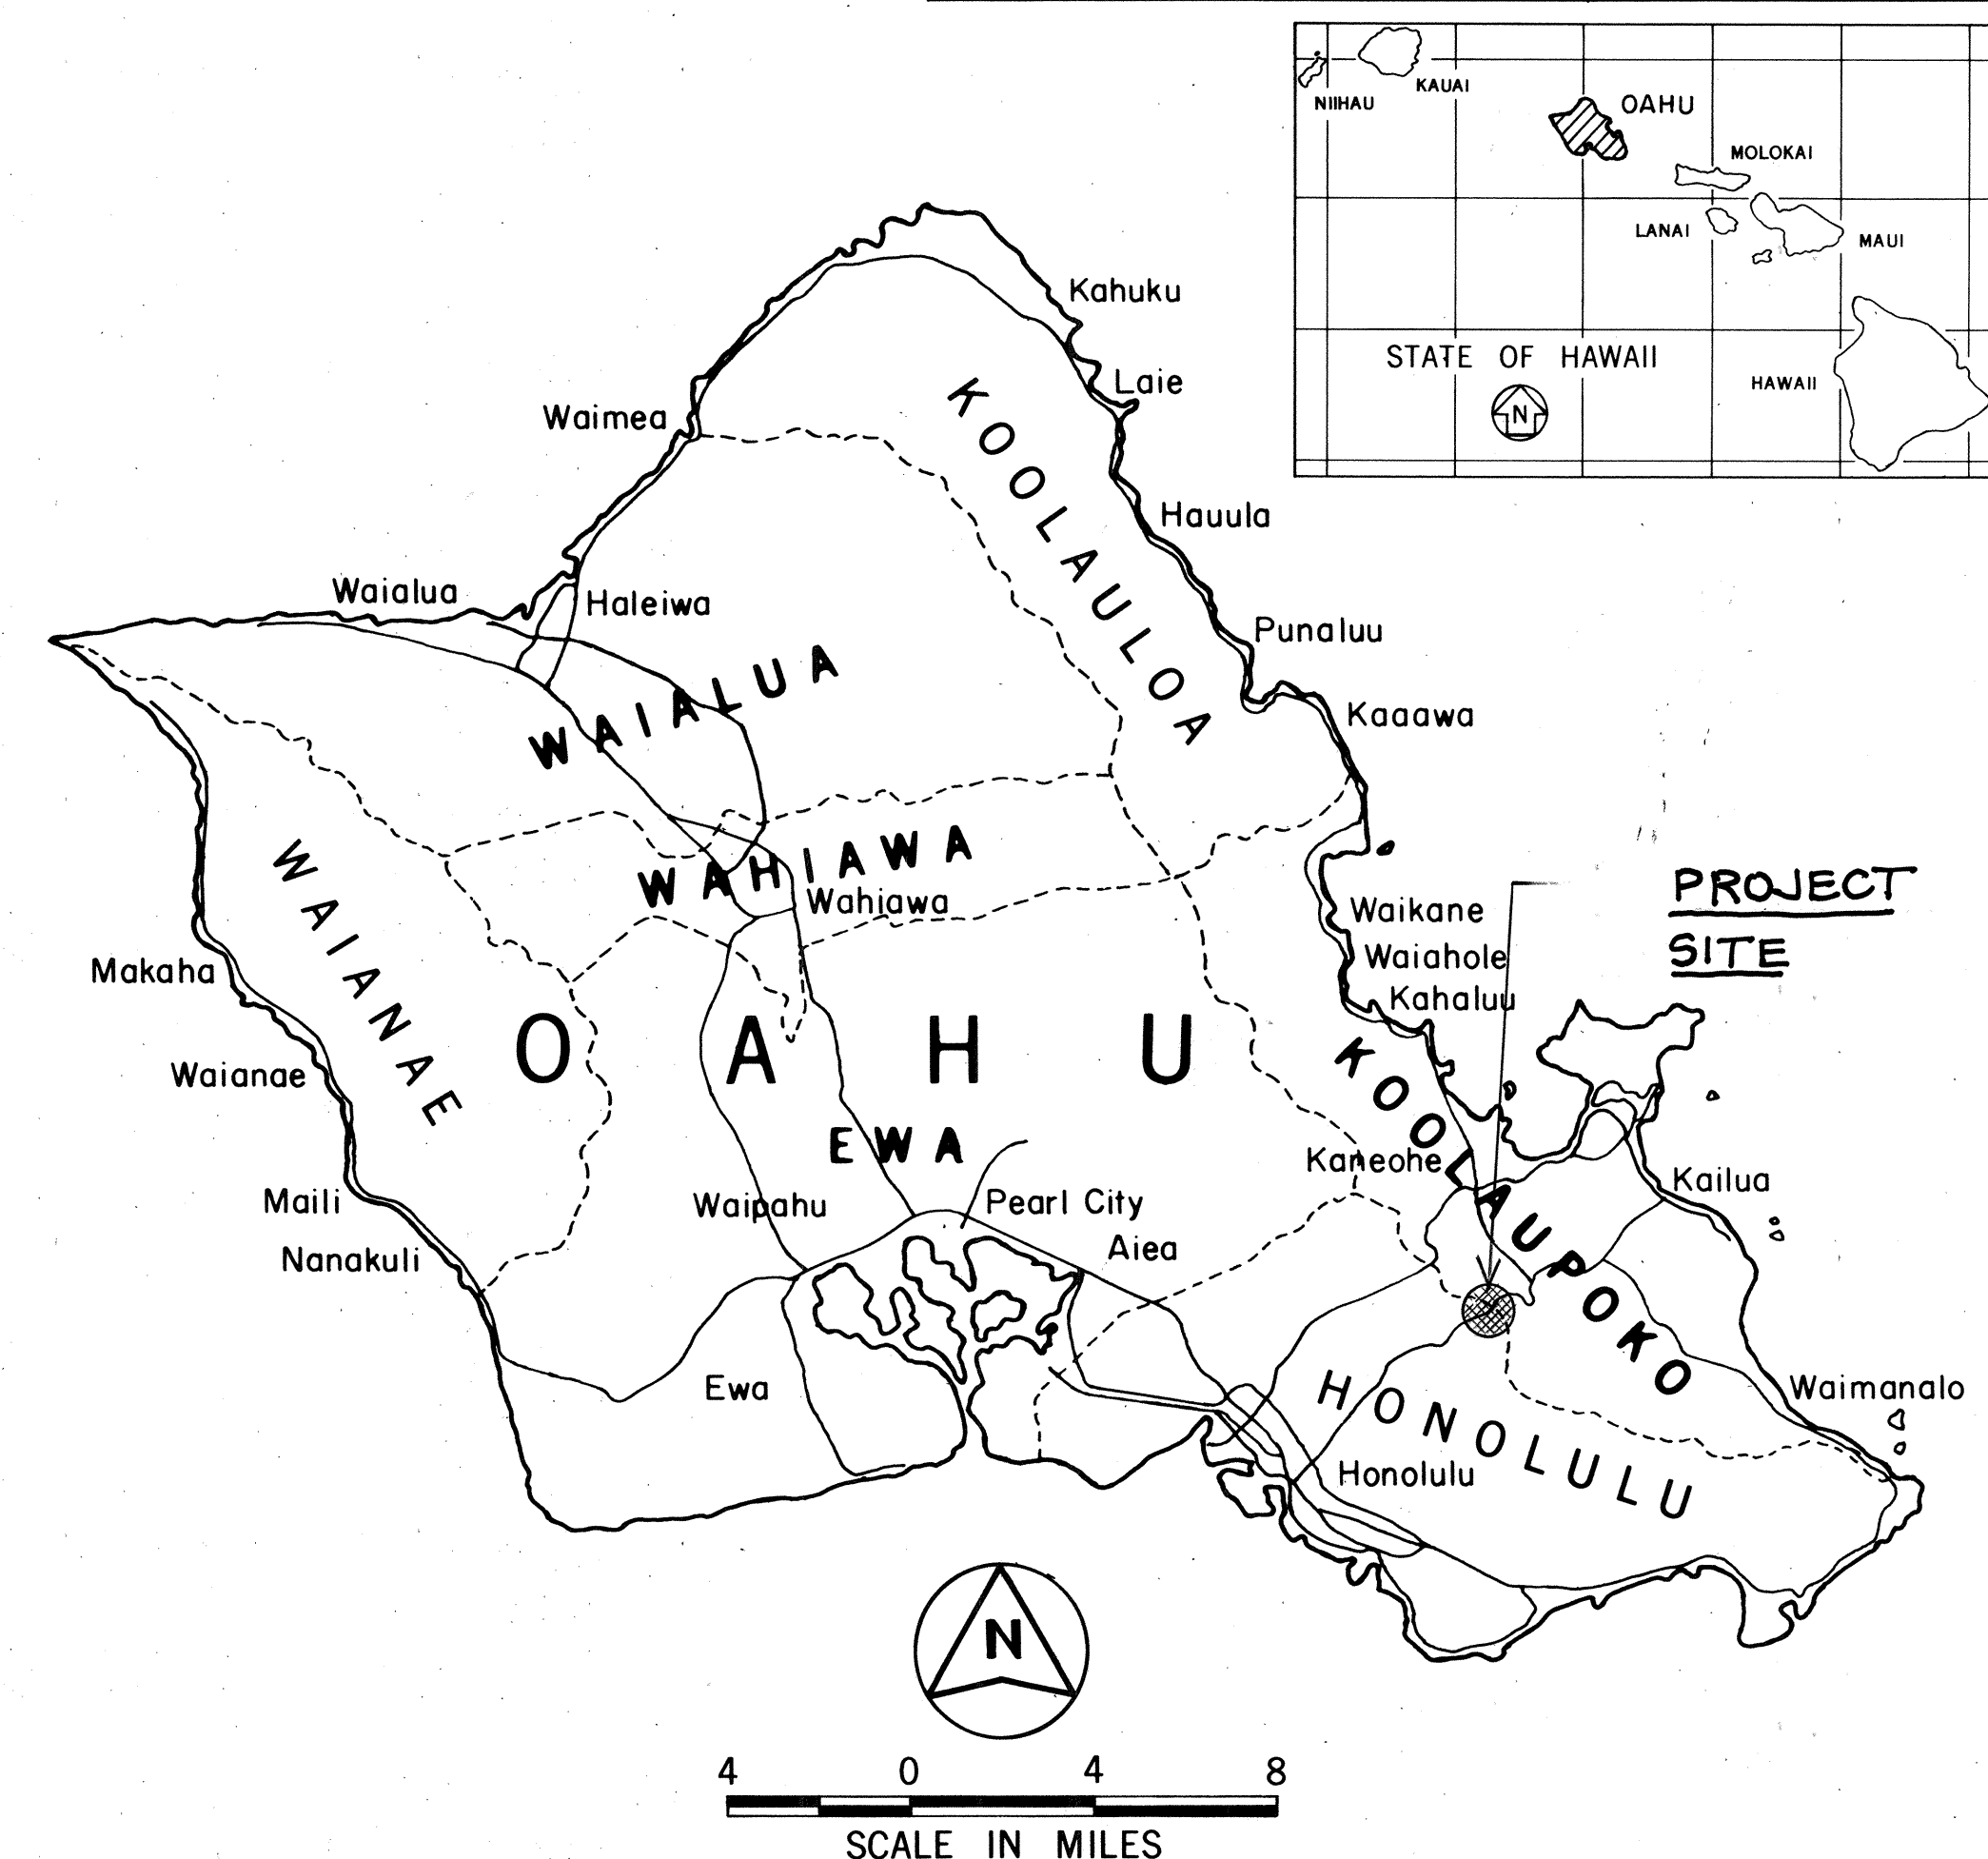

CHANGES MADE DURING CONSTRUCTION HAVE
BEEN INCORPORATED ON THESE PLANS EXCEPT
CHANGES IN THE ORIGINAL THEORETICAL
QUANTITIES. FOR ACTUAL QUANTITIES, REFER TO
PROJECT LEDGER AND/OR COMPUTATION BOOK.

Sidney S. C. Fee
RESIDENT ENGINEER

7/13/92
DATE

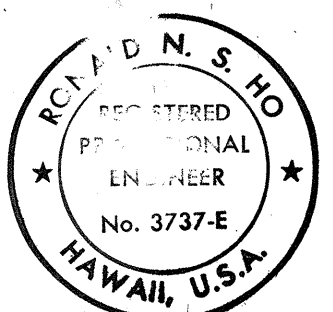

THIS WORK WAS PREPARED BY ME
OR UNDER MY SUPERVISION.
Ronald R. [Signature]
12/30/87

DEPARTMENT OF TRANSPORTATION
STATE OF HAWAII

APPROVED: Edward J. Hunt 1/27/88
DIR. OF TRANSPORTATION DATE

SHEET 1 OF 29 SHEETS