




FED. ROAD DIST. NO.	STATE	FED. AID PROJ. NO.	FISCAL YEAR	SHEET NO.	TOTAL SHEETS
HAWAII	HAW.	61B-01-88M	1988	55-1	5

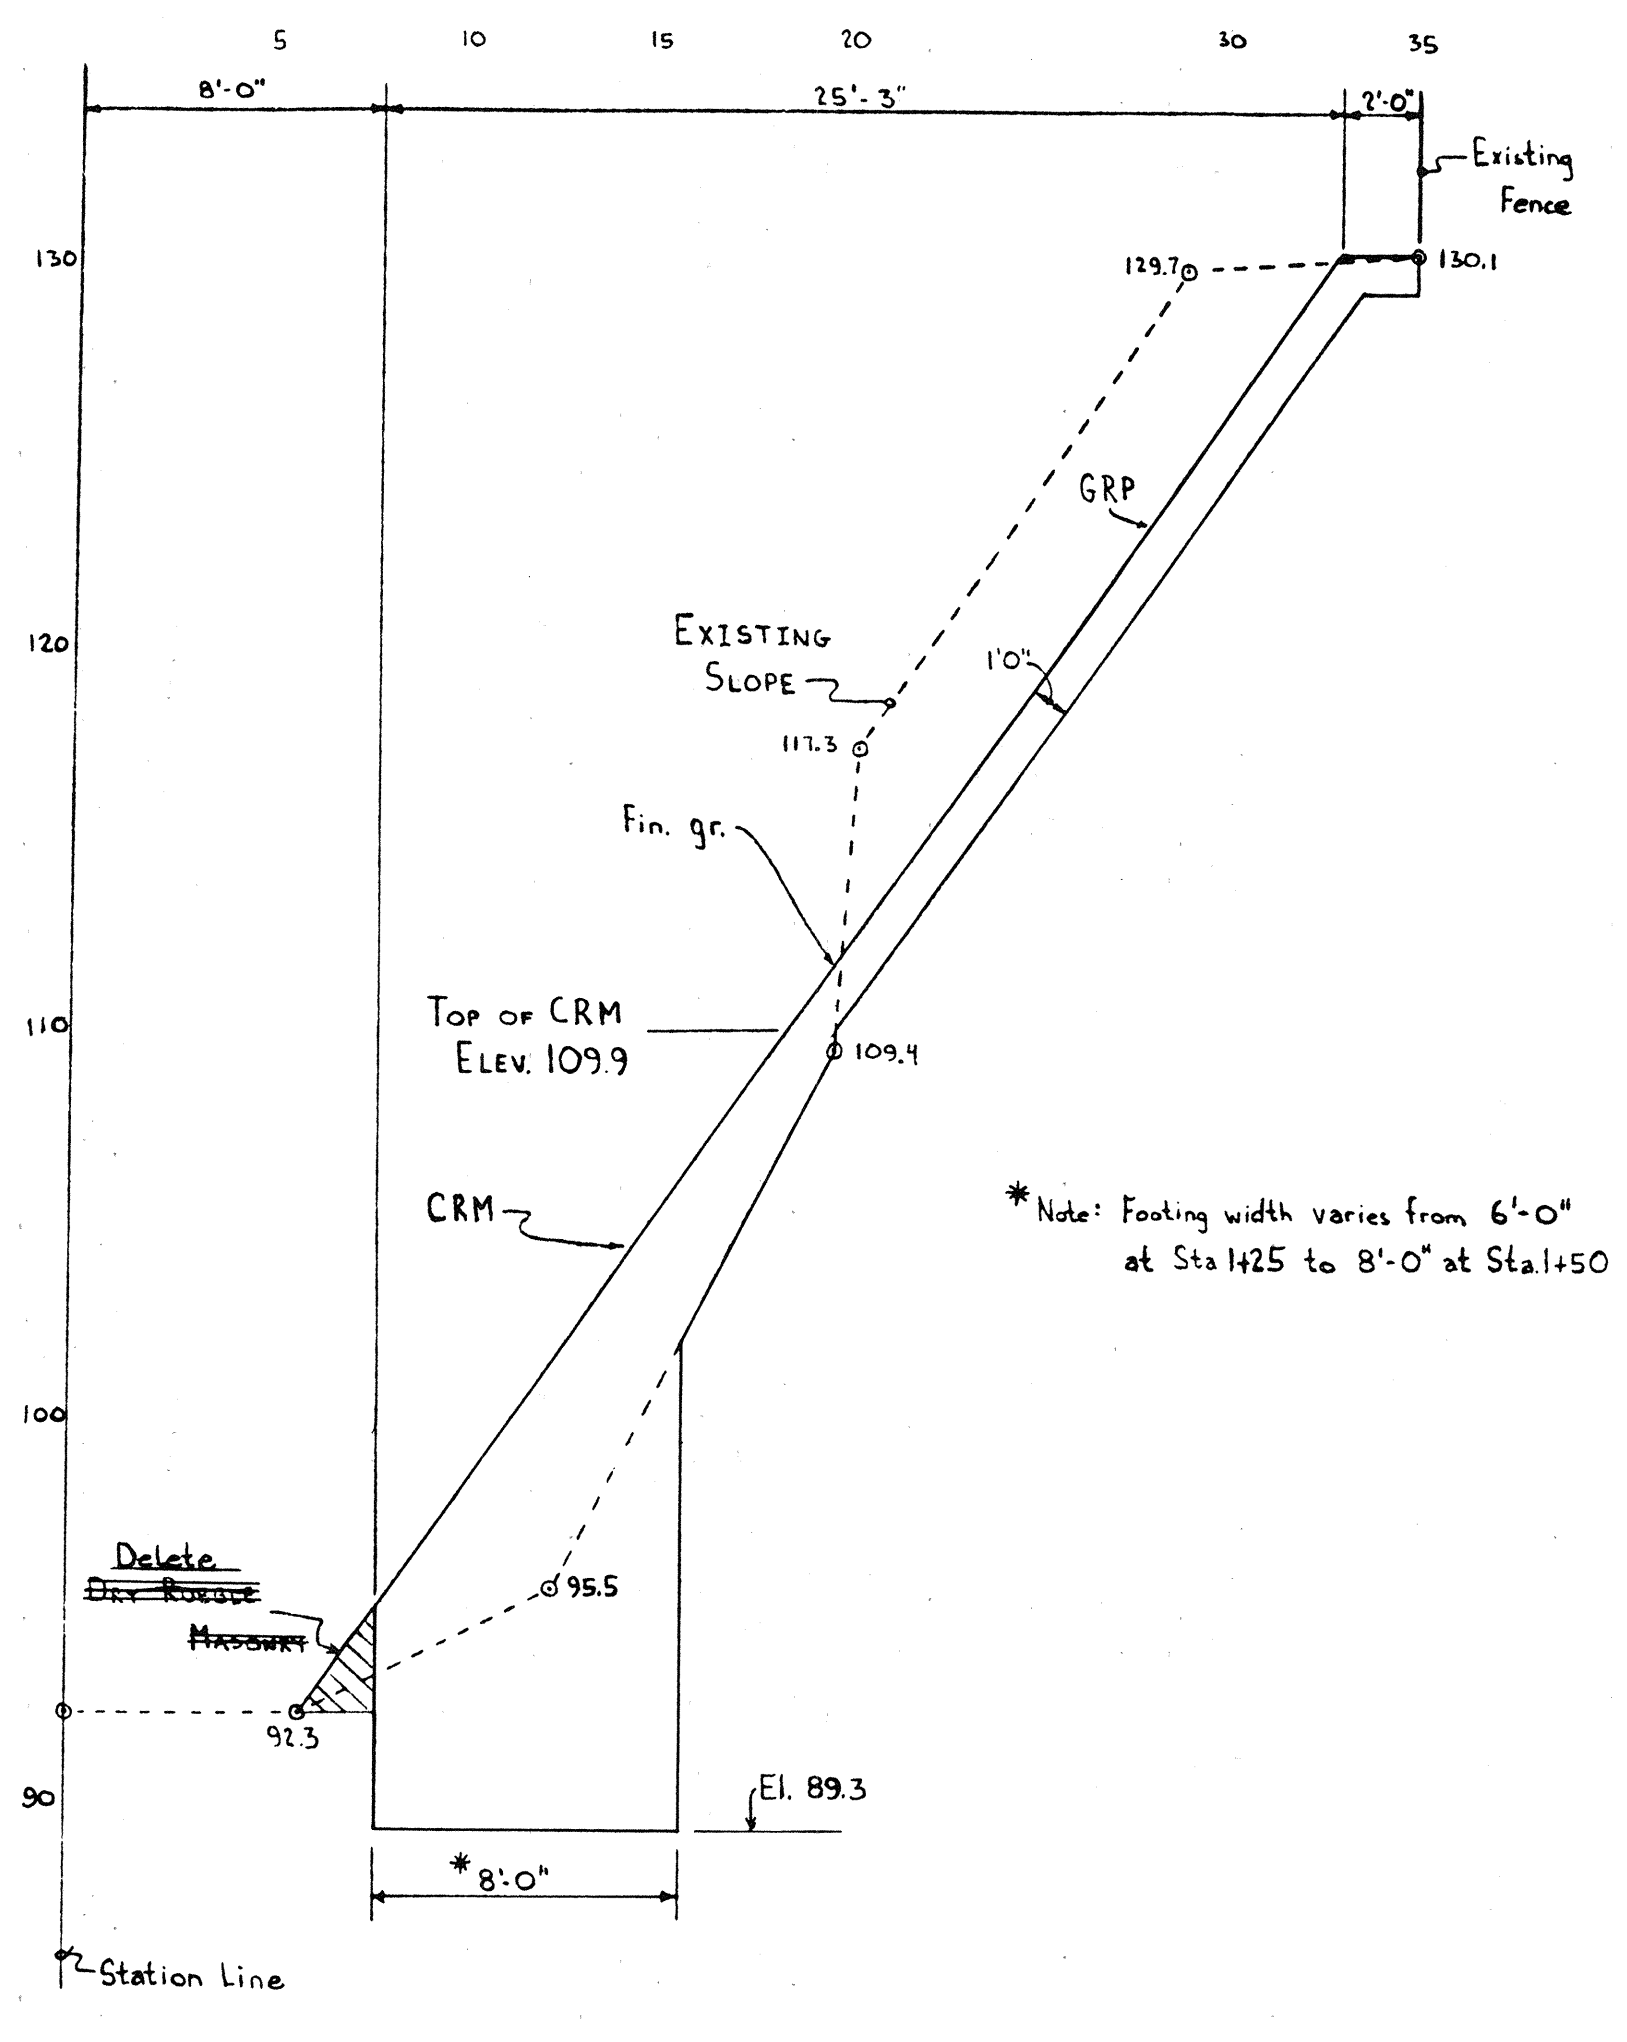

AT STA. 1+50

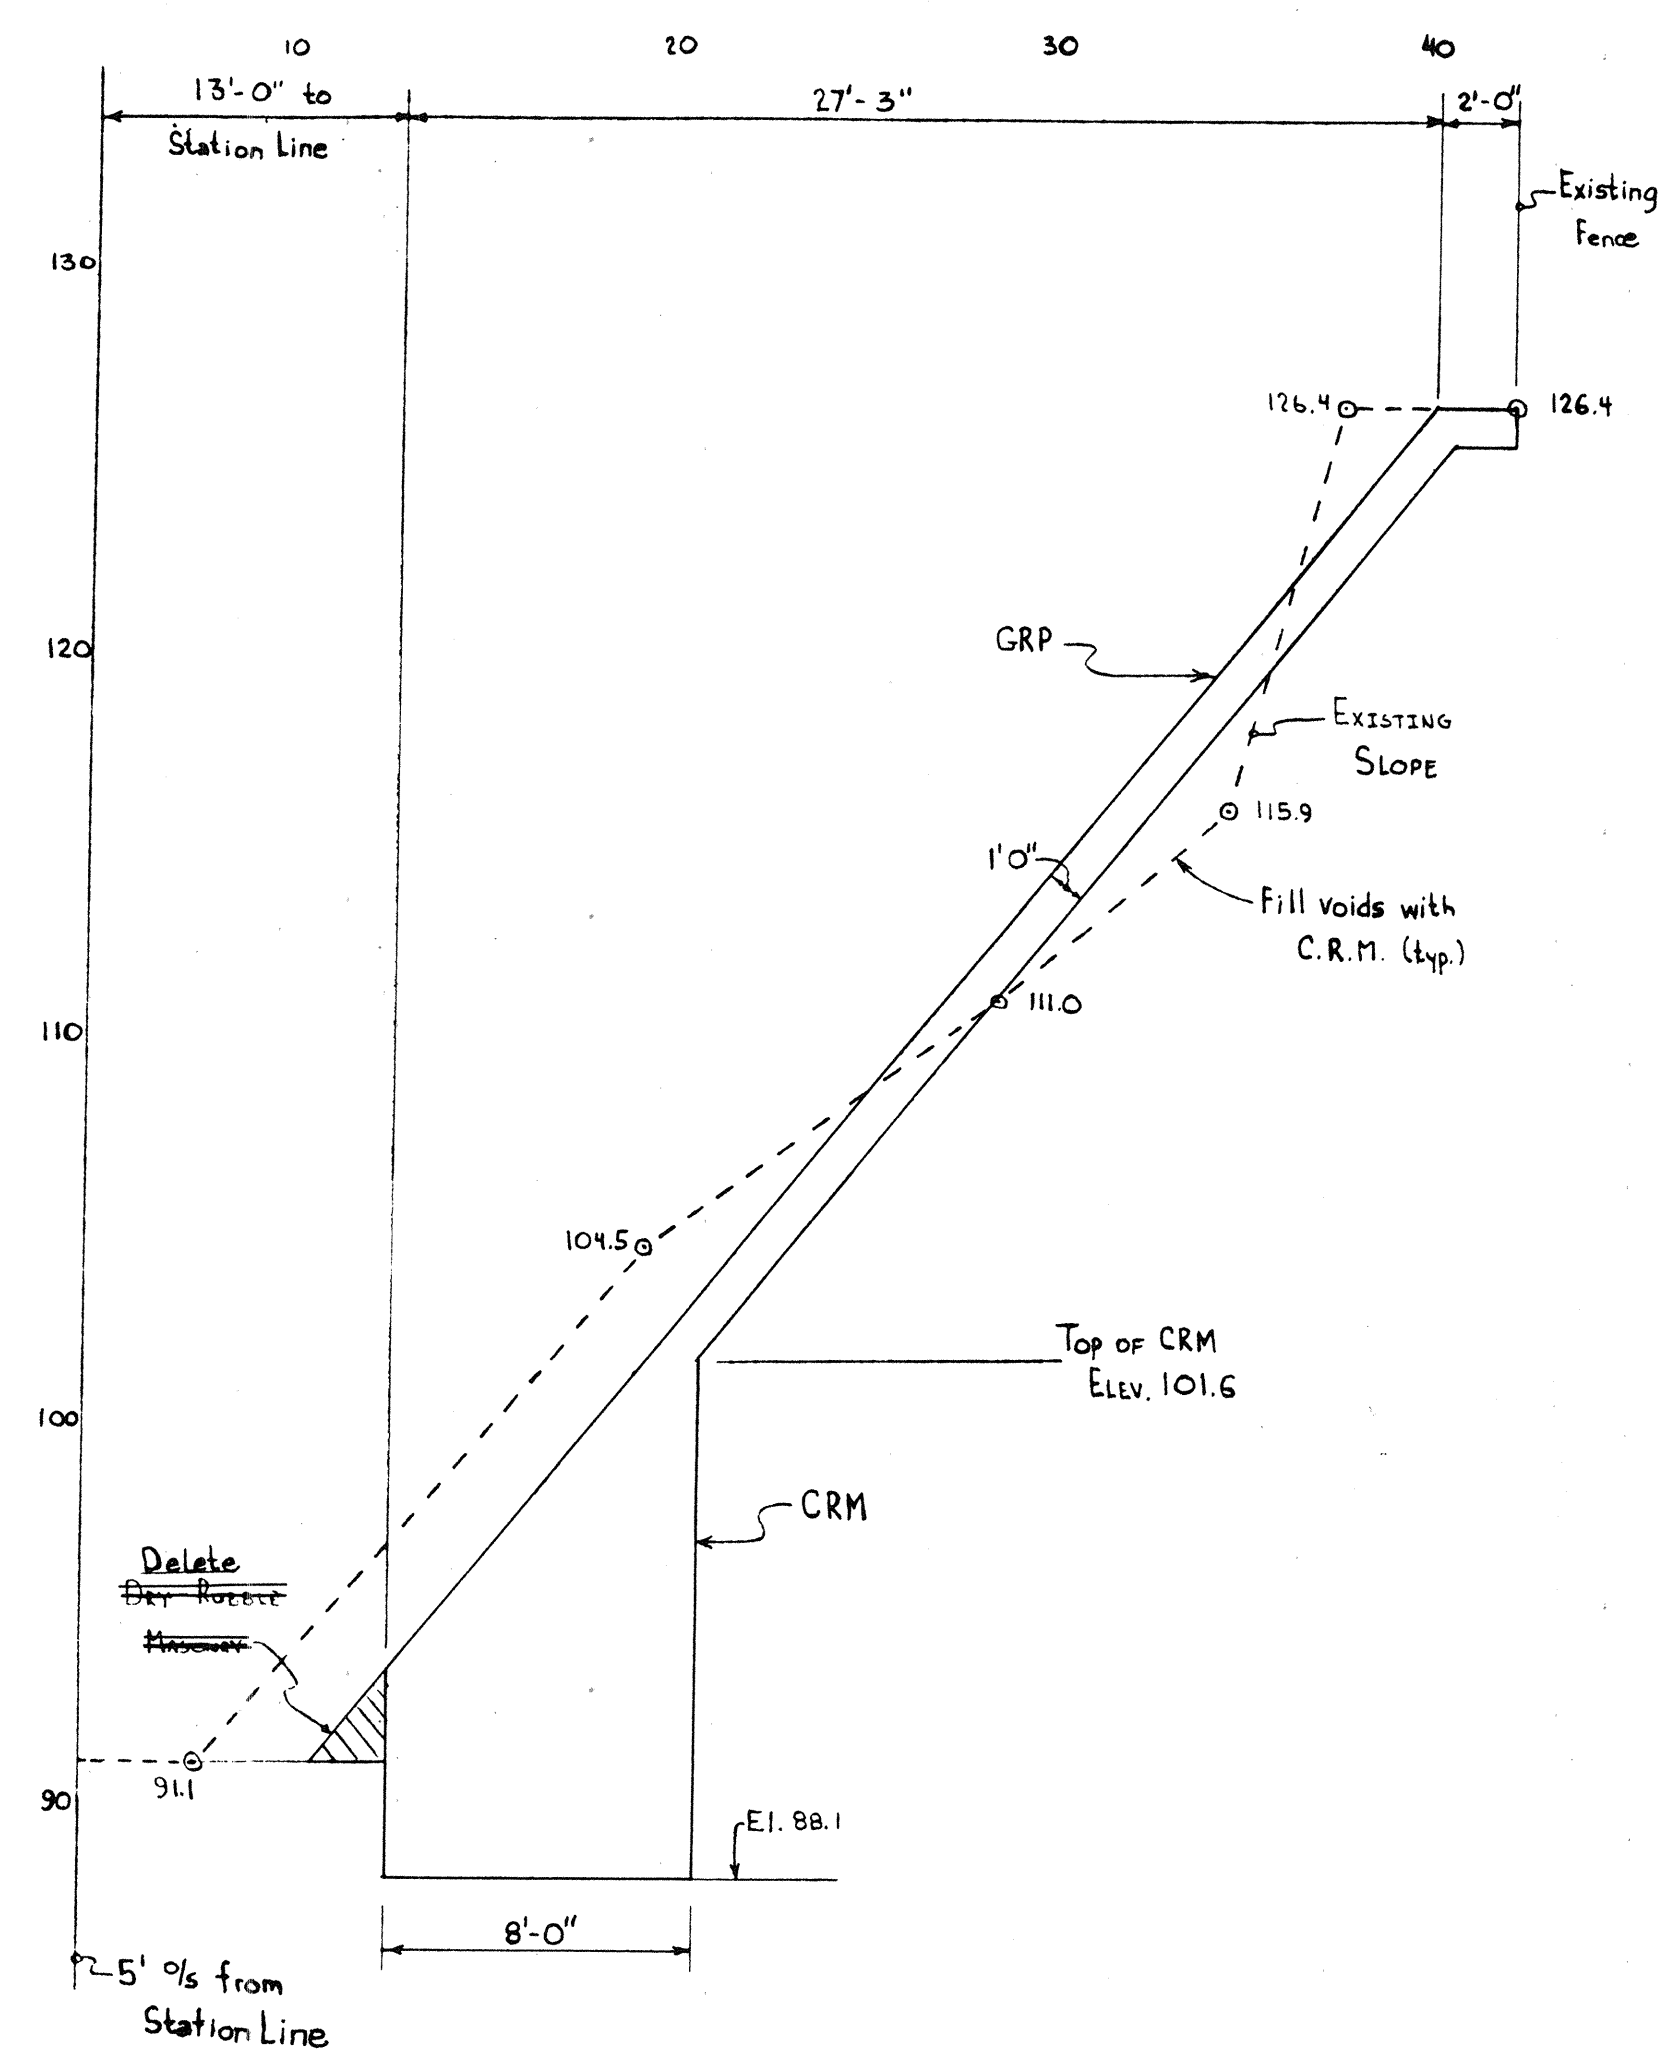


AT STA. 1+75

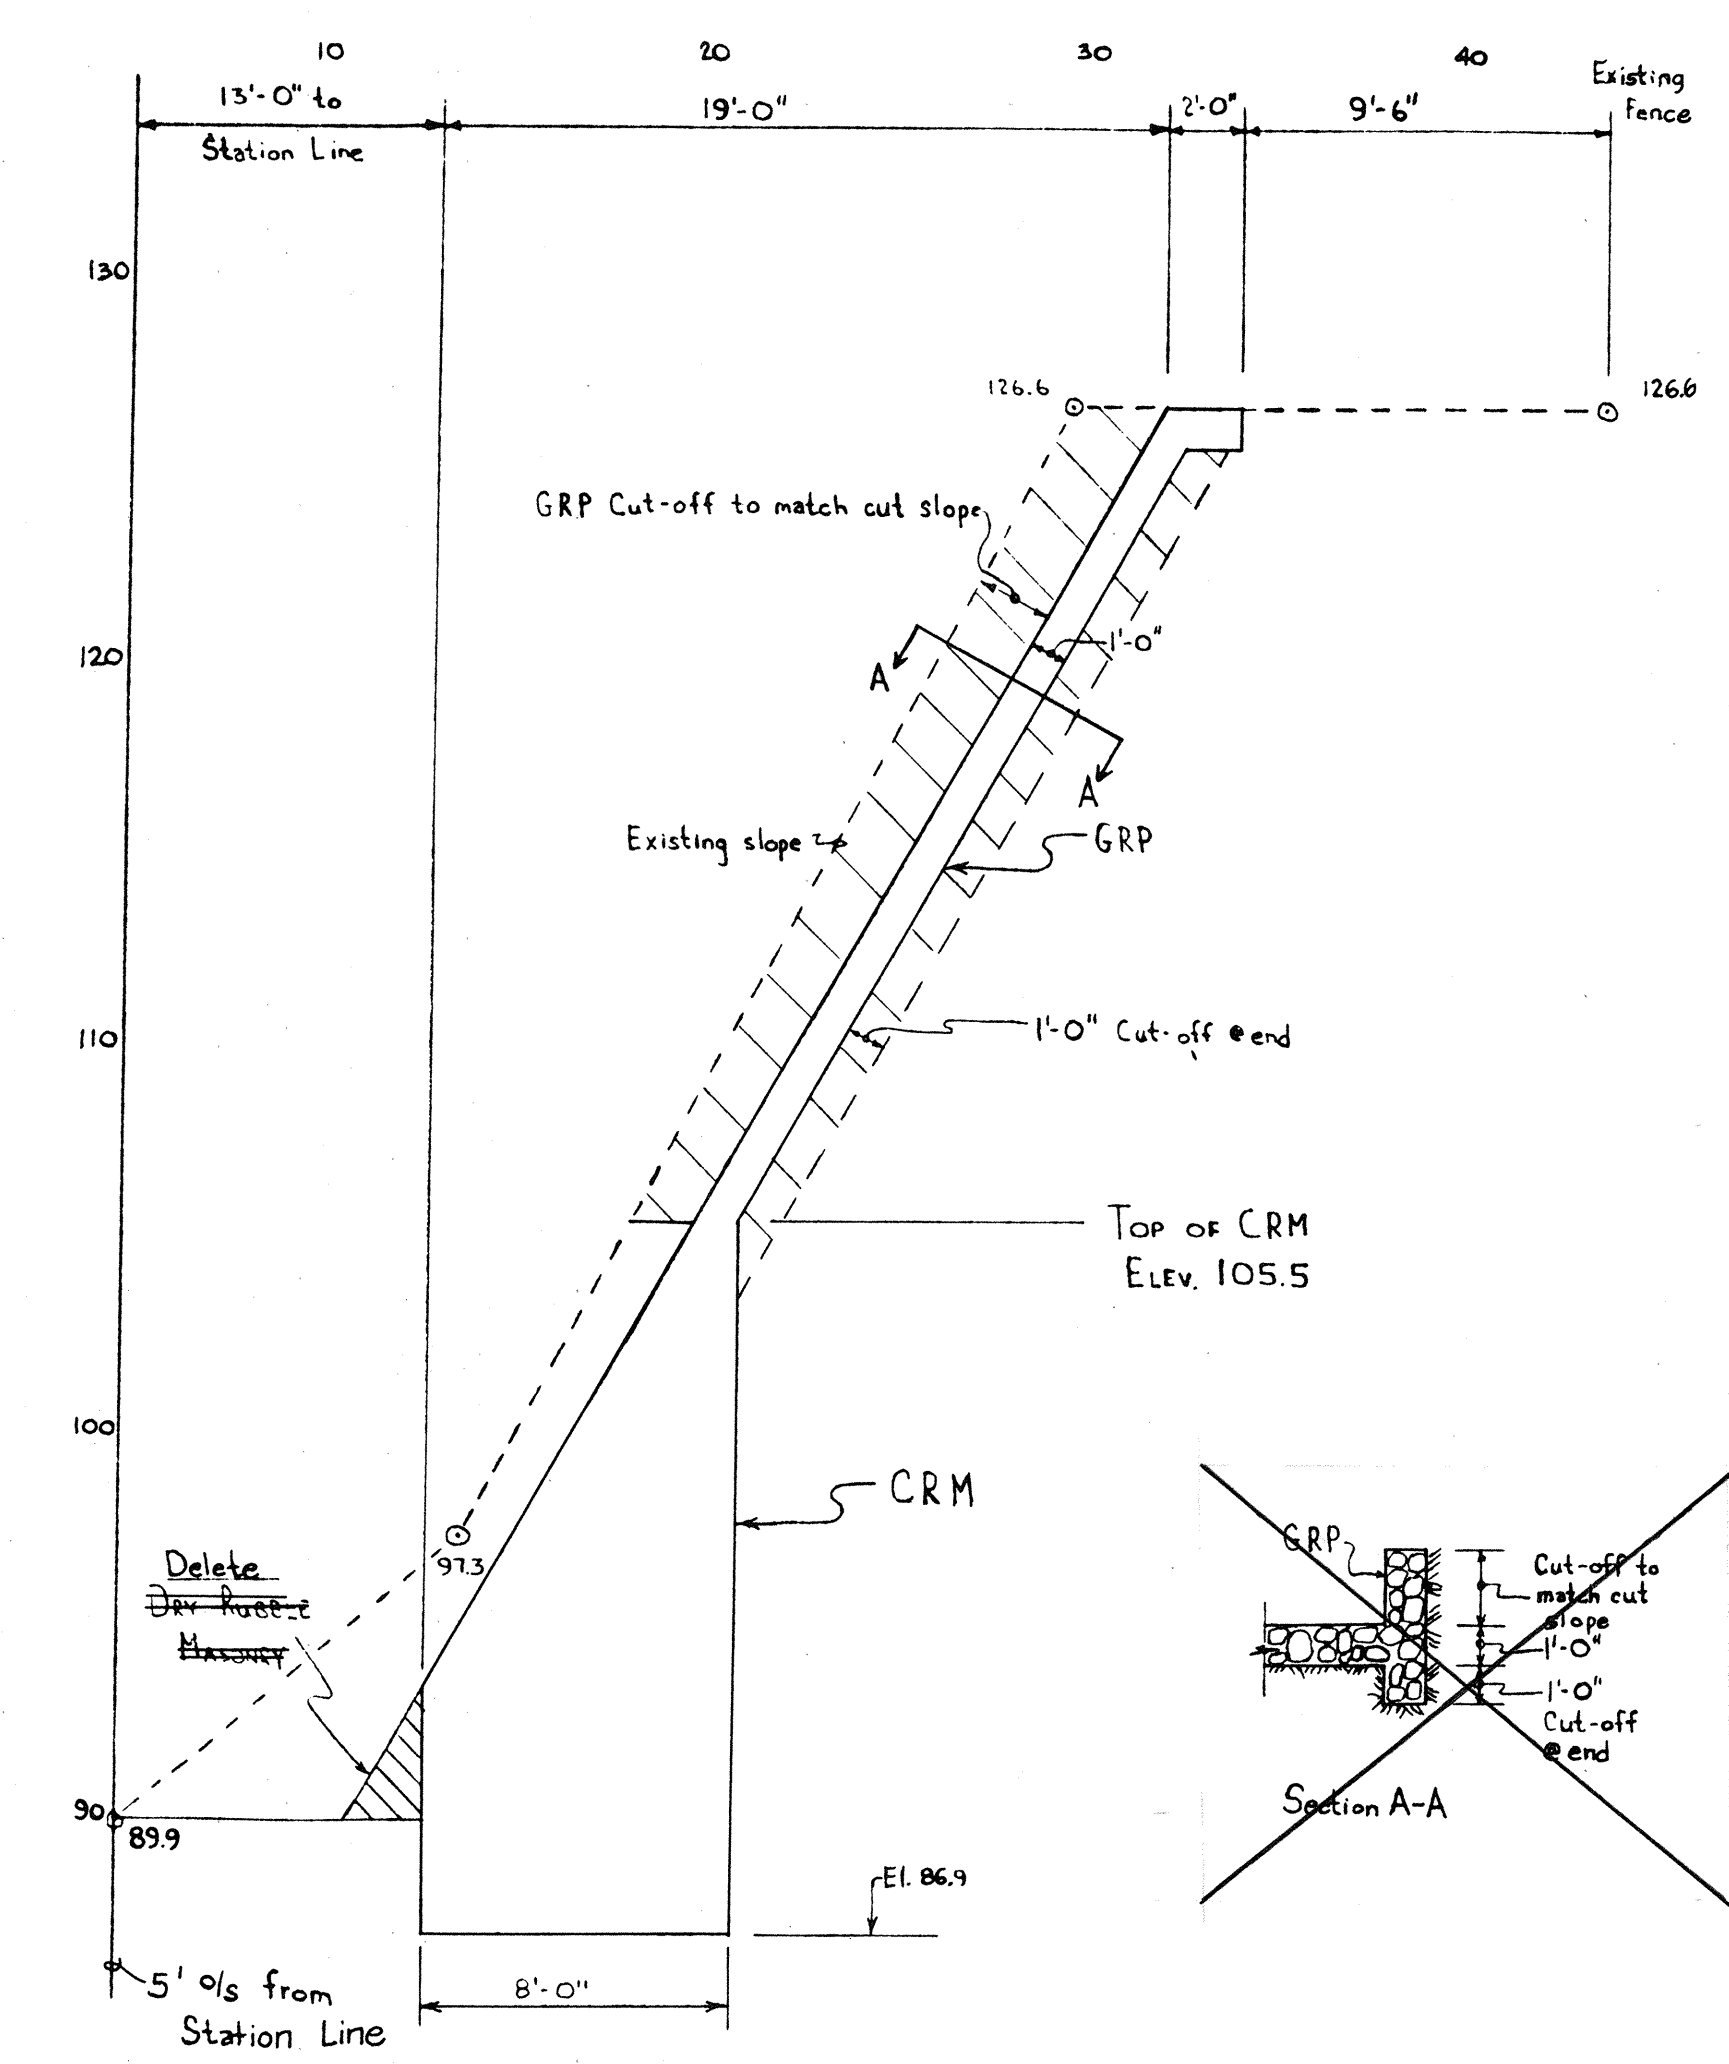

AT STA. 1+95

SECTIONS THRU CRM & GRP
Scale: 1" = 5'-0"

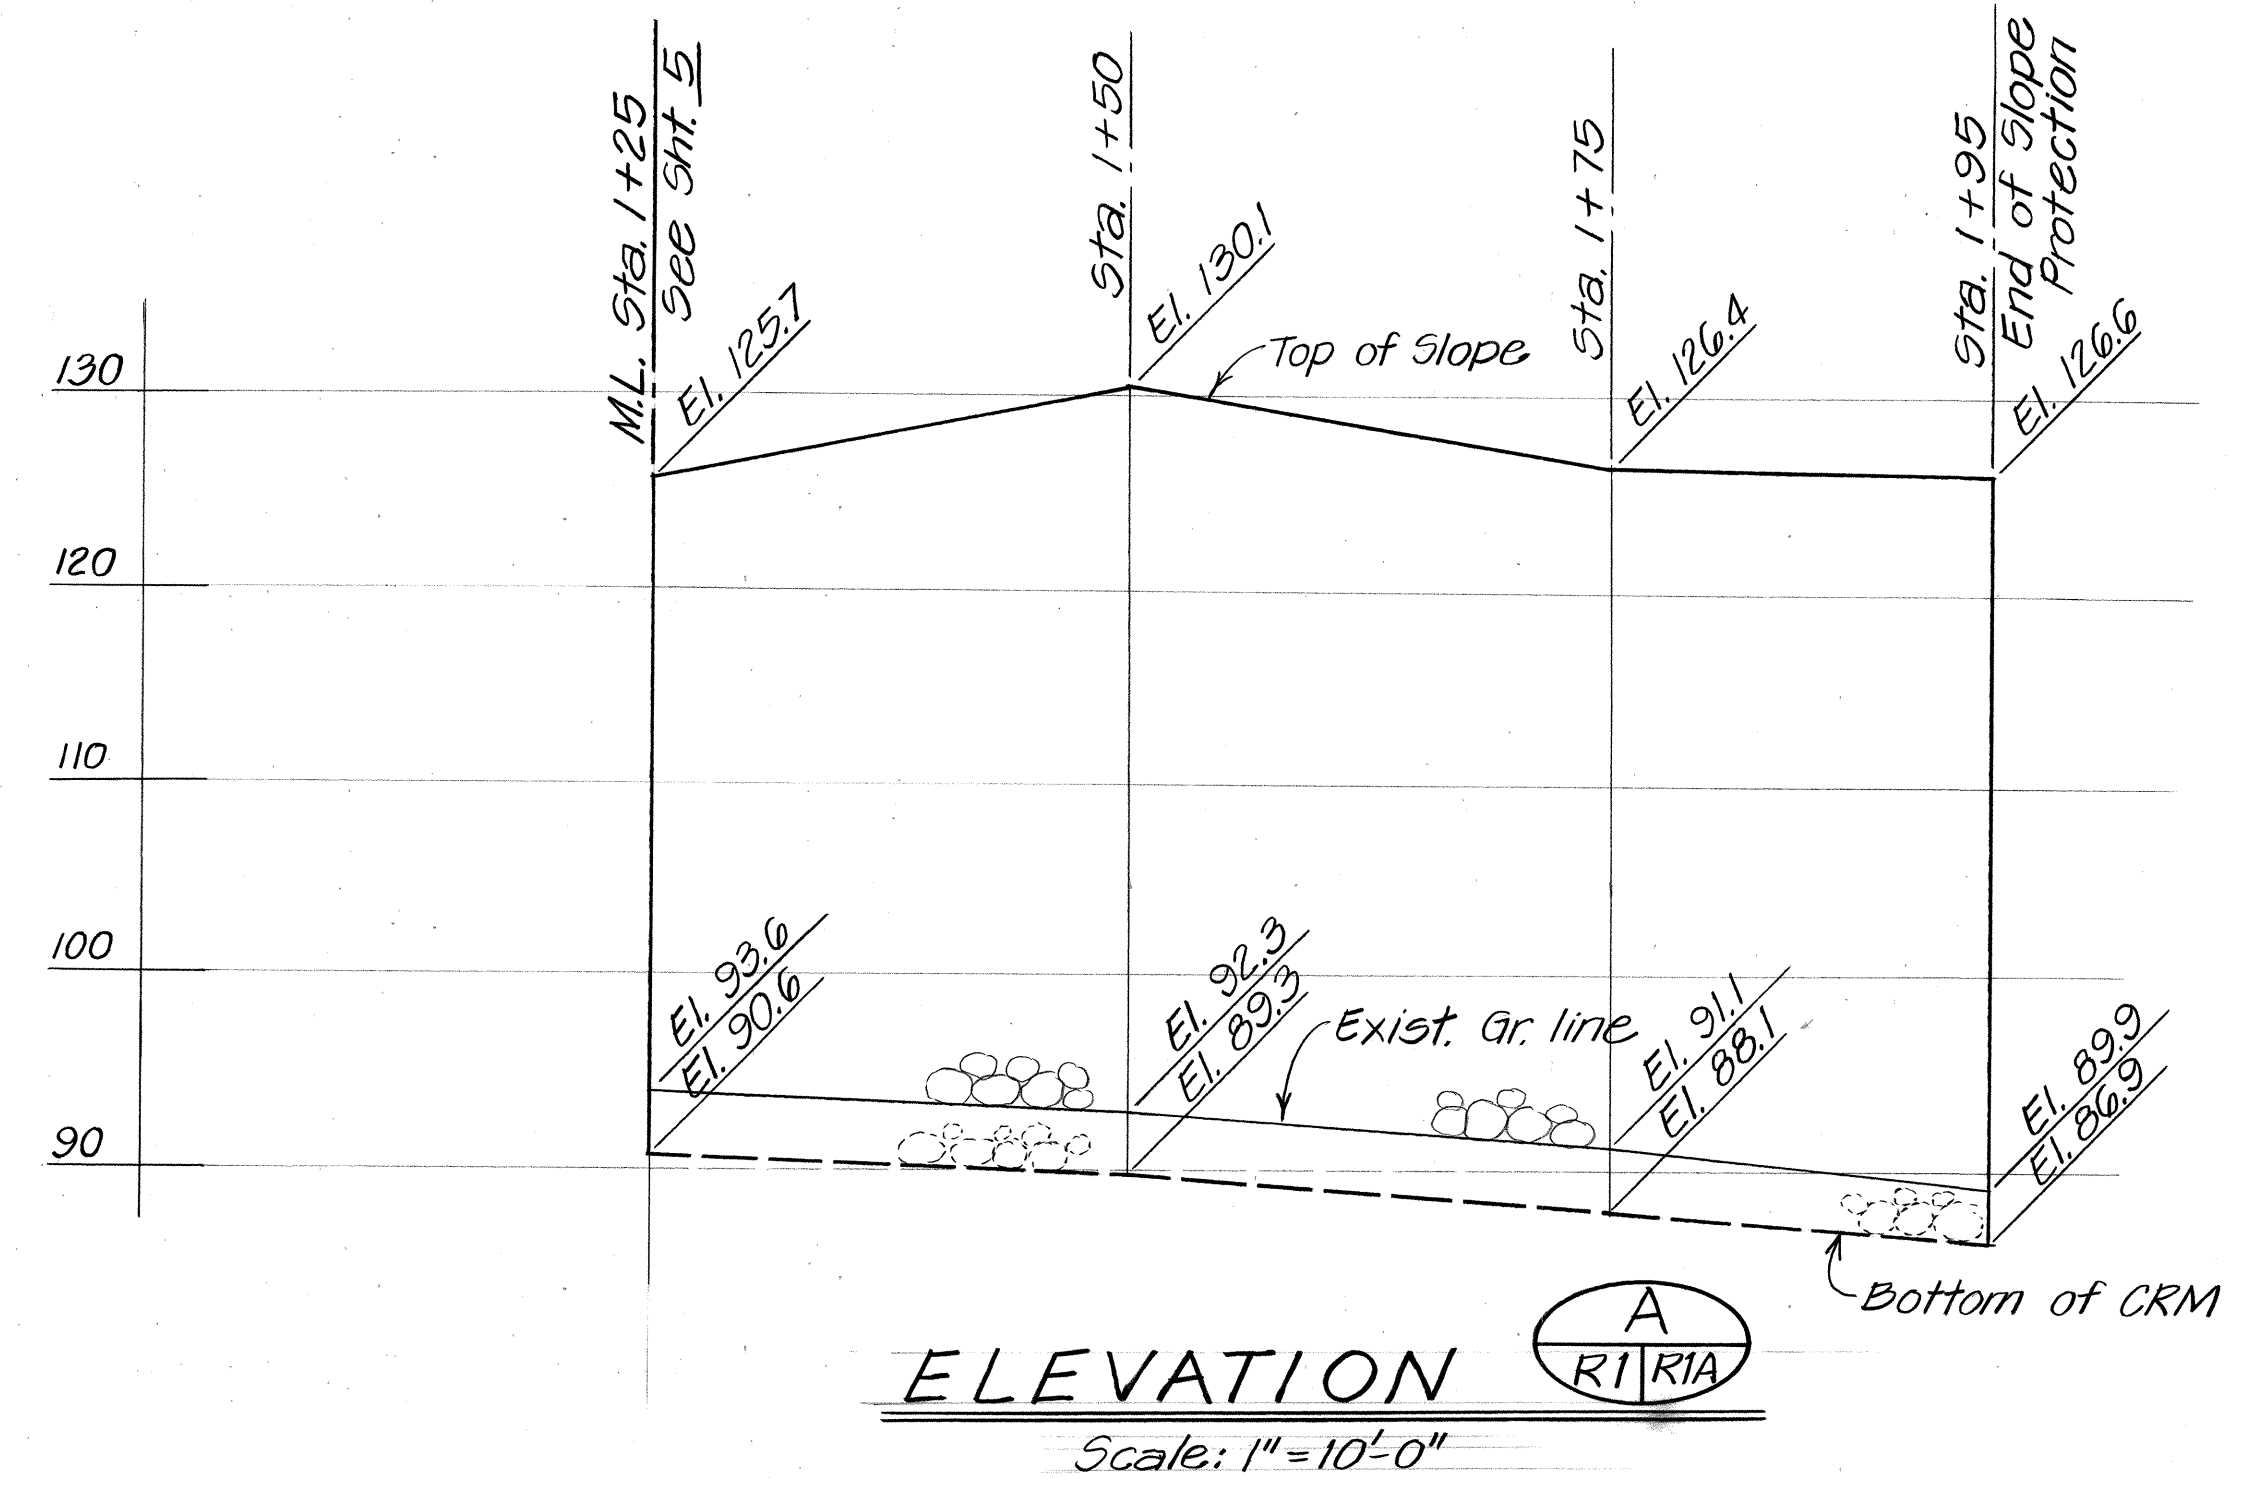

ELEVATION
Scale: 1" = 10'-0"

NOTE:
This Tracing was added during "As-Built" posting.

STATE OF HAWAII
DEPARTMENT OF TRANSPORTATION
HIGHWAYS DIVISION

SLOPE PROTECTION

KALANIANA'OLE HIGHWAY
AND ULUHALA STREET

Project No. 61B-01-88M
Scale: As Shown Date: June 1990
SHEET No. R1A OF 1 SHEETS