	INDEX TO DRAWINGS
SHEET NO.	DESCRIPTION
	TITLE SHEET
2	STANDARD PLANS SUMMARY
3	CRM REVETMENT - VICINITY OF
	KAPENA FALLS BRIDGE
4	DRAINAGE DETAILS
5	SLOPE PROTECTION - VICINITY OF
	ULUHALA STREET
:	
·	
	·
;	
:	

STATE OF HAWAII

DEPARTMENT OF TRANSPORTATION

HIGHWAYS DIVISION HONOLULU, HAWAII

"AS-BUILT" PLANS FOR

HIGHWAY


CRM REVETMENT IN THE VICINITY OF KAPENA FALLS BRIDGE PROJECT NO. 61A-01-88M

> DISTRICT OF HONOLULU ISLAND OF OAHU

> > AND

KALANIANAOLE HIGHWAY CRM SLOPE PROTECTION IN THE VICINITY OF ULUHALA STREET PROJECT NO. 61B-01-88M

> DISTRICT OF KOOLAUPOKO ISLAND OF OAHU

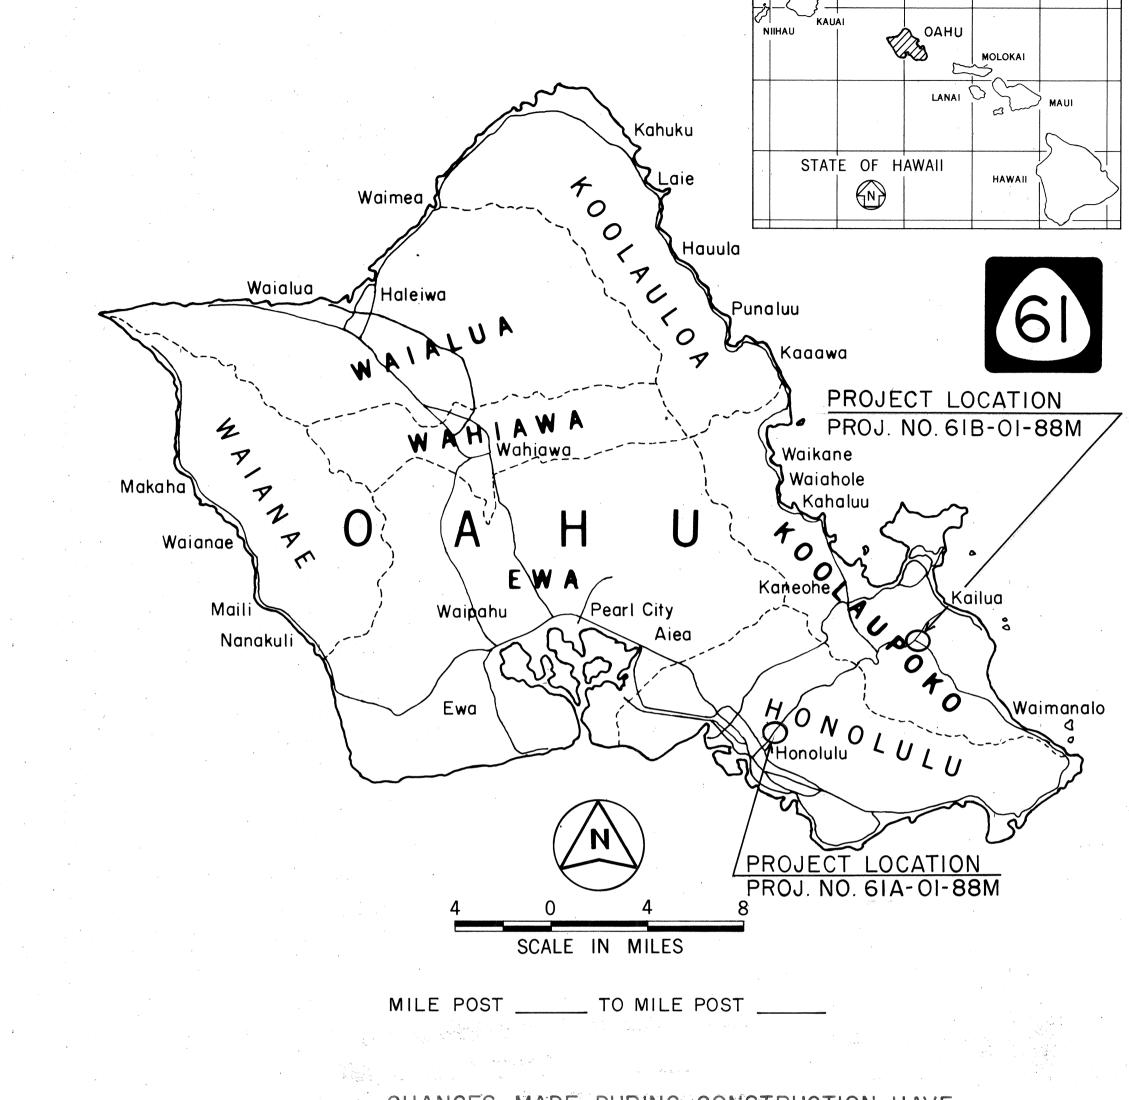

FED. ROAD DIST. NO.


CHANGES MADE DURING CONSTRUCTION HAVE BEEN INCORPORATED ON THESE PLANS EXCEPT CHANGES IN THE ORIGINAL THEORETICAL QUANTITIES. FOR ACTUAL QUANTITIES, REFER TO PROJECT LEDGER AND/OR COMPUTATION BOOK.


Warren S. Muyashus RESIDENT ENGINEER

7-24-90 DATE

FISCAL SHEET YEAR NO.

PROJ. NO. YEAR
6/A-0/-88M
6/B-0/-88M

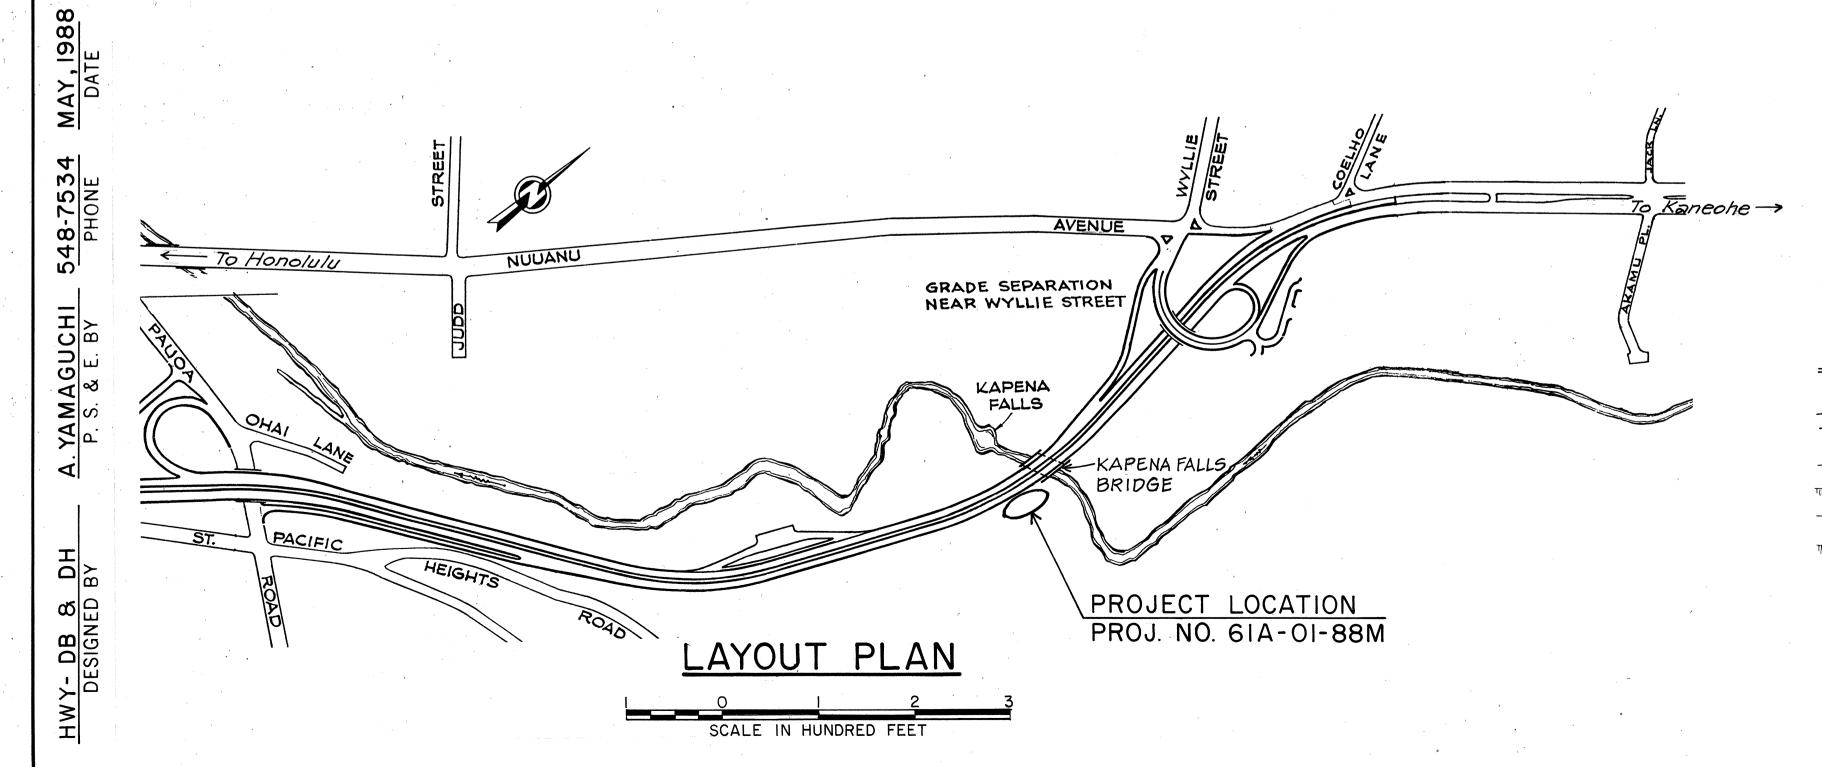

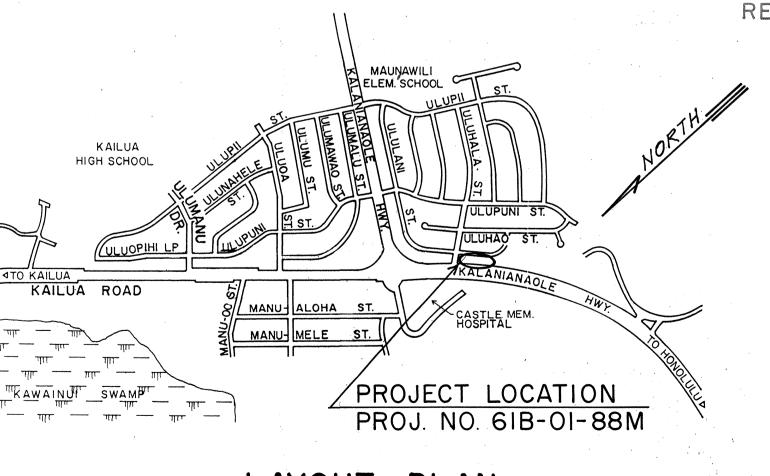

LAYOUT PLAN SCALE IN FEET

DEPARTMENT OF TRANSPORTATION STATE OF HAWAII APPROVED: