



FED. ROAD DIST. NO.	STATE	PROJ. NO.	FISCAL YEAR	SHEET NO.	TOTAL SHEETS
HAWAII	HAW.	61D-01-89M	1989	3	5

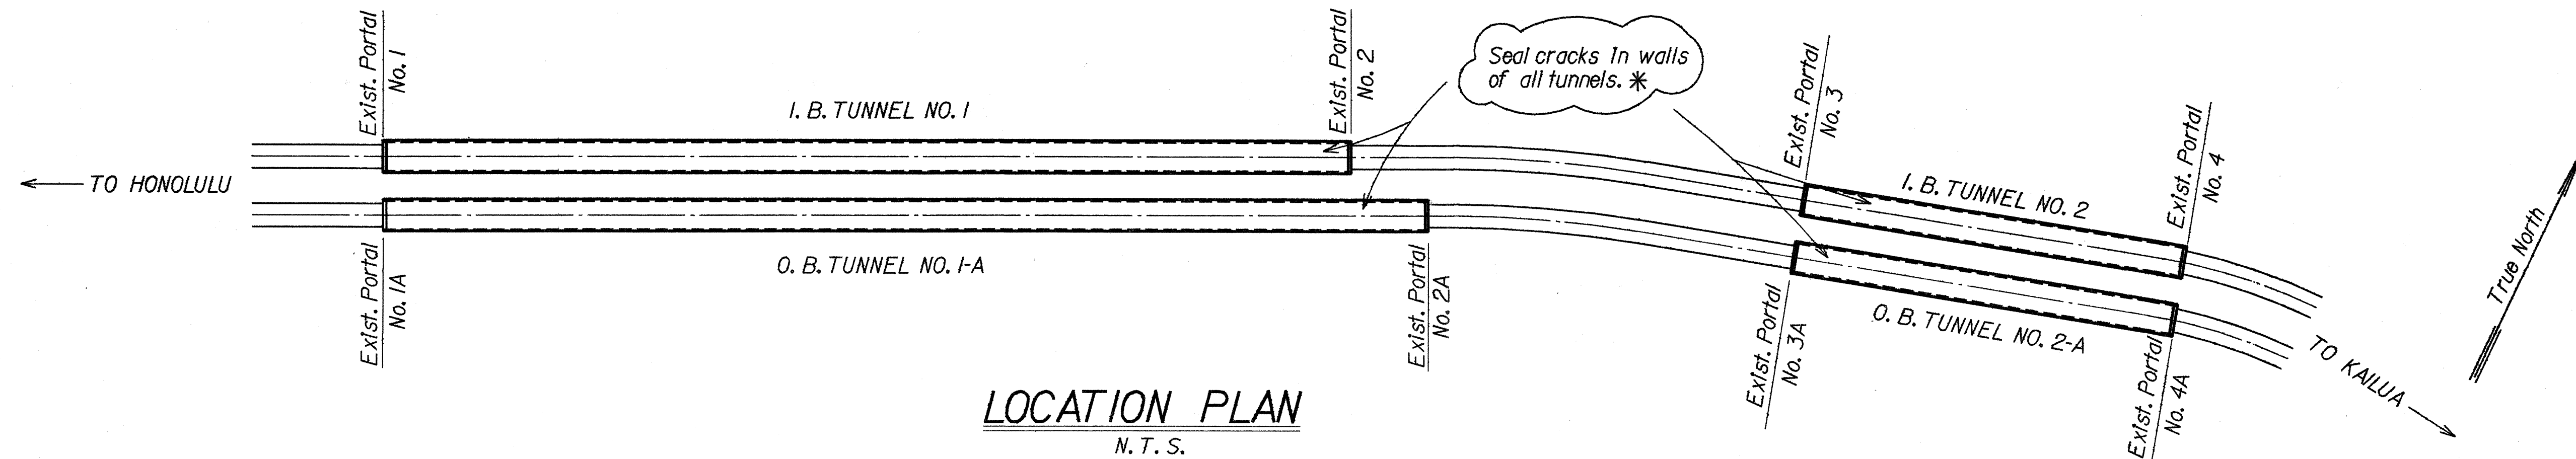


LOCATION PLAN
N. T. S.


* Cracks in Tunnel Nos. 1, 2, and 2-A sealed.
No work was done in Tunnel 1-A due to lack of funds.

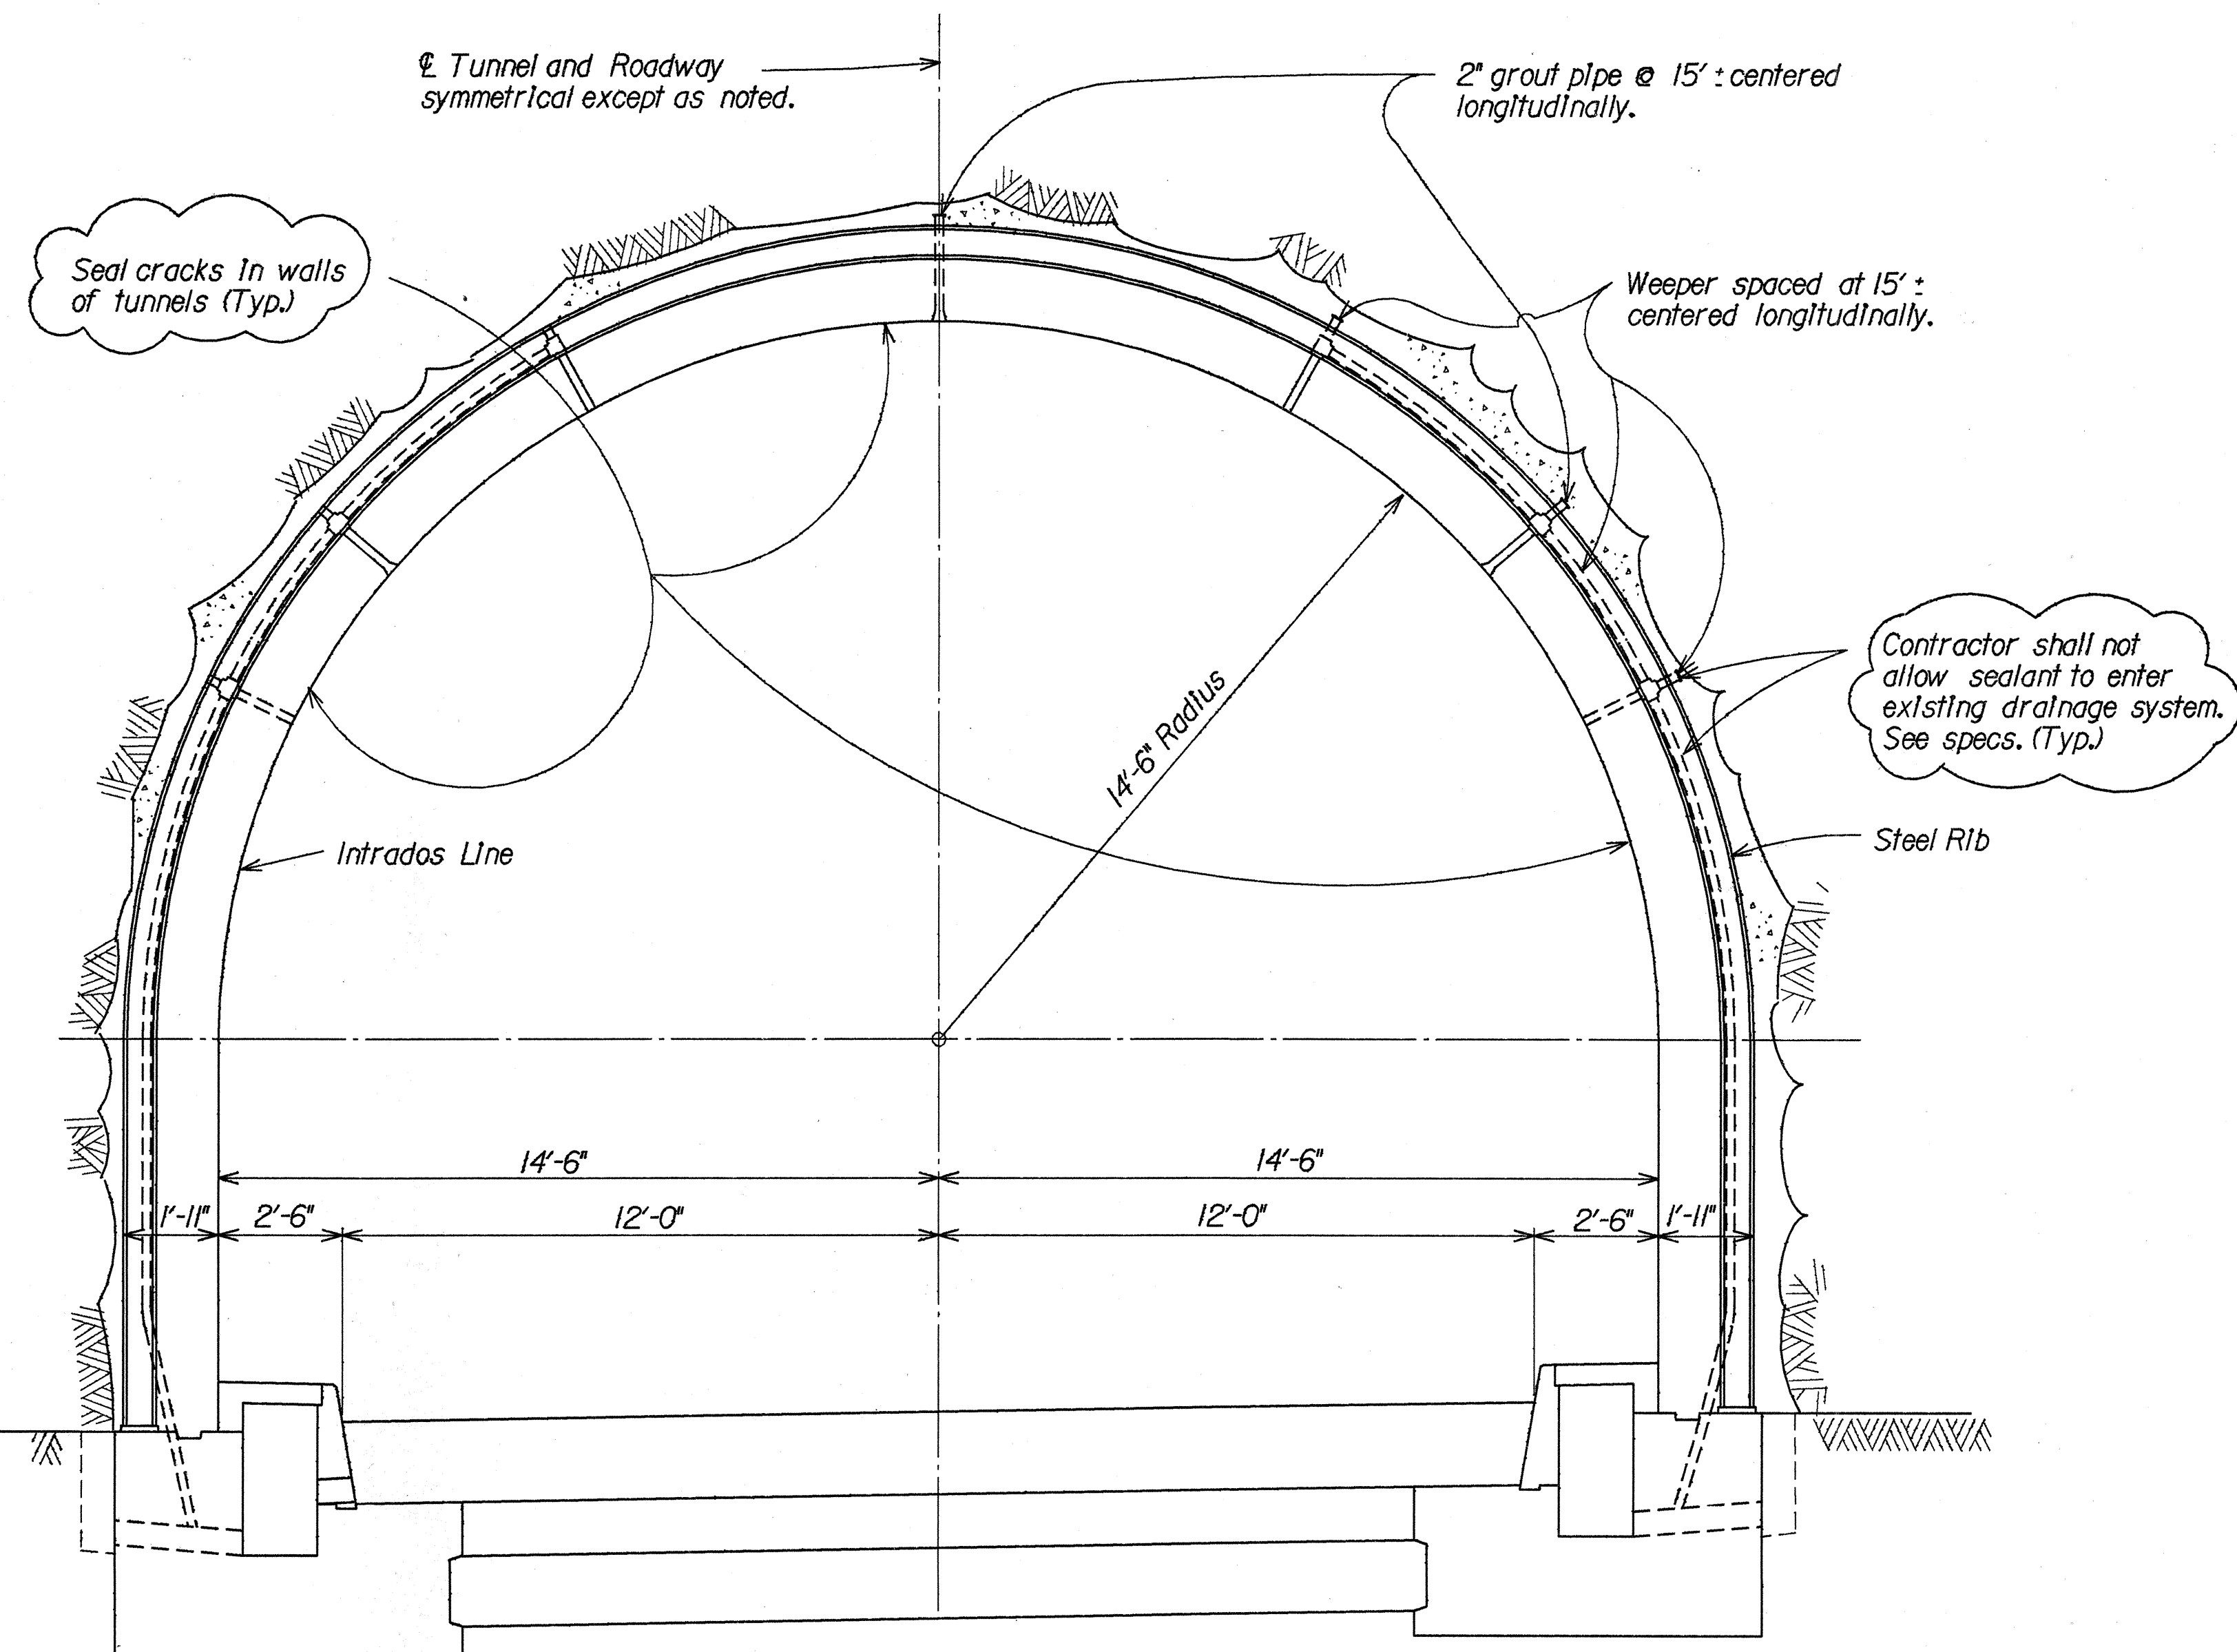


TYPICAL SECTION
Scale: 3/8"=1'-0"

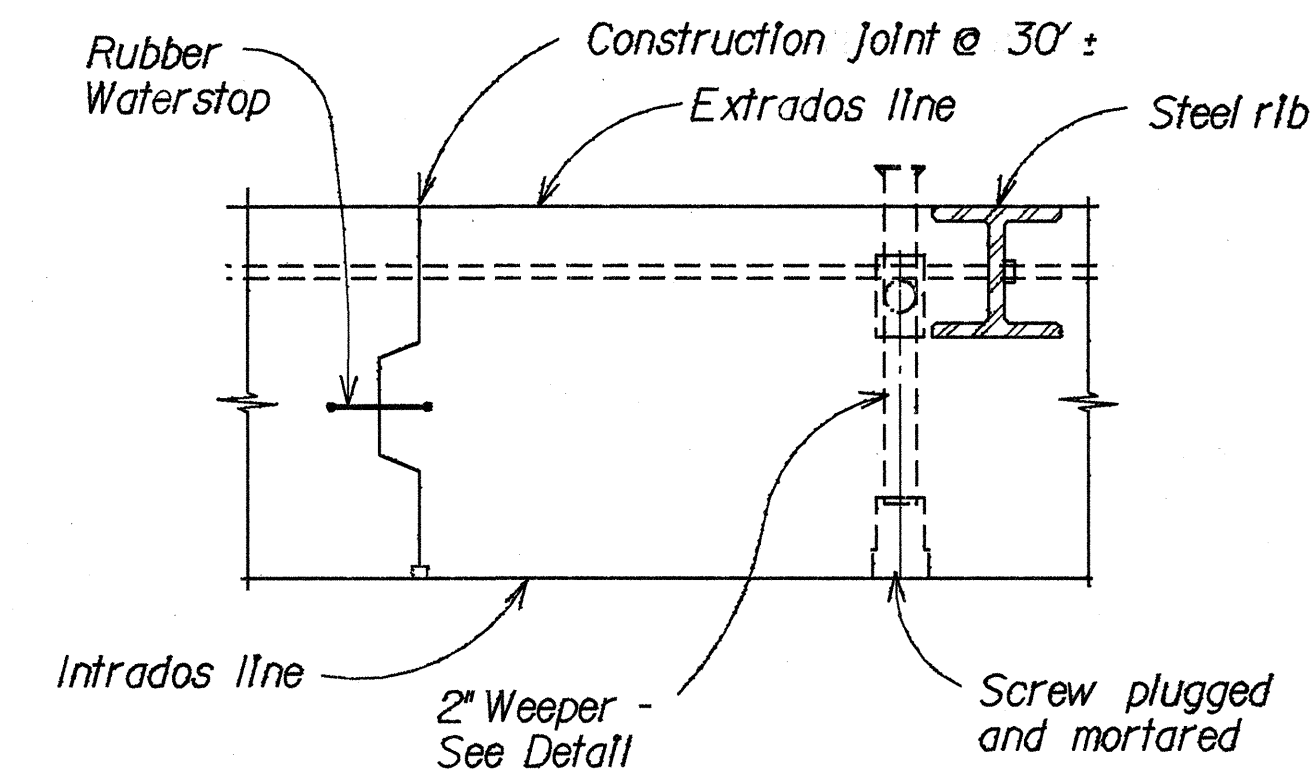


TRANSVERSE CONSTRUCTION JOINT
Scale: 1"=1'-0"

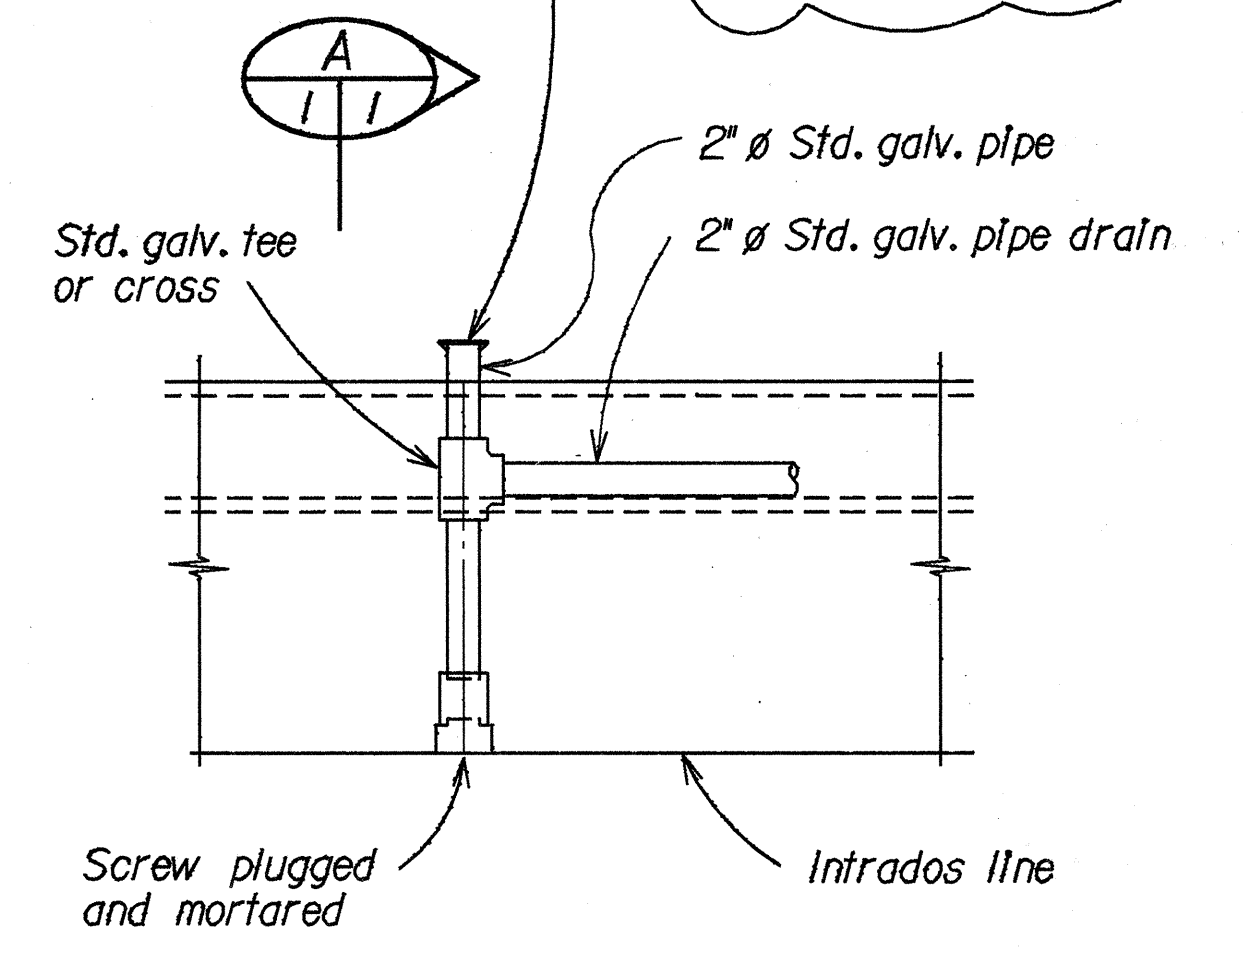

WEEPER DETAIL
Scale: 1"=1'-0"

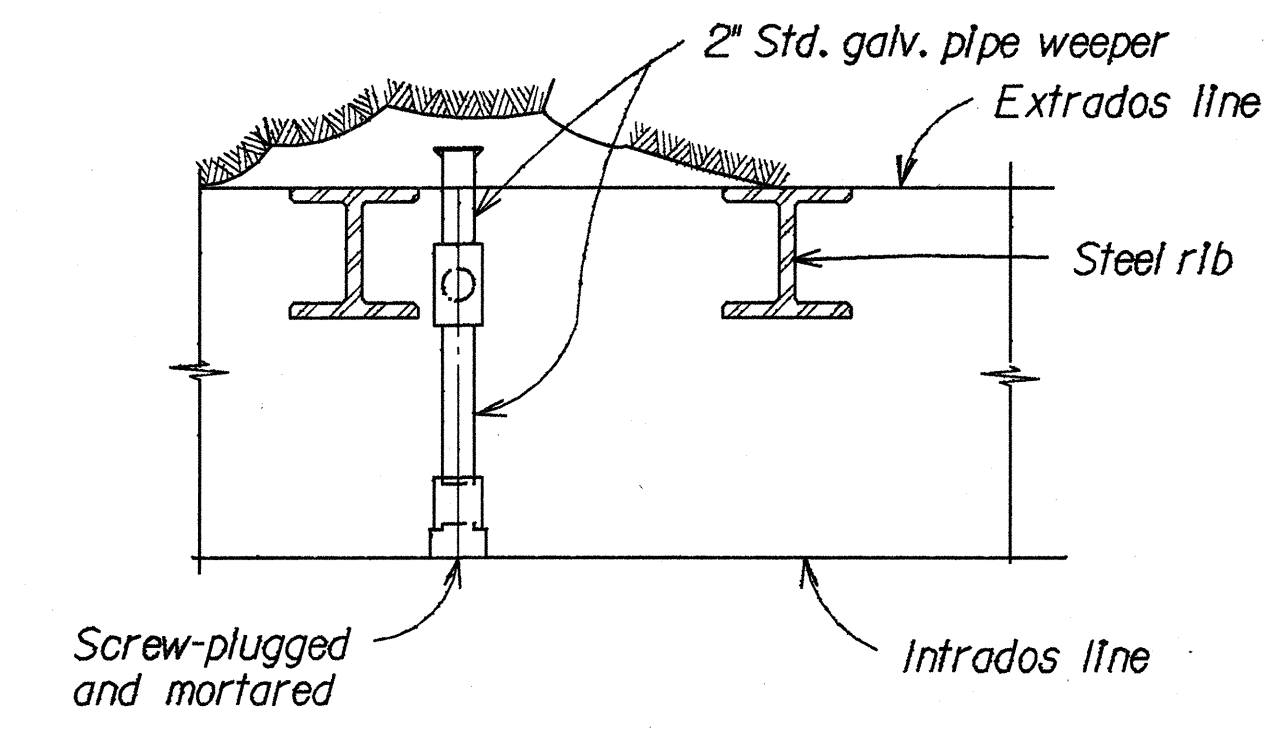

SECTION
Scale: 1"=1'-0"

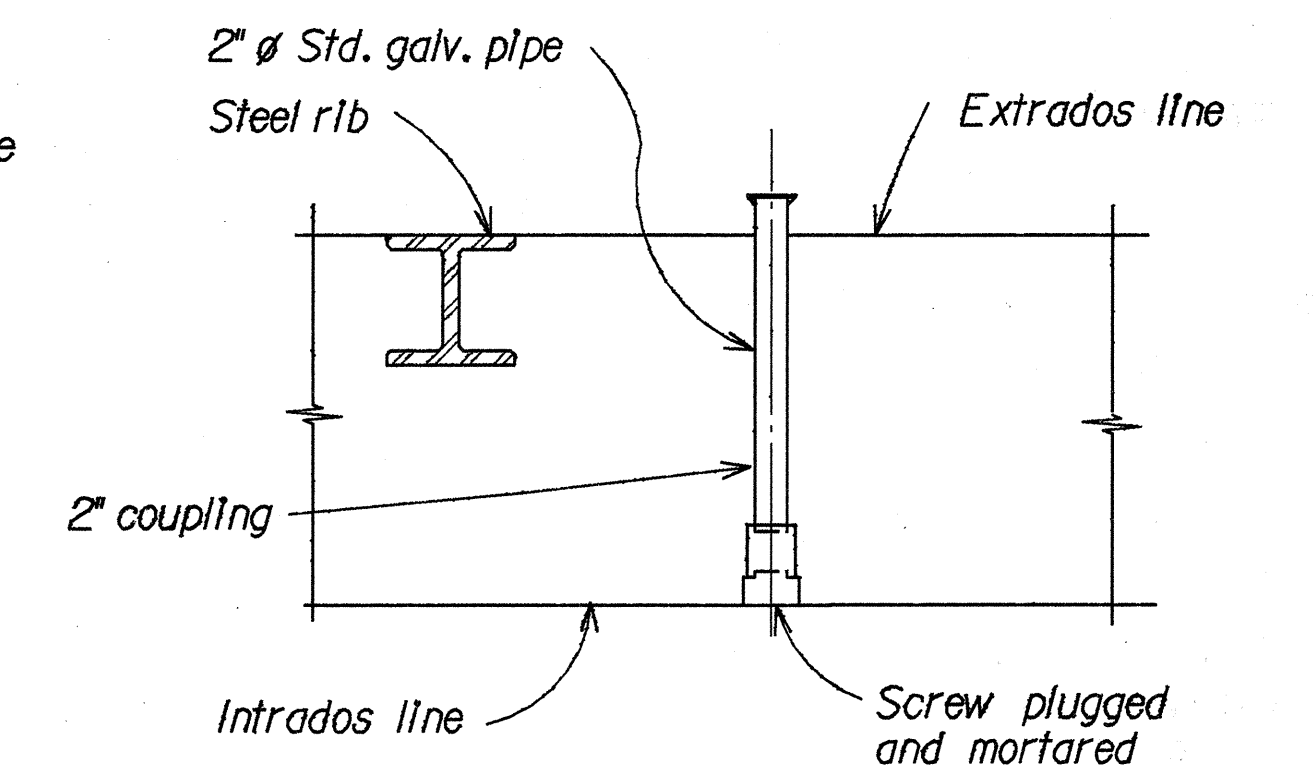

GROUT PIPE DETAIL
Scale: 1"=1'-0"

STATE OF HAWAII
DEPARTMENT OF TRANSPORTATION
HIGHWAYS DIVISION

PALI HIGHWAY, TUNNEL REPAIRS

REHABILITATION DETAILS

PALI HIGHWAY

Project No. 61D-01-89M

Scale: As Shown Date: February 1989

SHEET No. 1 OF 3 SHEETS

ORIGINAL PLAN	DATE
DRAWN BY	
CHECKED BY	
NOTED BY	
DATE	