




FED. ROAD DIST. NO.	STATE	PROJ. NO.	FISCAL YEAR	SHEET NO.	TOTAL SHEETS
HAWAII	HAW.	61ABC-01-90M	1990	4	44

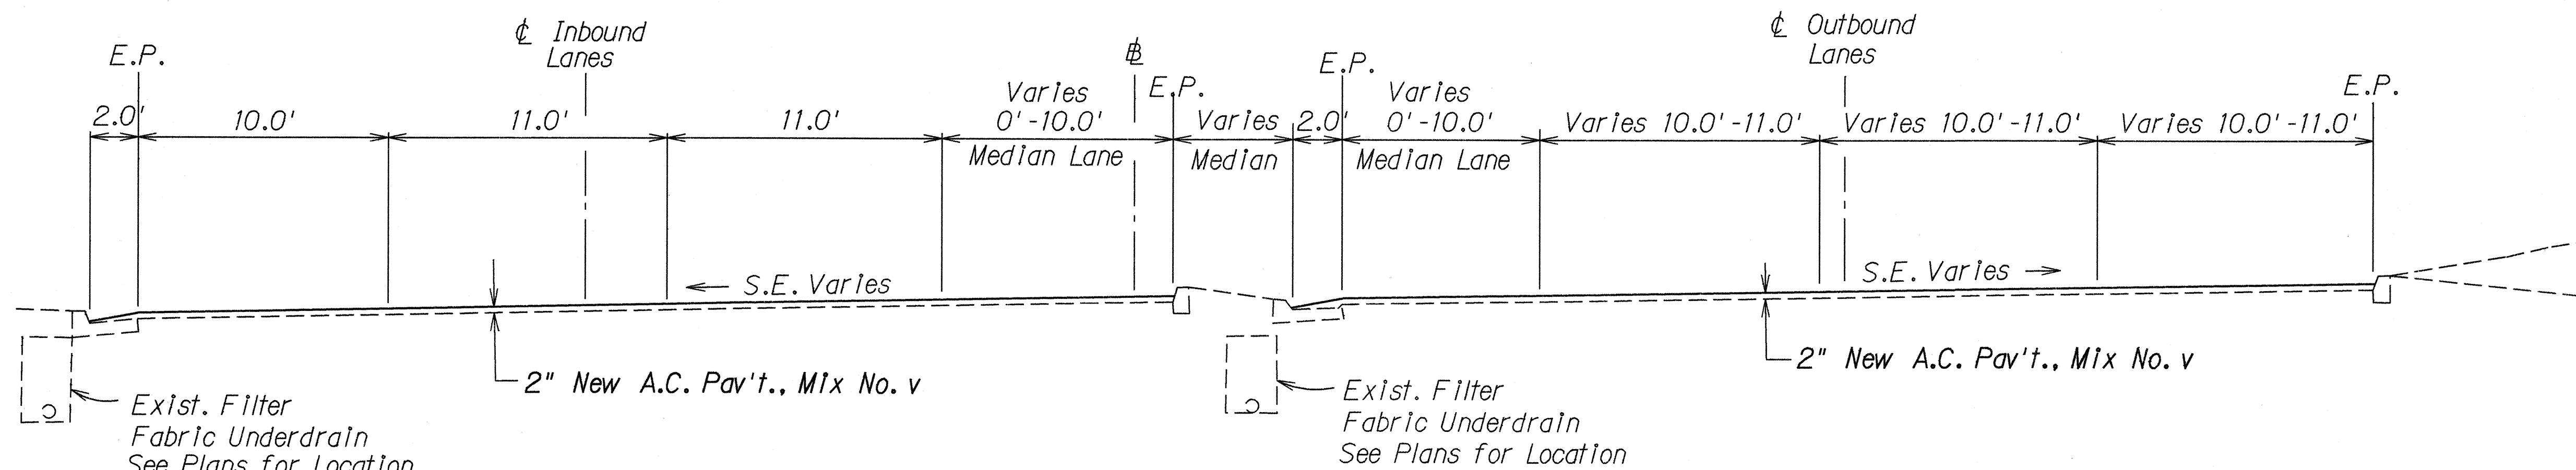


COUNTRY CLUB ROAD TO WAOKANAKA STREET
Scale: 1/4" = 1'-0"

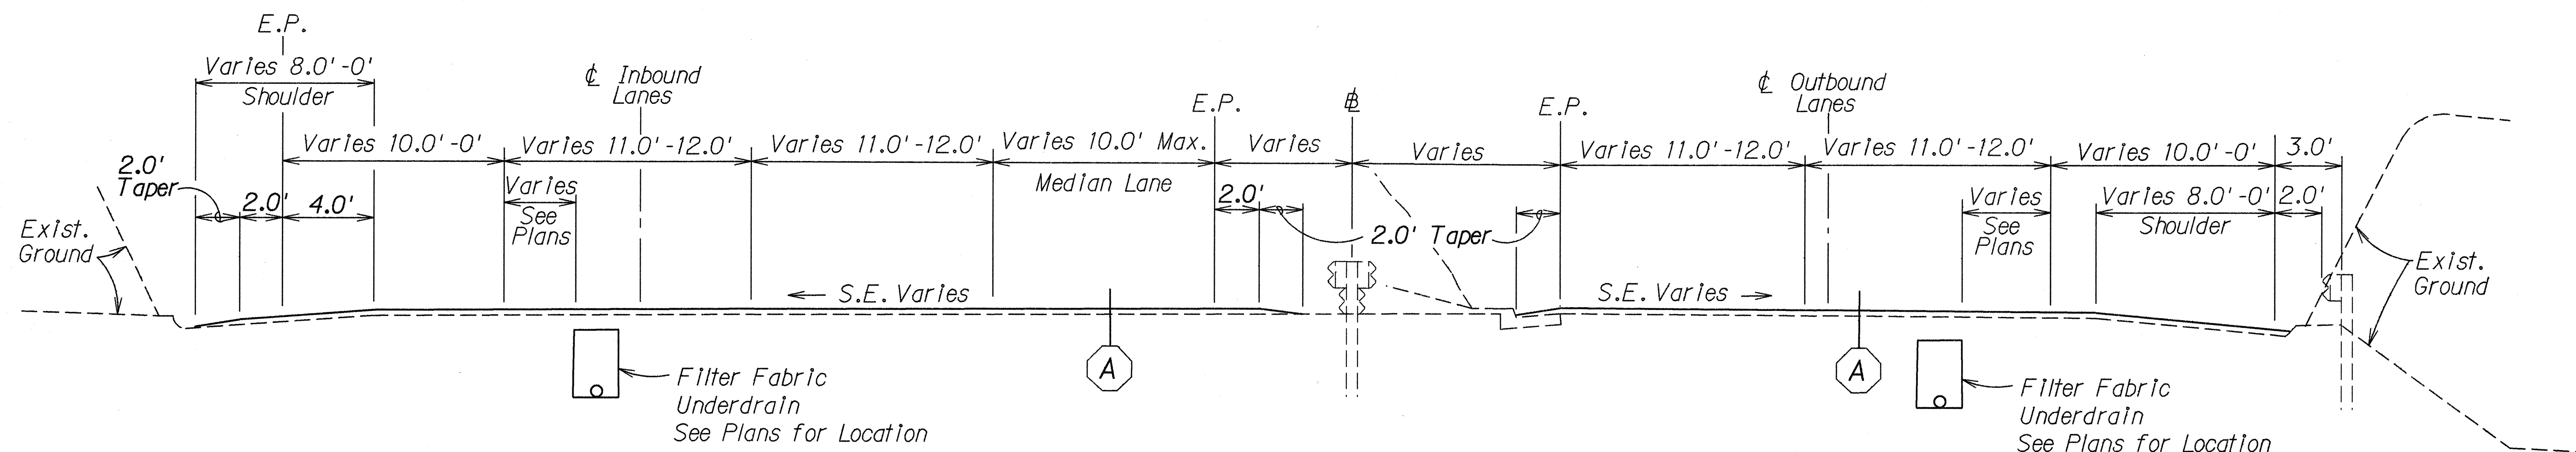


WAOKANAKA STREET TO CASTLE JUNCTION
Scale: 1/4" = 1'-0"

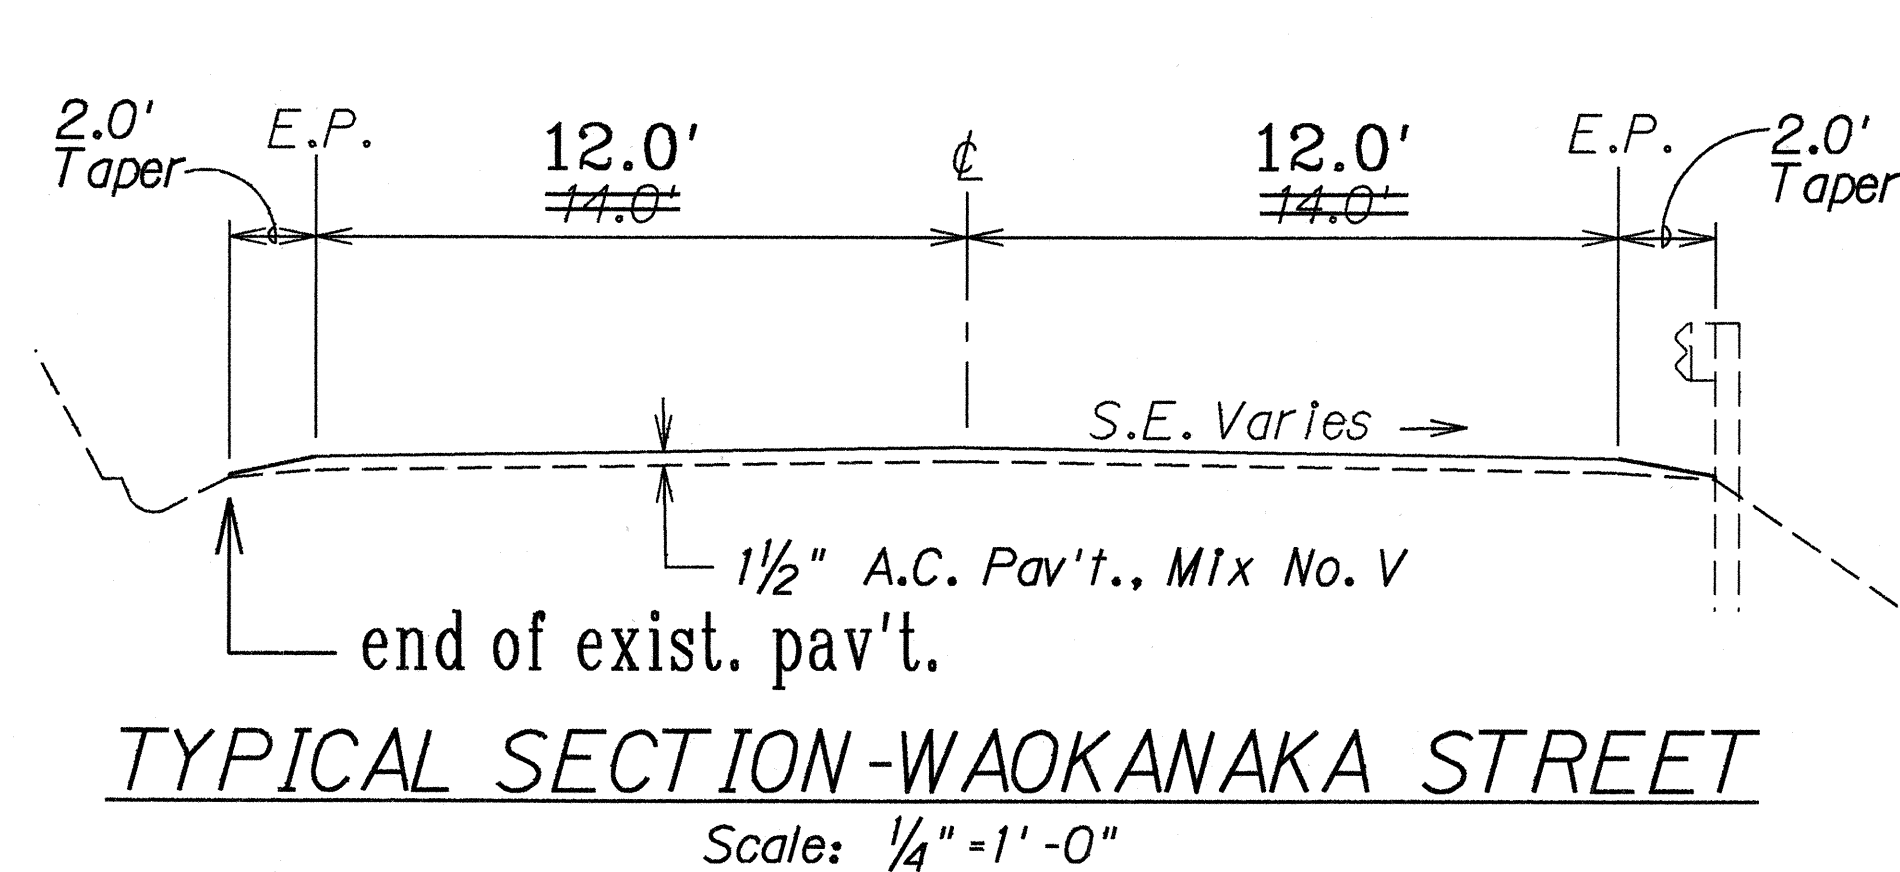

TYPICAL SECTION-WAOKANAKA STREET
Scale: 1/4" = 1'-0"

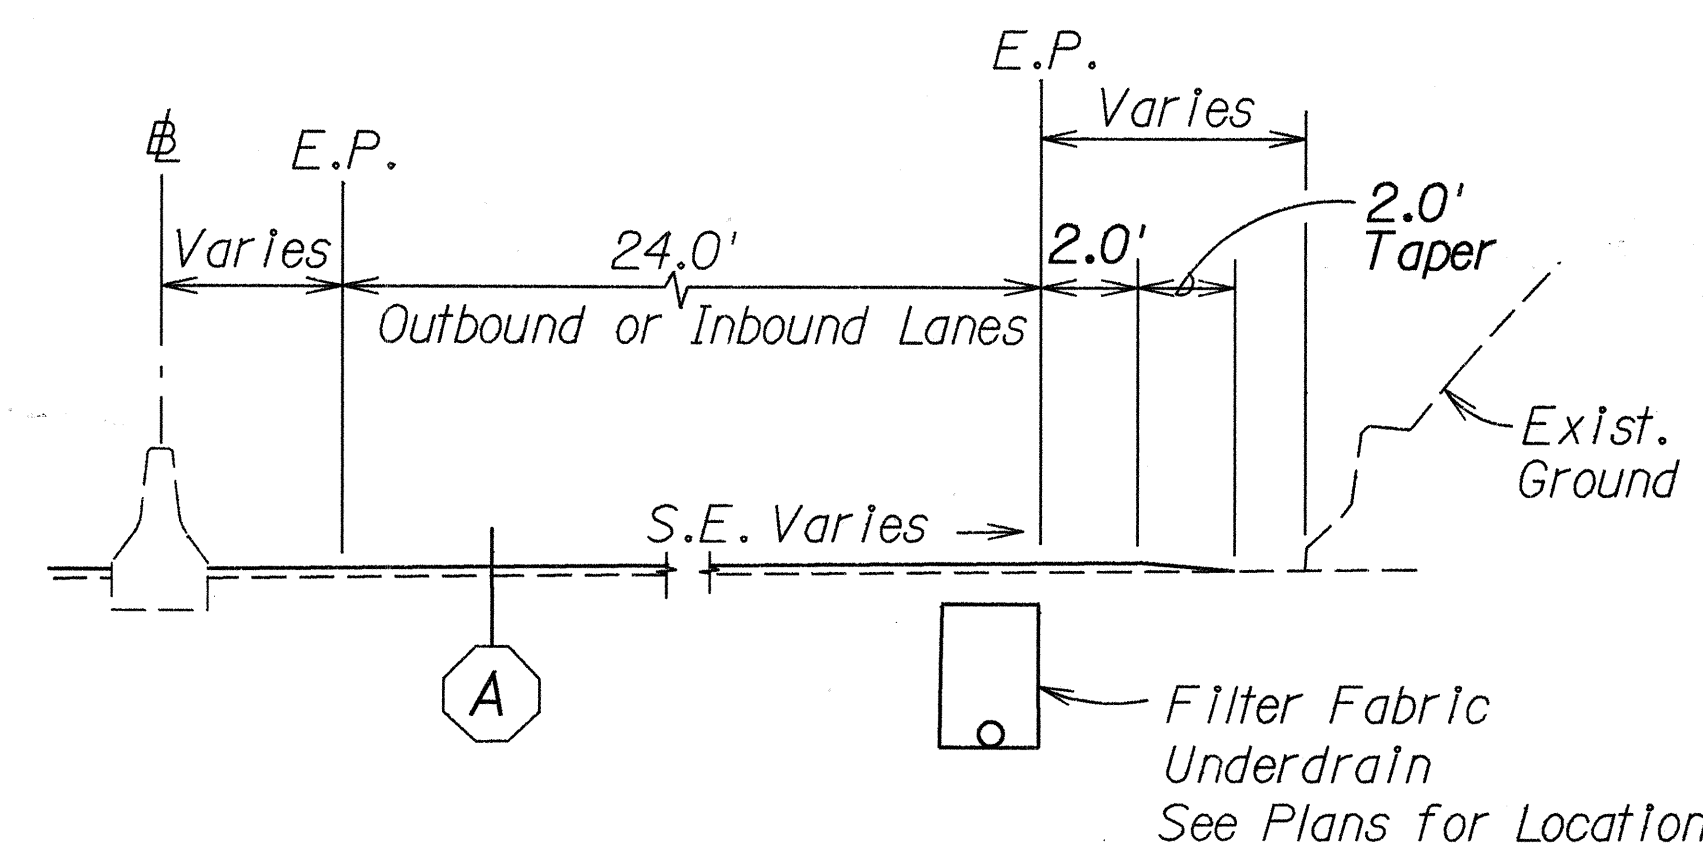

HALF SECTION WITH BARRIER DETAIL
Scale: 1/4" = 1'-0"

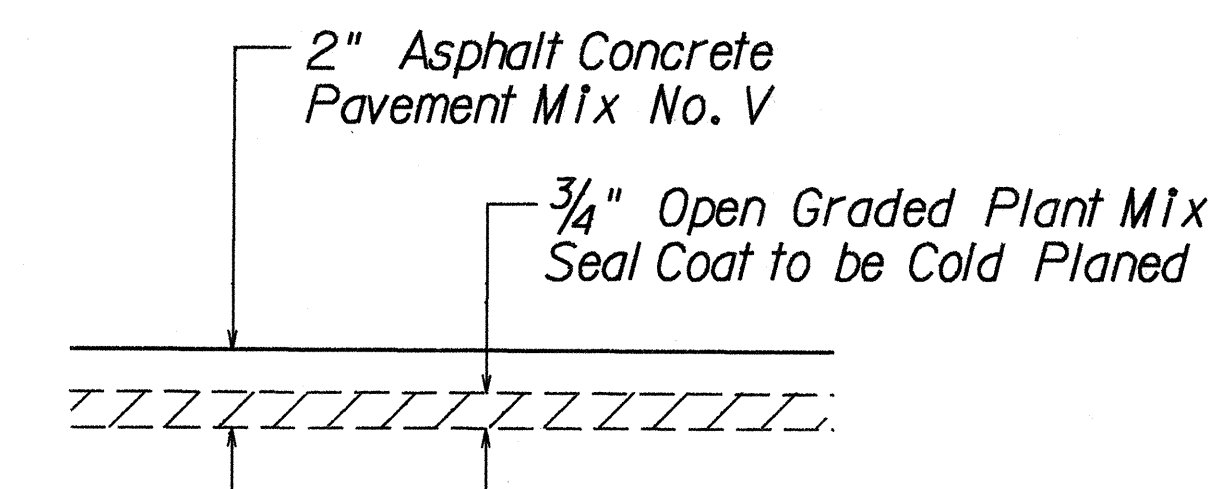


DETAIL A
Not to Scale

LEGEND FOR AS-BUILT POSTINGS	
	Squiggly line for as-built deletion
	Double line for as-built deletion
	Text for as-built posting

TYPICAL SECTIONS	
STATE OF HAWAII DEPARTMENT OF TRANSPORTATION HIGHWAYS DIVISION	
PALI HIGHWAY RESURFACING Country Club Road to Castle Junction PROJ. NO. 61ABC-01-90M	
Scale: As Shown	Date: May, 1990
SHEET No. 1 OF 3 SHEETS	


"AS-BUILT"

FED. ROAD DIST. NO.	STATE	PROJ. NO.	FISCAL YEAR	SHEET NO.	TOTAL SHEETS
HAWAII	HAW.	61ABC-01-90M	1990	5	44

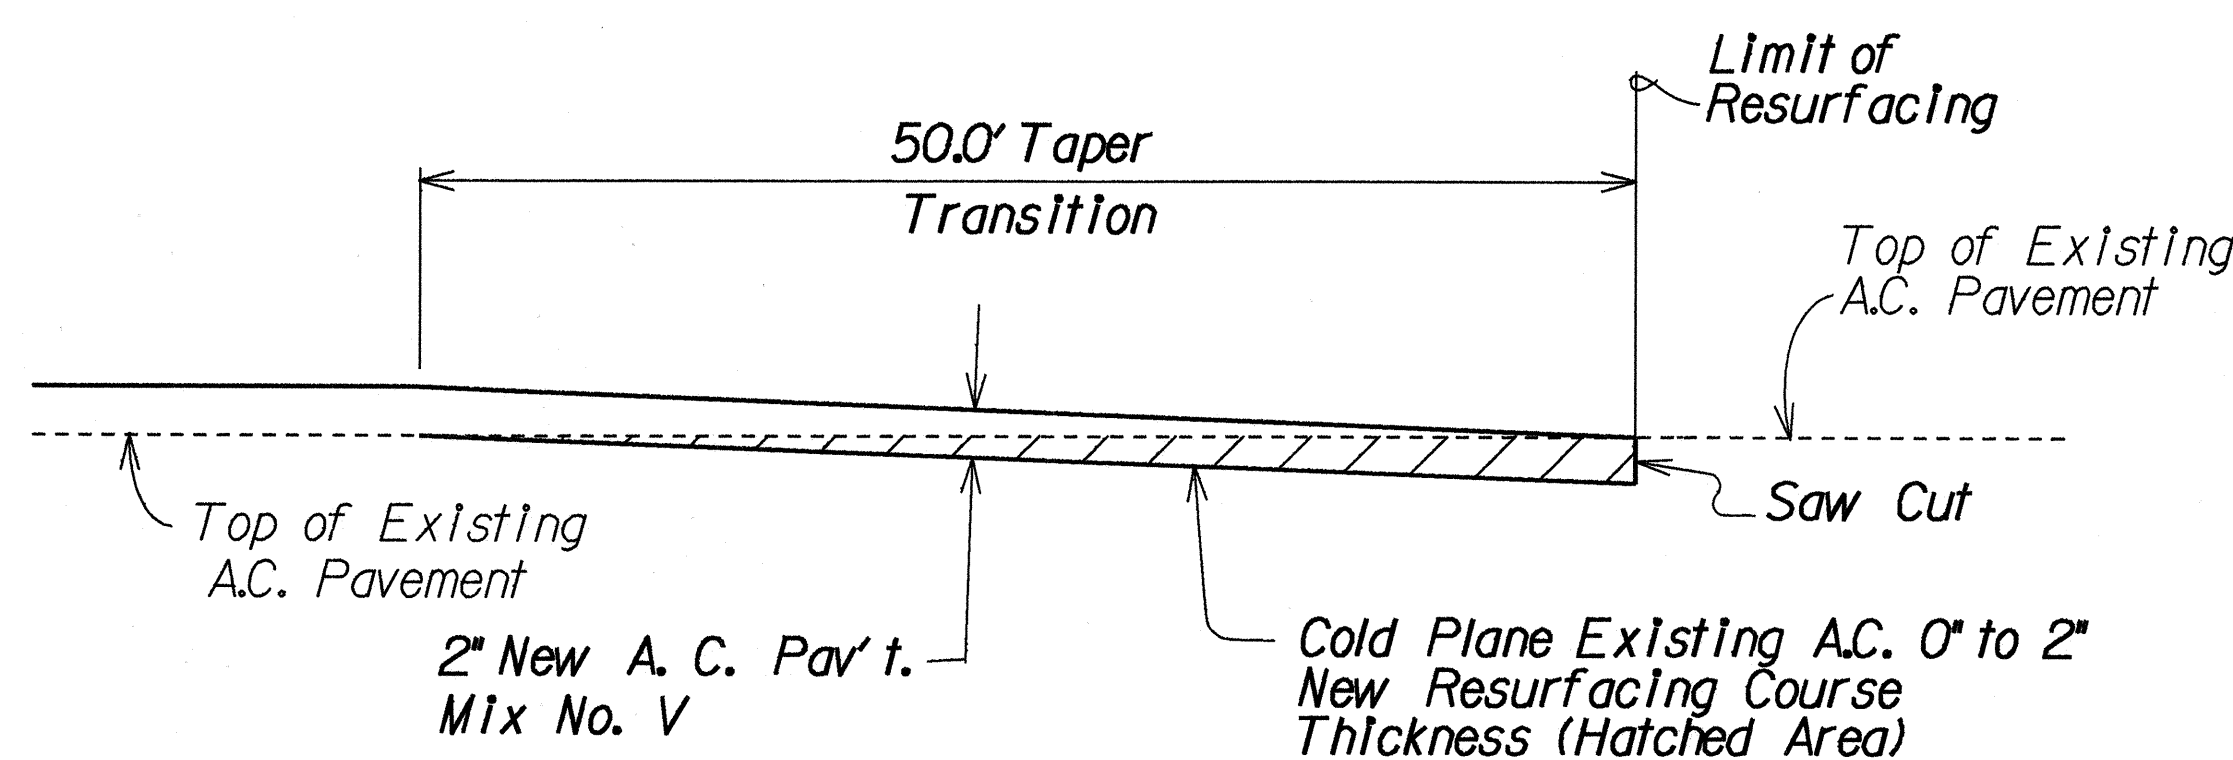


COLD PLANED TRANSITION
TO EXISTING A.C. PAVEMENT DETAIL

Not to Scale

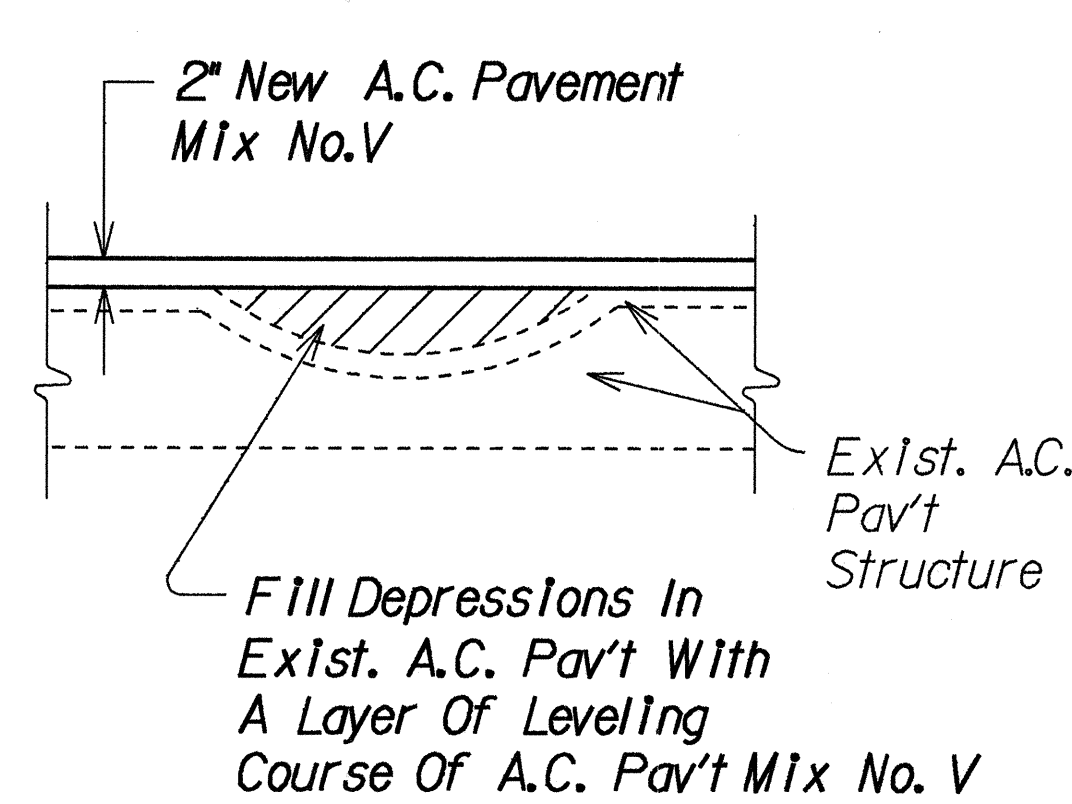


LEVELING COURSE DETAIL

Not to Scale

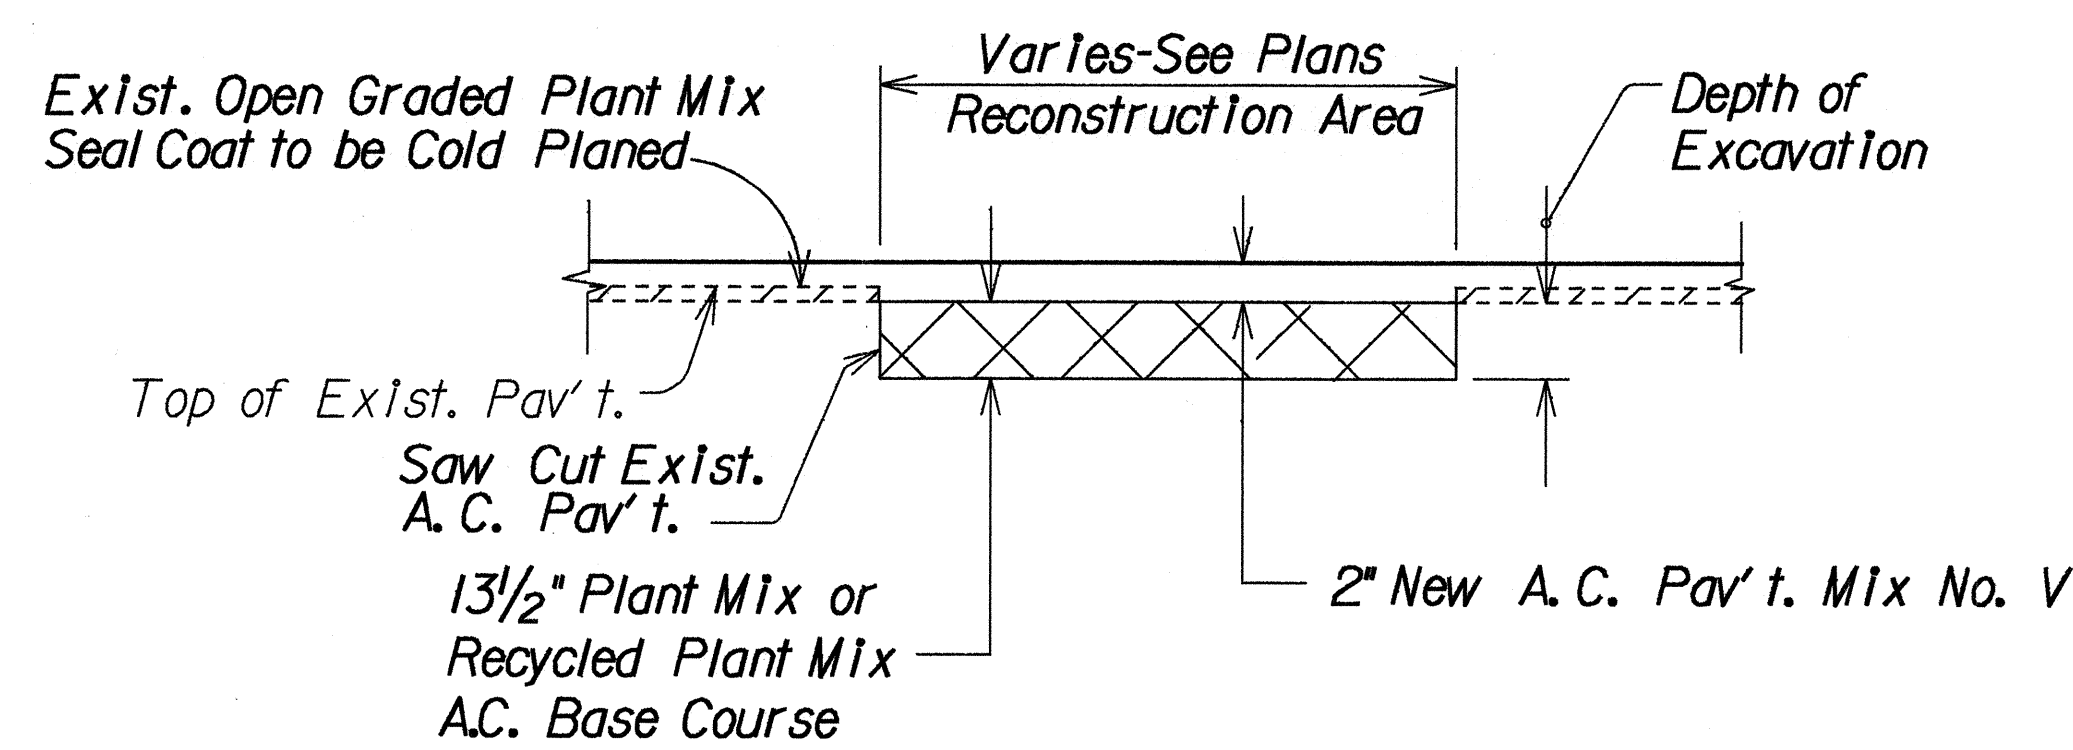


A.C. PAVEMENT RECONSTRUCTION DETAIL

Not to Scale

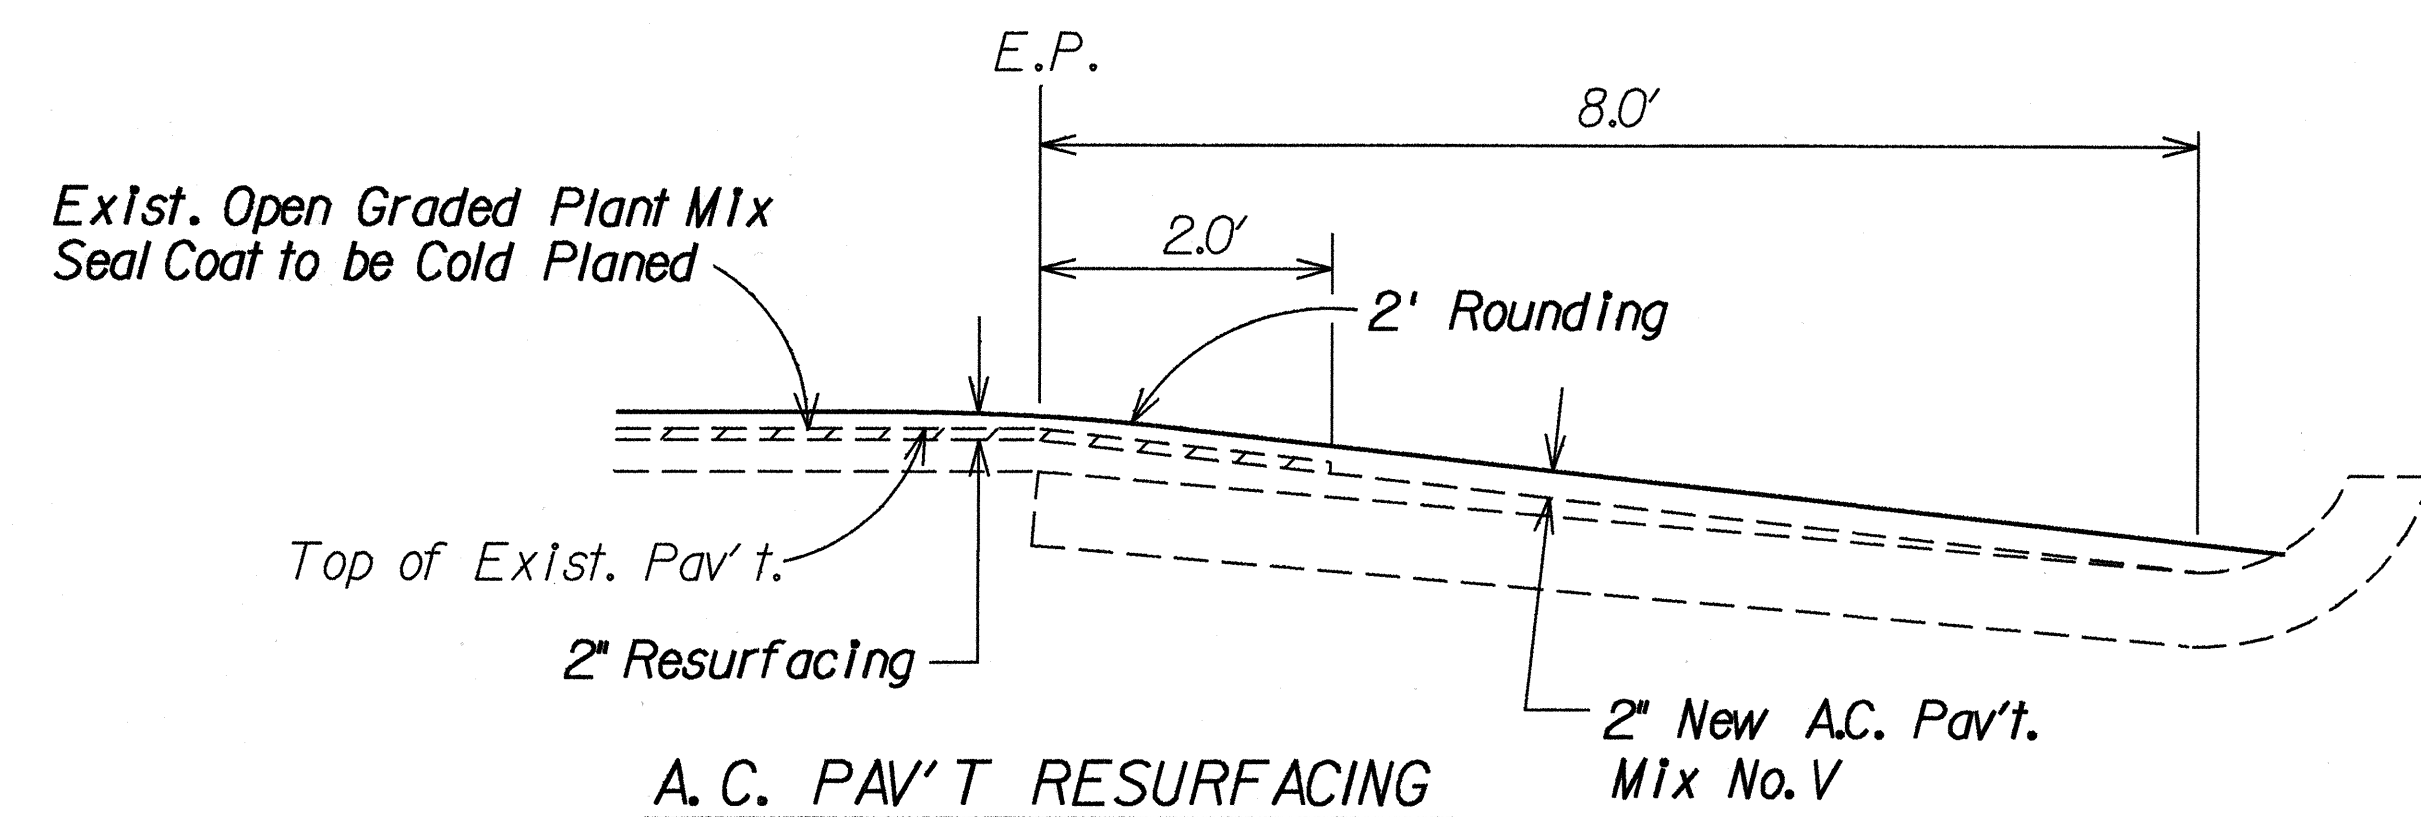


A.C. PAV'T RESURFACING
AT P.C.C. GUTTER DETAIL

Not to Scale

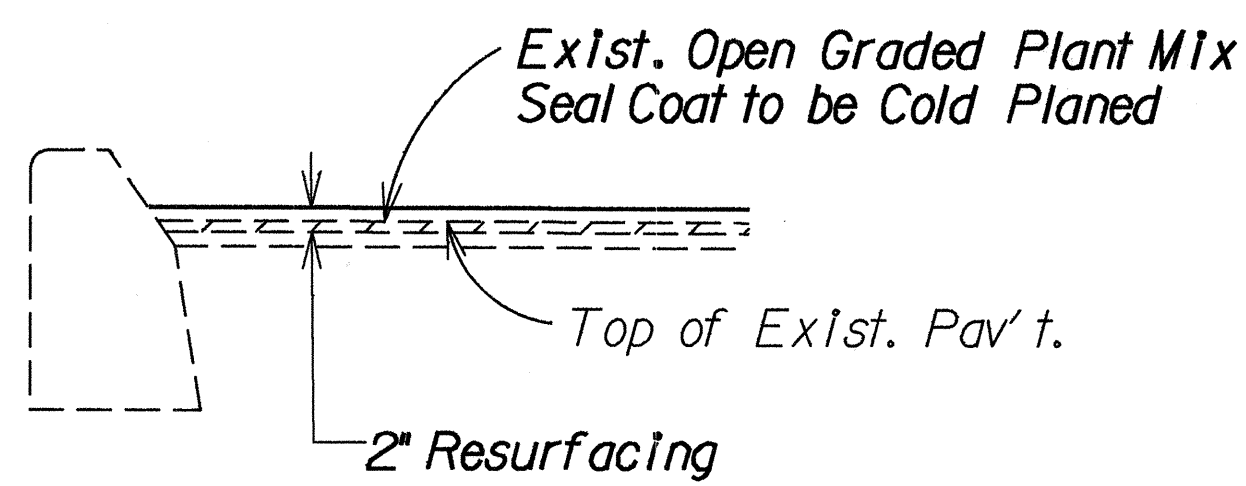


A.C. PAV'T RESURFACING
AT MEDIAN CURB DETAIL

Not to Scale

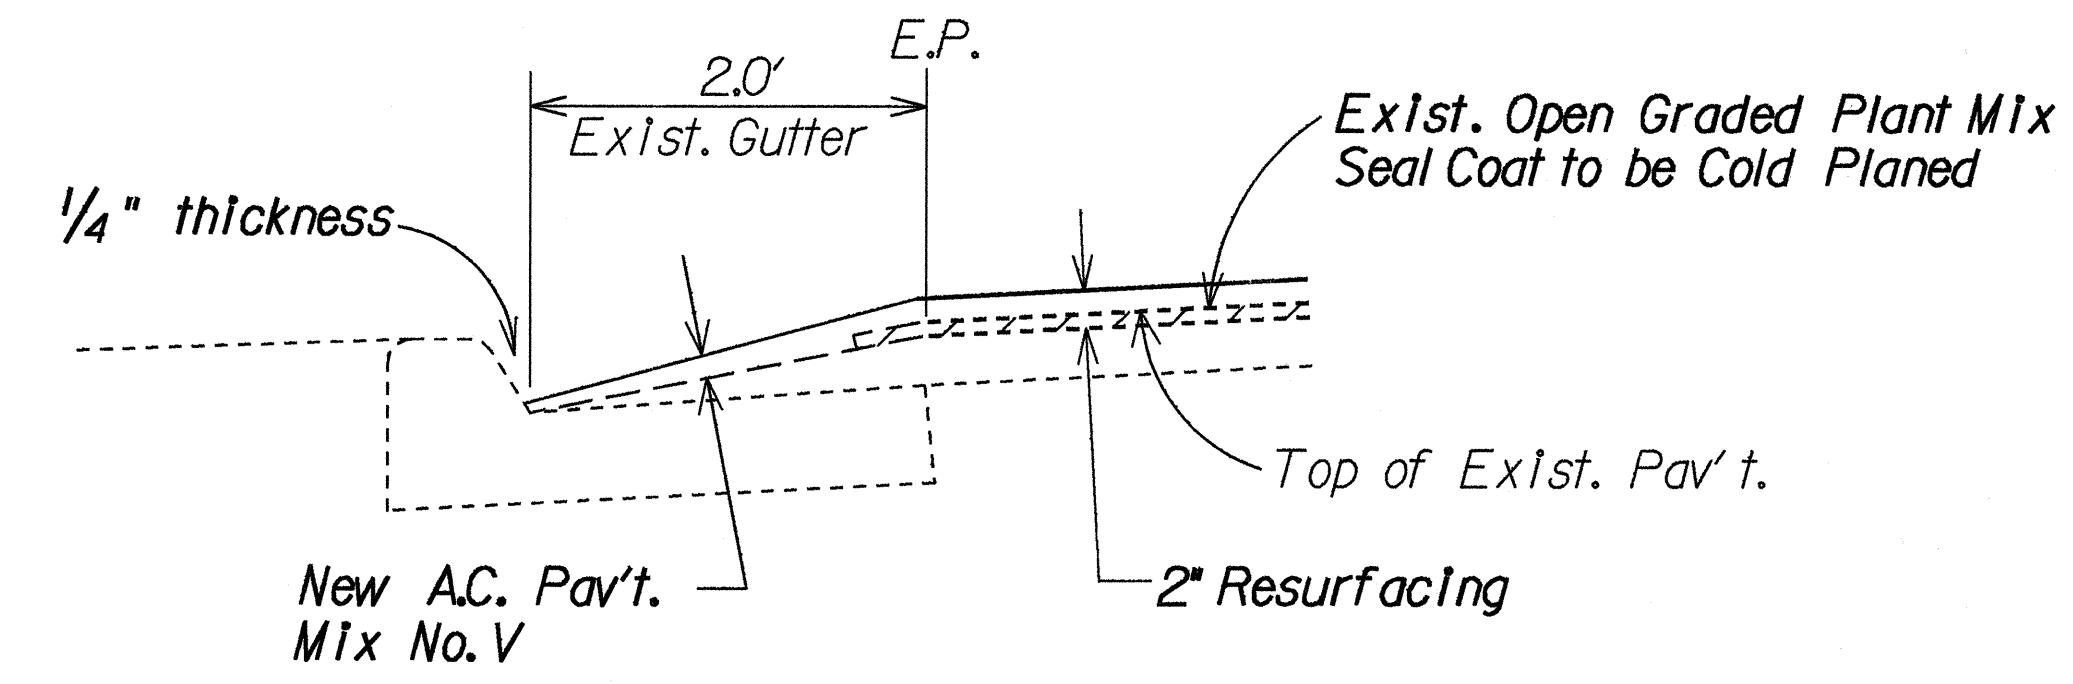

A.C. PAV'T RESURFACING
AT MEDIAN CURB AND GUTTER DETAIL

Not to Scale

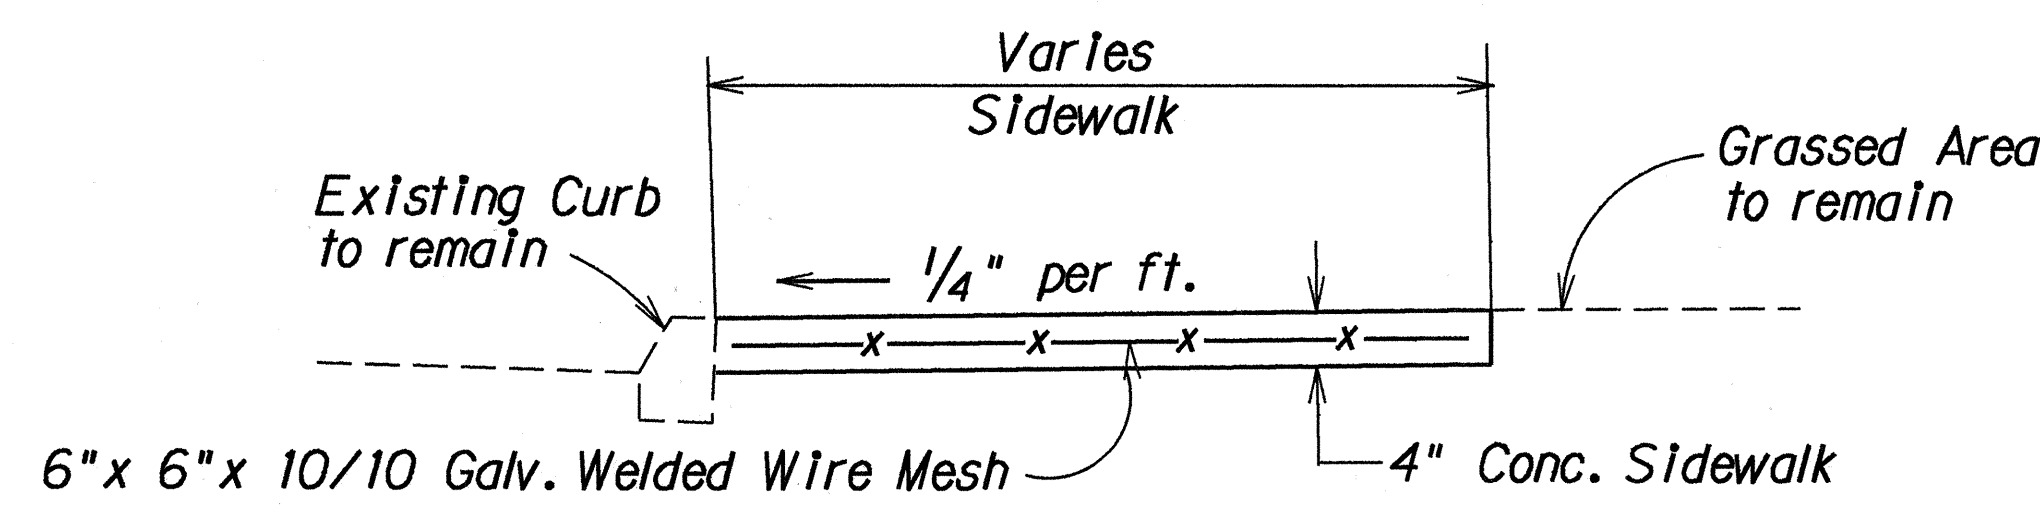

TYPICAL SIDEWALK SECTION

Not to Scale

NOTES

1. Sidewalk to be constructed in accordance with Section 608 of the Standard Specifications.
2. Any damage to the existing curb, driveways, wheelchair ramps and existing CRM wall by the Contractor shall be restored by the Contractor at no cost to the State.
3. Any required adjustments to the utility boxes shall be considered incidental to the sidewalk.
4. The existing utility poles located in the proposed sidewalk area to remain. Concrete to be placed around the utility poles.

6/13/90	Revised A.C. Pav't. Resurf. at P.C.C. Gutter Detail to include 2' rounding at E.P. as per Addendum No. 1.
DATE	REVISION


STATE OF HAWAII
DEPARTMENT OF TRANSPORTATION
HIGHWAYS DIVISION

MISCELLANEOUS DETAILS


PALI HIGHWAY RESURFACING
Country Club Road to Castle Junction
PROJ. NO. 61ABC-01-90M
Scale: As Shown Date: May, 1990
SHEET No. 2 OF 3 SHEETS

ORIGINAL PLAN	DATE
SURVEY PLATTED BY	
DRAWN BY	
DESIGNED BY	
CHECKED BY	
NOTE BOOK	
NO.	


FED. ROAD DIST. NO.	STATE	PROJ. NO.	FISCAL YEAR	SHEET NO.	TOTAL SHEETS
HAWAII	HAW.	61ABC-01-90M	1990	6	42

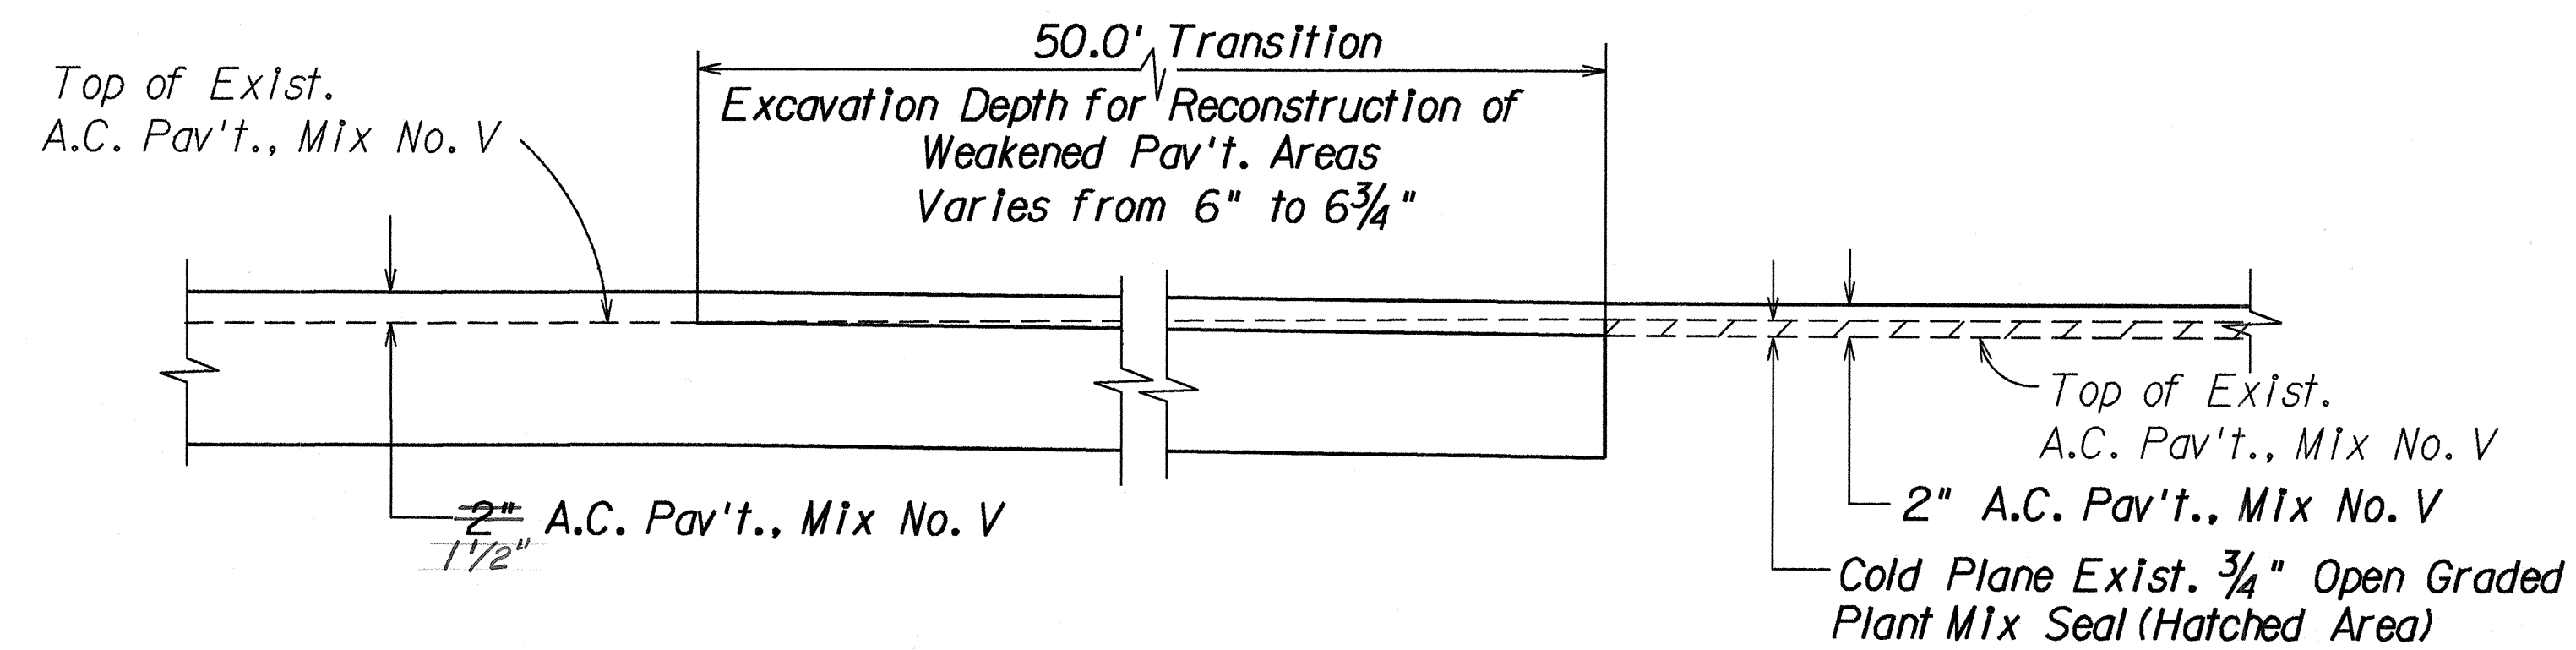

RESURFACING DETAIL AT WAOKANAKA ST.
Not to Scale

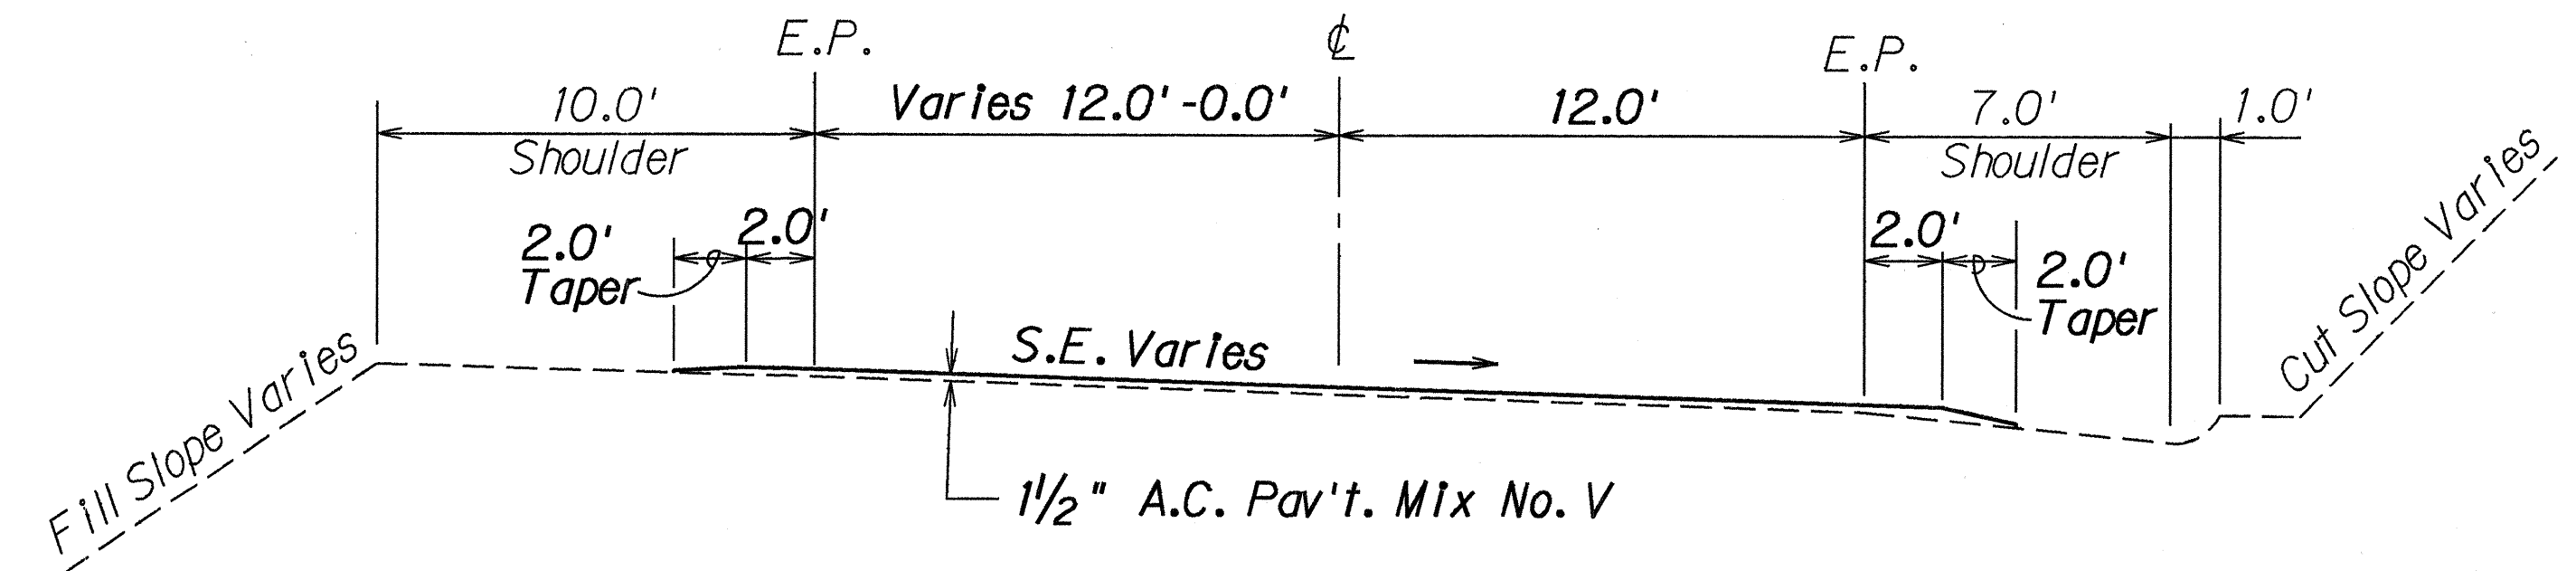

TYPICAL SECTION AT PALI LOOKOUT ROAD
Scale: $\frac{1}{4}'' = 1' - 0''$

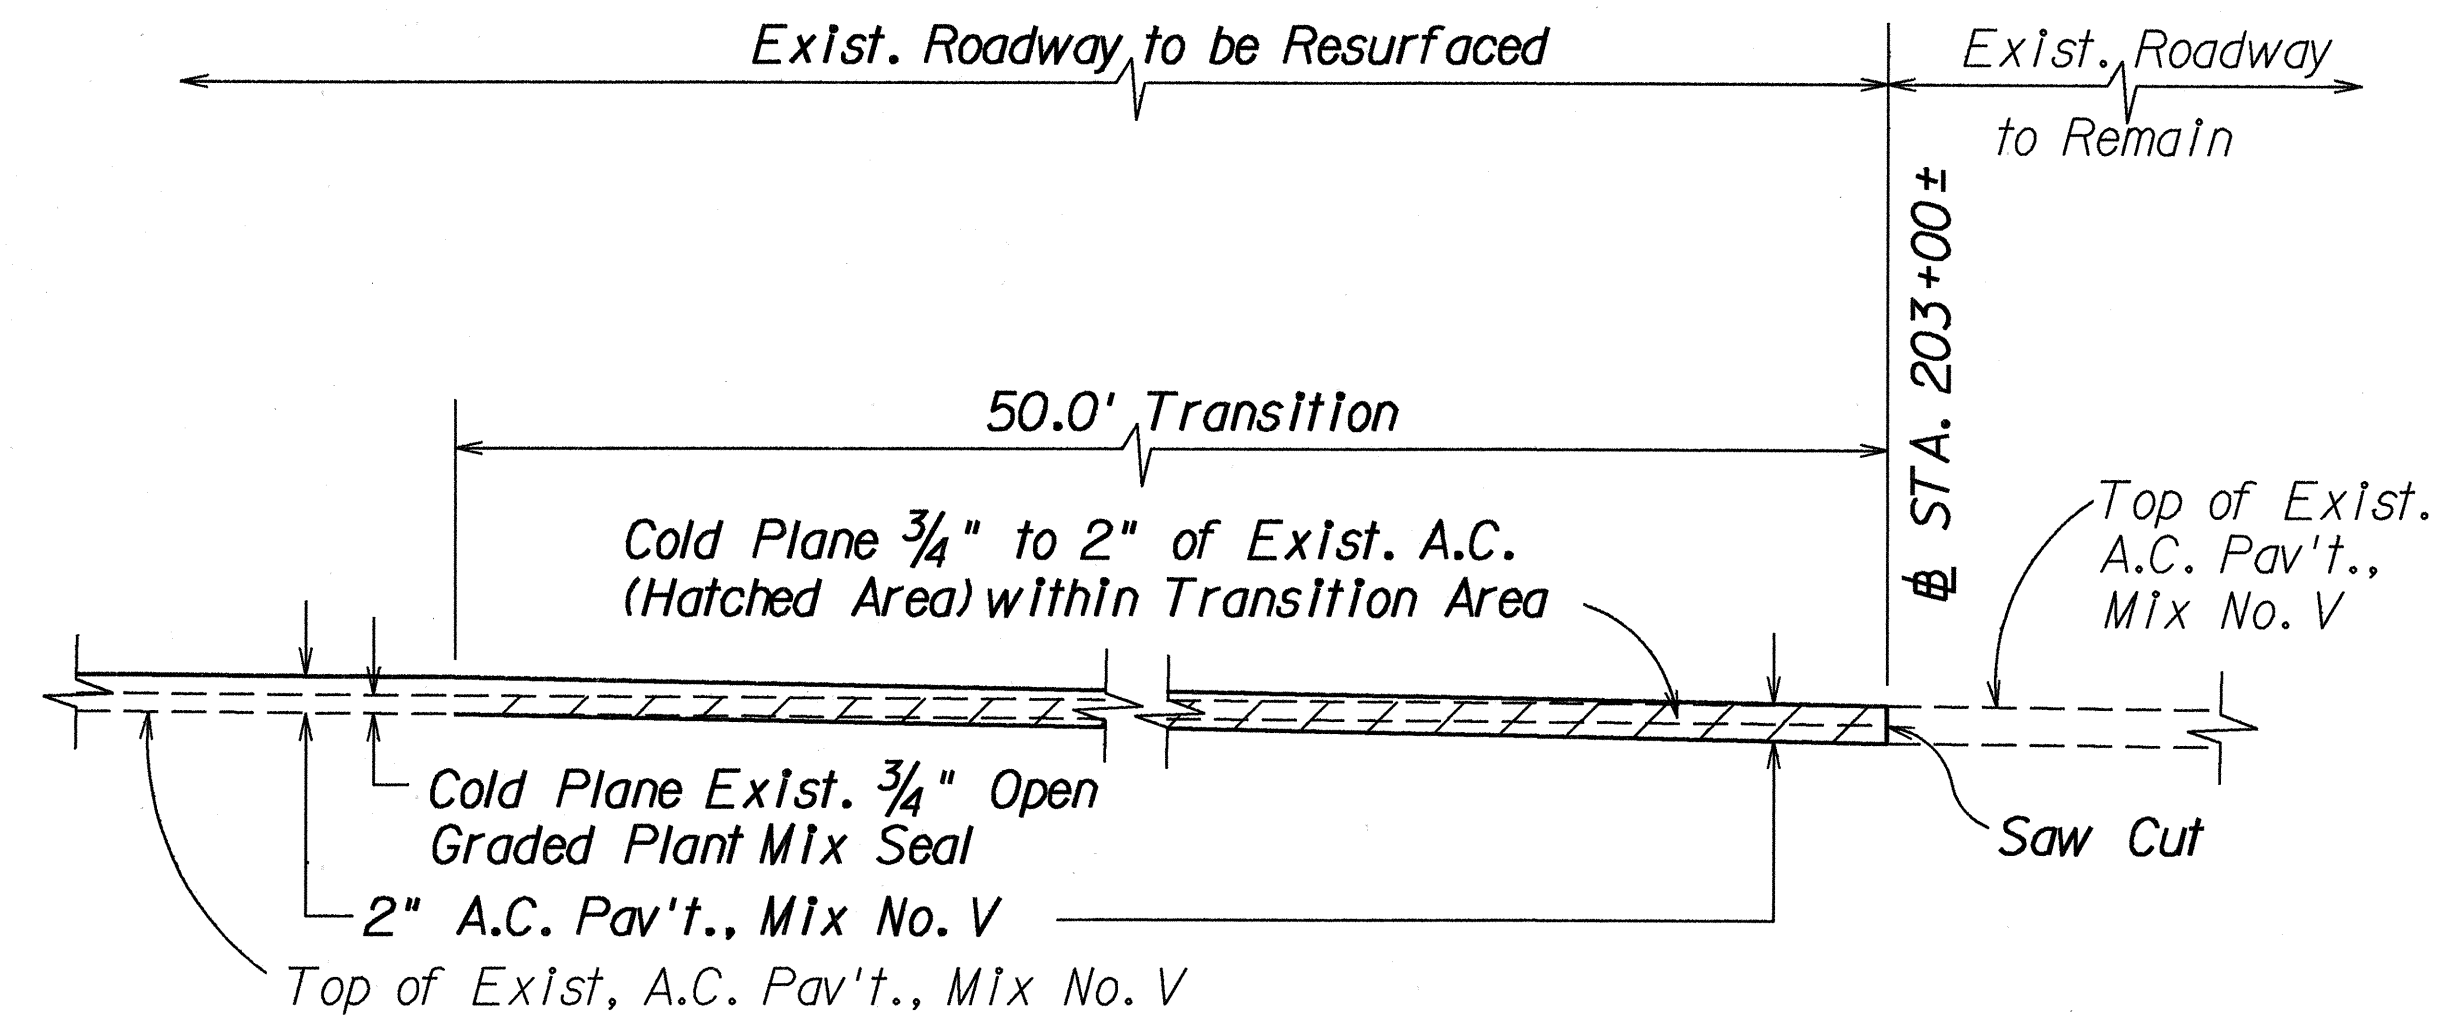

RESURFACING DETAIL AT CASTLE JUNCTION
Not to Scale

STATE OF HAWAII DEPARTMENT OF TRANSPORTATION HIGHWAYS DIVISION	
MISCELLANEOUS DETAILS	
PALI HIGHWAY RESURFACING Country Club Road to Castle Junction PROJ. NO. 61ABC-01-90M	
Scale: As Shown	Date: May, 1990
SHEET No. 3 OF 3 SHEETS	