INDEX TO DRAWINGS	
SHEET NO.	DESCRIPTION
1	TITLE SHEET
2	SUMMARY SHEET
3	GENERAL NOTES AND LEGEND
4	TYPICAL DETAILS AND SCHEDULE
5–10	PLANS
11	PAVEMENT MARKINGS LEGEND & DETAILS
12–13	SIGNING & PAVEMENT MARKING PLANS

STATE OF HAWAII

## DEPARTMENT OF TRANSPORTATION


HIGHWAYS DIVISION
HONOLULU, HAWAII


"AS-BUILT"

PLANS FOR

## PALI HIGHWAY SIDEWALKS WYLLIE STREET TO AHI PLACE PROJECT NO. 61A-01-92

DISTRICT OF HONOLULU ISLAND OF OAHU

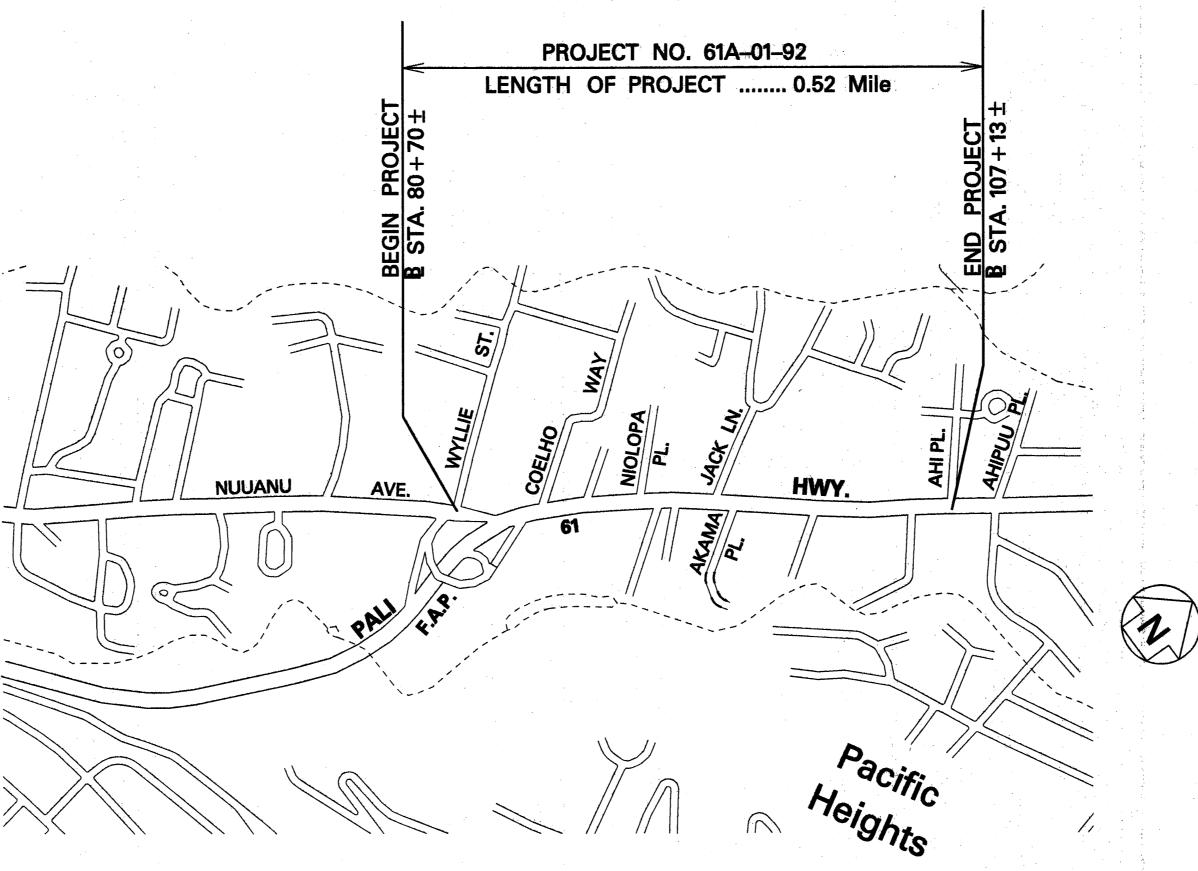

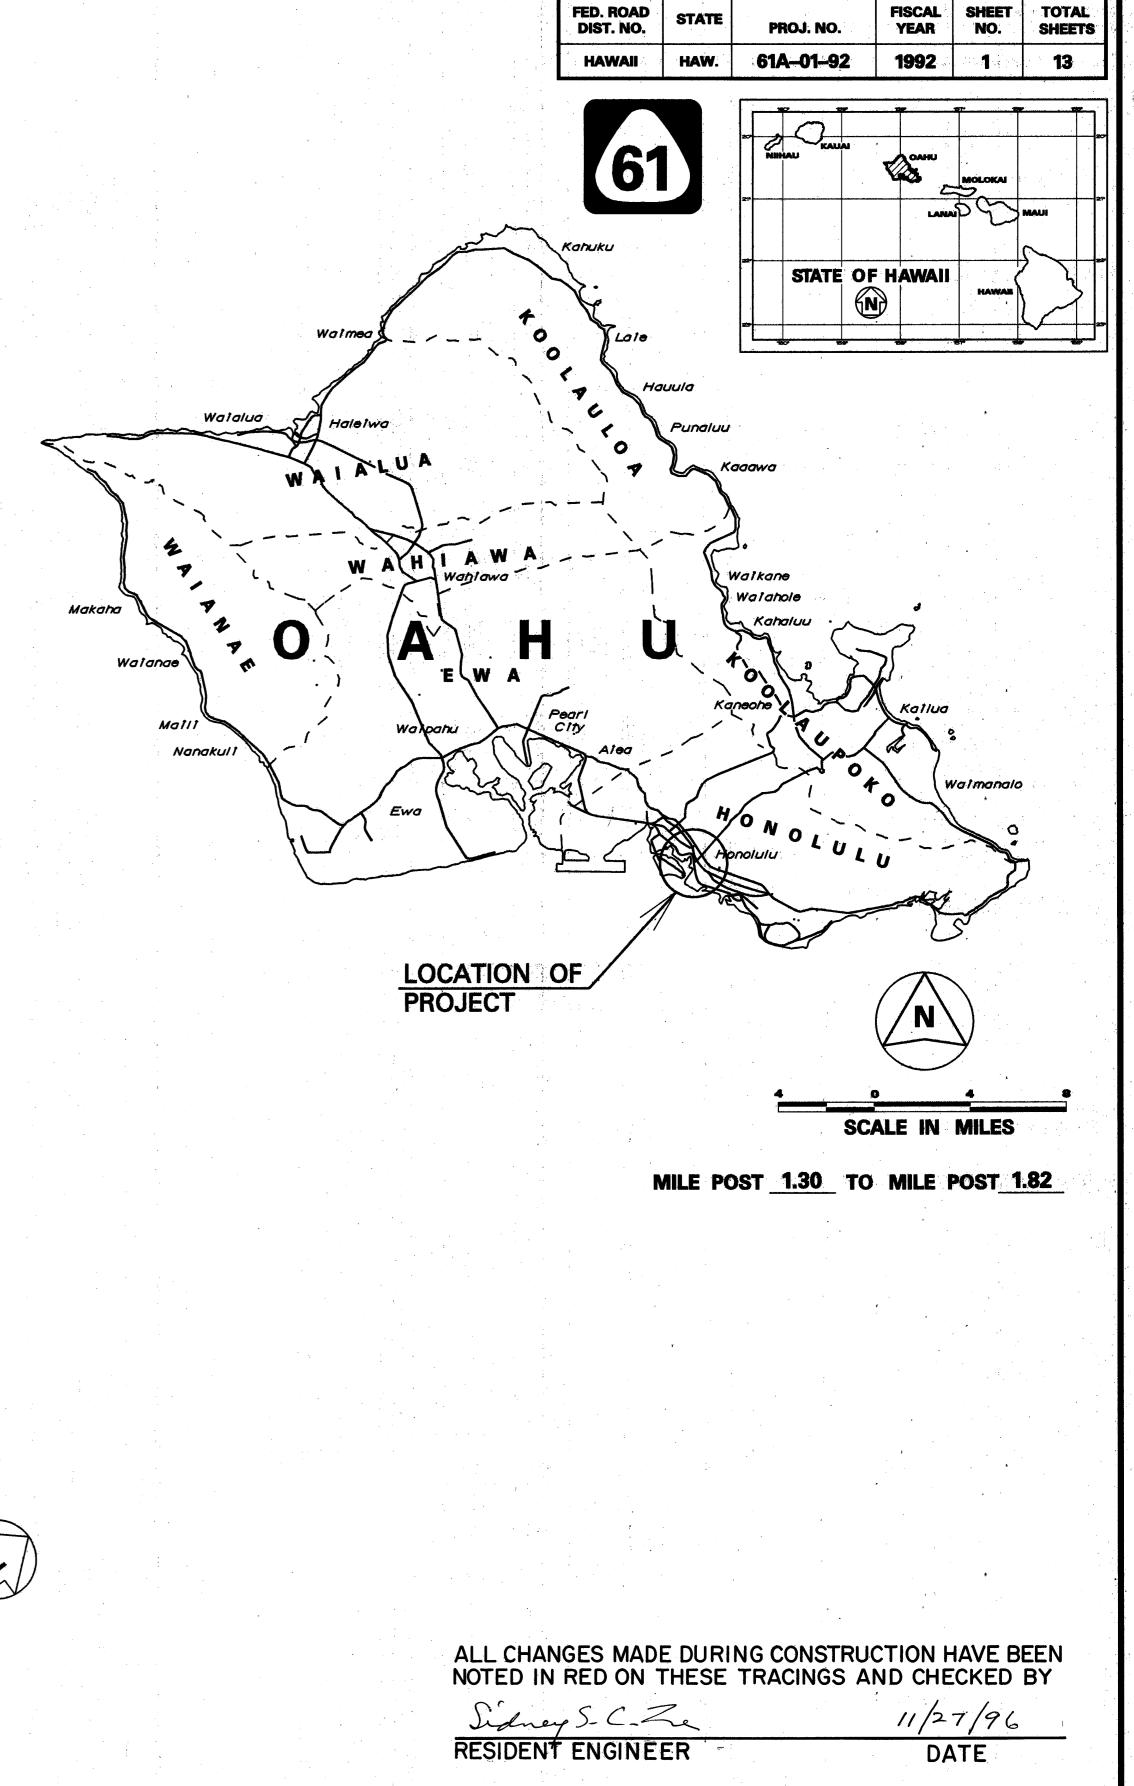

LAYOUT PLAN

SCALE IN HUNDRED FEET

4/23/97 DATE

DEPARTMENT OF TRANSPORTATION STATE OF HAWAII

Hanso

お DIR. OF TRANSPORTATION

**APPROVED:**