



FED. ROAD DIST. NO.	STATE	PROJ. NO.	FISCAL YEAR	SHEET NO.	TOTAL SHEETS
HAWAII	HAW.	61A-01-92	1992	4	13

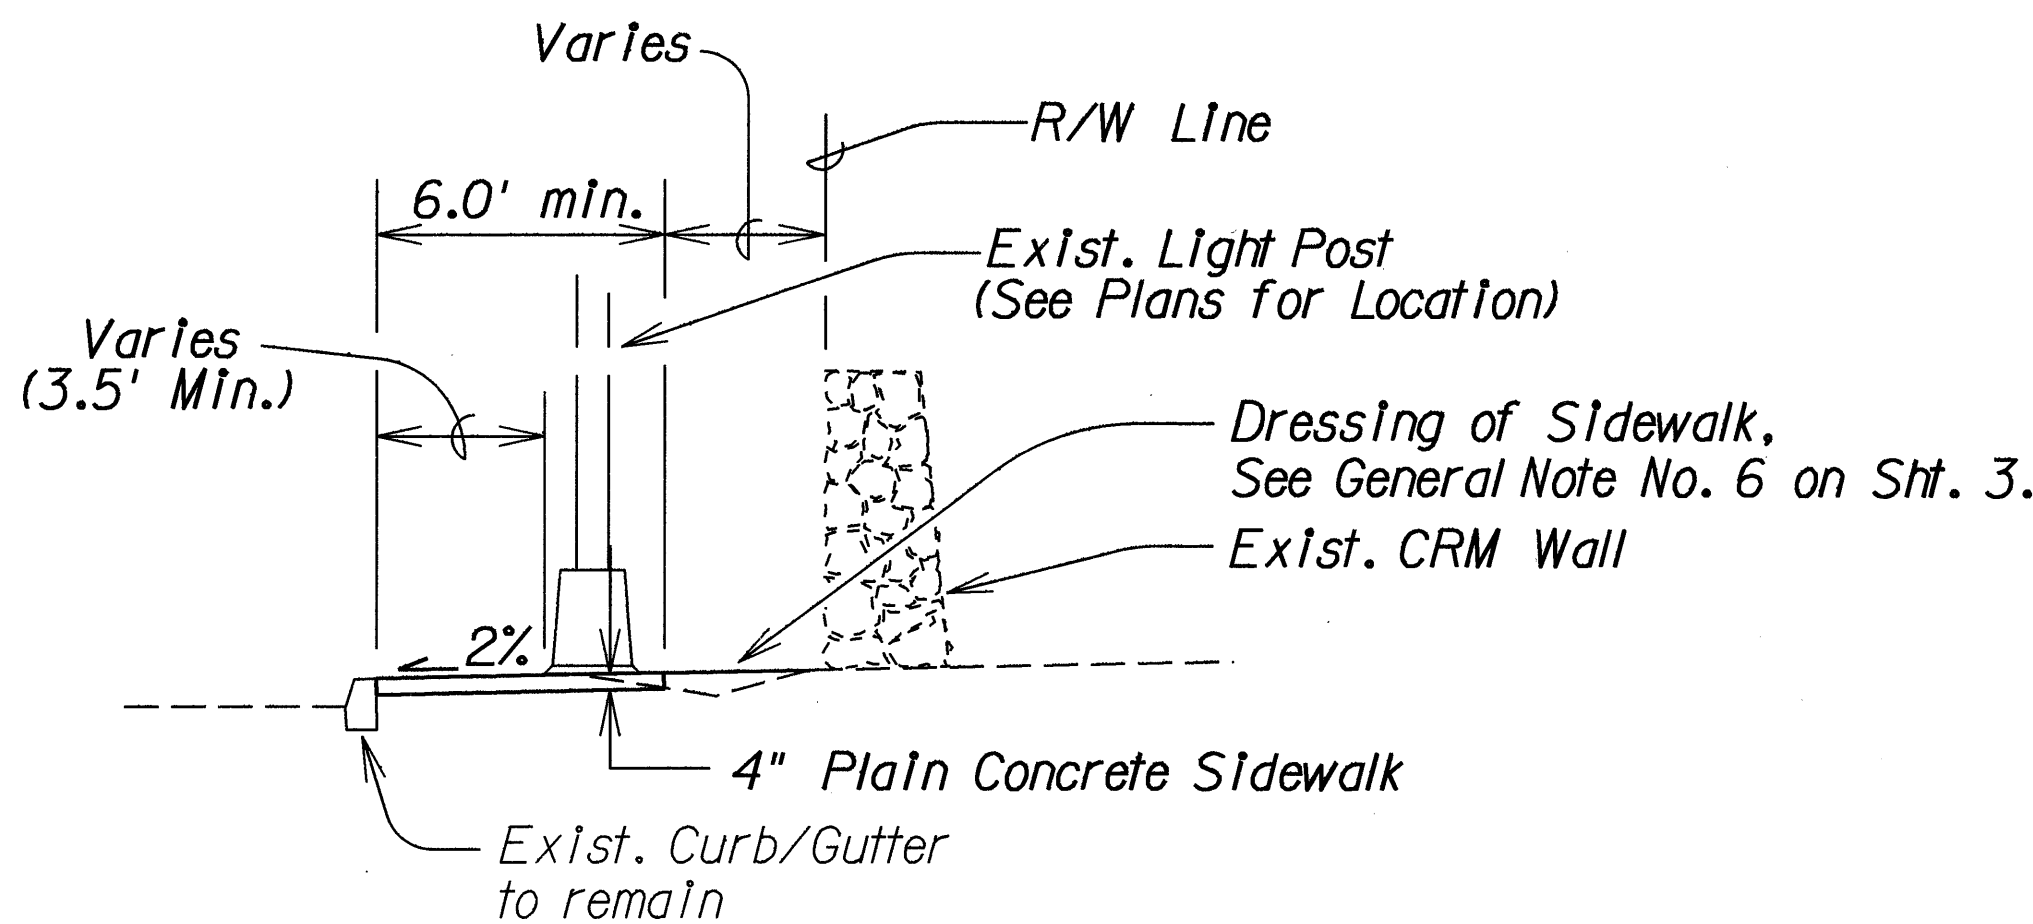

TYPICAL SIDEWALK DETAIL

Scale: 1/4" = 1'-0"

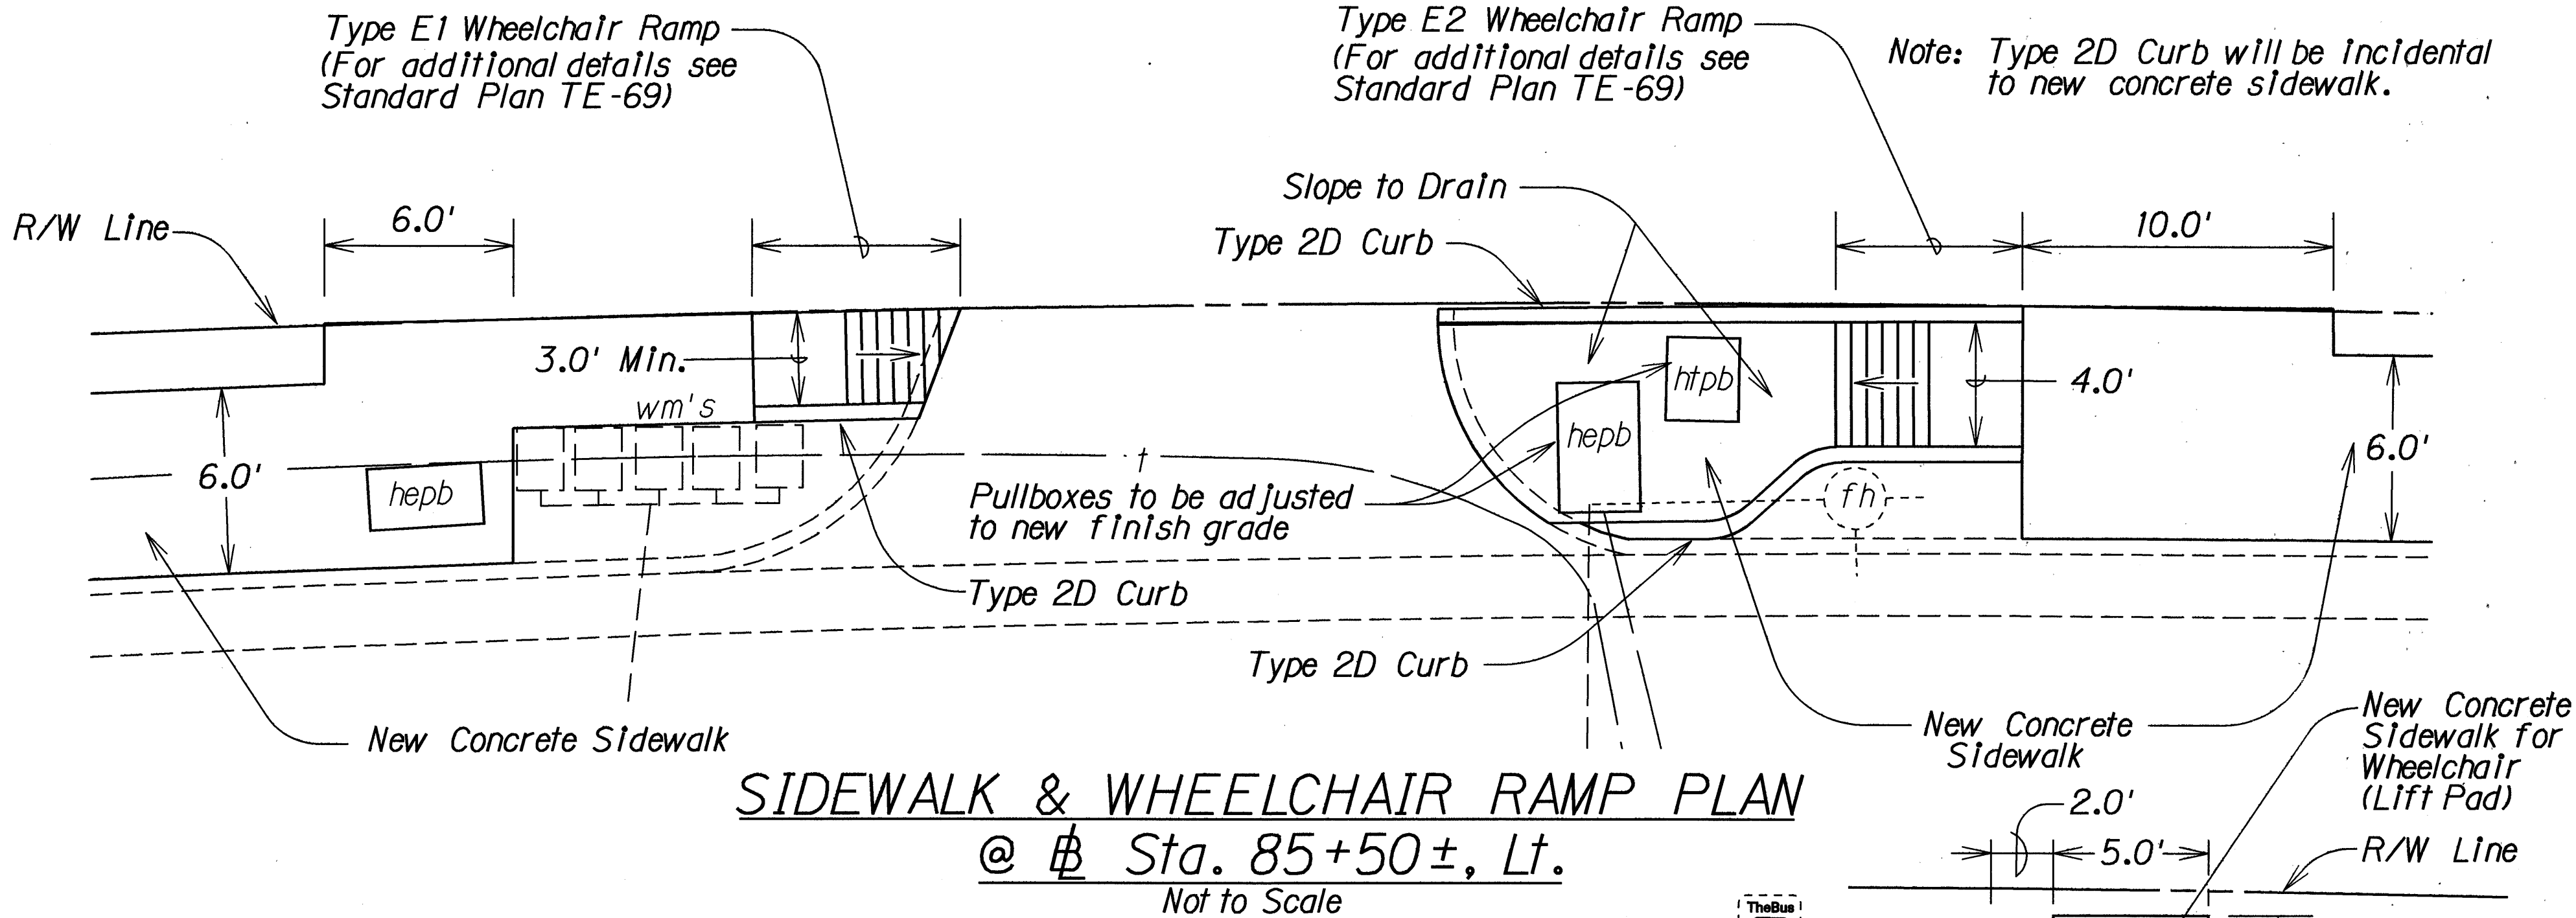

SIDEWALK & WHEELCHAIR RAMP PLAN

@ Sta. 85+50±, Lt.

Not to Scale

UTILITY ADJUSTMENT SCHEDULE

# Location o/s Left	Item No. 604.1000 Adjusting Water Meter	Item No. 604.2000 Adjusting Storm Drain Manhole	Item No. 604.3000 Adjusting HECO Pullboxes	Item No. 604.4000 Adjusting HECO Pullboxes 20" x 40"	Item No. 604.4100 Adjusting HECO Pullboxes 24" x 48"	Item No. 604.4200 Adjusting HECO Pullboxes w/Conc. Cover	Item No. 622.7000 Adjusting Highway Lighting Pullbox	Item No. 623.1000 Adjusting Traffic Signal Pullbox
Sta. 81+70±		2						
Sta. 85+00±			1				1	
Sta. 85+50±			1	1				
Sta. 85+90±					1			
Sta. 86+10±	1						1	
Sta. 86+80±			1					
Sta. 86+90±	1							
Sta. 87+80±							1	
Sta. 88+90±				1	1			
Sta. 89+20±			2		1			
Sta. 90+00±							1	
Sta. 90+90±	1							
Sta. 91+95±							1	
Sta. 93+70±							1	
Sta. 94+80±			1					
Sta. 95+50±							1	
Sta. 96+30±	1							
Sta. 97+00±			1					
Sta. 97+50±							1	
Sta. 99+20±							1	
Sta. 99+60±	1							
Sta. 99+90±	3							
Sta. 100+50±	2							
Sta. 101+20±							1	
Sta. 101+40±						1		
Sta. 101+45±			1					
Sta. 101+80±			1					
Sta. 102+10±	1							
Sta. 102+80±	2		1				1	
Sta. 104+80±	2						1	
Sta. 106+60±							2	
Sta. 107+00±								2
TOTAL	15	2	10	2	3	1	14	2

Note: Existing utilities shall be adjusted flush to the new sidewalk finish grade.

TYPICAL SIDEWALK DETAIL @ BUS STOP

NOT TO SCALE

WHEELCHAIR RAMP SCHEDULE

# Location o/s Left	Item No. 650.3000 Type C	Item No. 650.4000 Type D	Item No. 650.5000 Type E	Item No. 650.5100 Type E1	Item No. 650.5200 Type E2
Sta. 84+50±	1				
Sta. 84+70±		1			
Sta. 85+70±				1	
Sta. 86+00±					1
Sta. 88+00±		1			
Sta. 88+70±		1			
Sta. 92+00±		1			
Sta. 92+50±	1				
Sta. 93+00±		2			
Sta. 94+50±			2		
Sta. 97+20±			2		
Sta. 98+70±			2		
Sta. 100+20±			2		
TOTAL	2	6	8	1	1

STATE OF HAWAII
DEPARTMENT OF TRANSPORTATION
HIGHWAYS DIVISION

TYPICAL DETAILS & SCHEDULE

PALI HIGHWAY SIDEWALKS
Wyllie Street to Ahl Place
PROJ. NO. 61A-01-92

Scale: As Shown Date: Mar., 1992

SHEET No. 1 OF 1 SHEETS

5-13-92 Revised Utility Adjustment Schedule.
Add Typical Sidewalk Detail at
Bus Stop.

DATE REVISION