
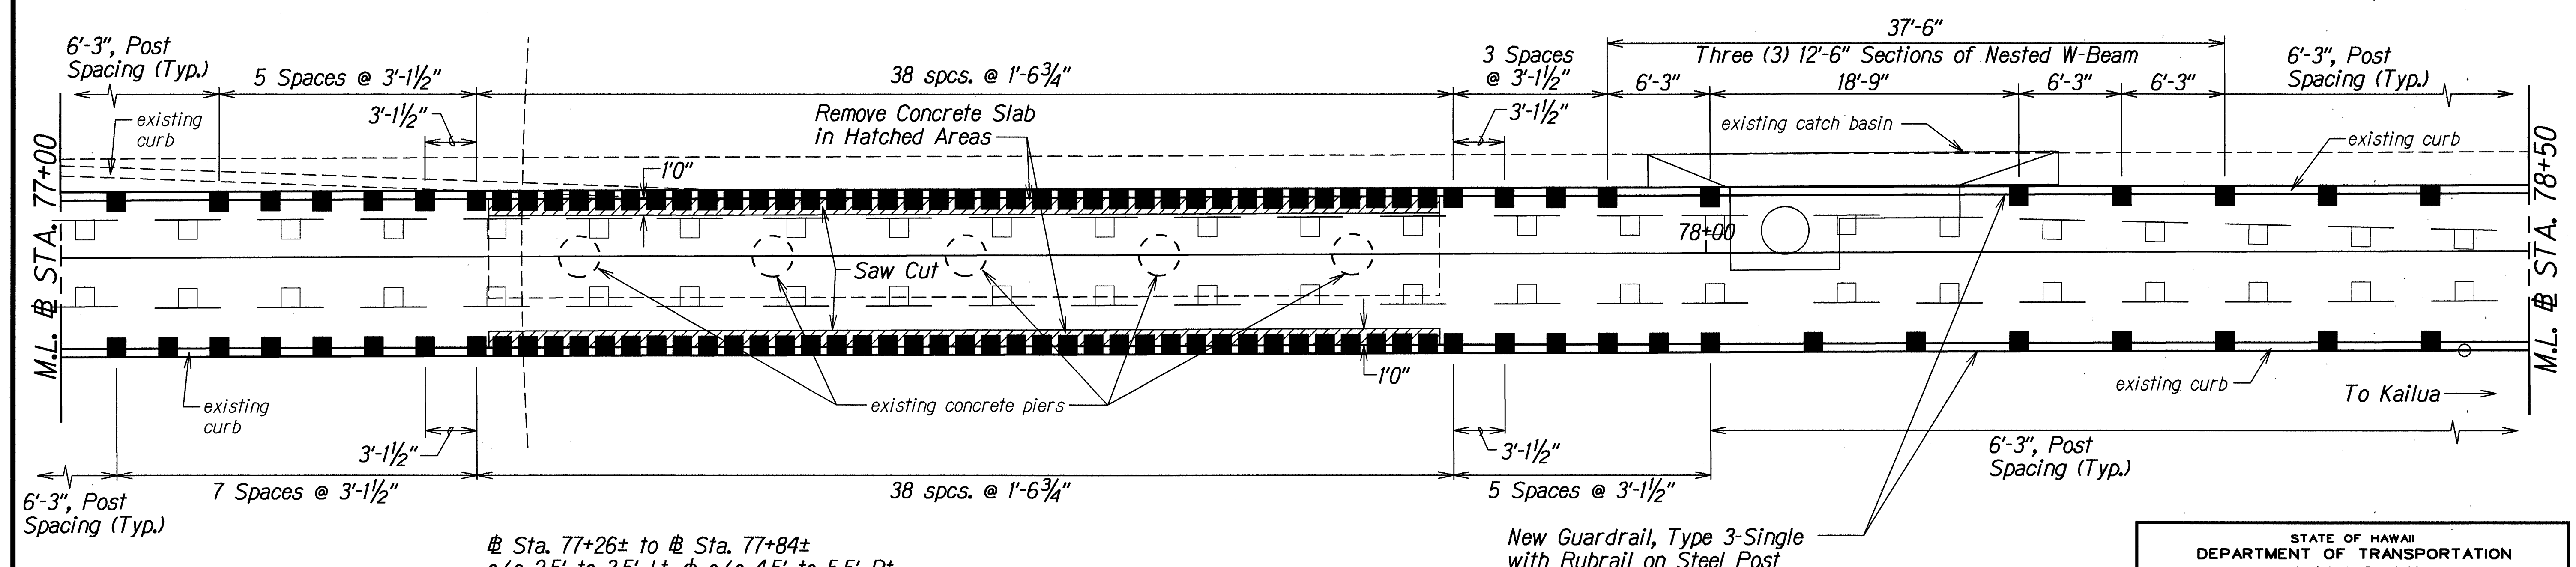


FED. ROAD DIST. NO.	STATE	FEDERAL AID PROJ. NO.	FISCAL YEAR	SHEET NO.	TOTAL SHEETS
HAWAII	HAW.	STP-061-1(30)	1993	11	41

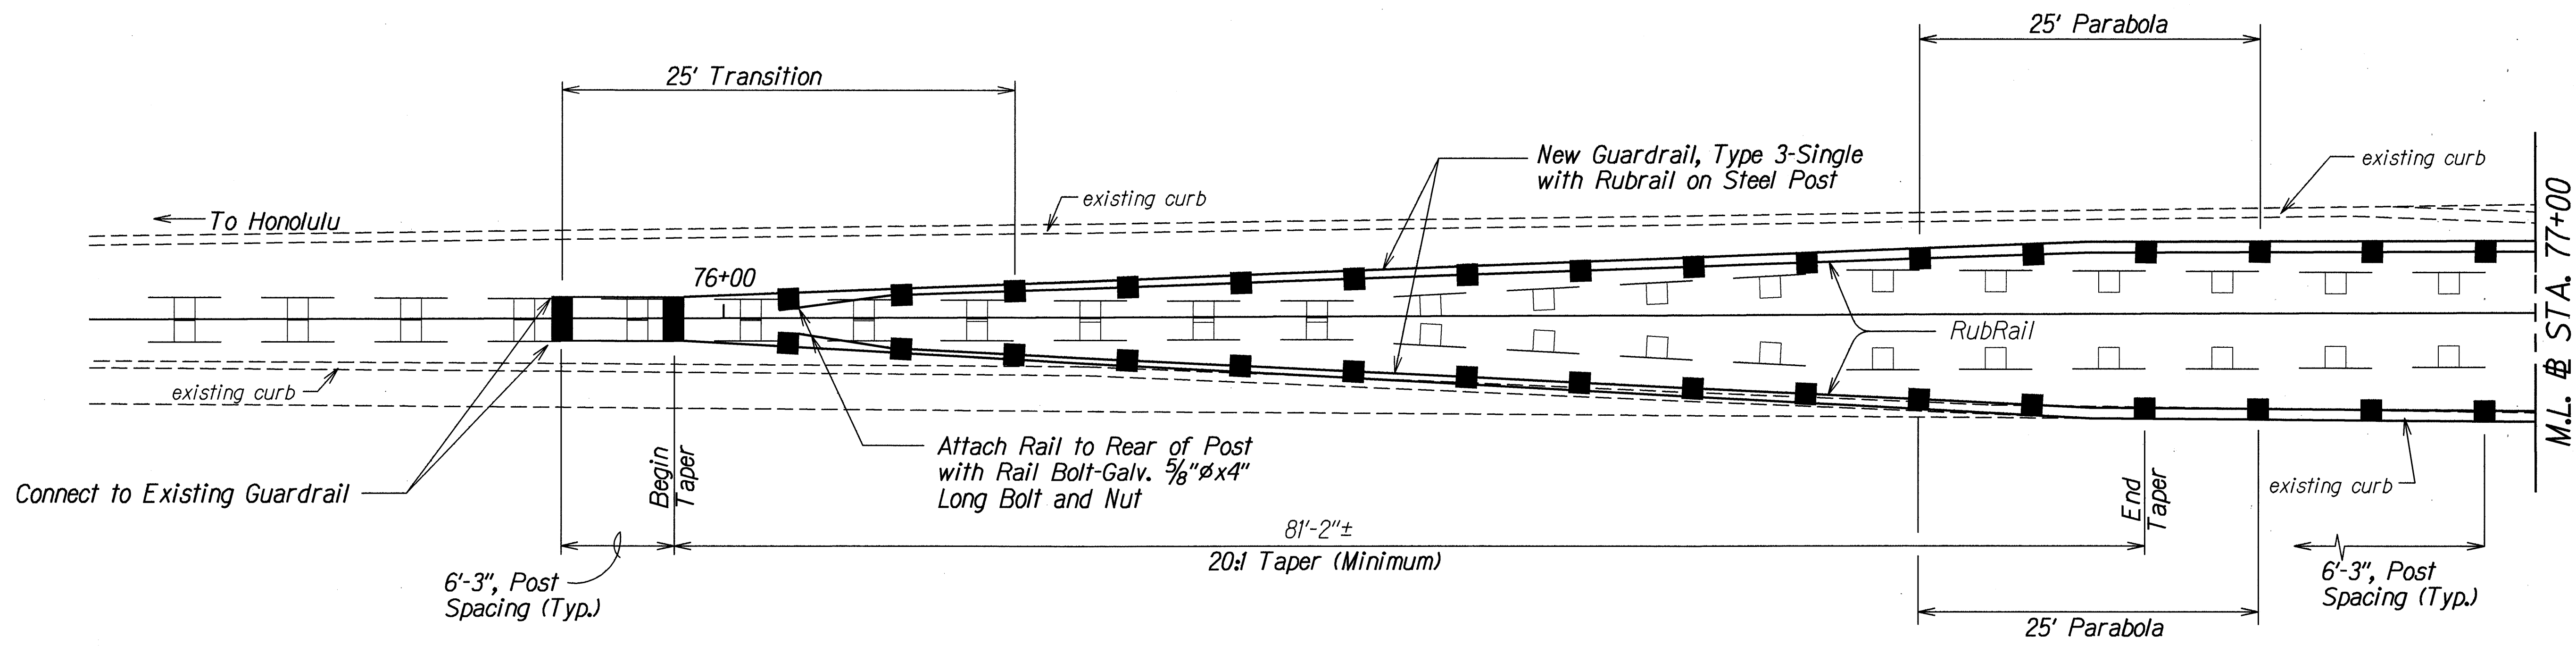

Sta. 77+26± to # Sta. 77+84±
o/s 2.5' to 3.5' Lt. # o/s 4.5' to 5.5' Rt.
Saw Cut and Remove 58± L.F. of existing
4" thick concrete median slab.
Install Metal Guardrail, as shown on this
sheet, and Backfill & Compact with
Asphalt Concrete Pavement, Mix No. IV.

New Guardrail, Type 3-Single
with Rubrail on Steel Post

STATE OF HAWAII
DEPARTMENT OF TRANSPORTATION
HIGHWAYS DIVISION
GUARDRAIL DETAIL AT
WYLLIE STREET OVERPASS
PALI HIGHWAY RESURFACING
Vineyard Blvd. to Country Club Rd.
F.A. Project No. STP-061-1(30)
Scale: 1"=5' Date: April 11, 1993
SHEET No. 1 OF 2 SHEETS

8/12/94
DATE
Additional work in median under
Wyllie Structure
REVISION

8/12/94	Additional work in median under Wyllie Structure
DATE	REVISION

ORIGINAL PLAN	SURVEY PLOTTED BY	DATE
DESIGNED BY	DRAWN BY	8/12/94
CHECKED BY	NOTED BY	
	DESIGNED BY	
	CHECKED BY	

