


INDEX TO DRAWINGS	
SHEET NO.	DESCRIPTION
1	TITLE SHEET
2	STANDARD PLANS SUMMARY
① 3	GENERAL NOTES & LEGEND
4	LEGEND
5 - 8	TYPICAL SECTIONS & DETAILS
9	TYPICAL DETAIL - INERTIAL BARRIER INSTALLATION
10	WHEELCHAIR RAMP DETAIL AND SCHEDULE
11 - 12	GUARDRAIL DETAIL AT WYLLIE STREET OVERPASS
13	GUARDRAIL SCHEDULE
14	UTILITY & MONUMENT ADJUSTMENT SCHEDULES
15 - 22	PLANS
23 - 26	GUARDRAIL CONNECTION DETAILS
② 27 - 41	PAVEMENT MARKING AND SIGNING PLANS, DETAILS AND SCHEDULES

Plan Shts. No ① ADD3S-I and ② C.O.4IS-I are supplementary sheets to this project.
TOTAL SHEET COUNT after "AS-BUILT" postings
43 Sheets.

HWY-DD/UNIT "A" JULIUS B. FRONDA 587-2246 April, 1993
DESIGNED BY P. S. & E. BY PHONE DATE

STATE OF HAWAII
DEPARTMENT OF TRANSPORTATION
HIGHWAYS DIVISION
HONOLULU, HAWAII
"AS-BUILT"
PLANS FOR
PALI HIGHWAY RESURFACING
VINEYARD BOULEVARD TO COUNTRY CLUB ROAD
FEDERAL AID PROJECT NO. STP-061-1(30)

DISTRICT OF HONOLULU
ISLAND OF OAHU

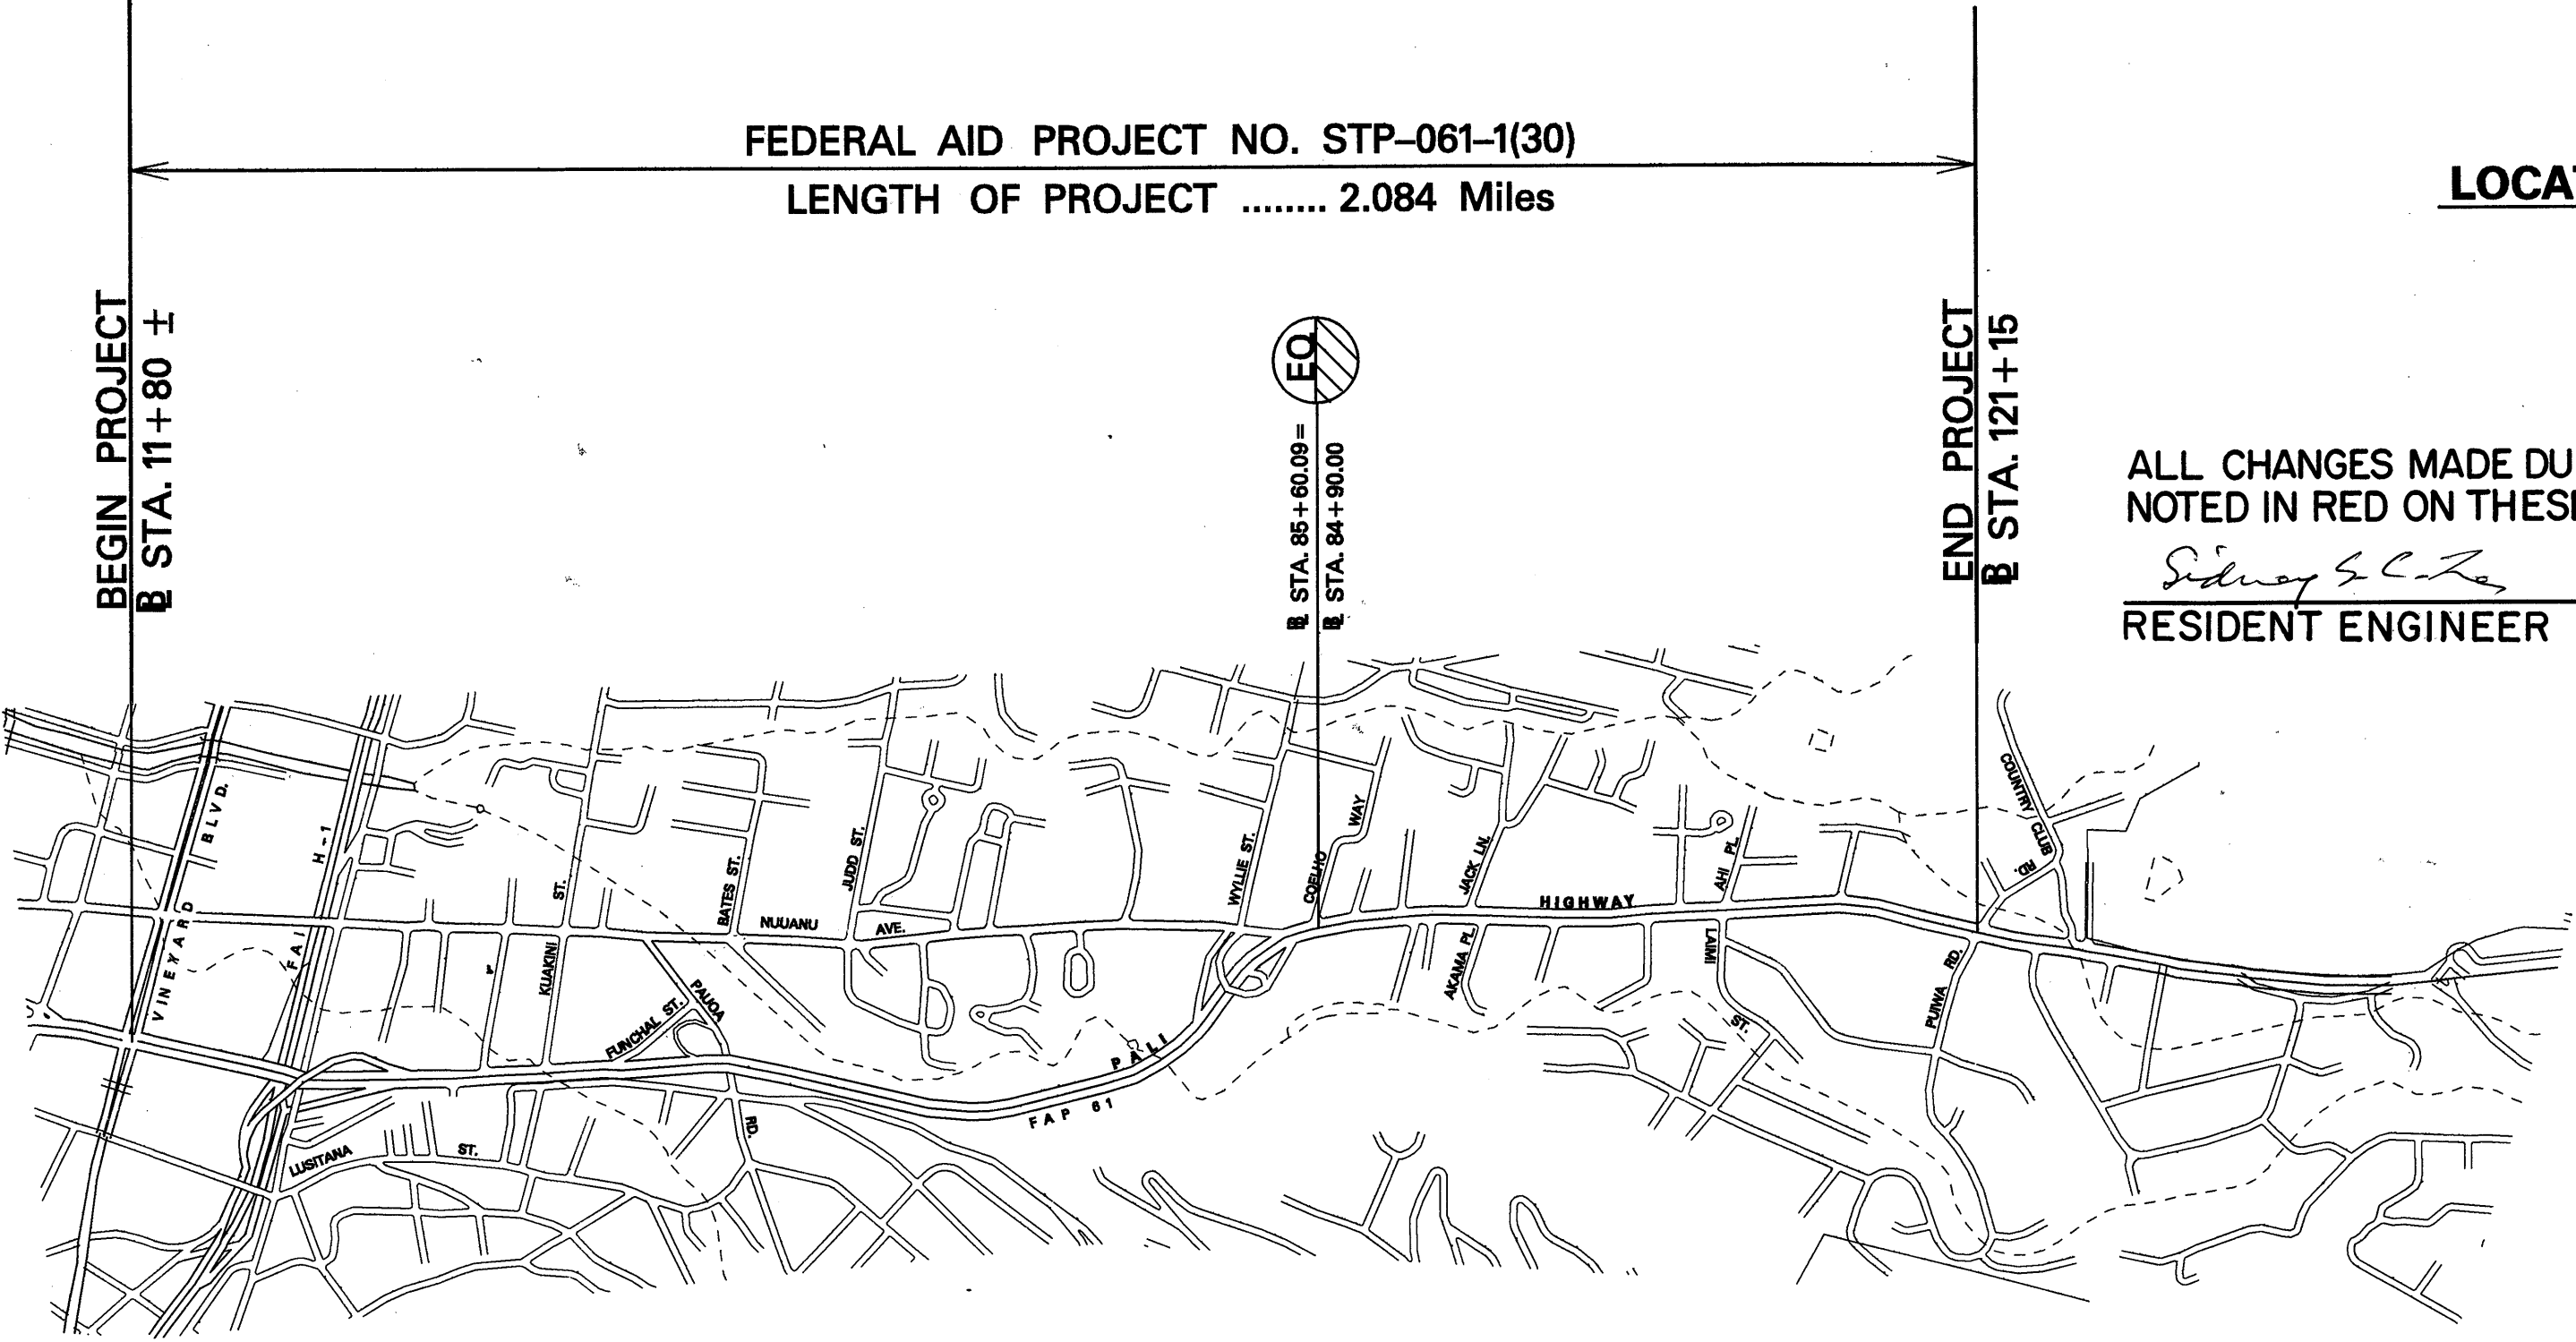


LAYOUT PLAN




GROSS LENGTH OF PROJECT.....2.084 MI.
LENGTH OF STRUCTURE.....0.055 MI.
NET LENGTH OF ROADWAY.....2.029 MI.

FED. ROAD DIST. NO.	STATE	FEDERAL AID PROJ. NO.	FISCAL YEAR	SHEET NO.	TOTAL SHEETS
HAWAII	HAW.	STP-061-1(30)	1993	1	41

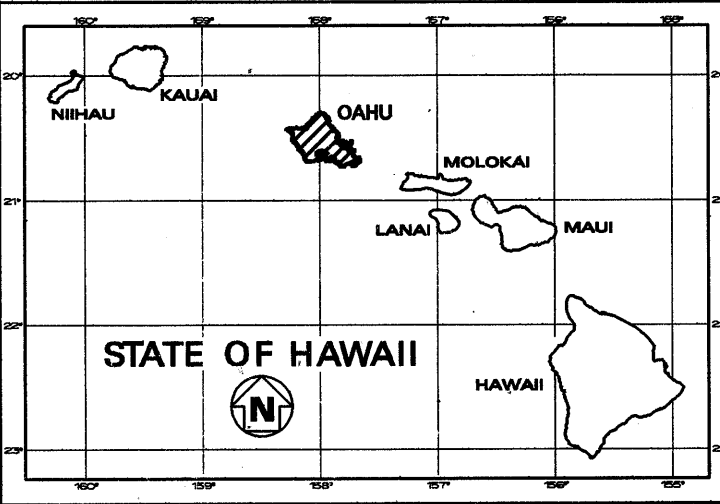

LOCATION OF PROJECT

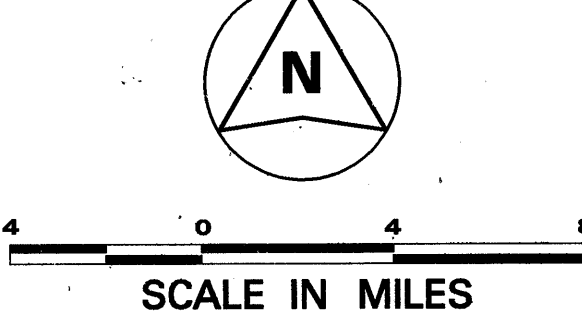

MILE POST 0.00 TO MILE POST 2.08

ALL CHANGES MADE DURING CONSTRUCTION HAVE BEEN NOTED IN RED ON THESE TRACINGS AND CHECKED BY
Sidney S. C. Lee 11/22/96
RESIDENT ENGINEER DATE

DESIGN DESIGNATION

	VINEYARD BLVD TO PALI INTERCHANGE	PALI INTERCHANGE TO COUNTRY CLUB ROAD
CURRENT ADT (1993)	31,100	68,100
DESIGN ADT (2013)	36,300	96,400
DHV	3,450	8,200
K	9.5	8.5
D	75/25	70/30
T	2.0%	2.5%
T ₂₄	3.0%	3.0%

DEPARTMENT OF TRANSPORTATION
FEDERAL HIGHWAY ADMINISTRATION
APPROVED: *Abraham Wong* 5/17/93
DIVISION ADMINISTRATOR DATE

DEPARTMENT OF TRANSPORTATION
STATE OF HAWAII
APPROVED: *T. Haruna* 5/14/93
DIR. OF TRANSPORTATION DATE