


FED. ROAD DIST. NO.	STATE	PROJ. NO.	FISCAL YEAR	SHEET NO.	TOTAL SHEETS
HAWAII	HAW.	61A-02-91	1992	3	4

GENERAL NOTES

1. The scope of work for this project consists of constructing a 4-foot wide bituminous sidewalk, a 4-foot wide concrete sidewalk, curbing and pavement striping.
2. The existence and location of underground utilities, appurtenances and structures as shown on the plans are from the latest available data but the accuracy is not guaranteed. The encountering of other obstacles during the course of the work is possible. The Contractor shall be held liable for any damages incurred to the existing facilities and/or improvements as a result of his operations.
3. The exact limits of constructing the specified items are approximate. The exact locations shall be determined in the field by the Engineer.
4. The Contractor's attention is directed to Subsection 107.13-Public Convenience and Safety, Section 645-Traffic Control and Subsection 107.21-Contractor's Responsibility for Utility Property and Service of the Special Provisions.
5. Dressed sidewalk shall consist of cleaning, grubbing, grading, reshaping and compacting the unpaved edge of sidewalk with suitable excavated material as shown on the plans and/or as directed by the Engineer. This work shall be considered incidental to the various contract items.
6. Removal of existing asphalt concrete sidewalk shall be considered incidental to Item No. 608.0200, Plain Concrete Sidewalk.
7. The Contractor shall provide safe access for pedestrians at all times during construction.


NOTES

1. The Contractor will be responsible for coordinating with Hawaiian Electric Company (HECO) when to have them adjust their own pullbox to meet the grade of the new concrete sidewalk. Contact person at HECO is Homer Gibbs, phone no. 543-7871.
2. The Contractor will be responsible for filling in gaps in existing lava rock curbing with mortar mix or concrete.

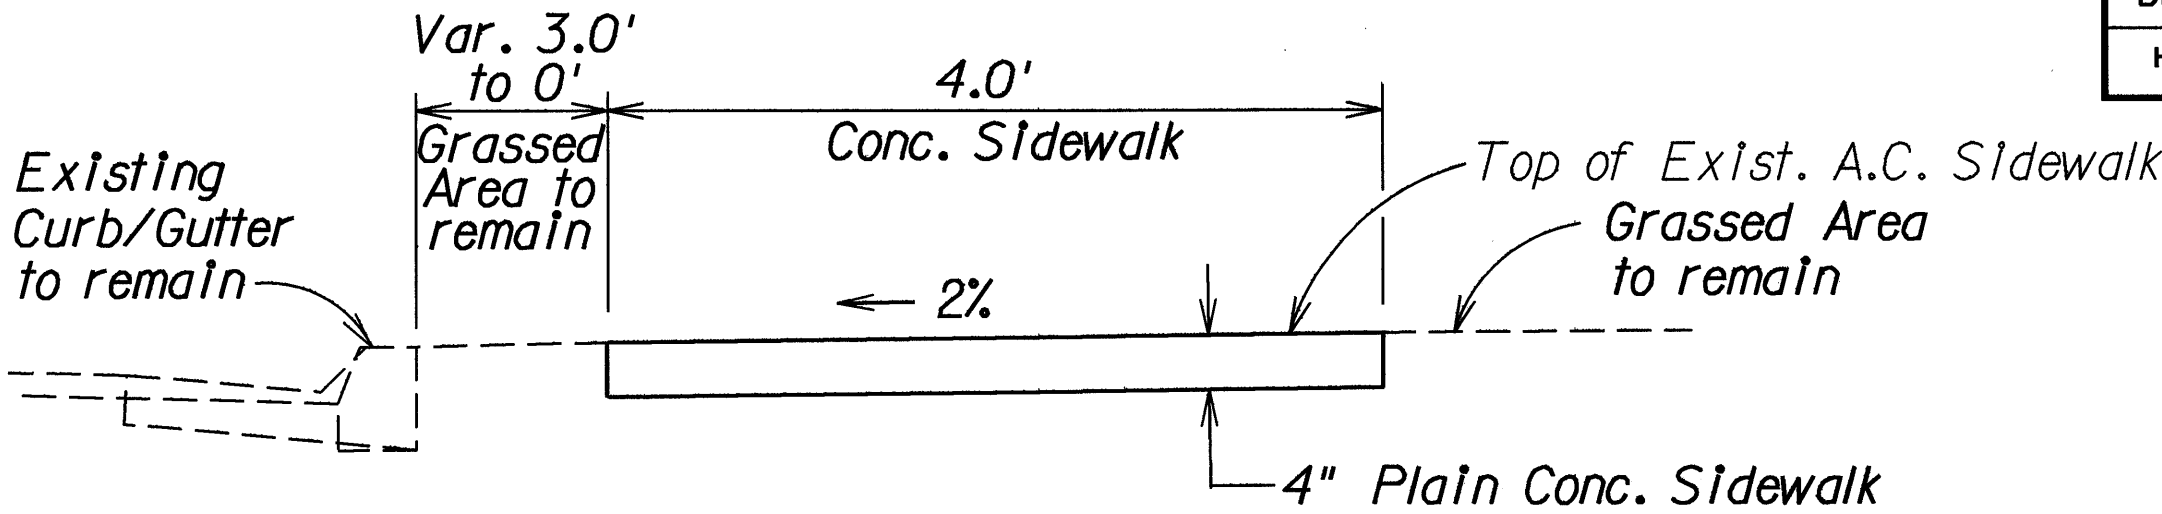


TYPICAL CONCRETE SIDEWALK SECTION

Not to Scale

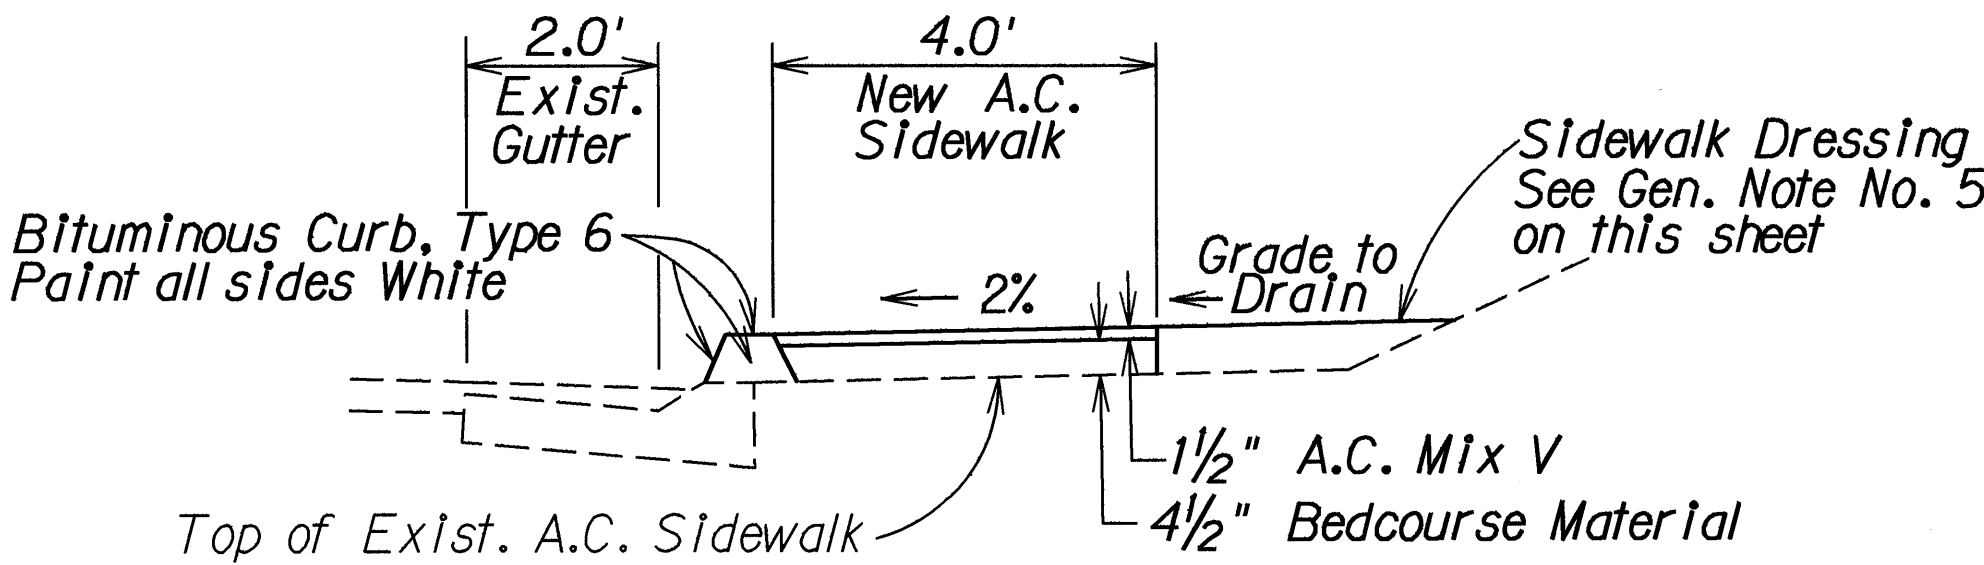

TYPICAL A.C. SIDEWALK SECTION

Not to Scale

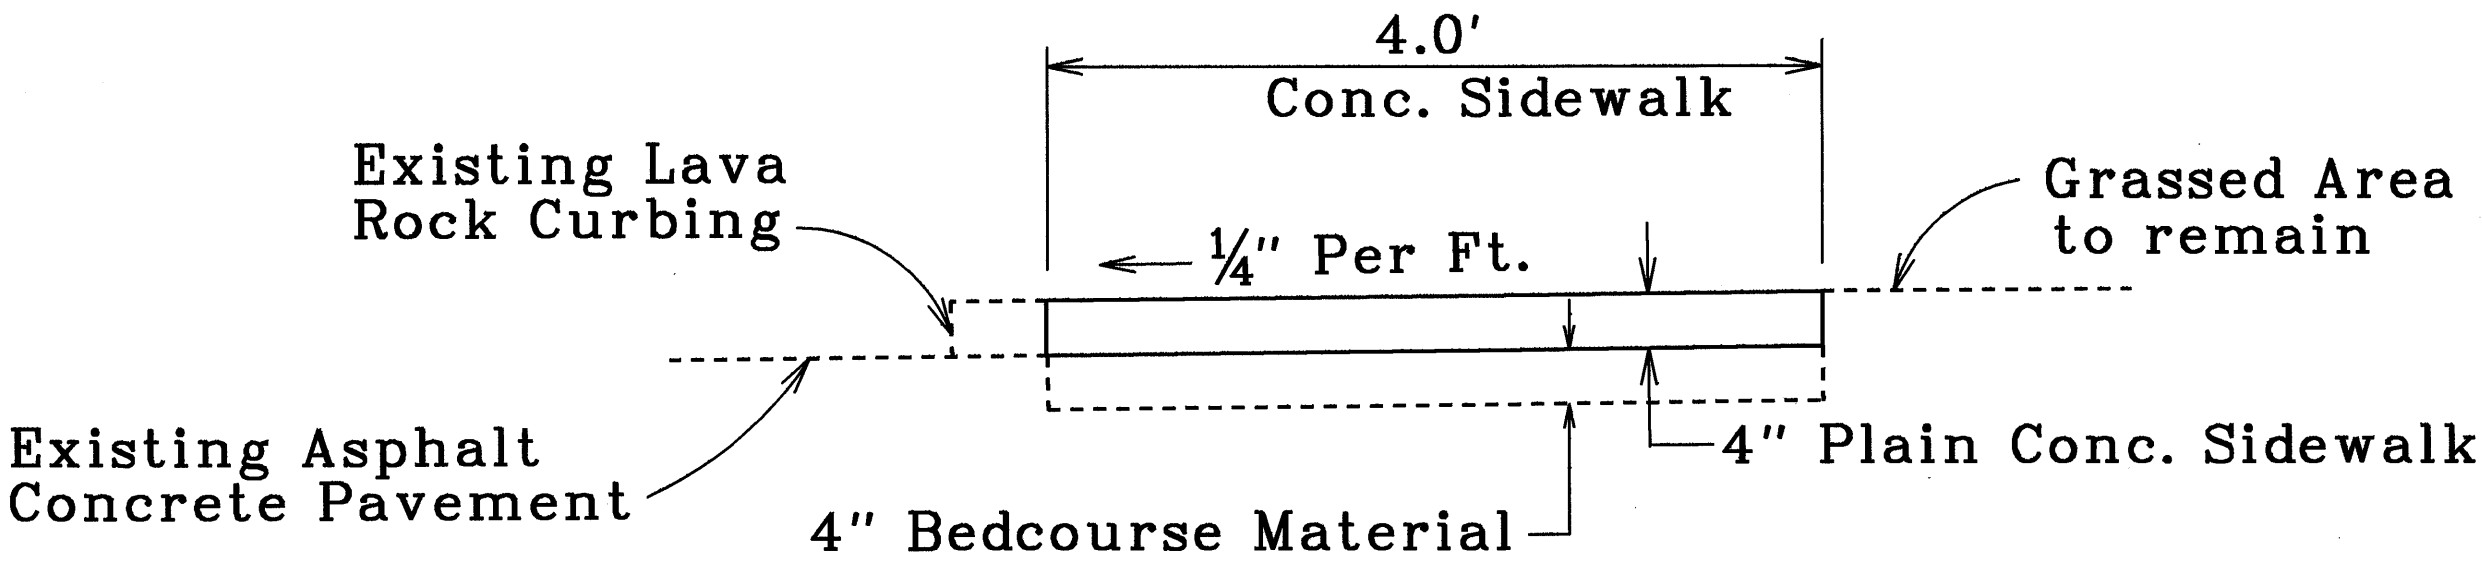

TYPICAL CONCRETE SIDEWALK SECTION

FOR C.C.O. #1 WORK

Not to Scale

LEGEND FOR  
AS-BUILT POSTINGS

- ~~~~~ Squiggly line for as-built deletion
- == Double line for as-built deletion
- Roadway Text for as-built posting

STATE OF HAWAII  
DEPARTMENT OF TRANSPORTATION  
HIGHWAYS DIVISION  
**GENERAL NOTES AND  
MISCELLANEOUS DETAILS**

**PALI HIGHWAY SIDEWALK**  
**Philippine Consulate to Hawaii Baptist Academy**  
**PROJECT NO. 61A-02-91**

Scale: As Shown Date: Oct., 1991

SHEET No. 1 OF 1 SHEETS

AS-BUILT