	INDEX TO DRAWINGS
SHEET NO.	DESCRIPTION
1	TITLE SHEET
2	STANDARD PLANS SUMMARY
3	GENERAL NOTES & LEGEND
① 4	TYPICAL SECTION & MISC. DETAILS
5 – 11	PLANS

① Plan Sheet Nos. C.0.4S-1 & C.0.4S-2 are Supplementary sheets original contract

plans.

STATE OF HAWAII

DEPARTMENT OF TRANSPORTATION

HIGHWAYS DIVISION
HONOLULU, HAWAII
''AS-BUILT''
PLANS FOR

PALI HIGHWAY SIDEWALKS

PHILIPPINE CONSULATE TO PUIWA ROAD & AHI PLACE TO COUNTRY CLUB ROAD FEDERAL AID PROJECT NO. STP-061-1(31)

DISTRICT OF HONOLULU ISLAND OF OAHU

Scale: 1"=500'


New Total = 13

LIMITS OF PROJECT

THO HOP BE AND A STATE OF PROJECT

THE HOP BE AND A

SCALE IN HUNDRED FEET

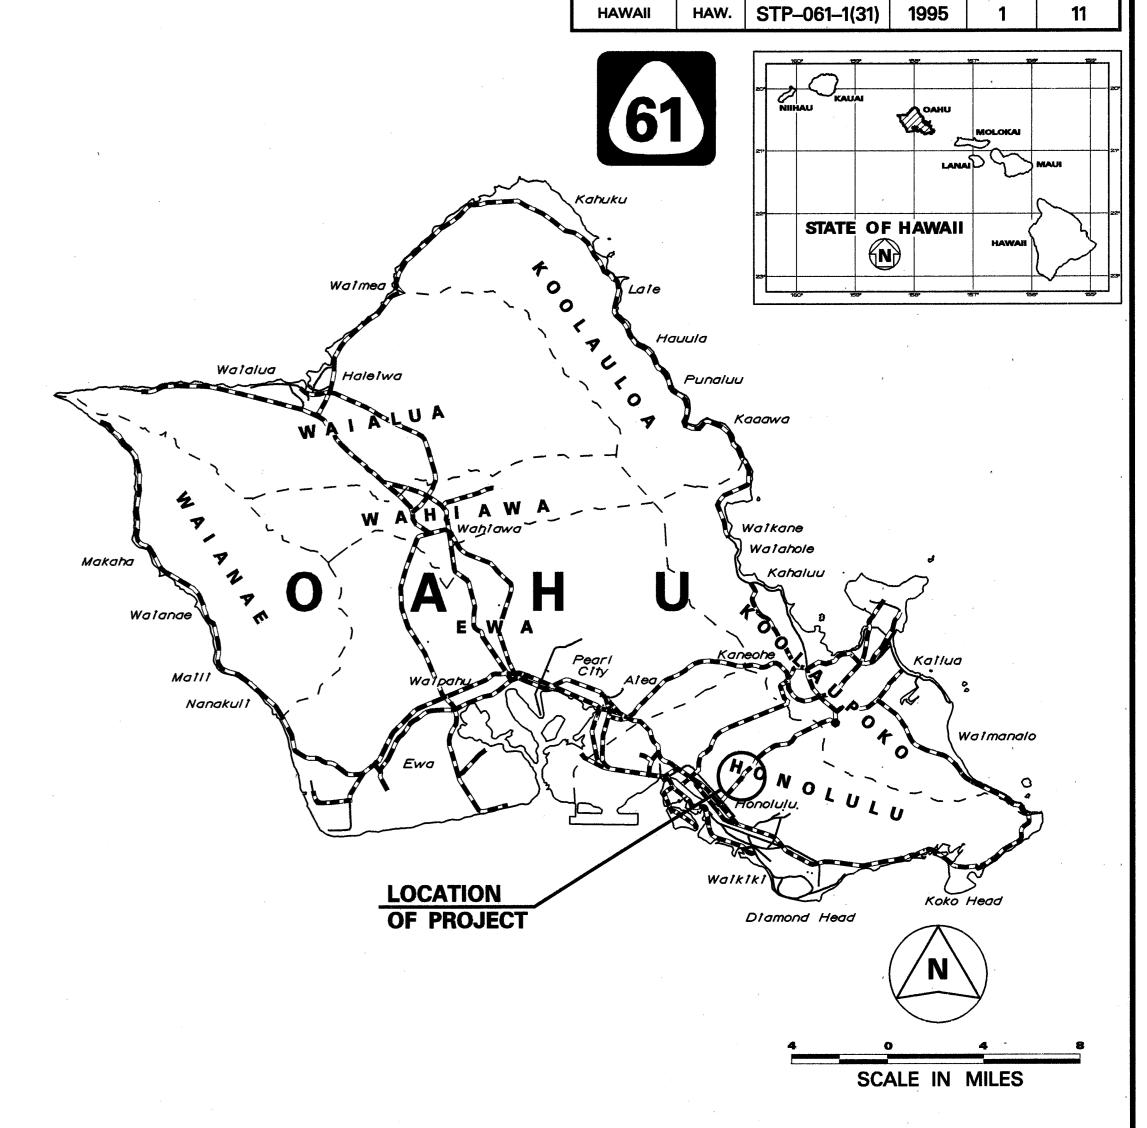

FED. ROAD DIST. NO. FED. AID PROJ. NO.

---- FEDERAL AID PROJECTS PREVIOUSLY CONSTRUCTED OR UNDER CONSTRUCTION

MILE POST 1.34 TO MILE POST 2.08

CHANGES MADE DURING CONSTRUCTION HAVE BEEN INCORPORATED ON THESE PLANS EXCEPT CHANGES IN THE ORIGINAL THEORETICAL QUANTITIES. FOR ACTUAL QUANTITIES, REFER TO PROJECT LEDGER AND/OR COMPUTATION BOOK.

RESIDENT ENGINEER

DATE

DEPARTMENT OF TRANSPORTATION STATE OF HAWAII

APPROVED:

They Hayarhih 1/19

1