


FED. ROAD DIST. NO.	STATE	FED. AID PROJ. NO.	FISCAL YEAR	SHEET NO.	TOTAL SHEETS
HAWAII	HAW.	STP-061-1(27)	1992	10	18

TRUE NORTH
SCALE: 1"=20'

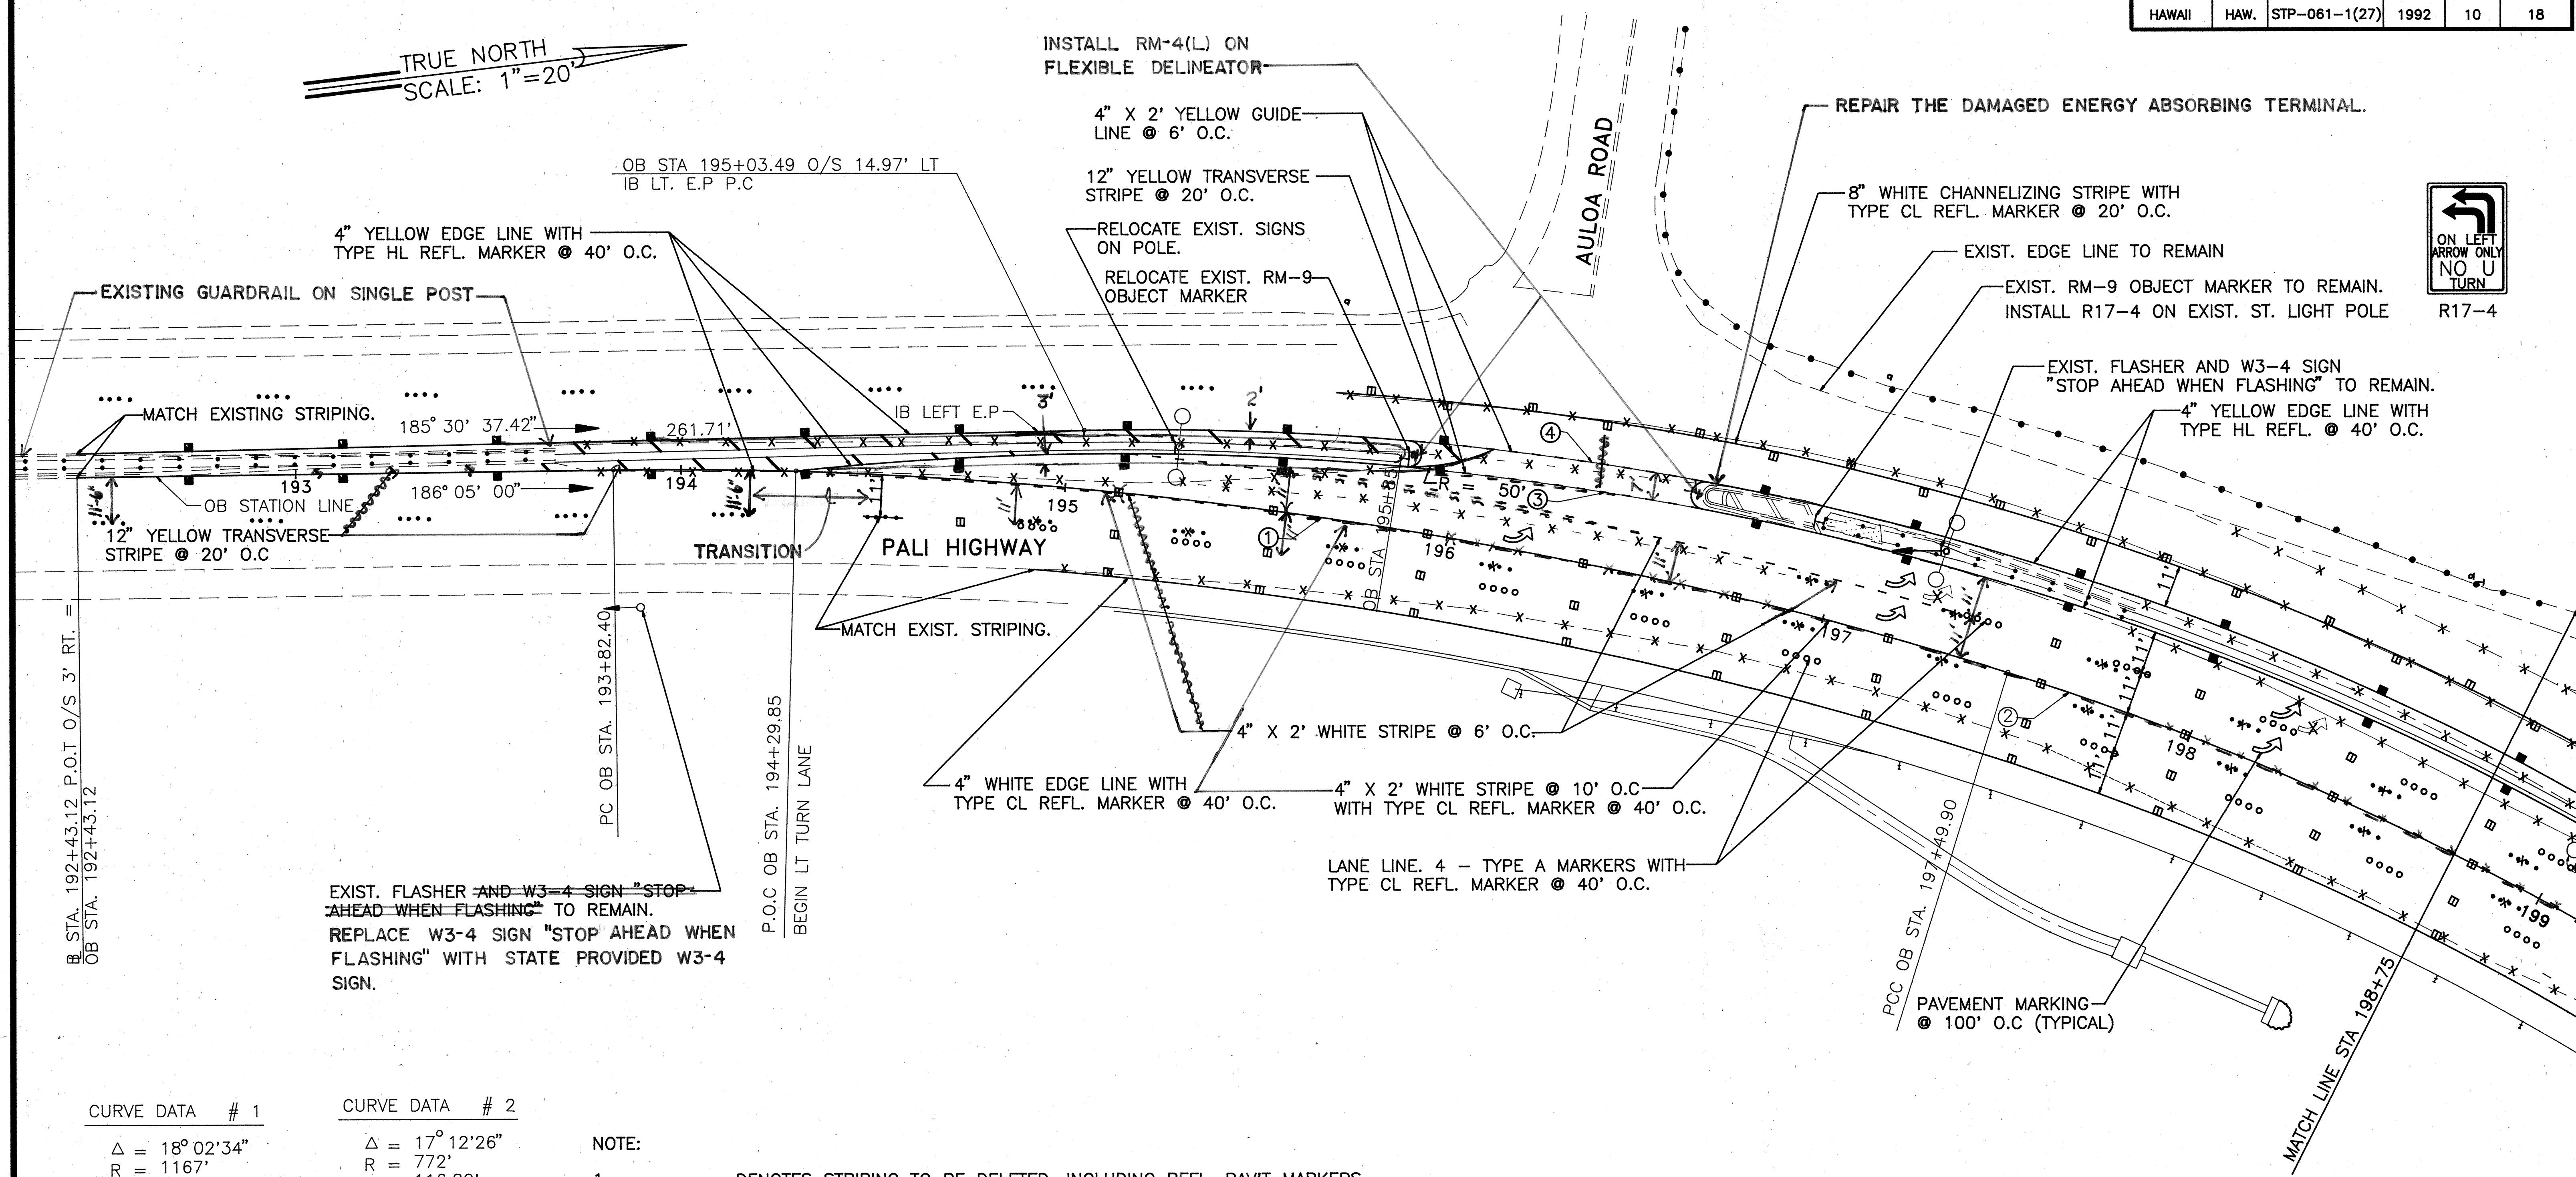

CURVE DATA # 1

Δ = 18° 02' 34"
R = 1167'
T = 185.28'
L = 367.50'
C = 365.98'

CURVE DATA # 2

Δ = 17° 12' 26"
R = 772'
T = 116.80'
L = 231.85'
C = 230.98'


CURVE DATA # 3

Δ = 35° 49' 23"
R = 794.00'
T = 256.43'
L = 496.43'
C = 488.39'

CURVE DATA # 4

Δ = 35° 49' 23"
R = 775'
T = 250.49'
L = 484.55'
C = 476.70'

- NOTE:
- x — DENOTES STRIPING TO BE DELETED, INCLUDING REFL. PAV'T MARKERS.
 - EXCEPT AS NOTED, ALL EXISTING SIGNS AND OBJECT MARKERS TO REMAIN.
 - EXCEPT AS NOTED, ALL EXISTING STRIPING WHICH ARE TO REMAIN BETWEEN OB STA. 192+43.12 AND OB STA. 205+00 AND KANEHOE BOUND LANES OF KAMEHAMEHA HIGHWAY BETWEEN STA. 158+00 AND STA. 161+60 SHALL BE RESTRIPE AND MISSING OR DAMAGED MARKERS REPLACED.

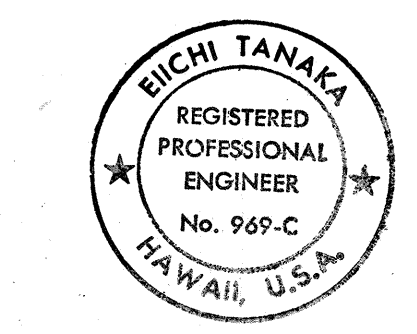

THIS WORK WAS PREPARED BY ME
OR UNDER MY SUPERVISION
Eichi Tanaka
Signature

STATE OF HAWAII
DEPARTMENT OF TRANSPORTATION
HIGHWAYS DIVISION

SIGNS AND MARKINGS

PALI HIGHWAY
INTERSECTION IMPROVEMENTS AT
KAMEHAMEHA HIGHWAY

F.A. PROJECT NO. STP-061-1(27)

SCALE: AS SHOWN DATE: MAY 1992

SHEET NO. 1 OF 2 SHEETS

FED. ROAD DIST. NO.	STATE	FED. AID PROJ. NO.	FISCAL YEAR	SHEET NO.	TOTAL SHEETS
HAWAII	HAW.	STP-061-1(27)	1992	11	18

NOTE :


1. ALL EXISTING SIGNS AND REFLECTORS TO REMAIN, EXCEPT AS NOTED.
2. ALL PAV'T MARKINGS TO REMAIN EXCEPT THOSE MARKED X WHICH SHALL BE DELETED.



CURVE DATA # 7

Δ = 82° 20' 19"
R = 35'
T = 30.61'
L = 50.30'
C = 46.08'

TRUE NORTH
SCALE: 1" = 20'

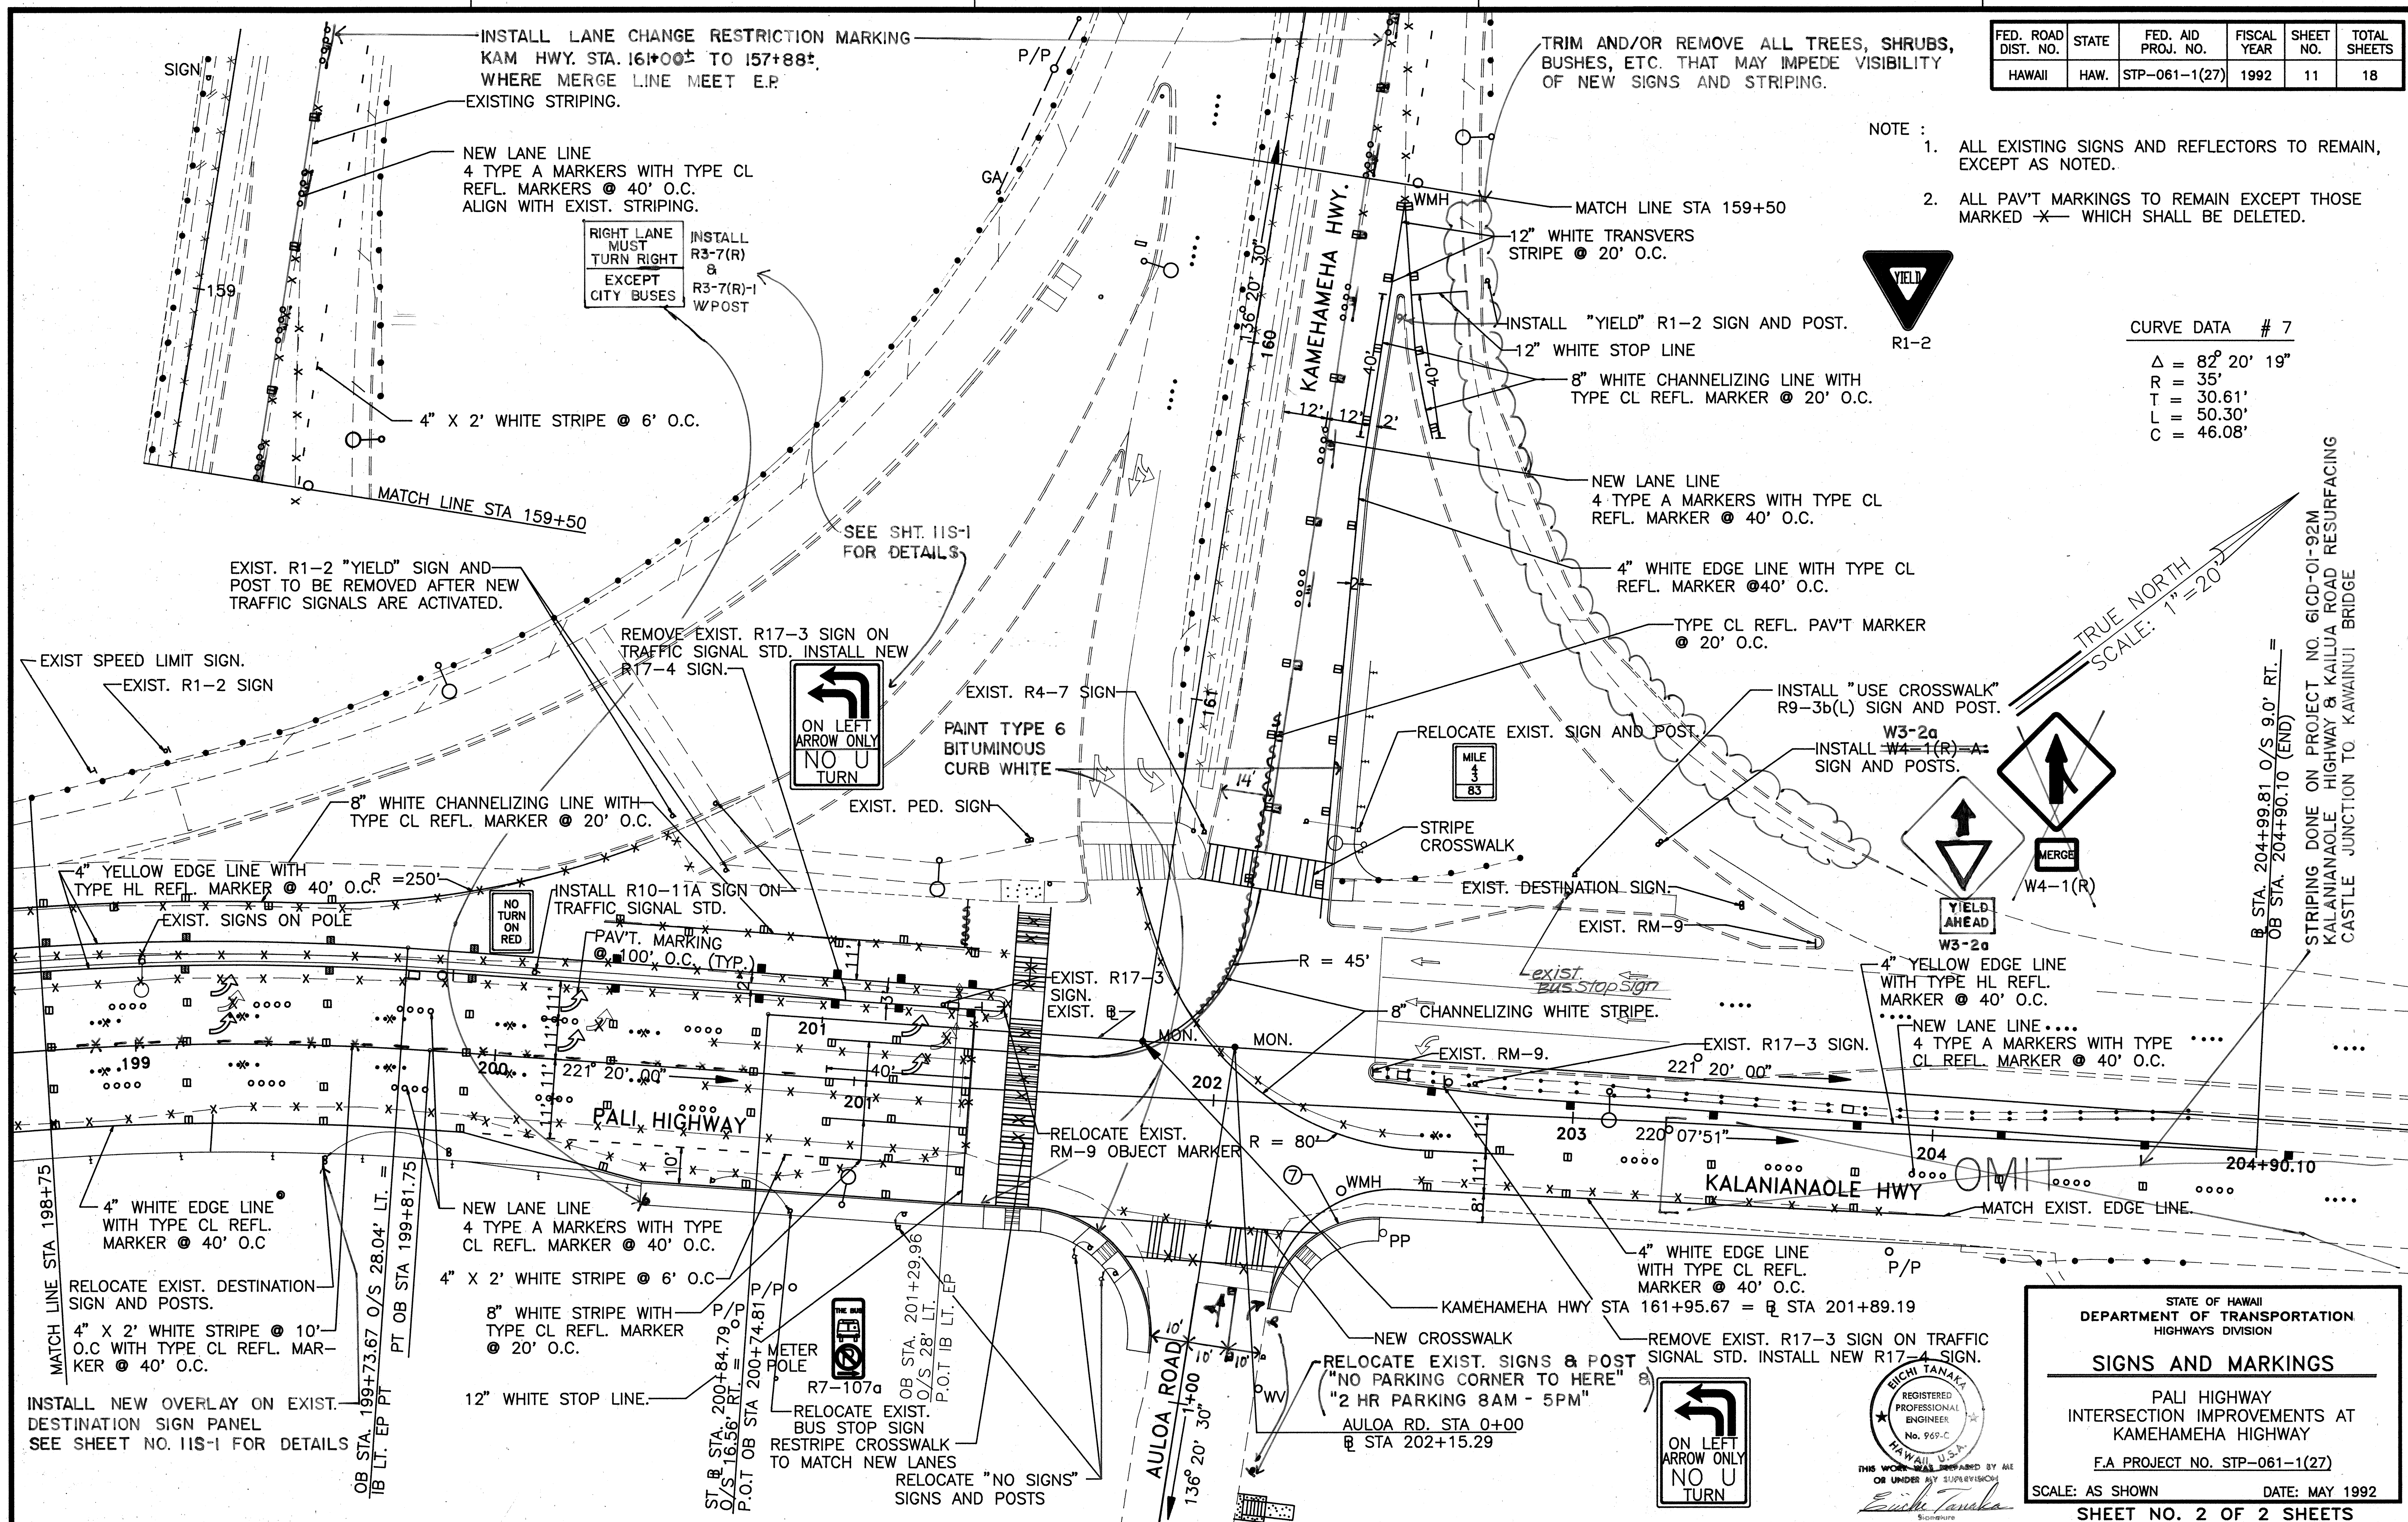

STATE OF HAWAII
DEPARTMENT OF TRANSPORTATION
HIGHWAYS DIVISION

SIGNS AND MARKINGS


PALI HIGHWAY
INTERSECTION IMPROVEMENTS AT
KAMEHAMEHA HIGHWAY

F.A. PROJECT NO. STP-061-1(27)

SCALE: AS SHOWN DATE: MAY 1992




SHEET NO. 2 OF 2 SHEETS

FED. ROAD DIST. NO.	STATE	PROJ. NO.	FISCAL YEAR	SHEET NO.	TOTAL SHEETS
HAWAII	HAW.	STP-061-11(27)	1992	11 S-1	

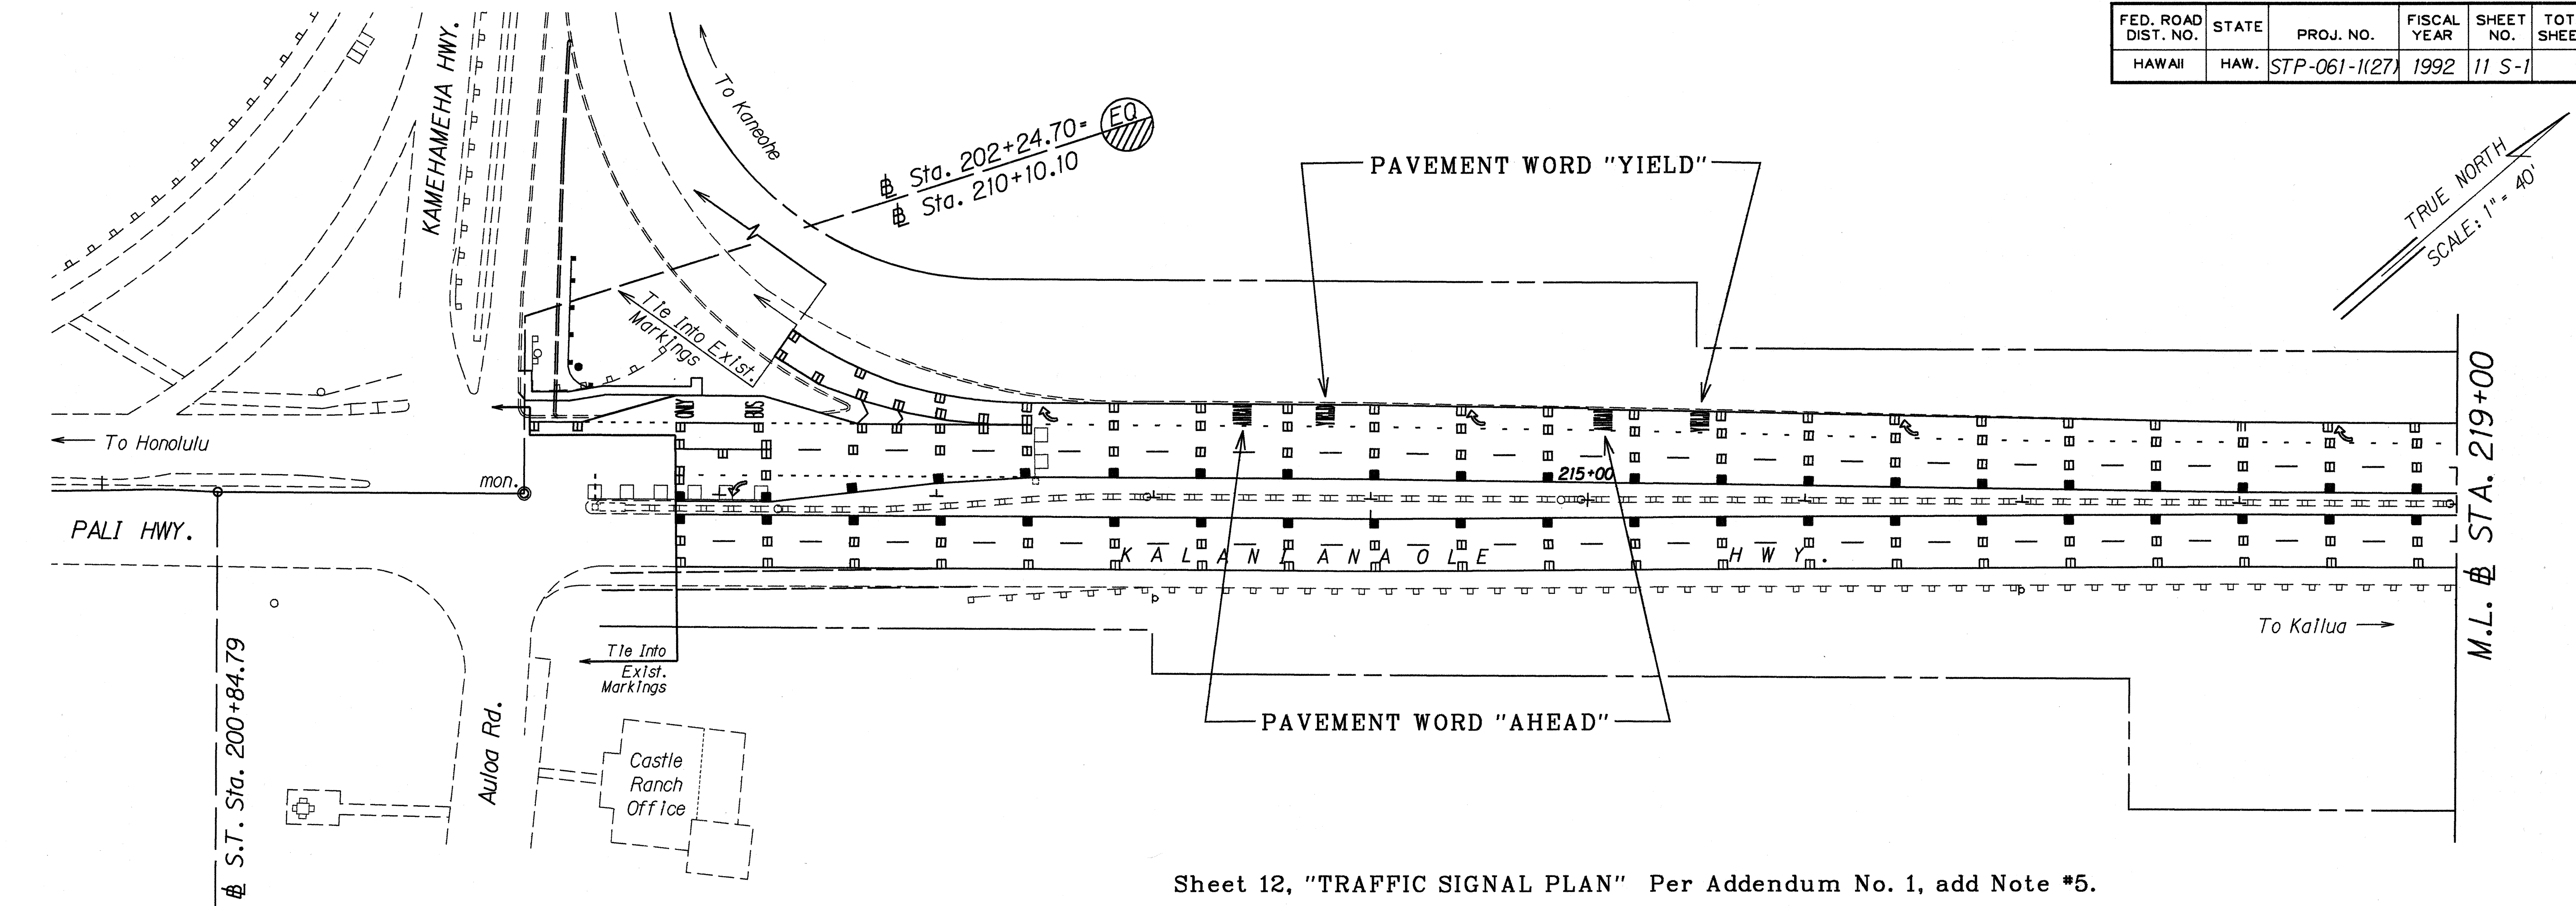

Sheet 12, "TRAFFIC SIGNAL PLAN" Per Addendum No. 1, add Note #5.

5. Furnish and install one (1) additional 2" conduit along conduit runs shown on the plan between the controller (OB Sta. 202+50, 67' LT) and the power source pole (OB Sta. 200+87, 60' RT). Also furnish and install one (1) TYPE B pullbox at the power source end of the conduit. The conduit and pullbox will be paid for at the lump sum price under Item 623.5038 of the proposal.

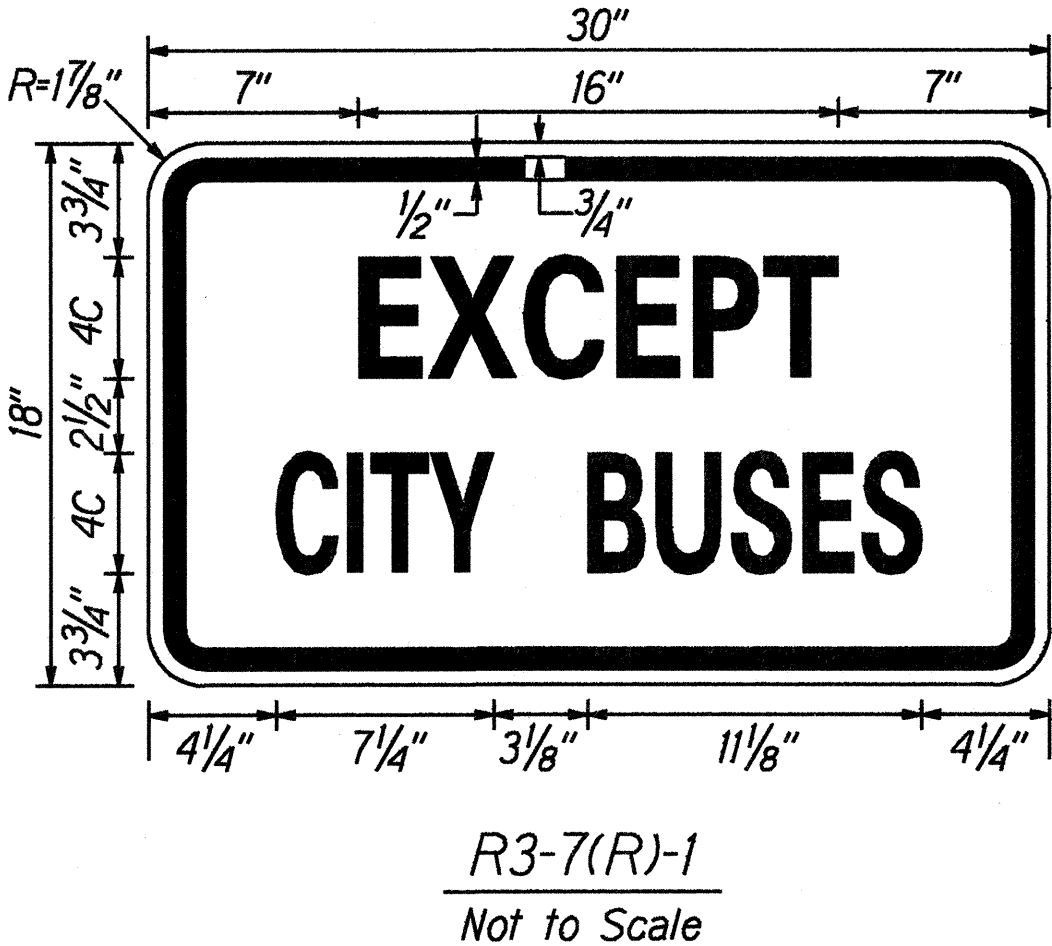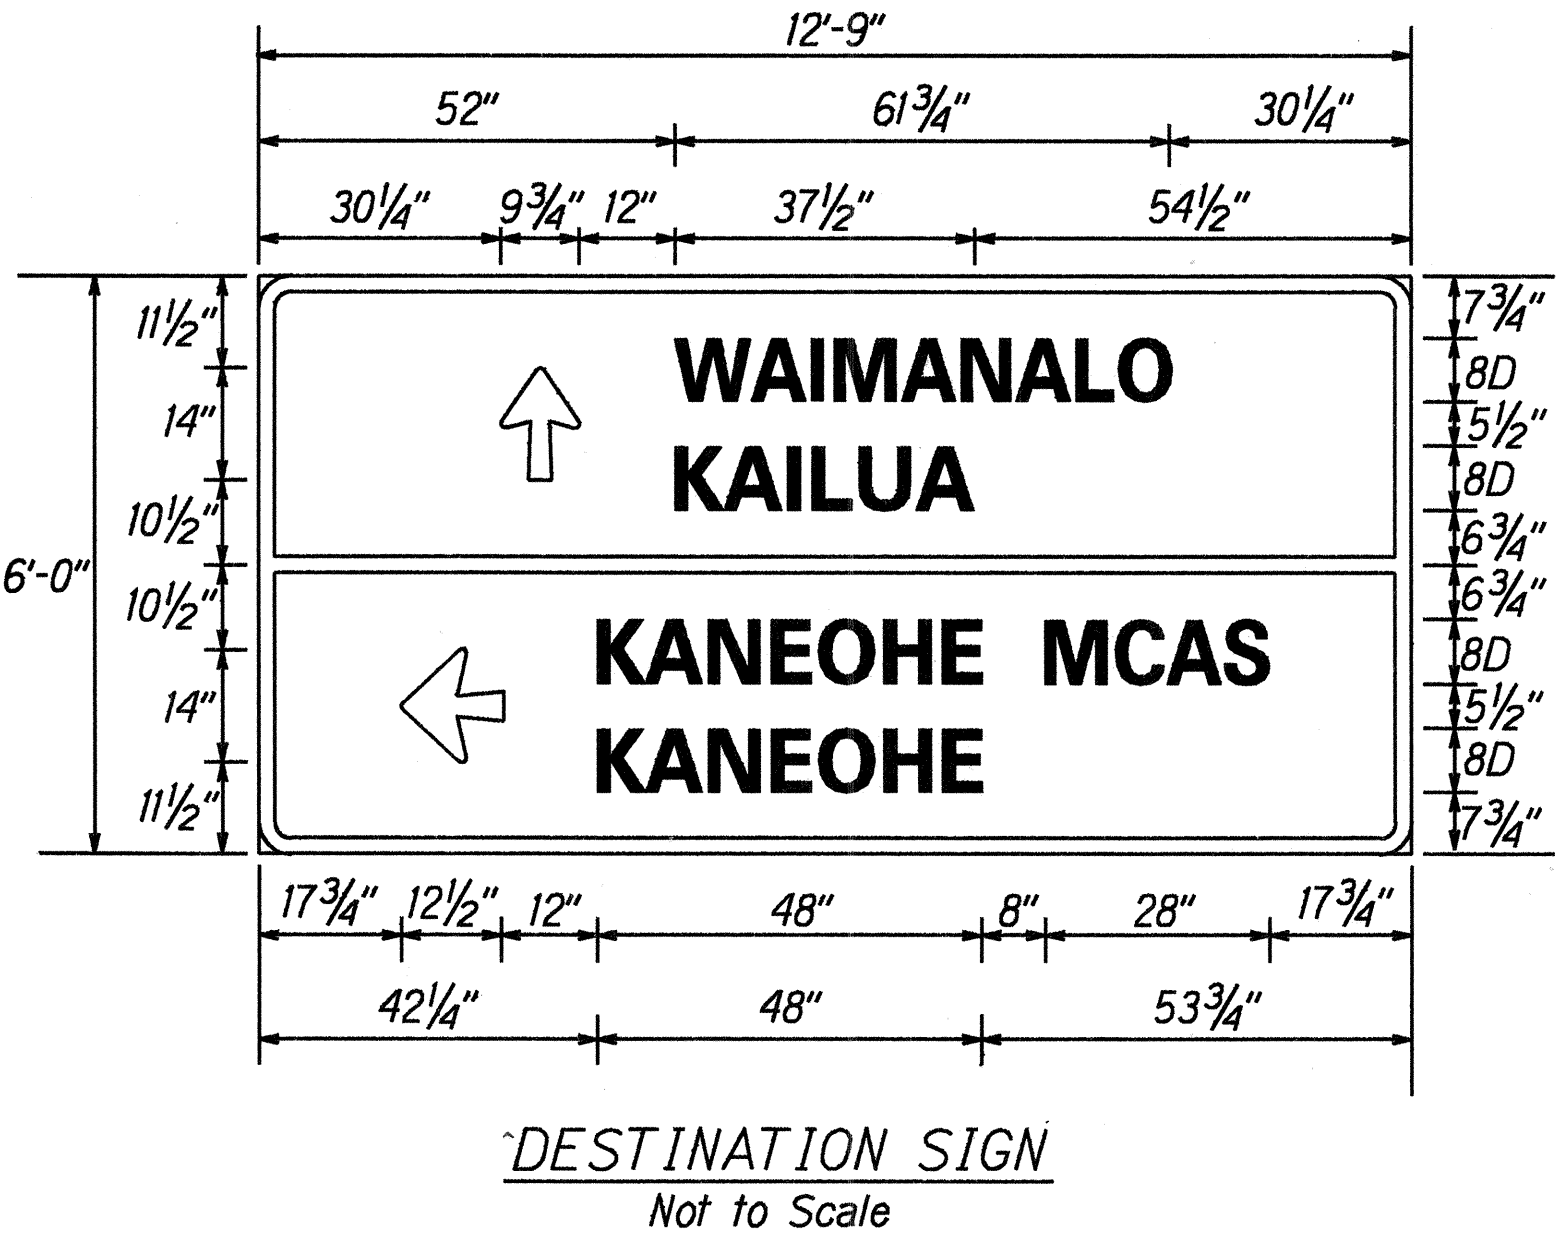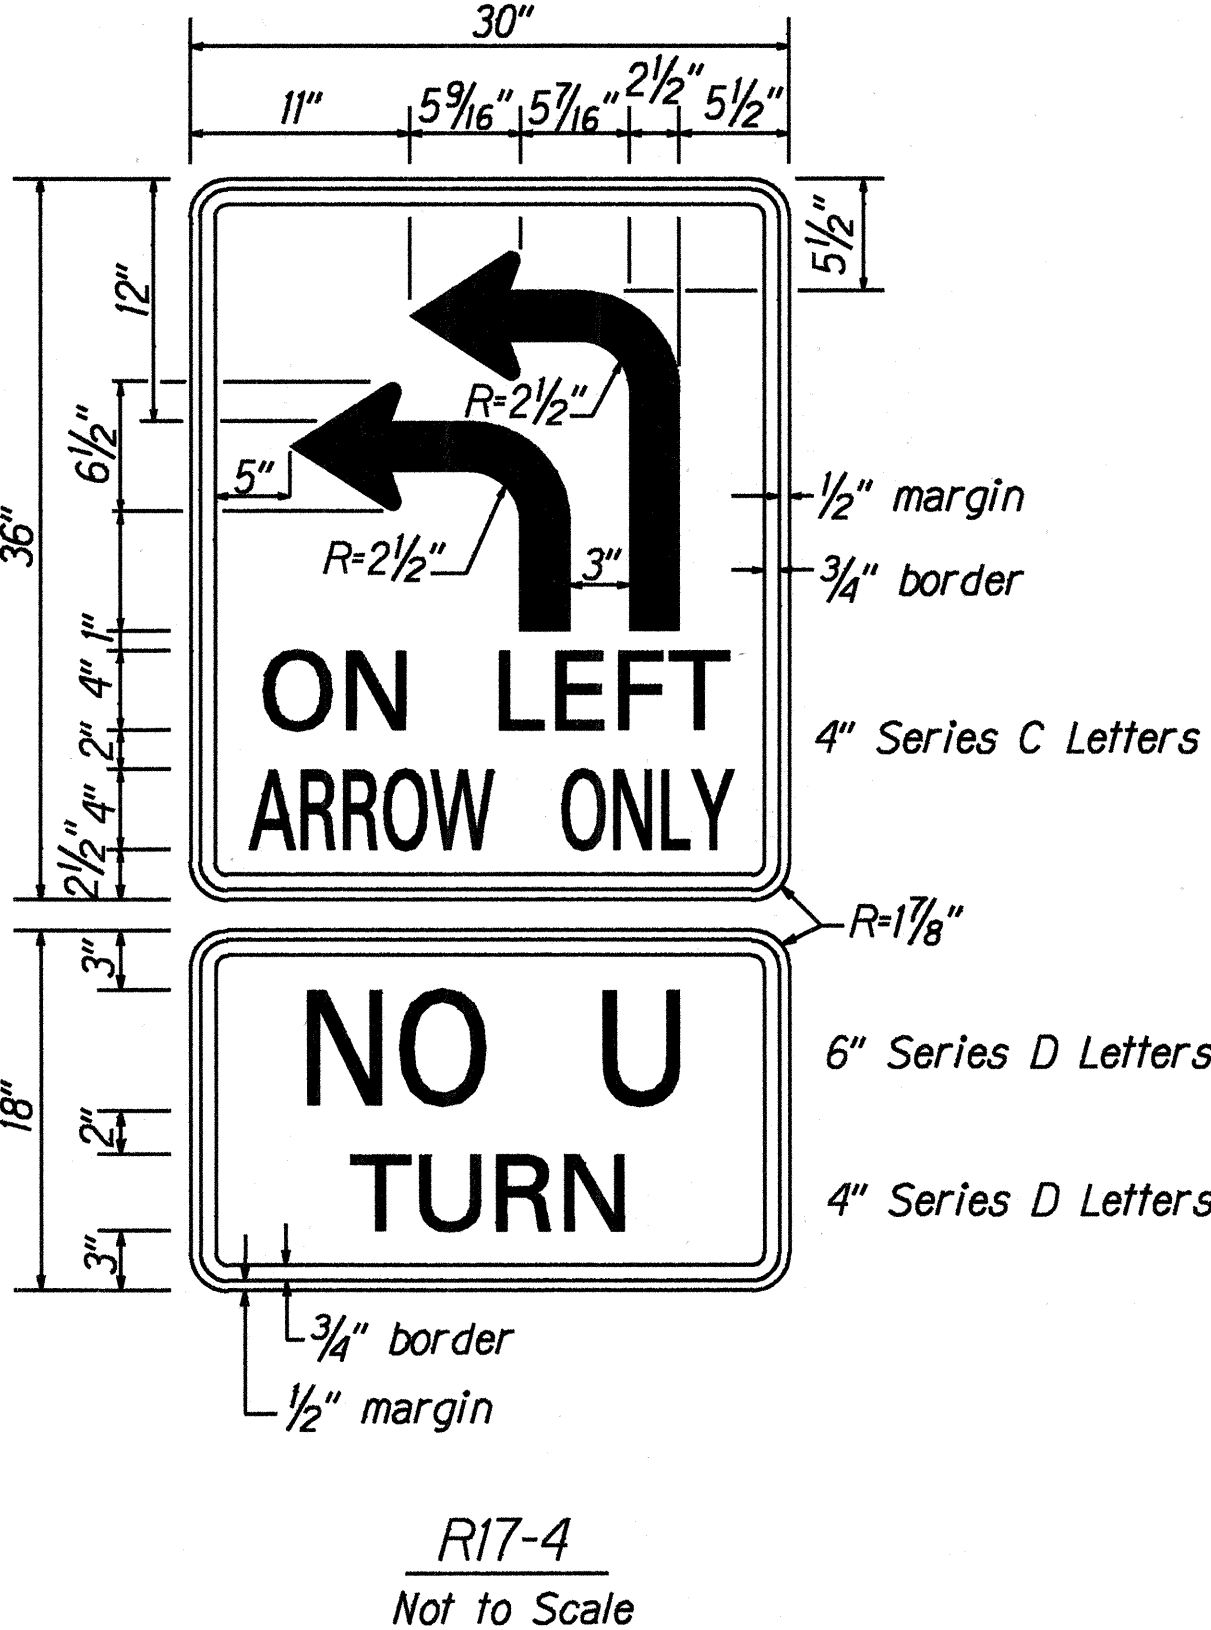

LEGEND FOR AS-BUILT POSTINGS	
	Squiggly line for as-built deletion
	Double line for as-built deletion
	Text for as-built posting

STATE OF HAWAII
DEPARTMENT OF TRANSPORTATION
HIGHWAYS DIVISION

SIGNS & MARKINGS

PALI HIGHWAY
INTERSECTION IMPROVEMENTS AT
KAMEHAMEHA HIGHWAY
Fed. Aid Project No. STP-061-11(27)

Scale: 1" = 40'
Date: May, 1992
SHEET No. X OF X SHEETS