
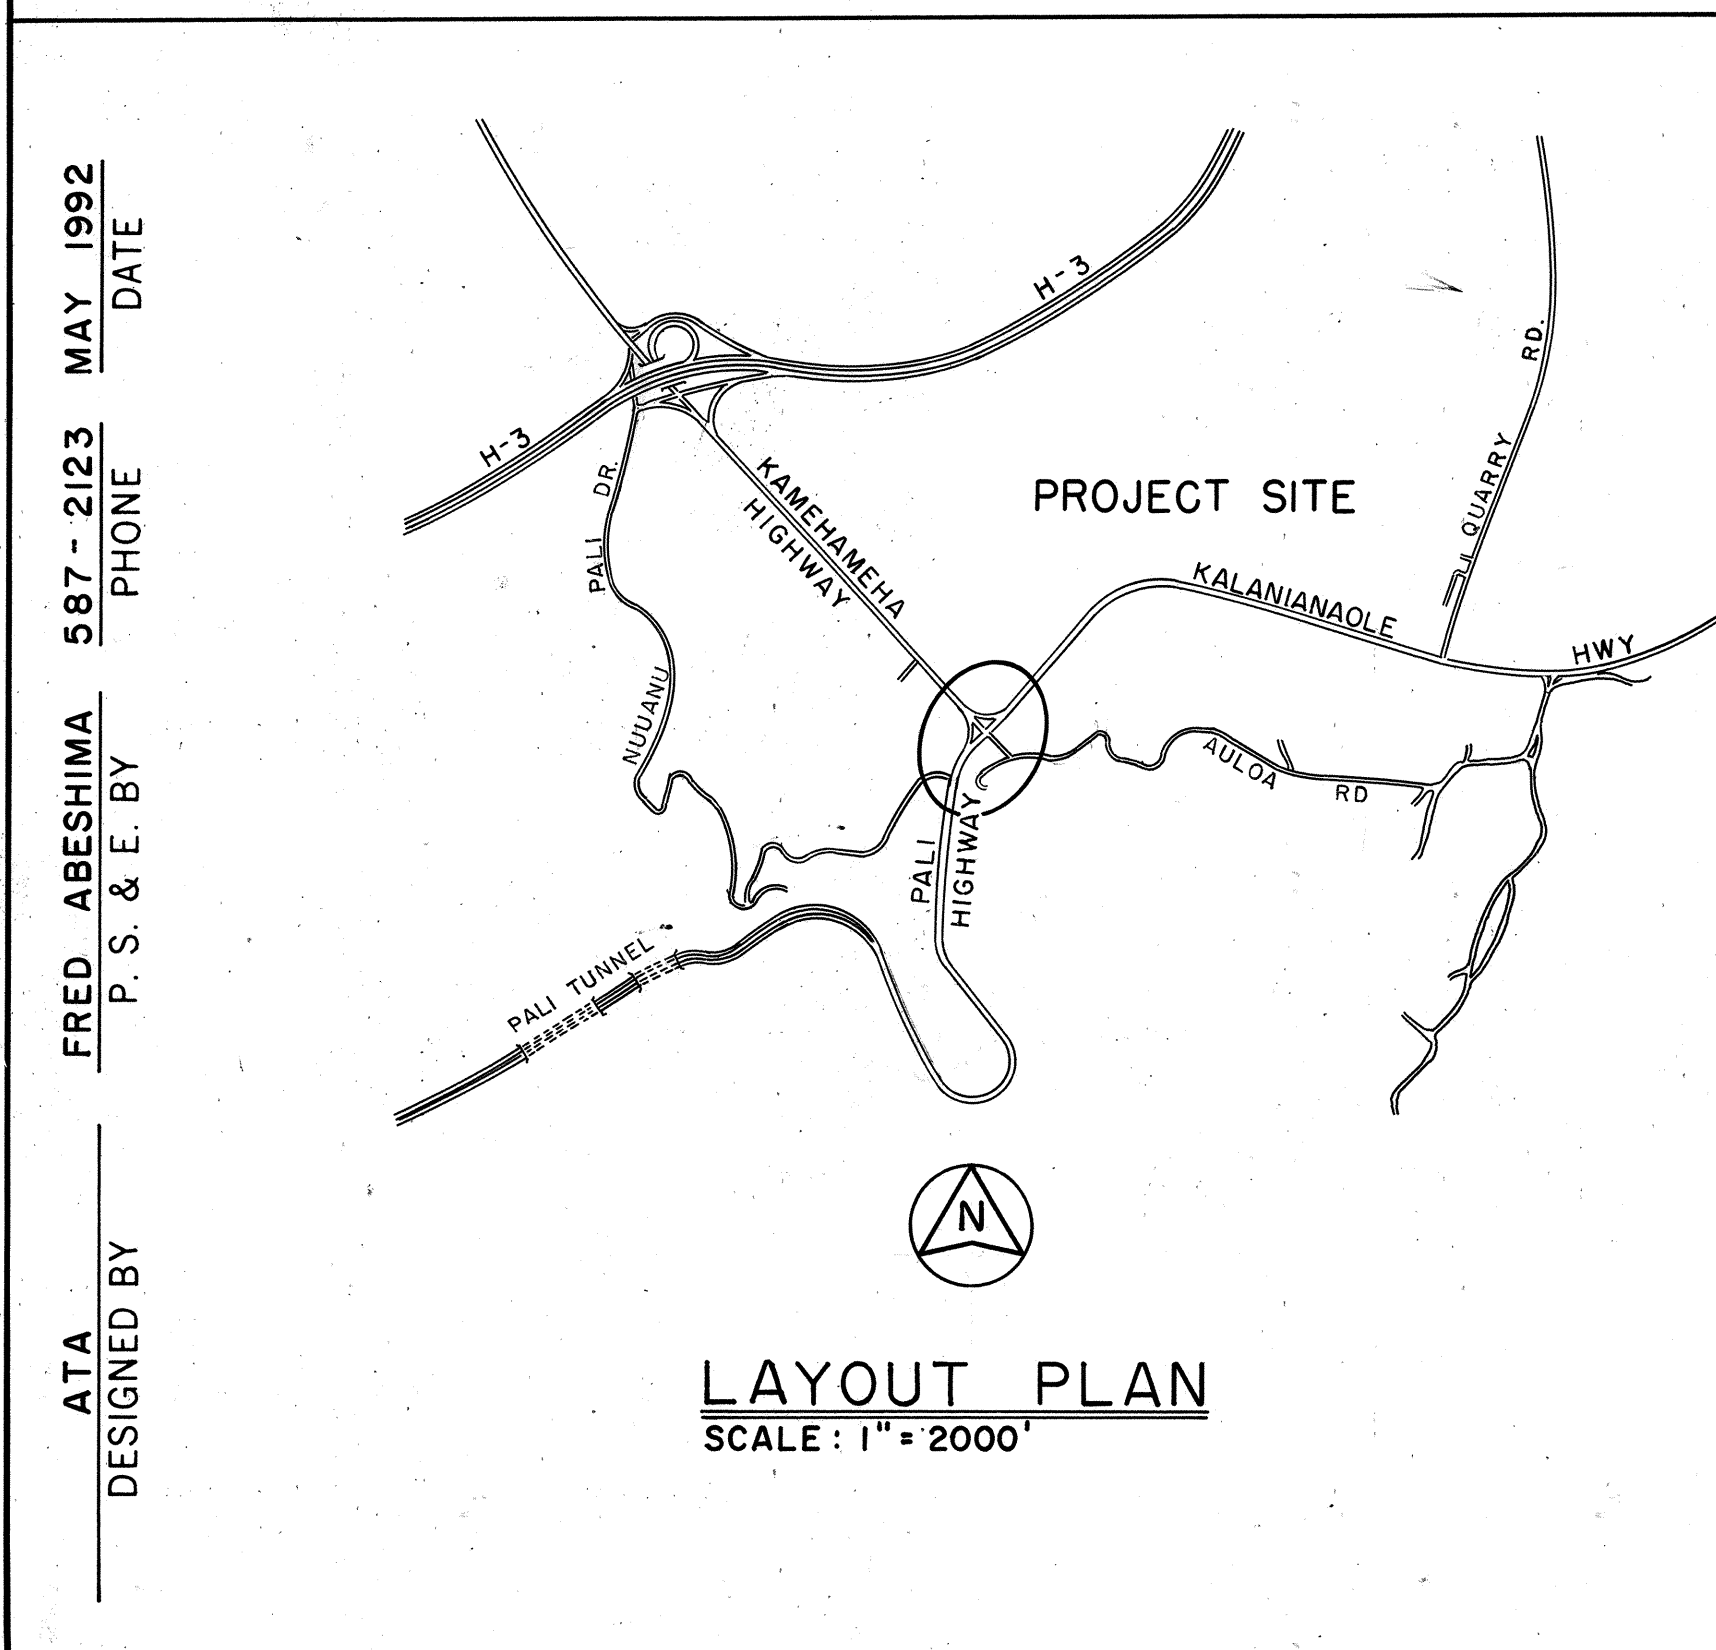


INDEX TO DRAWINGS	
SHEET NO.	DESCRIPTION
1	TITLE SHEET
2	STANDARD PLAN SUMMARY
3	LEGEND, NOTES AND DETAILS
4	TYPICAL SECTION
5	ROADWAY PLAN
6	ROADWAY PLAN
7	PAVEMENT GRADES
8	PAVEMENT GRADES
9	DRAINAGE PLAN
10	SIGNS AND MARKINGS
① 11	SIGNS AND MARKINGS
12	TRAFFIC SIGNAL PLAN
13	LOOP DETECTOR DETAILS
14	ENERGY ABSORBING TERMINAL
15	ENERGY ABSORBING TERMINAL
16	CROSS SECTIONS
17	CROSS SECTIONS
18	CROSS SECTIONS

Plan Sht. No. ①11S-1 is a supplementary sheet to this project. TOTAL SHEET COUNT after "AS-BUILT" postings 19 Sheets.

STATE OF HAWAII
DEPARTMENT OF TRANSPORTATION
HIGHWAYS DIVISION
HONOLULU, HAWAII
"AS-BUILT"
PLANS FOR
PALI HIGHWAY
INTERSECTION IMPROVEMENTS
AT KAMEHAMEHA HIGHWAY
FEDERAL AID PROJECT NO. STP-061-1(27)
DISTRICT OF KOOLAUPOKO
ISLAND OF OAHU

FED. ROAD DIST. NO.	STATE	FED. AID PROJ. NO.	FISCAL YEAR	SHEET NO.	TOTAL SHEETS
HAWAII	HAW.	STP-061-1(27)	1992	1	18

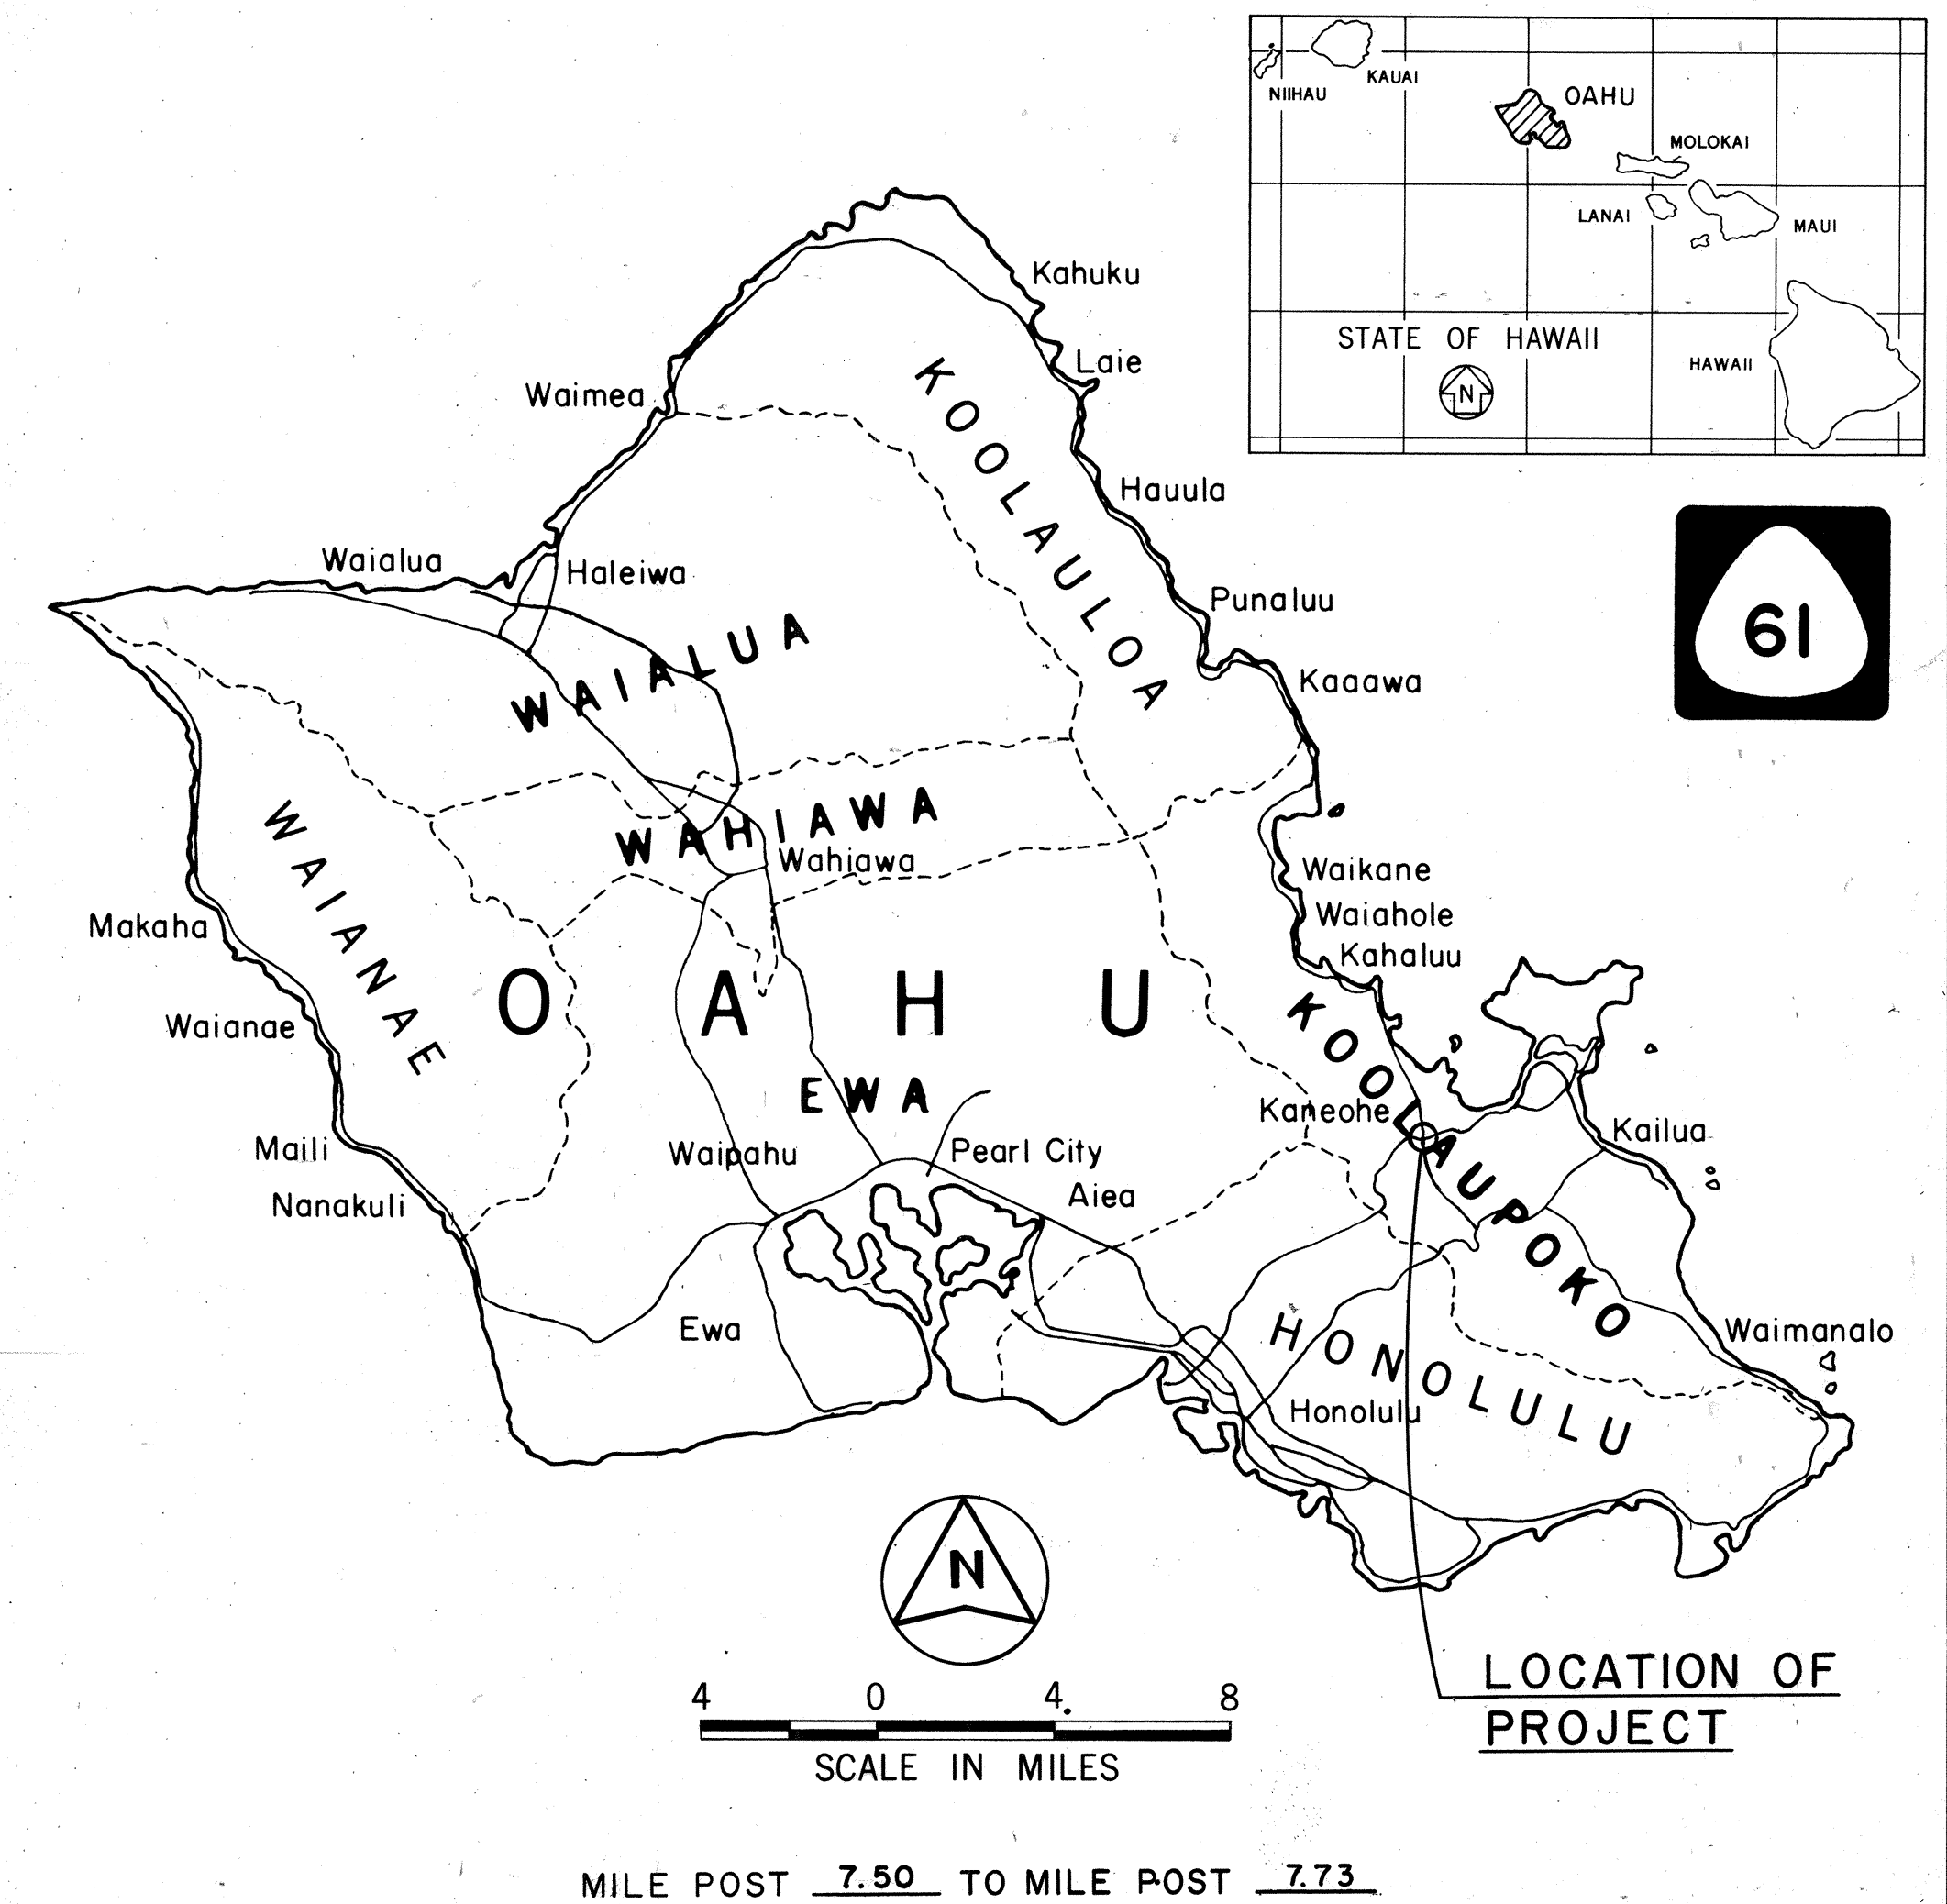

CHANGES MADE DURING CONSTRUCTION HAVE BEEN INCORPORATED ON THESE PLANS EXCEPT CHANGES IN THE ORIGINAL THEORETICAL QUANTITIES. FOR ACTUAL QUANTITIES, REFER TO PROJECT LEDGER AND/OR COMPUTATION BOOK.

Sidney S. C. Zee 8/16/99
RESIDENT ENGINEER DATE

DEPARTMENT OF TRANSPORTATION
FEDERAL HIGHWAY ADMINISTRATION
APPROVED:
[Signature] 5-29-92
DIVISION ADMINISTRATOR DATE

DEPARTMENT OF TRANSPORTATION
STATE OF HAWAII
APPROVED:
[Signature] 5/21/92
DIR. OF TRANSPORTATION DATE