

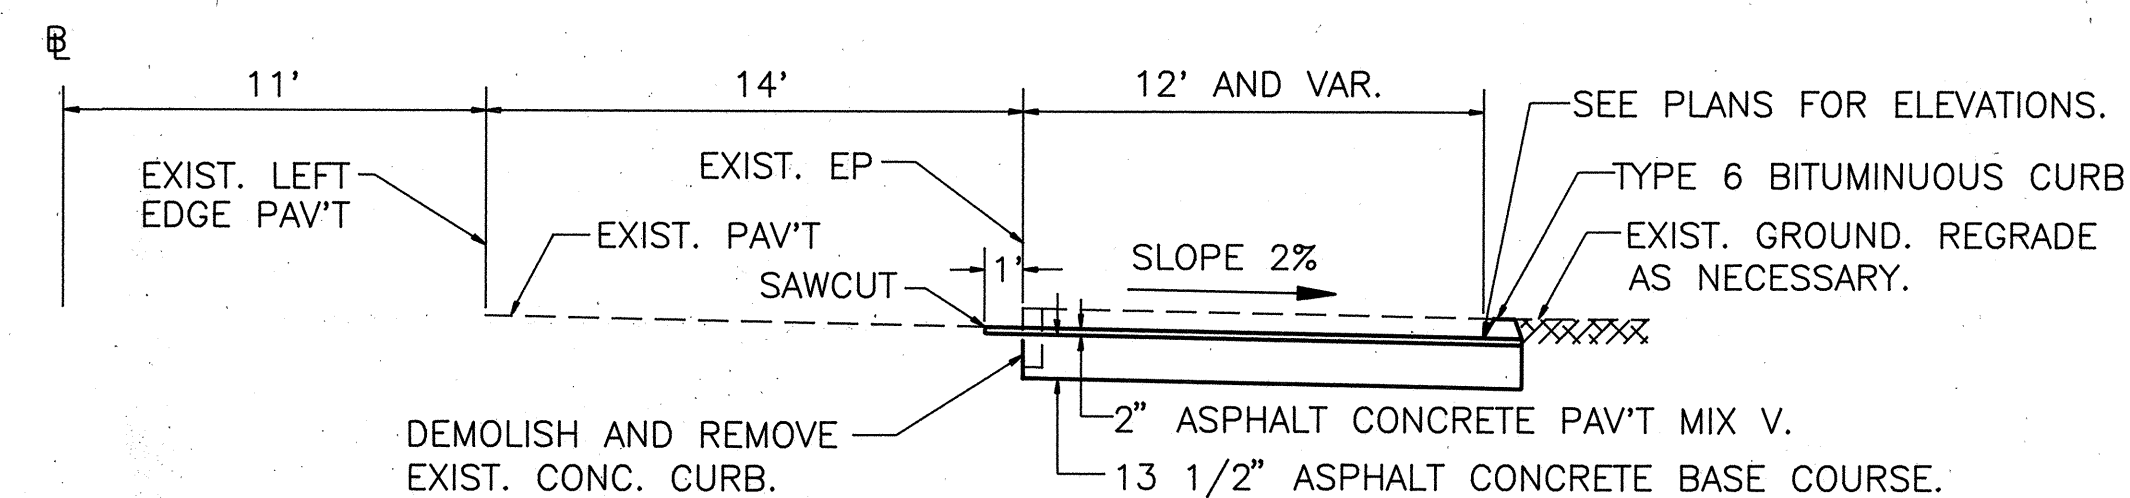


FED. ROAD DIST. NO.	STATE	FED. AID PROJ. NO.	FISCAL YEAR	SHEET NO.	TOTAL SHEETS
HAWAII	HAW.	61C-02-91	1992	4	18

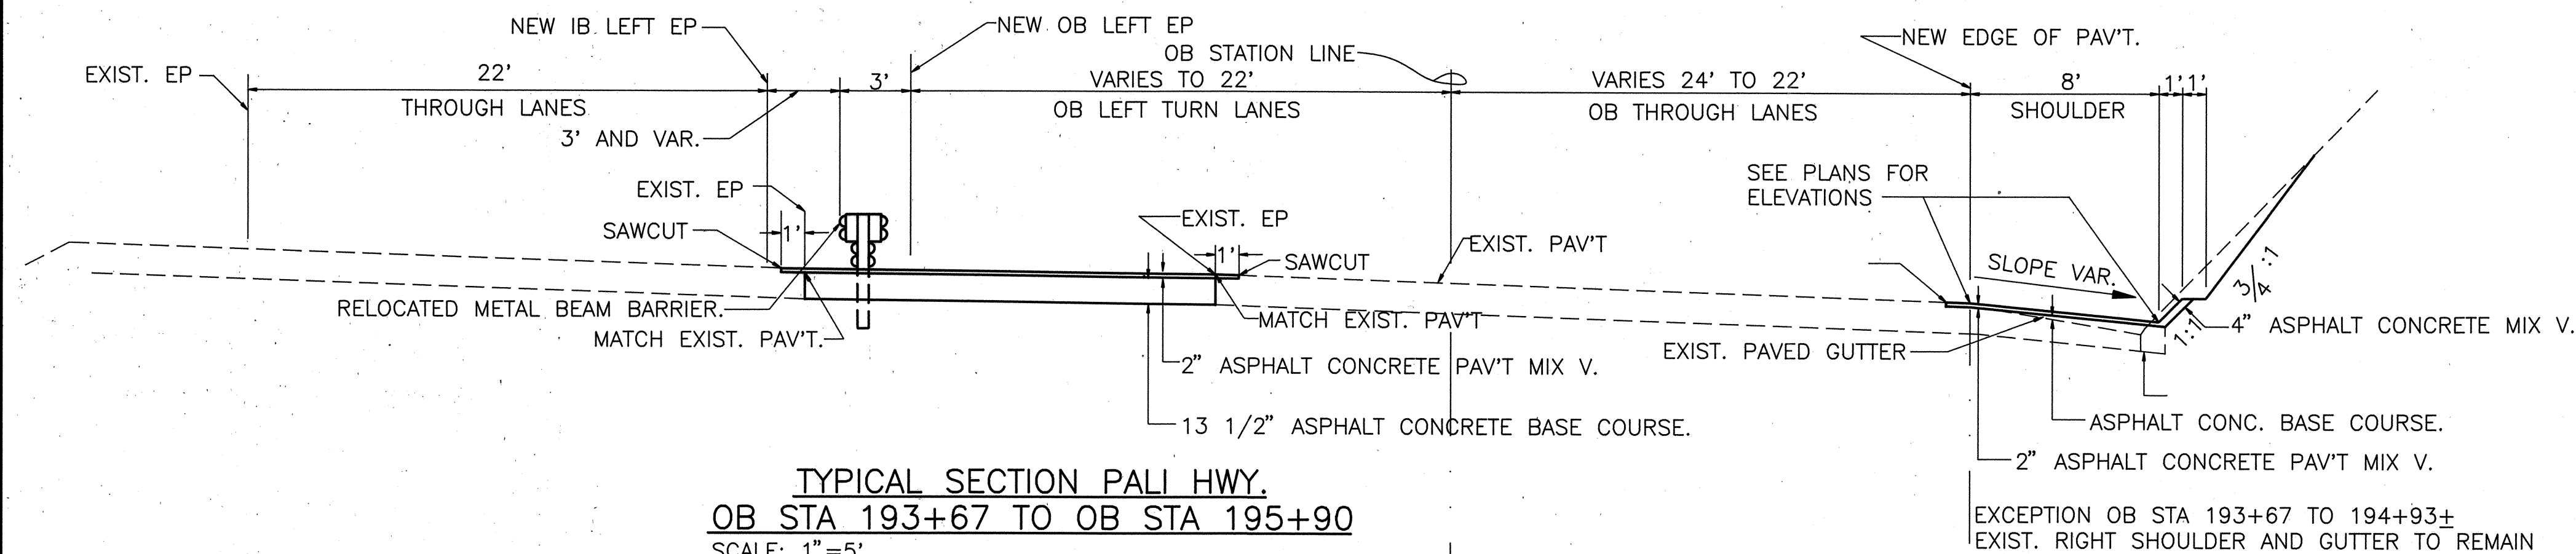





NOTE:

- "EXIST EP" = EXISTING EDGE LINE STRIPE

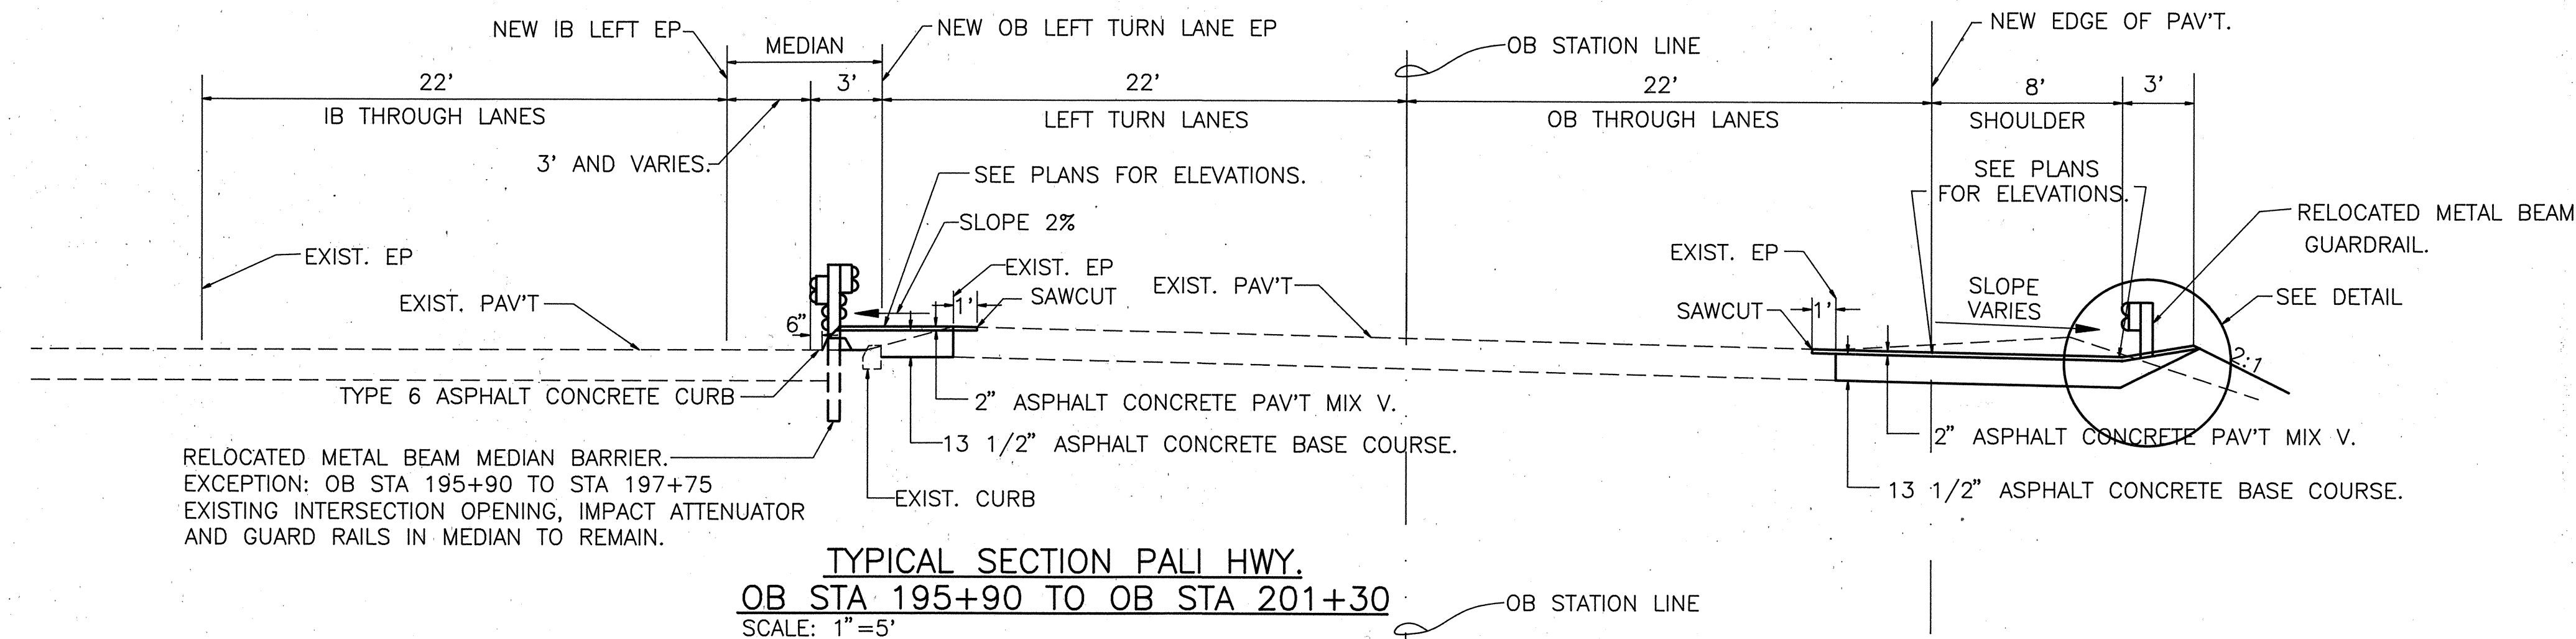

NOTE:

- SEE PLAN SHEETS 7 AND 8 FOR ELEVATIONS.

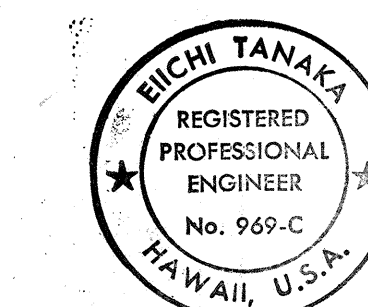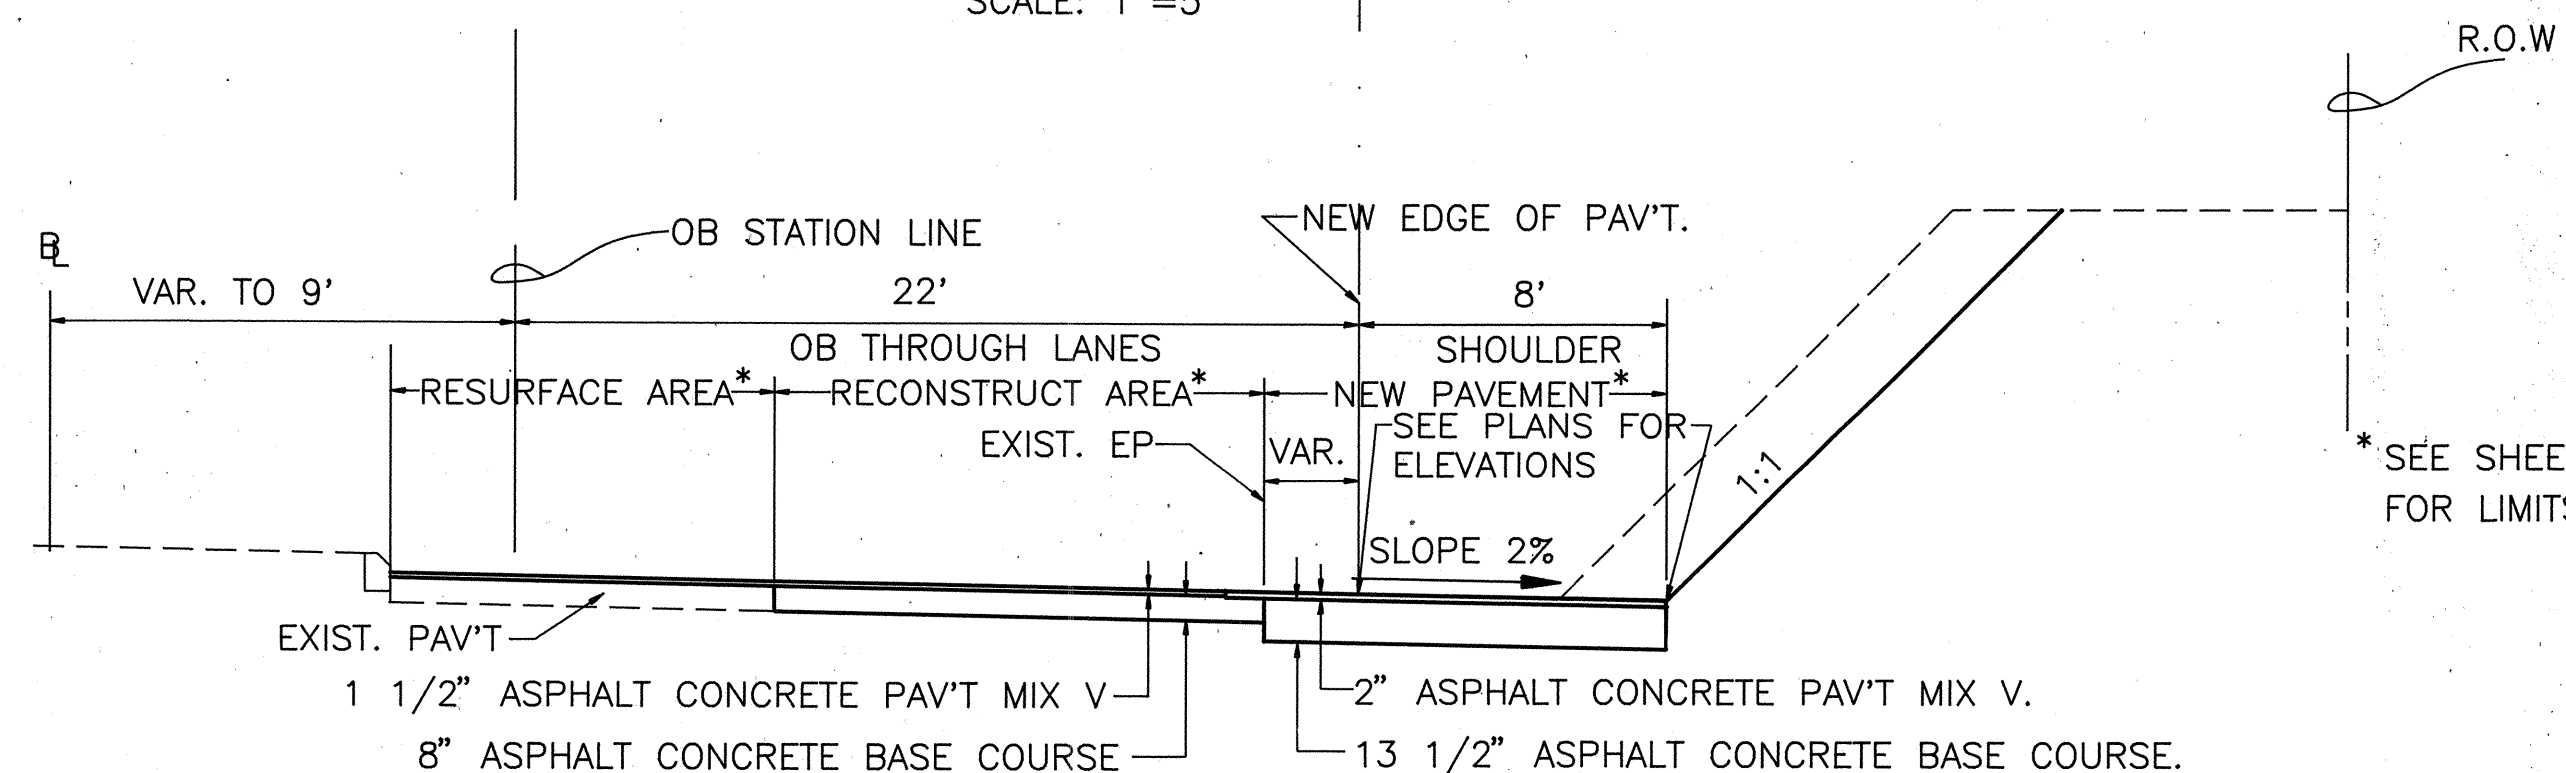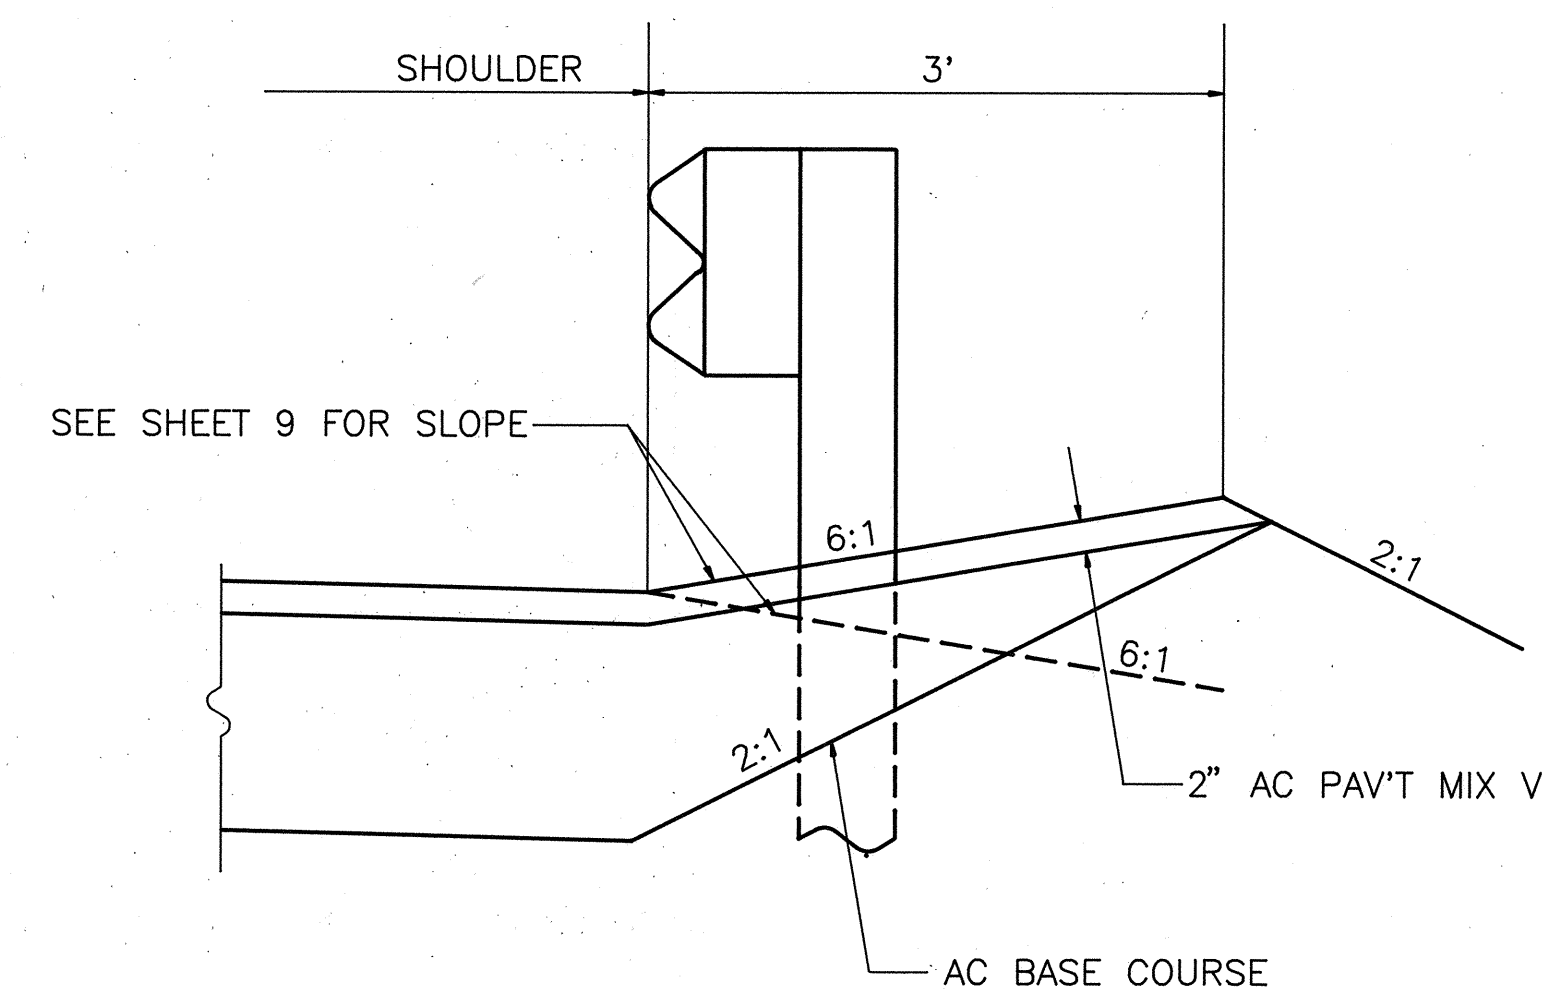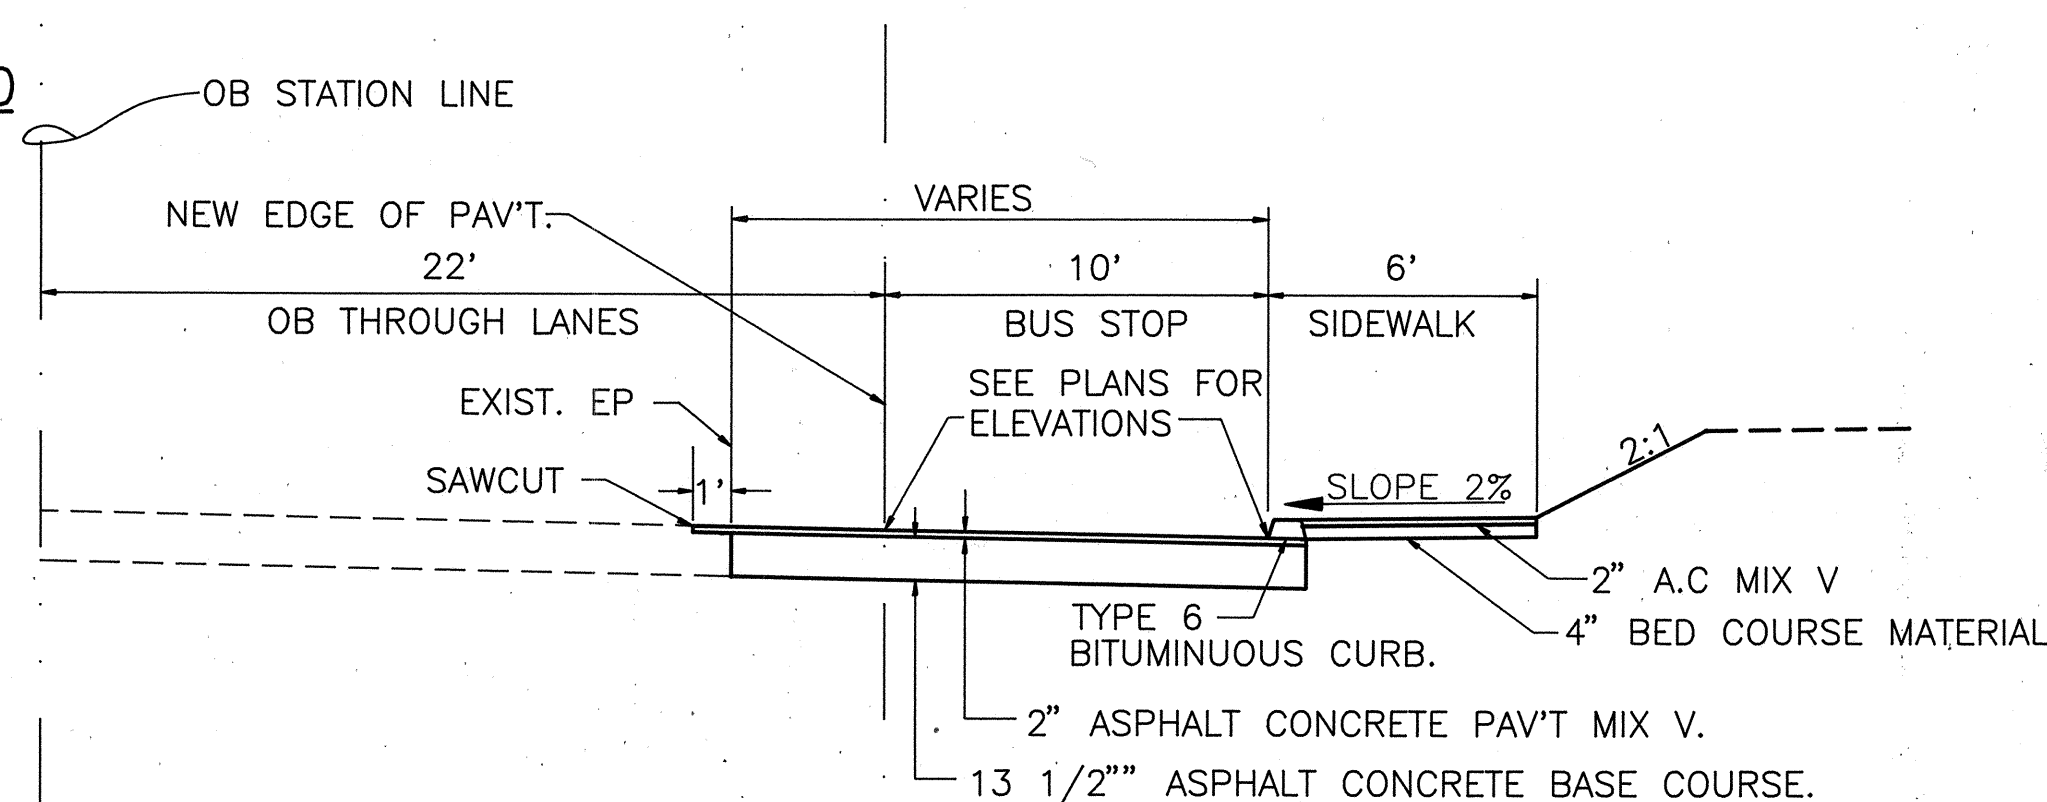

THIS WORK WAS PREPARED BY ME
OR UNDER MY SUPERVISION
Eichi Tanaka
Signature

STATE OF HAWAII
DEPARTMENT OF TRANSPORTATION
HIGHWAYS DIVISION

TYPICAL SECTIONS

PALI HIGHWAY
INTERSECTION IMPROVEMENTS AT
KAMEHAMEHA HIGHWAY

F.A PROJECT NO. STP-061-1(27)

SCALE: AS SHOWN DATE: MAY 1992

SHEET NO. 1 OF 1 SHEETS