



FED. ROAD DIST. NO.	STATE	FED. AID PROJ. NO.	FISCAL YEAR	SHEET NO.	TOTAL SHEETS
HAWAII	HAW.	NH-061-1(29)	1996	5	5

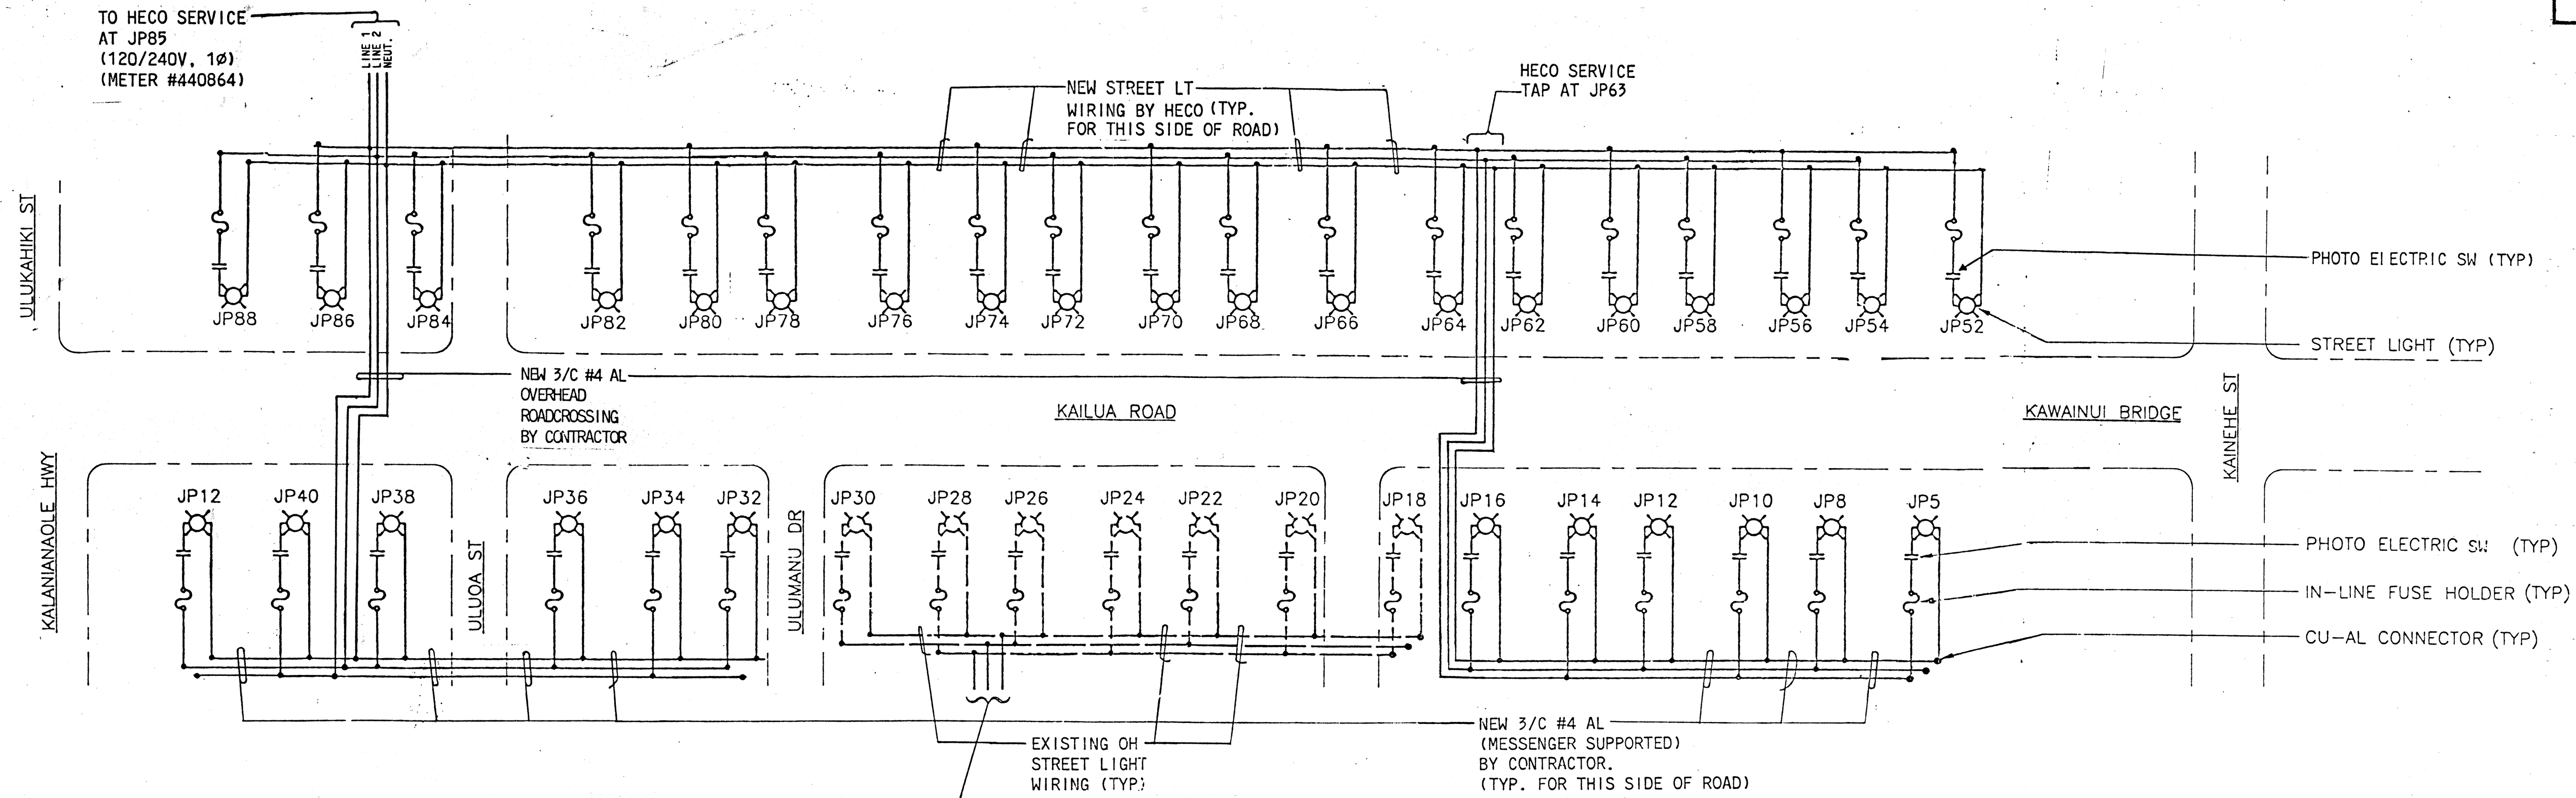


STREET LIGHT DIAGRAM -- KAILUA RD
N.T.S.

- NOTES:
- SOLID LINES INDICATE NEW WIRING AND STREET LIGHTS.
 - DASHED LINES INDICATE EXISTING WIRING AND STREET LIGHTS.

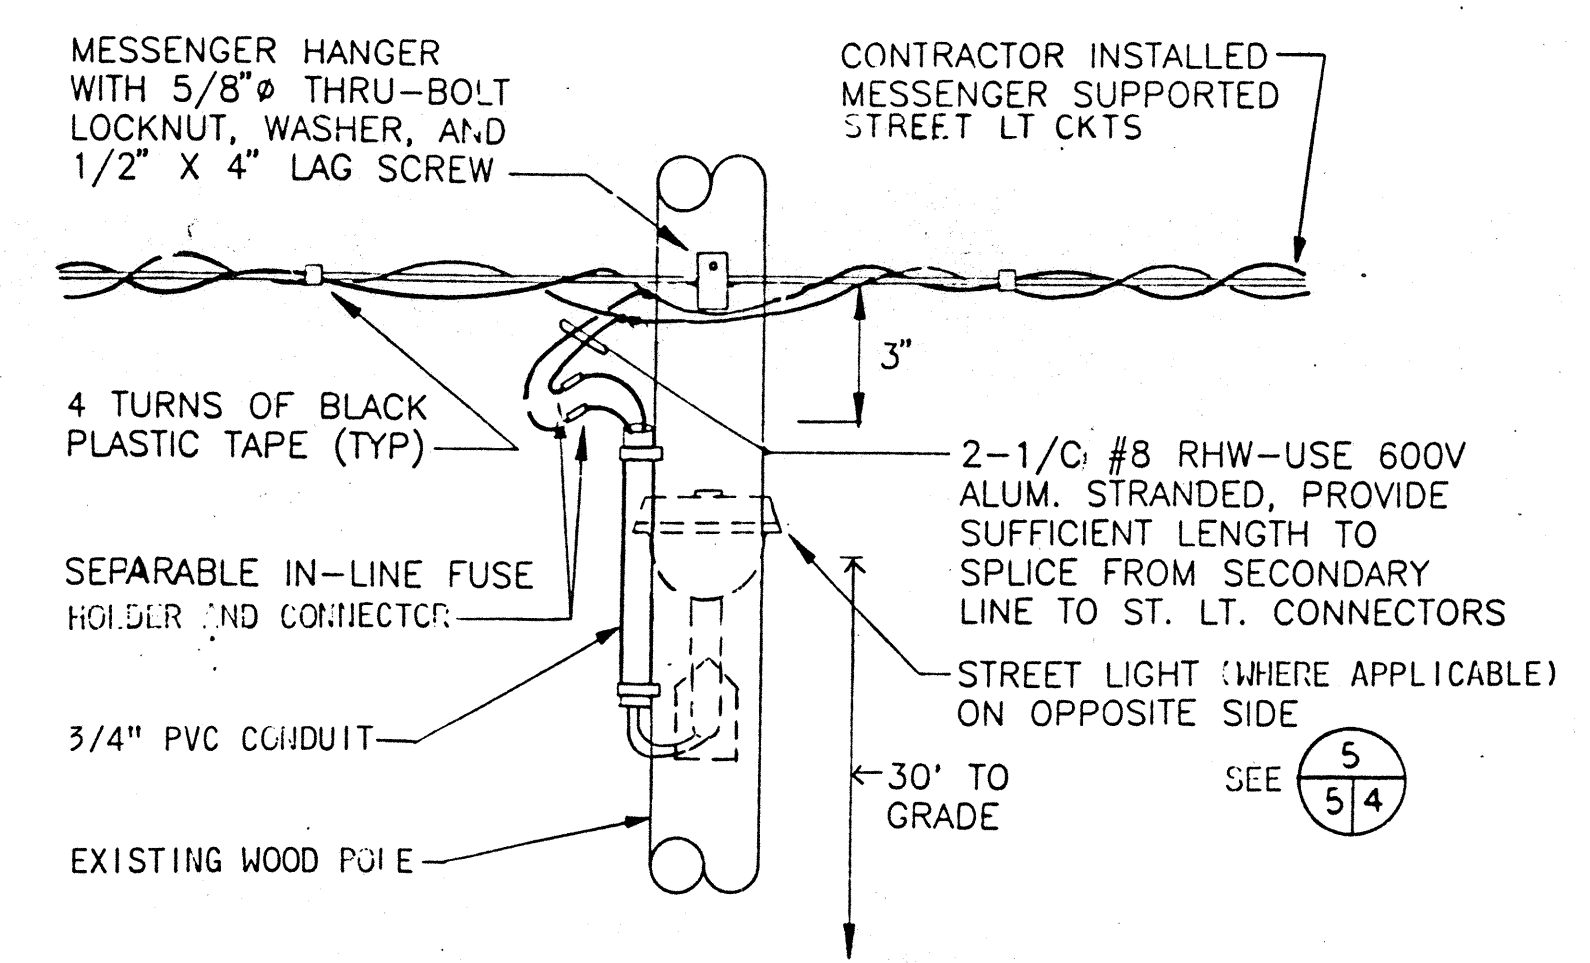


1/25 STREET-LIGHT CIRCUIT TANGENT DETAIL
N.T.S.

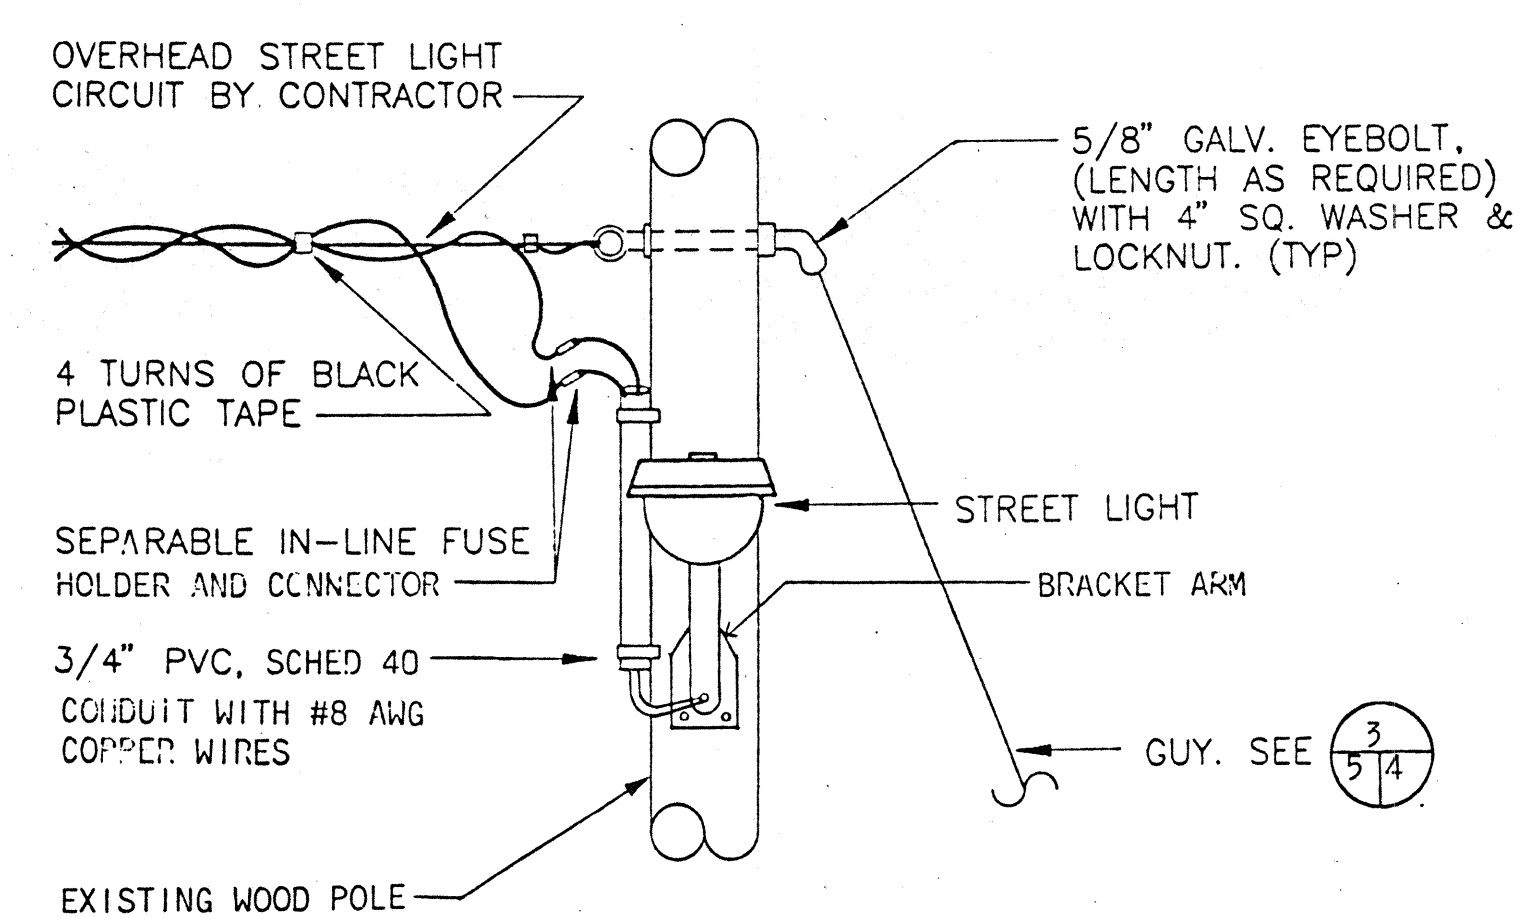

2/25 STREET-LIGHT CIRCUIT DEAD-END DETAIL
N.T.S.

ORIGINAL PLAN	DATE
DESIGNED BY	
TRACED BY	
QUANTITIES BY	
CHECKED BY	
NO.	

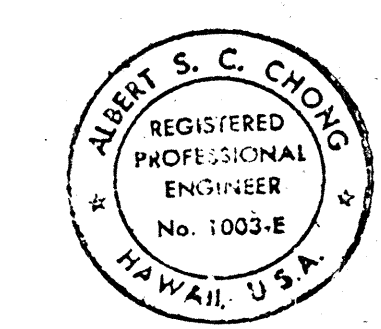

THIS WORK WAS PREPARED BY ME OR UNDER MY SUPERVISION

Albert S. C. Cho

STATE OF HAWAII
DEPARTMENT OF TRANSPORTATION
HIGHWAYS DIVISION

STREET LIGHT DIAGRAM, AND MISCELLANEOUS DETAILS

HIGHWAY LIGHTING IMPROVEMENTS AND REHABILITATION
KAILUA ROAD
KALANIANA'OLE HIGHWAY TO KAWAINUI BRIDGE