	INDEX TO DRAWINGS
SHEET NO.	DESCRIPTION
1	TITLE SHEET
2	PARTIAL STREET LIGHT PLAN-PARTS AND 11,
	ELECTRICAL SYMBOLS AND NOTES
3	PARTIAL STREET LIGHT PLAN-PARTS III AND IV
Δ	MISCELLANEOUS DETAILS
5	STREET LIGHT DIAGRAM AND MISCELLANEOUS DETAILS
	.
:	
:	
1.1	

STATE OF HAWAII

DEPARTMENT OF TRANSPORTATION

HIGHWAYS DIVISION HONOLULU, HAWAII

"AS-BUILT" Plans For

HIGHWAY LIGHTING IMPROVEMENTS & REHABILITATION


KAILUA ROAD: KALANIANAOLE HIGHWAY To KAWAINUI BRIDGE

Project No.: NH - 061 - 1 (29)

DISTRICT of KOOLAULOA, ISLAND of OAHU

PROJECT LOCATION-KAILUA POAD LOCATION MAP - KAILUA ROAD

NOT TO SCALE

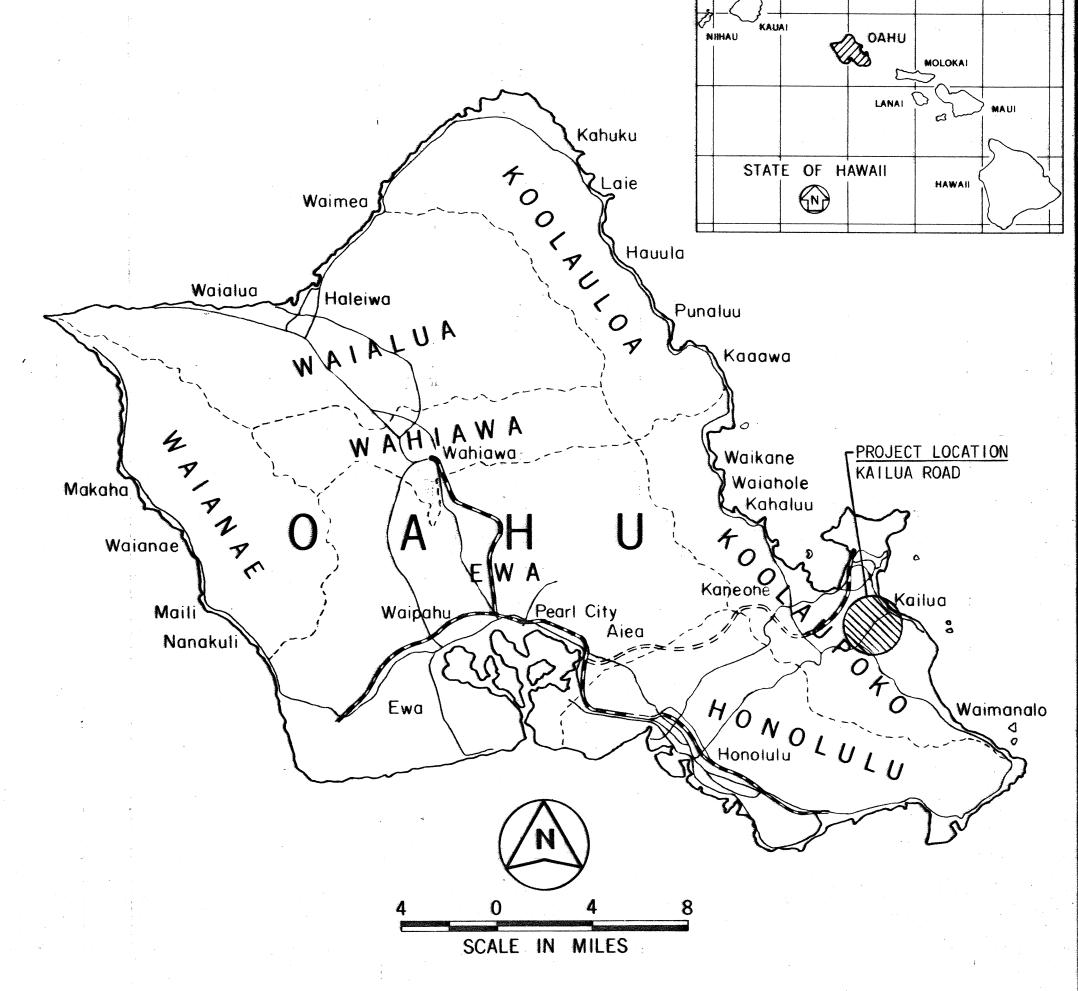

FED. ROAD DIST. NO.

FED. AID PROJ. NO.

FISCAL SHEET YEAR NO.

NO. SHEETS

FEDERAL AID INTERSTATE PROJECTS PREVIOUSLY CONSTRUCTED OR UNDER CONSTRUCTION

MILE POST 9.54 TO MILE POST 10.60

NOTE:

ALL CHANGES MADE DURING CONSTRUCTION HAVE BEEN NOTED DEREC ON THESE TRACINGS AND CHECKED BY:

RESIDENT ENGINEER

DEPARTMENT OF TRANSPORTATION STATE OF HAWAII

DIR. OF TRANSPORTATION