


FED. ROAD DIST. NO.	STATE	PROJ. NO.	FISCAL YEAR	SHEET NO.	TOTAL SHEETS
HAWAII	HAW.	61A-01-97M	1997	41	84

TRUE NORTH
SCALE: 1" = 40'

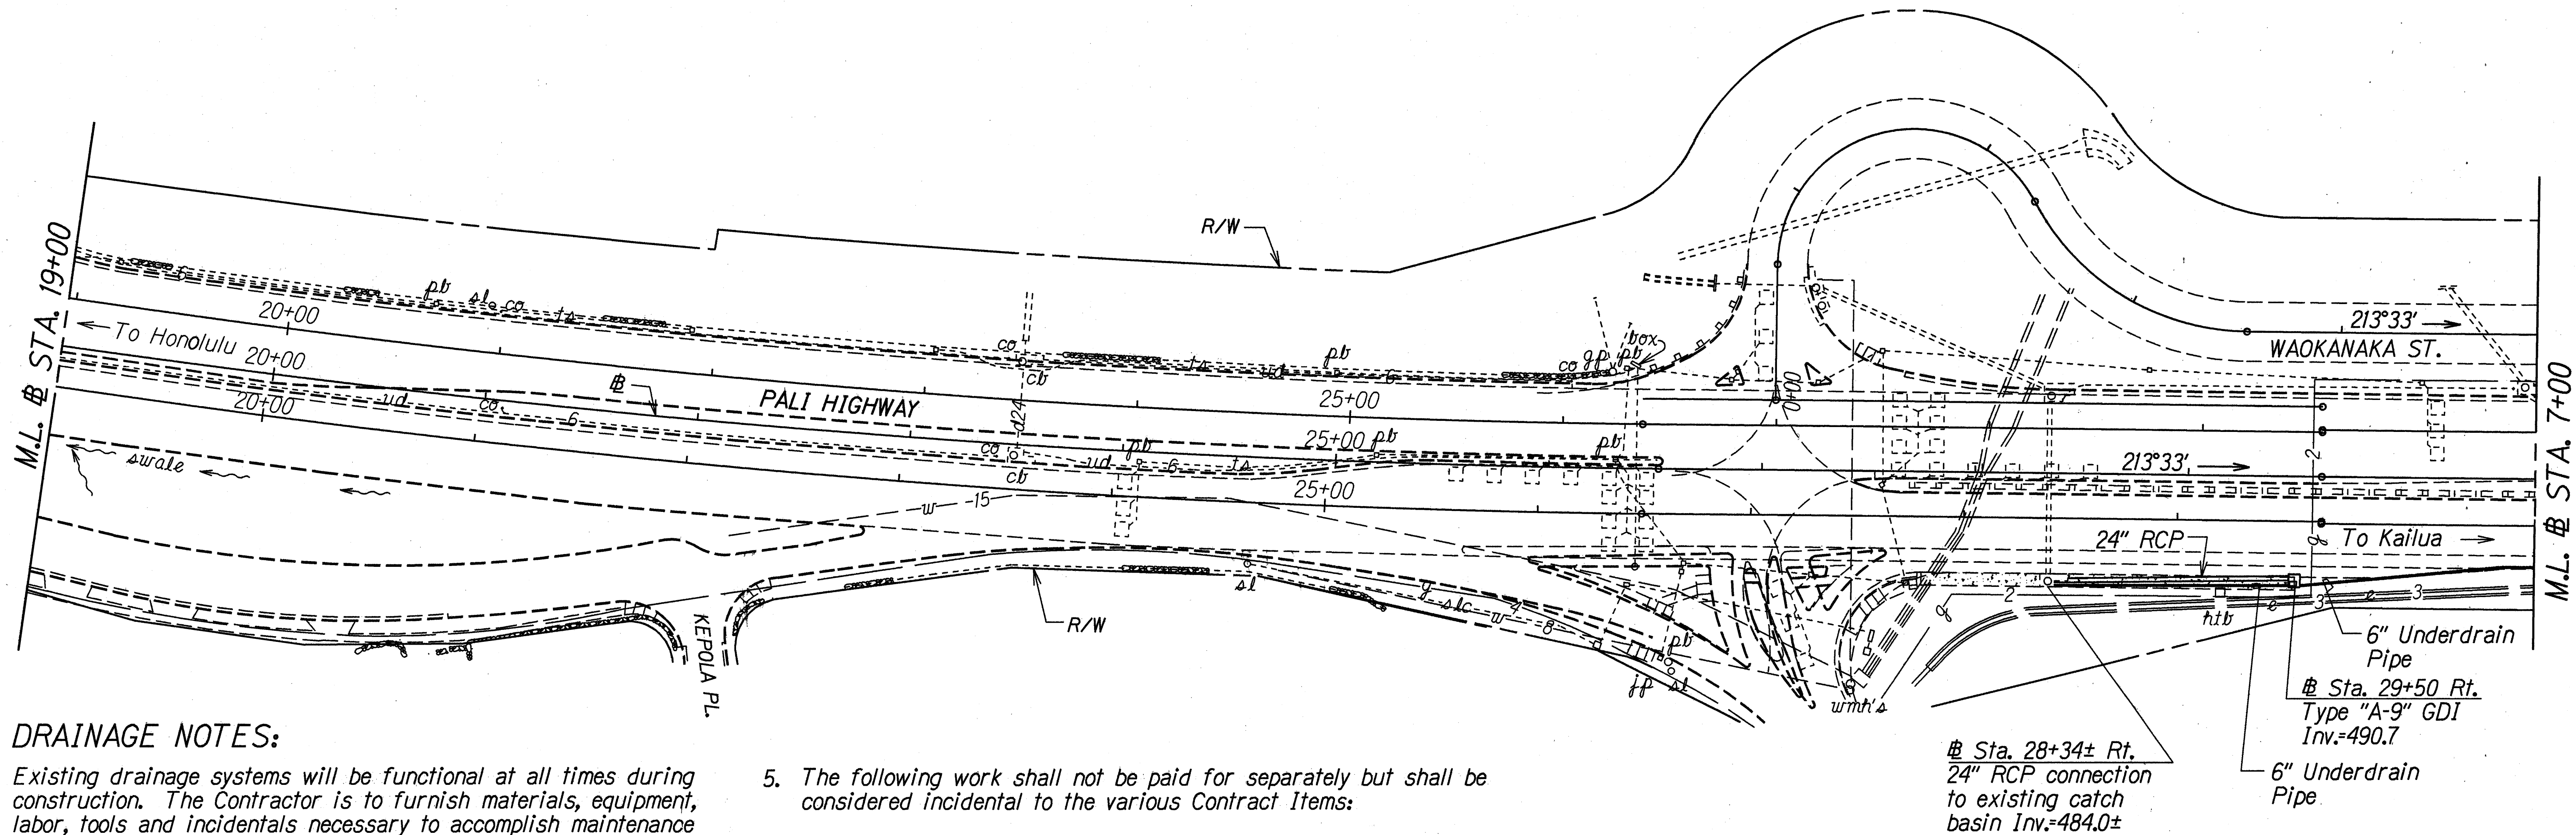

DRAINAGE NOTES:

- Existing drainage systems will be functional at all times during construction. The Contractor is to furnish materials, equipment, labor, tools and incidentals necessary to accomplish maintenance of flow. The cost shall be incidental to the various Contract Items.
- Existing culvert and spillway systems within the project limits may require removal of silt and debris material. The Engineer will pay for cleaning of existing culverts and spillways on a force account basis under Item No. 603.5001, "Clean Existing Culverts".
- The Contractor shall verify the locations of all existing culverts and utilities in the field. Any existing culverts and utilities damaged during construction shall be repaired or replaced by the Contractor at his own expense.
- Only non-pneumatic type of drill as approved by the Engineer will be permitted for drilling holes in concrete. Where indicated on Plans, the approximate diameter of drilled holes for installation of dowels shall be $\frac{3}{4}$ ", and voids after installing dowels shall be filled with epoxy grout as directed by the Engineer.
- The following work shall not be paid for separately but shall be considered incidental to the various Contract Items:
 - Demolishing, removing, and disposing existing concrete drainage structures, and portions of existing spillways.
 - 6" Underdrain connections to: existing drainage structures and spillways, and new concrete drainage structures.
 - 24" RCP connections to existing and new concrete drainage structures.
- For details of 6" underdrain connections to concrete drainage structures and grouted rubble paving spillways, see Sheet No. H23.
- For added reinforcing around culverts at new drainage structures, see Standard Plan H-04.
- For Culvert Trench and Backfill Detail, see Sht. No. H23.
- Concrete shall be Class A unless otherwise noted.
- Chamfer all exposed concrete edges 1".

Sta. 29+50 Rt.
Construct: Type "A-9" GDI
(For Typ. Details see Sht. No. H18)
Install: 24" RCP, Class III
(For Profile see Sht. No. H10)
6" Underdrain Pipe

Estimated Quantities
Structure Excavation for
Drainage System = 124 C.Y.
Bedcourse Material = 22 C.Y.
24" RCP, Cl. III = 112 L.F.
Type "A-9" GDI,
4.00 ft. to 4.99 ft. = 1 EA.
6" Perforated Underdrain Pipe = 108 L.F.
6" Nonperforated Underdrain Pipe = 4 L.F.

6/13/97 Revised Drainage Plans.

DATE REVISION

STATE OF HAWAII
DEPARTMENT OF TRANSPORTATION
HIGHWAYS DIVISION

DRAINAGE PLAN

PALI HIGHWAY RESURFACING
Country Club Rd. to Tunnel Entrance,
Including Both Rds. to Lookout
Project No. 61A-01-97M

Scale: 1"=40' Date: May 1997


SHEET No. H1 OF 24 SHEETS

ADD. 41

ORIGINAL PLAN	DATE
SURVEY PLOTTED BY	4/3/97
DRAWN BY	A. Nomura
NOTED BY	
DESIGNED BY	C. Matsuda
CHECKED BY	
APPROVED BY	

FED. ROAD DIST. NO.	STATE	PROJ. NO.	FISCAL YEAR	SHEET NO.	TOTAL SHEETS
HAWAII	HAW.	61A-01-97M	1997	42	84

TRUE NORTH
SCALE: 1" = 40'

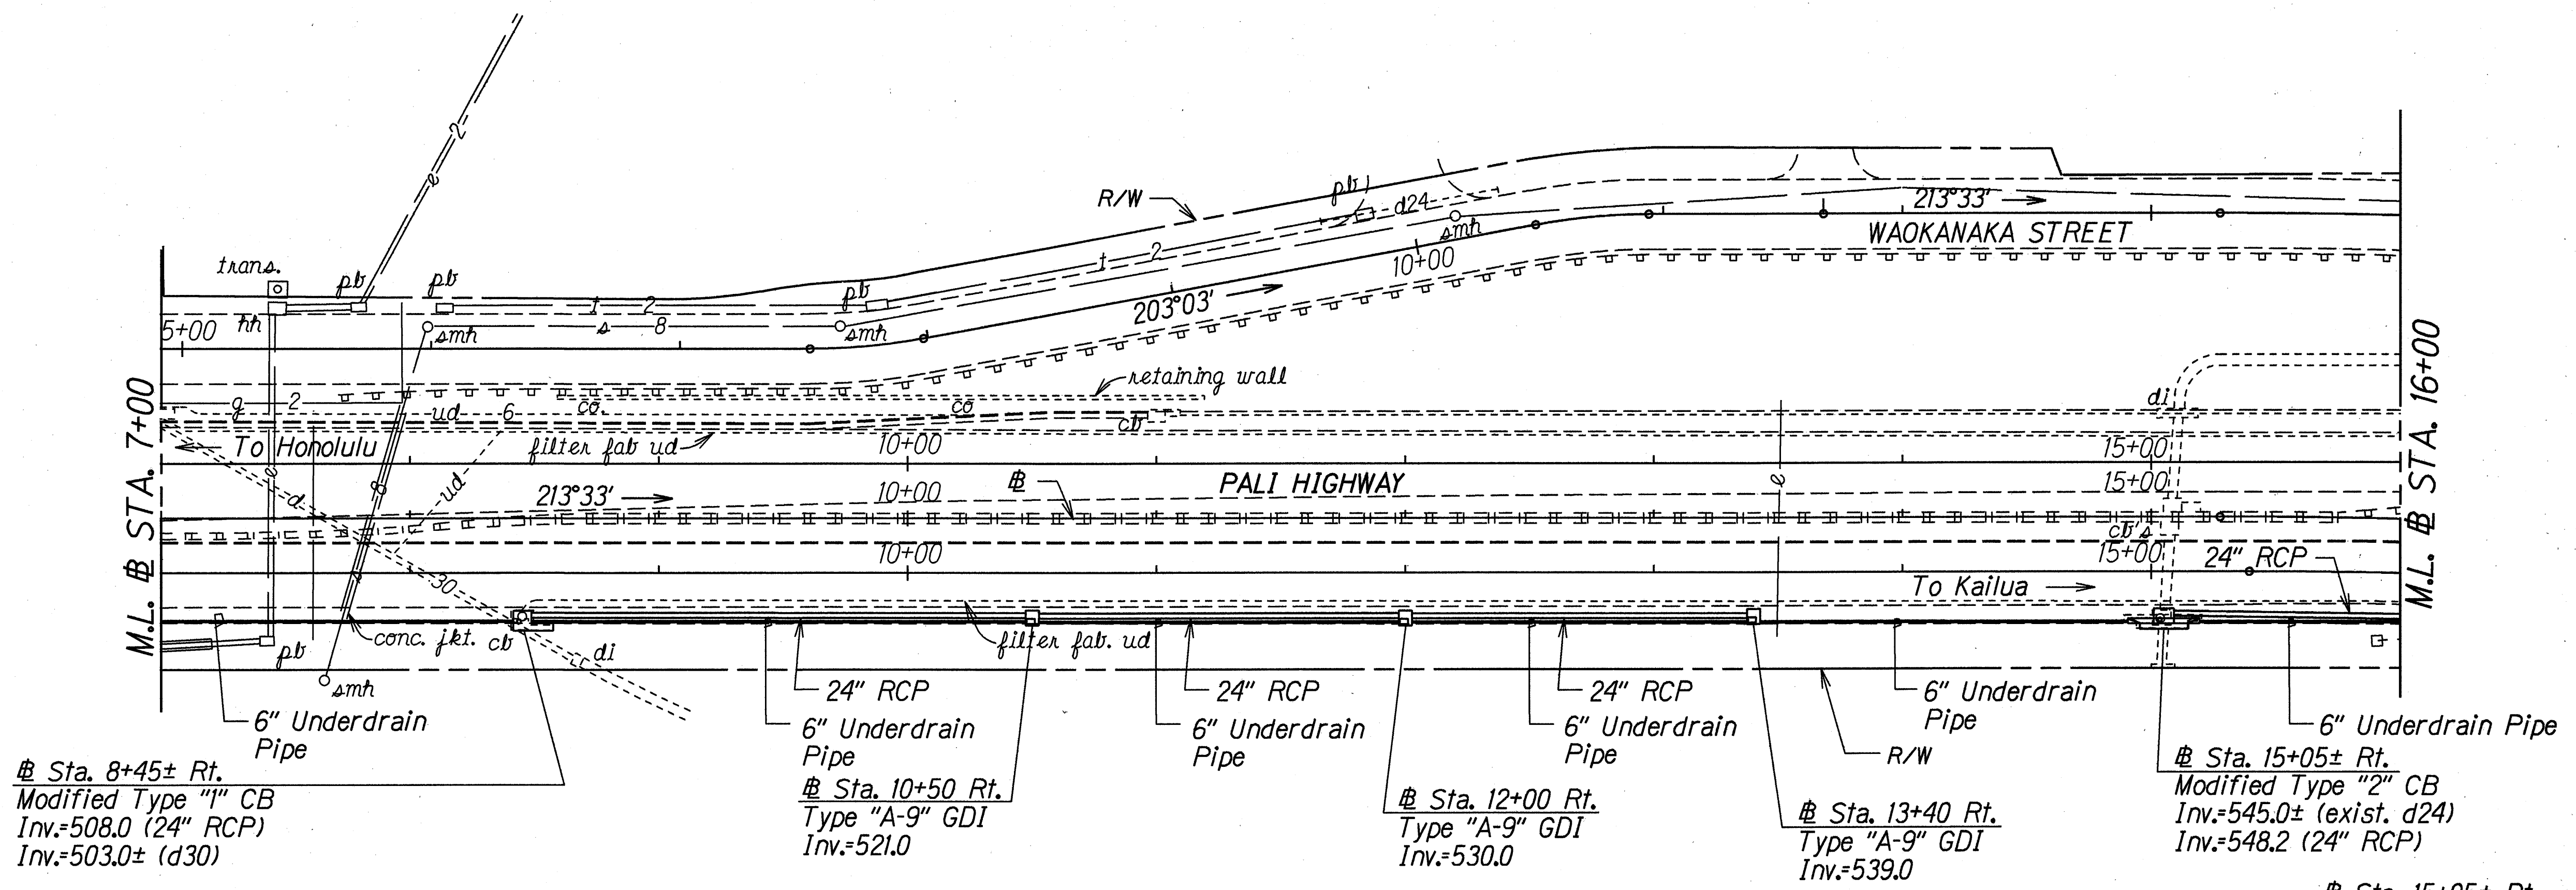

Sta. 8+45± Rt.
Modified Type "1" CB
Inv.=508.0 (24" RCP)
Inv.=503.0± (d30)

Sta. 10+50 Rt.
Type "A-9" GDI
Inv.=521.0

Sta. 12+00 Rt.
Type "A-9" GDI
Inv.=530.0

Sta. 13+40 Rt.
Type "A-9" GDI
Inv.=539.0

Sta. 15+05± Rt.
Modified Type "2" CB
Inv.=545.0± (exist. d24)
Inv.=548.2 (24" RCP)

Sta. 15+05± Rt.
Construct: Modified Type "2" CB
(For Details see Sht. No. H14)

Estimated Quantity
Modified Type "2" CB,
1.00 ft. to 1.99 ft. = 1 EA.

Sta. 29+50 Rt. to
Sta. 8+45± Rt.
Install: 6" Underdrain Pipe

Estimated Quantities
6" Perforated Underdrain Pipe = 248 L.F.
6" Nonperforated Underdrain Pipe = 4 L.F.

Sta. 10+50 Rt.
Construct: Type "A-9" GDI
(For Typ. Details see Sht. No. H18)
Install: 24" RCP, Class III
(For Profile see Sht. No. H10)
6" Underdrain Pipe

Estimated Quantities
Structure Excavation for
Drainage System = 206 C.Y.
Bedcourse Material = 40 C.Y.
24" RCP, Cl. III = 200 L.F.
Type "A-9" GDI,
4.00 ft. to 4.99 ft. = 1 EA.
6" Perforated Underdrain Pipe = 196 L.F.
6" Nonperforated Underdrain Pipe = 4 L.F.

Sta. 12+00 Rt.
Construct: Type "A-9" GDI
Install: 24" RCP, Class III
6" Underdrain Pipe

Estimated Quantities
Structure Excavation for
Drainage System = 150 C.Y.
Bedcourse Material = 29 C.Y.
24" RCP, Cl. III = 146 L.F.
Type "A-9" GDI,
4.00 ft. to 4.99 ft. = 1 EA.
6" Perforated Underdrain Pipe = 142 L.F.
6" Nonperforated Underdrain Pipe = 4 L.F.

Sta. 13+40 Rt.
Construct: Type "A-9" GDI
Install: 24" RCP, Class III
6" Underdrain Pipe

Estimated Quantities
Structure Excavation for
Drainage System = 140 C.Y.
Bedcourse Material = 27 C.Y.
24" RCP, Cl. III = 136 L.F.
Type "A-9" GDI,
4.00 ft. to 4.99 ft. = 1 EA.
6" Perforated Underdrain Pipe = 132 L.F.
6" Nonperforated Underdrain Pipe = 4 L.F.

Sta. 13+40 Rt. to
Sta. 15+05± Rt.
Install: 6" Underdrain Pipe

Estimated Quantities
6" Perforated Underdrain Pipe = 159 L.F.
6" Nonperforated Underdrain Pipe = 4 L.F.

6/13/97	Revised Drainage Plans.
DATE	REVISION

STATE OF HAWAII
DEPARTMENT OF TRANSPORTATION
HIGHWAYS DIVISION

DRAINAGE PLAN

PALI HIGHWAY RESURFACING
Country Club Rd. to Tunnel Entrance,
Including Both Rds. to Lookout
Project No. 61A-01-97M

Scale: 1"=40' Date: May 1997


SHEET No. H2 OF 24 SHEETS

ORIGINAL PLAN	DATE
SURVEY PLOTTED BY	4/13/97
DRAWN BY	A. Noma
TRACED BY	C. Masada
NOTED BY	4/20/97
CHECKED BY	4/20/97

Sta. 8+45± Rt.
Construct: Modified Type "1" CB
(For Details see Sht. Nos. H12 & H13)

Estimated Quantity
Modified Type "1" CB,
1.00 ft. to 1.99 ft. = 1 EA.

FED. ROAD DIST. NO.	STATE	PROJ. NO.	FISCAL YEAR	SHEET NO.	TOTAL SHEETS
HAWAII	HAW.	61A-01-97M	1997	43	84

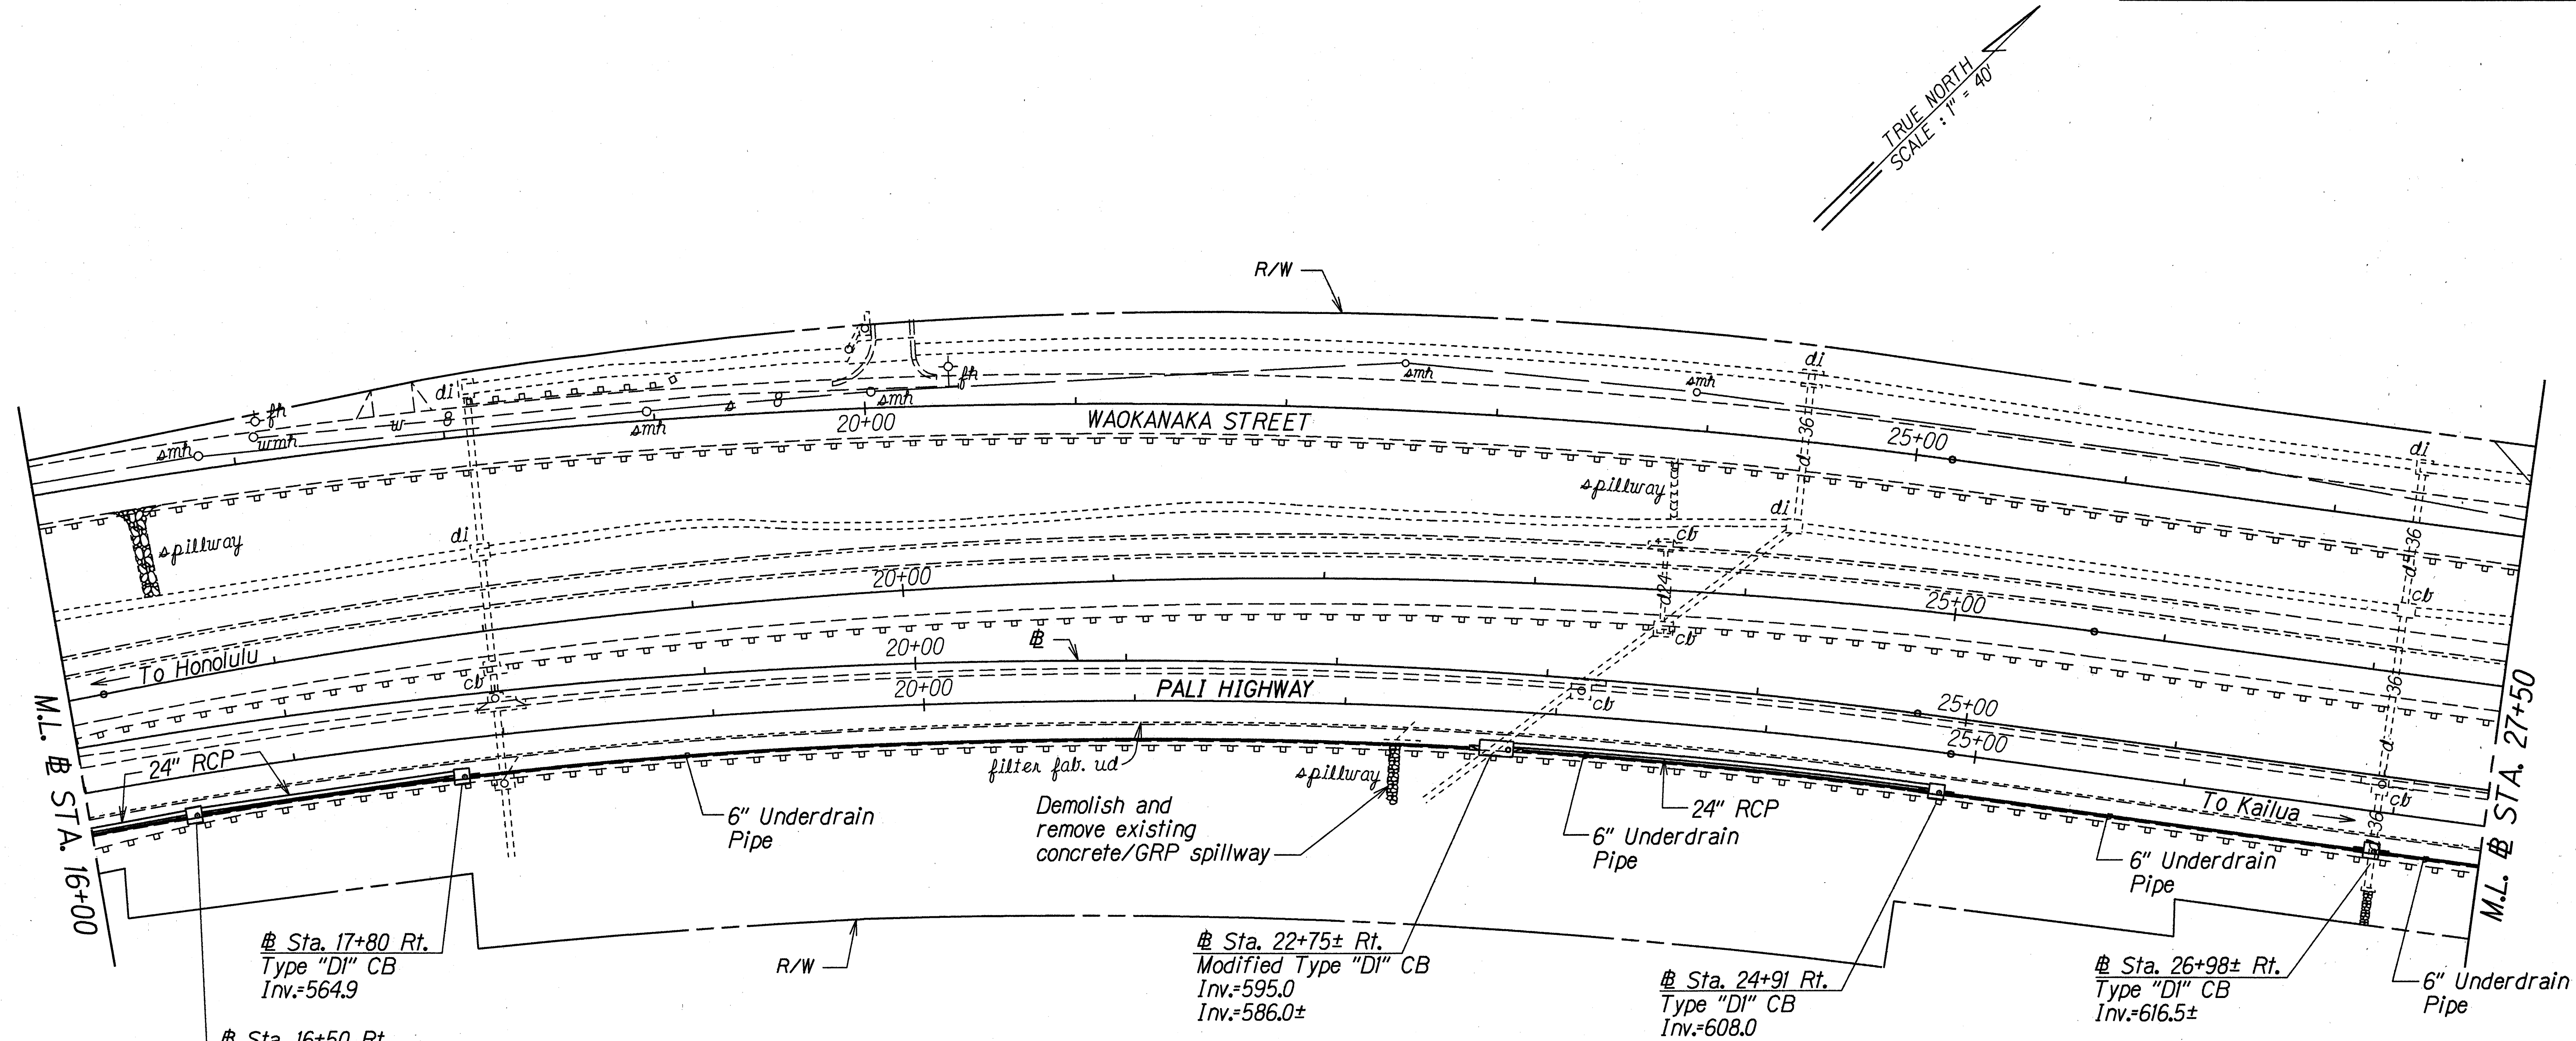

DATE	4/2/97
SURVEY PLOTTED BY	
DRAWN BY	A. Moniz
TRACED BY	
DESIGNED BY	C. Matsuda
CHECKED BY	
NOTED BY	
ORIGINAL PLAN	

Sta. 16+50 Rt.
Construct: Type "DI" CB
Install: 24" RCP, Class III
(For Profile see Sht. No. H10)
6" Underdrain Pipe

Estimated Quantities
Structure Excavation for Drainage System = 153 C.Y.
Bedcourse Material = 28 C.Y.
24" RCP, Cl. III = 140 L.F.
Type "DI" CB, 4.00 ft. to 4.99 ft. = 1 EA.
6" Perforated Underdrain Pipe = 136 L.F.
6" Nonperforated Underdrain Pipe = 4 L.F.

Sta. 17+80 Rt.
Construct: Type "DI" CB
Install: 24" RCP, Class III
6" Underdrain Pipe

Estimated Quantities
Structure Excavation for Drainage System = 123 C.Y.
Bedcourse Material = 25 C.Y.
24" RCP, Cl. III = 126 L.F.
Type "DI" CB, 4.00 ft. to 4.99 ft. = 1 EA.
6" Perforated Underdrain Pipe = 122 L.F.
6" Nonperforated Underdrain Pipe = 4 L.F.

Sta. 17+80 Rt. to # Sta. 22+75± Rt.
Install: 6" Underdrain Pipe

Estimated Quantities
6" Perforated Underdrain Pipe = 483 L.F.
6" Nonperforated Underdrain Pipe = 4 L.F.

Sta. 22+75± Rt.
Construct: Modified Type "DI" CB
(For Details see Sht. Nos. H15 & H16)

Estimated Quantity
Modified Type "DI" CB, 14.00 ft. to 14.99 ft. = 1 EA.

Sta. 24+91 Rt.
Construct: Type "DI" CB
Install: 24" RCP, Class III
(For Profile see Sht. No. H10)
6" Underdrain Pipe

Estimated Quantities
Structure Excavation for Drainage System = 223 C.Y.
Bedcourse Material = 41 C.Y.
24" RCP, Class III = 206 L.F.
Type "DI" CB, 4.00 ft. to 4.99 ft. = 1 EA.
6" Perforated Underdrain Pipe = 202 L.F.
6" Nonperforated Underdrain Pipe = 4 L.F.

Sta. 24+91 Rt. to # Sta. 26+98± Rt.
Install: 6" Underdrain Pipe

Estimated Quantities
6" Perforated Underdrain Pipe = 197 L.F.
6" Nonperforated Underdrain Pipe = 4 L.F.

Sta. 26+98± Rt.
Construct: Type "DI" CB

Estimated Quantity
Type "DI" CB, 9.00 ft. to 9.99 ft. = 1 EA.

6/13/97	Revised Drainage Plans.
DATE	REVISION

STATE OF HAWAII
DEPARTMENT OF TRANSPORTATION
HIGHWAYS DIVISION

DRAINAGE PLAN

PALI HIGHWAY RESURFACING
Country Club Rd. to Tunnel Entrance,
Including Both Rds. to Lookout
Project No. 61A-01-97M

Scale: 1"=40' Date: May 1997

SHEET No. H3 OF 24 SHEETS


FED. ROAD DIST. NO.	STATE	PROJ. NO.	FISCAL YEAR	SHEET NO.	TOTAL SHEETS
HAWAII	HAW.	61A-01-97M	1997	44	84

Sta. 36+50 Rt.
Construct: Type "A-9" GDI
Install: 24" RCP, Class III
(For Profile see Sht. No. H11)
6" Underdrain Pipe

Estimated Quantities
Structure Excavation for
Drainage System = 124 C.Y.
Bedcourse Material = 23 C.Y.
24" RCP, Cl. III = 116 L.F.
Type "A-9" GDI,
4.00 ft. to 4.99 ft. = 1 EA.
6" Perforated Underdrain Pipe = 112 L.F.
6" Nonperforated Underdrain Pipe = 4 L.F.

Sta. 36+50 Rt. to
Sta. 37+60 Rt.
Construct: Underdrain Cleanout
(For Typical Detail see Sht. No. H24)
Install: 6" Underdrain Pipe

Estimated Quantities
6" Perforated Underdrain Pipe = 106 L.F.
6" Nonperforated Underdrain Pipe = 5 L.F.
Cleanout = 1 EA.

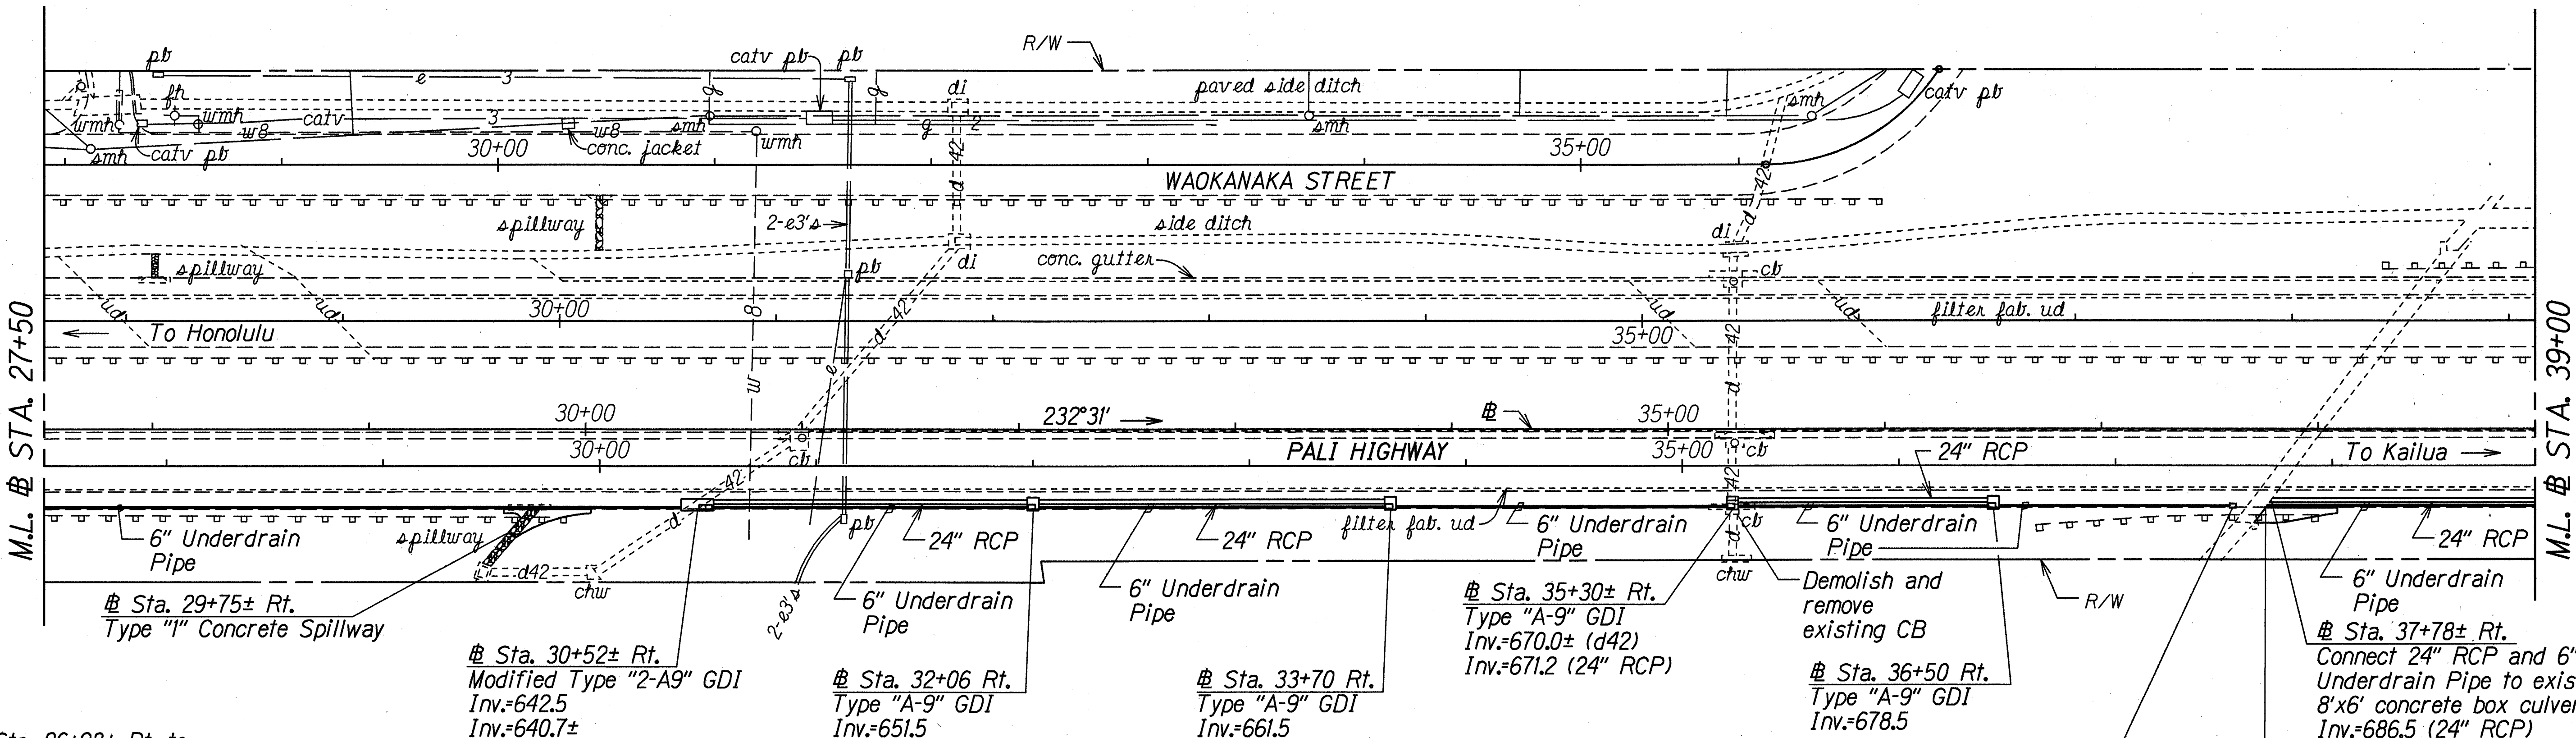

Sta. 26+98± Rt. to
Sta. 30+52± Rt.
Construct: Type "I" Concrete Spillway
(For Typ. Details see Sht. No. H19)
Install: 6" Underdrain Pipe

Estimated Quantities
Ditch and Channel Excavation = 7 C.Y.
6" Perforated Underdrain Pipe = 339 L.F.
6" Nonperforated Underdrain Pipe = 4 L.F.
Type "I" Concrete Spillway = 35 L.F.

Sta. 30+52± Rt.
Construct: Modified Type "2-A9" GDI
(For Details see Sht. No. H17)

Estimated Quantity
Modified Type "2-A9" GDI,
7.00 ft. to 7.99 ft. = 1 EA.

Sta. 32+06 Rt.
Construct: Type "A-9" GDI
(For Typ. Details see Sht. No. H18)
Install: 24" RCP, Class III
(For Profile see Sht. No. H11)
6" Underdrain Pipe

Estimated Quantities
Structure Excavation for
Drainage System = 157 C.Y.
Bedcourse Material = 29 C.Y.
24" RCP, Class III = 145 L.F.
Type "A-9" GDI,
4.00 ft. to 4.99 ft. = 1 EA.
6" Perforated Underdrain Pipe = 141 L.F.
6" Nonperforated Underdrain Pipe = 4 L.F.

Sta. 33+70 Rt.
Construct: Type "A-9" GDI
Install: 24" RCP, Class III
6" Underdrain Pipe

Estimated Quantities
Structure Excavation for
Drainage System = 172 C.Y.
Bedcourse Material = 32 C.Y.
24" RCP, Class III = 160 L.F.
Type "A-9" GDI,
4.00 ft. to 4.99 ft. = 1 EA.
6" Perforated Underdrain Pipe = 156 L.F.
6" Nonperforated Underdrain Pipe = 4 L.F.

Sta. 33+70 Rt. to
Sta. 35+30± Rt.
Install: 6" Underdrain Pipe

Estimated Quantities
6" Perforated Underdrain Pipe = 152 L.F.
6" Nonperforated Underdrain Pipe = 4 L.F.

Sta. 35+30± Rt.
Demolish and Remove: Existing catch basin
Construct: Type "A-9" GDI

Estimated Quantity
Type "A-9" GDI,
4.00 ft. to 4.99 ft. = 1 EA.

Sta. 37+60 Rt.
6" Underdrain Cleanout

Sta. 37+78± Rt.
Connect 24" RCP and 6"
Underdrain Pipe to exist.
8'x6' concrete box culvert
Inv.=686.5 (24" RCP)
Inv.=683.2± (Box Culvert)
Sta. 37+76± Rt.
Type "2" Concrete Spillway

6/13/97 Revised Drainage Plans.

DATE REVISION

STATE OF HAWAII
DEPARTMENT OF TRANSPORTATION
HIGHWAYS DIVISION

DRAINAGE PLAN
PALI HIGHWAY RESURFACING
Country Club Rd. to Tunnel Entrance,
Including Both Rds. to Lookout
Project No. 61A-01-97M
Scale: 1"=40' Date: May 1997

SHEET No. H4 OF 24 SHEETS

ORIGINAL PLAN	DATE
4/13/97	
SURVEY PLOTTED BY	
DRAWN BY	
CHECKED BY	
NOTED BY	
QUANTITIES BY	
CHECKED BY	

FED. ROAD DIST. NO.	STATE	PROJ. NO.	FISCAL YEAR	SHEET NO.	TOTAL SHEETS
HAWAII	HAW.	61A-01-97M	1997	45	84

Sta. 45+00 Rt.
Construct: Type "A-9" GDI
Install: 24" RCP, Class III
6" Underdrain Pipe

Estimated Quantities
Structure Excavation for
Drainage System = 102 C.Y.
Bedcourse Material = 20 C.Y.
24" RCP, Cl. III = 101 L.F.
Type "A-9" GDI,
4.00 ft. to 4.99 ft. = 1 EA.
6" Perforated Underdrain Pipe = 97 L.F.
6" Nonperforated Underdrain Pipe = 4 L.F.

Sta. 46+05 Rt.
Construct: Type "A-9" GDI
Install: 24" RCP, Class III
6" Underdrain Pipe

Estimated Quantities
Structure Excavation for
Drainage System = 102 C.Y.
Bedcourse Material = 20 C.Y.
24" RCP, Cl. III = 101 L.F.
Type "A-9" GDI,
4.00 ft. to 4.99 ft. = 1 EA.
6" Perforated Underdrain Pipe = 97 L.F.
6" Nonperforated Underdrain Pipe = 4 L.F.


Sta. 47+10 Rt.
Construct: Type "A-9" GDI
Install: 24" RCP, Class III
6" Underdrain Pipe

Estimated Quantities
Structure Excavation for
Drainage System = 102 C.Y.
Bedcourse Material = 20 C.Y.
24" RCP, Cl. III = 101 L.F.
Type "A-9" GDI,
4.00 ft. to 4.99 ft. = 1 EA.
6" Perforated Underdrain Pipe = 97 L.F.
6" Nonperforated Underdrain Pipe = 4 L.F.

Sta. 48+15 Rt.
Construct: Type "A-9" GDI
Install: 24" RCP, Class III
6" Underdrain Pipe

Estimated Quantities
Structure Excavation for
Drainage System = 102 C.Y.
Bedcourse Material = 20 C.Y.
24" RCP, Cl. III = 101 L.F.
Type "A-9" GDI,
4.00 ft. to 4.99 ft. = 1 EA.
6" Perforated Underdrain Pipe = 97 L.F.
6" Nonperforated Underdrain Pipe = 4 L.F.

TRUE NORTH
SCALE: 1" = 40'

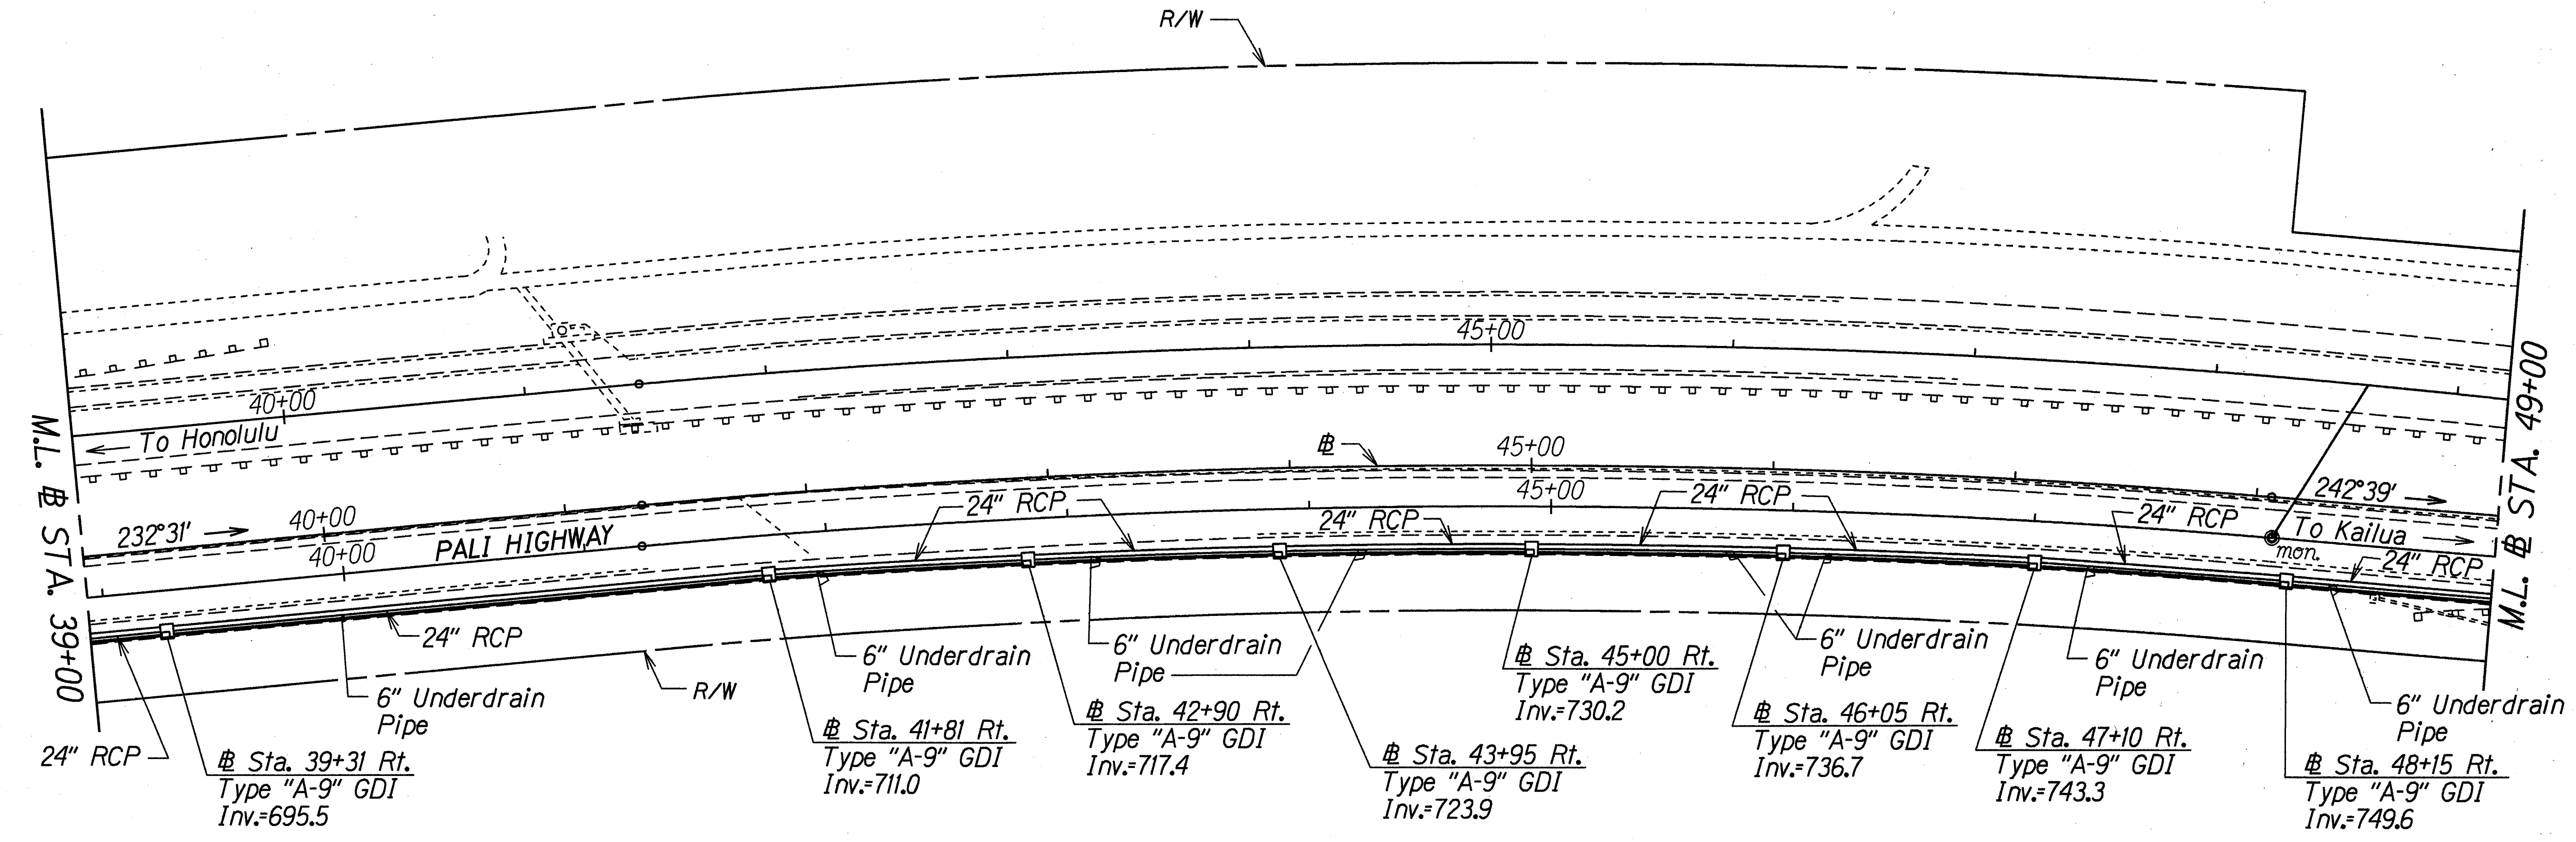

Sta. 39+31 Rt.
Construct: Type "A-9" GDI
Type "2" Concrete Spillway
(For Details see Sht. No. H20)
Install: 24" RCP, Class III
(For Profile see Sht. No. H11A)
6" Underdrain Pipe

Estimated Quantities
Ditch and Channel Excavation = 6 C.Y.
Structure Excavation for
Drainage System = 170 C.Y.
Bedcourse Material = 30 C.Y.
24" RCP, Class III = 151 L.F.
Type "A-9" GDI,
4.00 ft. to 4.99 ft. = 1 EA.
6" Perforated Underdrain Pipe = 147 L.F.
6" Nonperforated Underdrain Pipe = 4 L.F.
Type "2" Concrete Spillway = 38 L.F.

Sta. 41+81 Rt.
Construct: Type "A-9" GDI
Install: 24" RCP, Class III
6" Underdrain Pipe

Estimated Quantities
Structure Excavation for
Drainage System = 267 C.Y.
Bedcourse Material = 49 C.Y.
24" RCP, Class III = 246 L.F.
Type "A-9" GDI,
4.00 ft. to 4.99 ft. = 1 EA.
6" Perforated Underdrain Pipe = 242 L.F.
6" Nonperforated Underdrain Pipe = 4 L.F.

Sta. 42+90 Rt.
Construct: Type "A-9" GDI
Install: 24" RCP, Class III
6" Underdrain Pipe

Estimated Quantities
Structure Excavation for
Drainage System = 112 C.Y.
Bedcourse Material = 21 C.Y.
24" RCP, Class III = 105 L.F.
Type "A-9" GDI,
4.00 ft. to 4.99 ft. = 1 EA.
6" Perforated Underdrain Pipe = 101 L.F.
6" Nonperforated Underdrain Pipe = 4 L.F.

Sta. 43+95 Rt.
Construct: Type "A-9" GDI
Install: 24" RCP, Class III
6" Underdrain Pipe

Estimated Quantities
Structure Excavation for
Drainage System = 102 C.Y.
Bedcourse Material = 20 C.Y.
24" RCP, Class III = 101 L.F.
Type "A-9" GDI,
4.00 ft. to 4.99 ft. = 1 EA.
6" Perforated Underdrain Pipe = 97 L.F.
6" Nonperforated Underdrain Pipe = 4 L.F.

SURVEY PLOTTED BY	DATE
DRAWN BY	4/13/97
CHECKED BY	
NOTED BY	
DESIGNED BY	
APPROVED BY	

6/13/97	Revised Drainage Plans.
DATE	REVISION

STATE OF HAWAII
DEPARTMENT OF TRANSPORTATION
HIGHWAYS DIVISION

DRAINAGE PLAN


PALI HIGHWAY RESURFACING
Country Club Rd. to Tunnel Entrance,
Including Both Rds. to Lookout
Project No. 61A-01-97M

Scale: 1"=40' Date: May 1997

SHEET No. H5 OF 24 SHEETS

FED. ROAD DIST. NO.	STATE	PROJ. NO.	FISCAL YEAR	SHEET NO.	TOTAL SHEETS
HAWAII	HAW.	61A-01-97M	1997	46	84

TRUE NORTH
SCALE: 1" = 40'

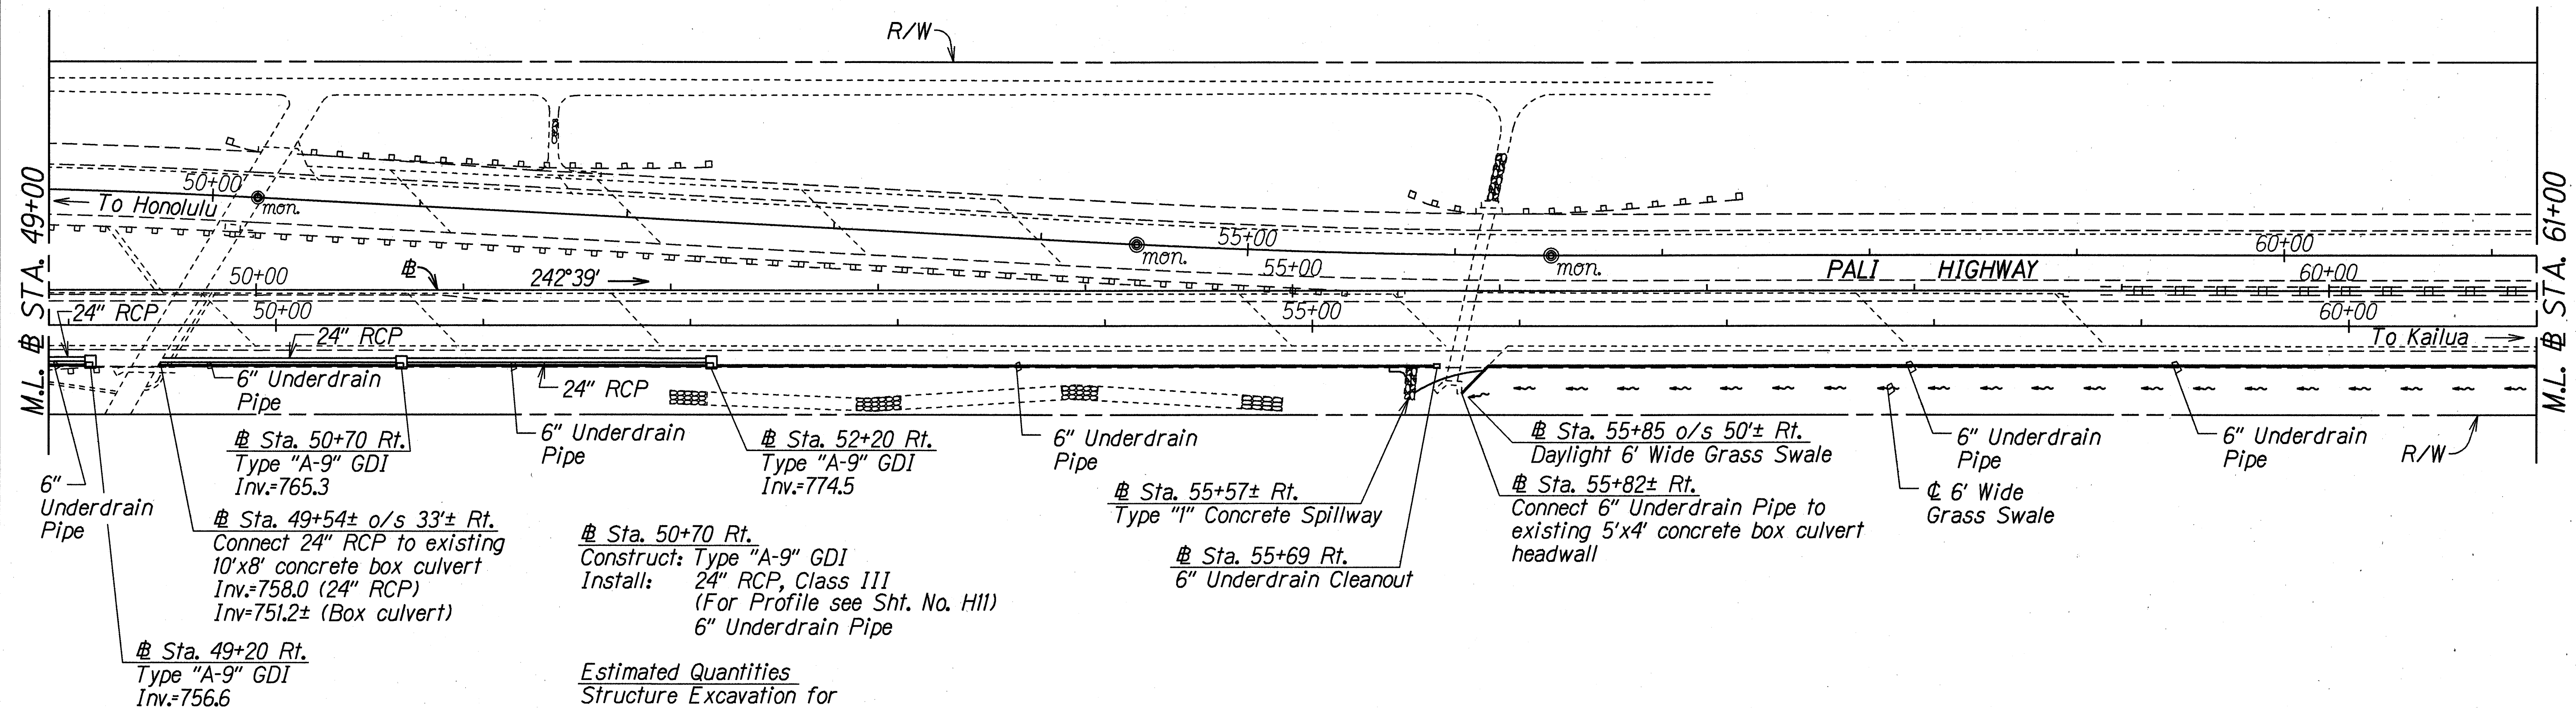

Estimated Quantities

Structure Excavation for Drainage System	= 130 C.Y.
Bedcourse Material	= 23 C.Y.
24" RCP, Class III	= 114 L.F.
Type "A-9" GDI, 4.00 ft. to 4.99 ft.	= 1 EA.
6" Perforated Underdrain Pipe	= 112 L.F.
6" Nonperforated Underdrain Pipe	= 2 L.F.

Sta. 49+20 Rt.
Construct: Type "A-9" GDI
(For Typ. Details see Sht. No. H18)
Install: 24" RCP, Class III
(For Profile see Sht. No. H11A)
6" Underdrain Pipe

Estimated Quantities

Structure Excavation for Drainage System	= 103 C.Y.
Bedcourse Material	= 21 C.Y.
24" RCP, Cl. III	= 101 L.F.
Type "A-9" GDI, 4.00 ft. to 4.99 ft.	= 1 EA.
6" Perforated Underdrain Pipe	= 97 L.F.
6" Nonperforated Underdrain Pipe	= 4 L.F.

Sta. 52+20 Rt.
Construct: Type "A-9" GDI
Install: 24" RCP, Class III
6" Underdrain Pipe

Estimated Quantities

Structure Excavation for Drainage System	= 171 C.Y.
Bedcourse Material	= 29 C.Y.
24" RCP, Cl. III	= 146 L.F.
Type "A-9" GDI, 4.00 ft. to 4.99 ft.	= 1 EA.
6" Perforated Underdrain Pipe	= 142 L.F.
6" Nonperforated Underdrain Pipe	= 4 L.F.

Sta. 52+20 Rt. to Sta. 55+69 Rt.
Construct: Type "I" Concrete Spillway
(For Typ. Details see Sht. No. H19)
Install: 6" Underdrain Pipe
Underdrain Cleanout

Estimated Quantities

Ditch and Channel Excavation	= 7 C.Y.
Type "I" Concrete Spillway	= 35 L.F.
6" Perforated Underdrain Pipe	= 342 L.F.
6" Nonperforated Underdrain Pipe	= 5 L.F.
Cleanout	= 1 EA.
Grouted Rubble Paving	= L.S. (0.5 C.Y.)

Sta. 55+82± Rt. to Sta. 61+00 Rt.
Construct: Type "4" Concrete Spillway
(For Details see Sht. No. H22)
6' Wide Grass Swale
(For Typ. Detail see Sht. No. H23)
Install: 6" Underdrain Pipe

Estimated Quantities

6' Wide Grass Swale	= 515 L.F.
6" Perforated Underdrain Pipe	= 518 L.F.
6" Nonperforated Underdrain Pipe	= 2 L.F.

6/13/97 Revised Drainage Plans.
DATE REVISION

STATE OF HAWAII
DEPARTMENT OF TRANSPORTATION
HIGHWAYS DIVISION

DRAINAGE PLAN

PALI HIGHWAY RESURFACING
Country Club Rd. to Tunnel Entrance,
Including Both Rds. to Lookout
Project No. 61A-01-97M


Scale: 1"=40' Date: May 1997

SHEET No. H6 OF 24 SHEETS

ADD. 46

ORIGINAL PLAN	DATE	4/13/97
DRAWN BY	NAME	A. Noma
CHECKED BY	NAME	C. Matsuda
APPROVED BY	NAME	
DATE		

FED. ROAD DIST. NO.	STATE	PROJ. NO.	FISCAL YEAR	SHEET NO.	TOTAL SHEETS
HAWAII	HAW.	61A-01-97M	1997	47	84

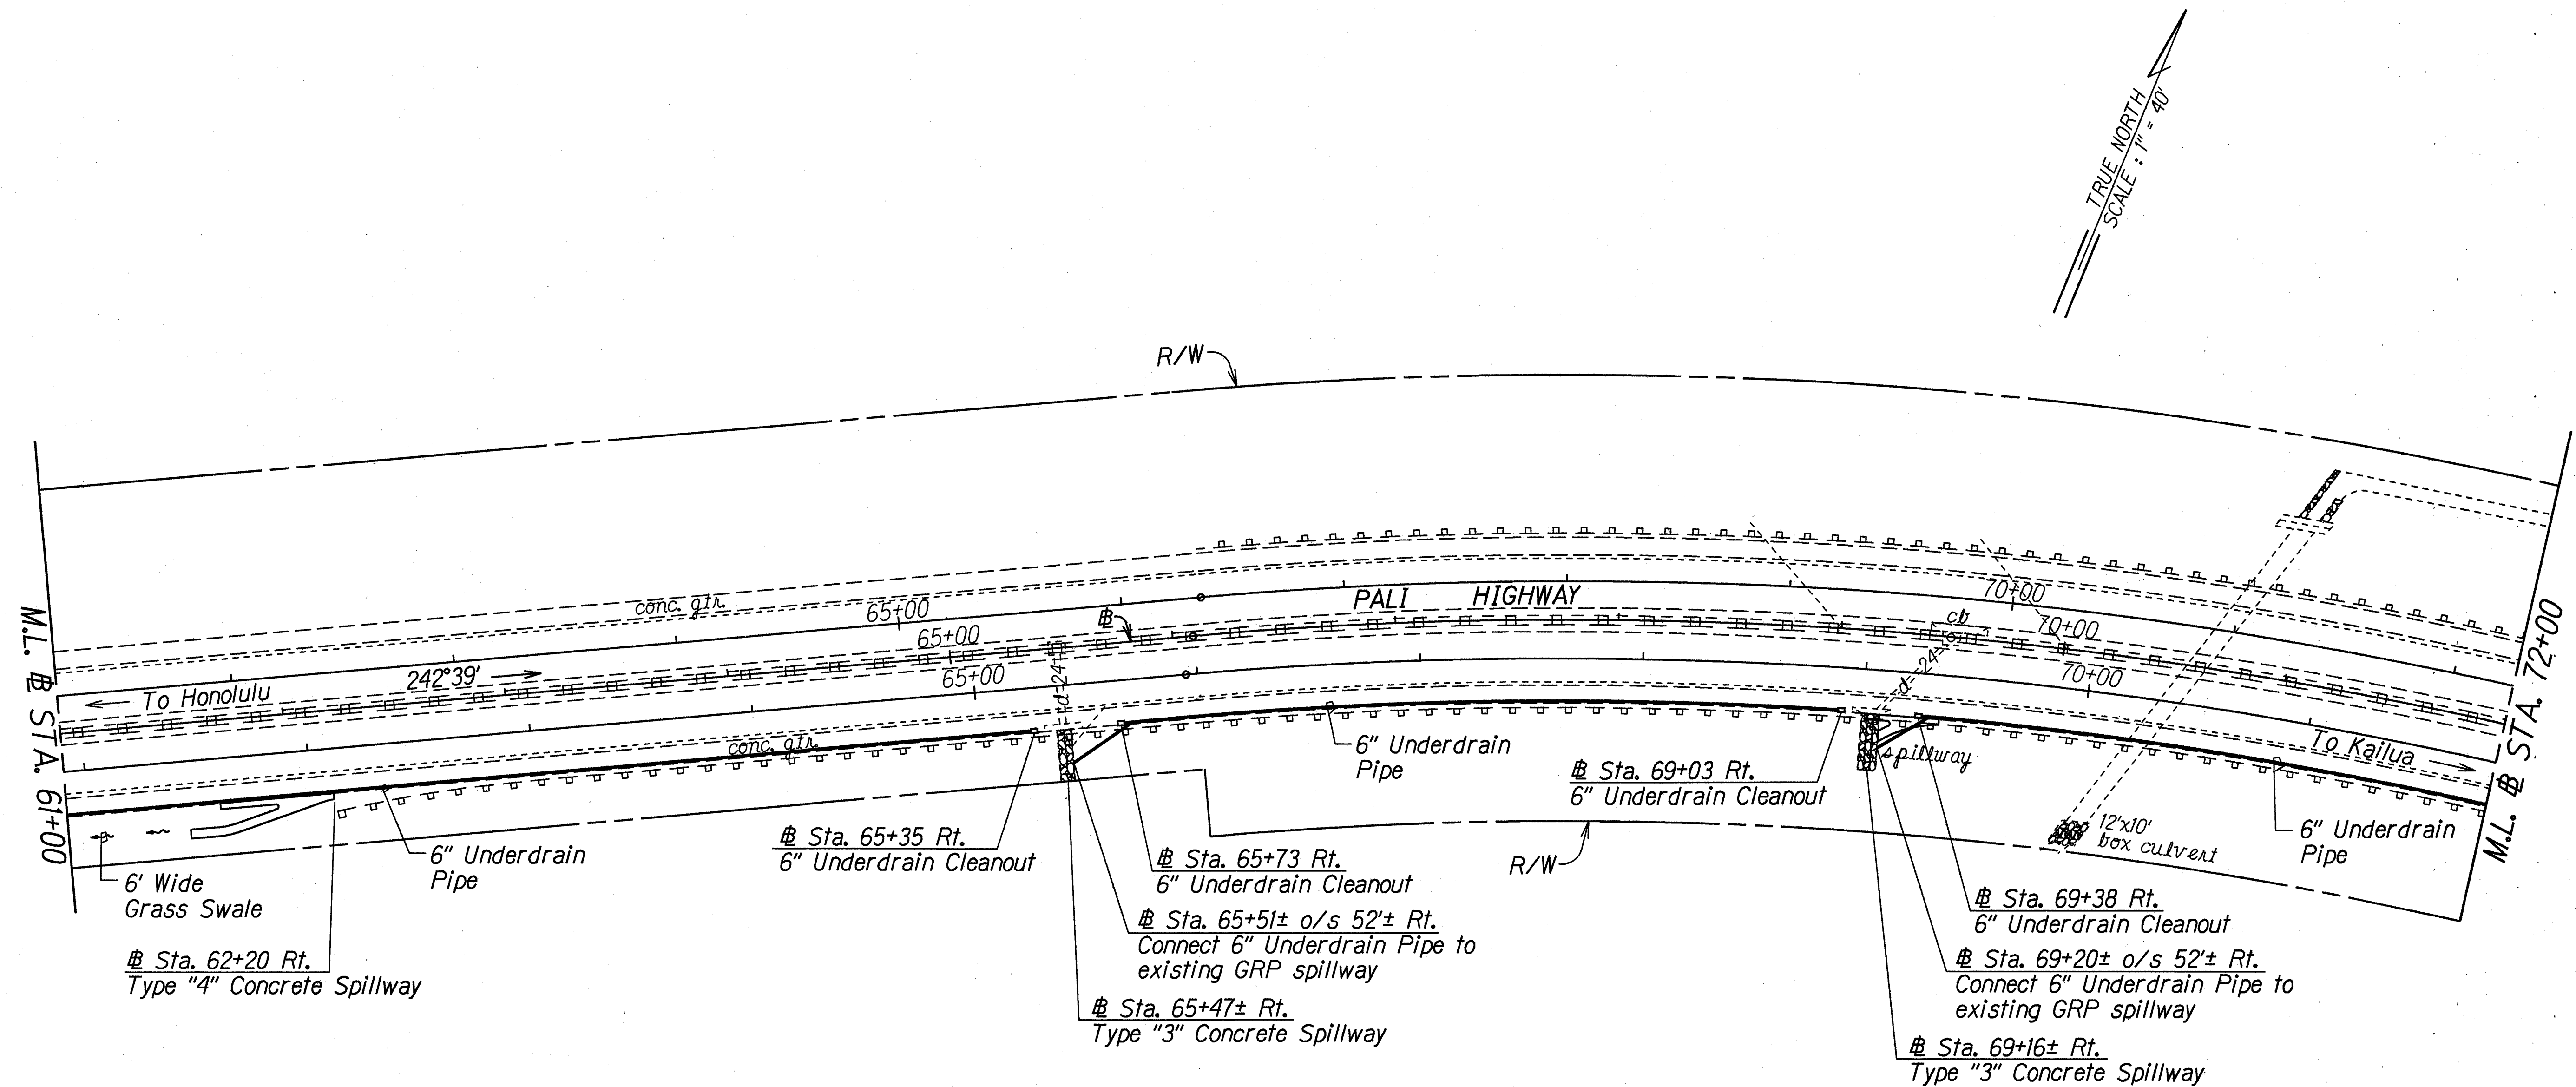

Sta. 61+00 Rt. to
Sta. 65+35 Rt.
Construct: Type "4" Concrete Spillway
(For Typ. Details see Sht. No. H22)
6' Wide Grass Swale
(For Typ. Detail see Sht. No. H23)
Underdrain Cleanout
(For Typ. Details see Sht. No. H24)
Install: 6" Underdrain Pipe

Estimated Quantities
Ditch and Channel Excavation = 10 C.Y.
Type "4" Concrete Spillway = 65 L.F.
6' Wide Grass Swale = 100 L.F.
6" Perforated Underdrain Pipe = 432 L.F.
6" Nonperforated Underdrain Pipe = 3 L.F.
Cleanout = 1 EA.

Sta. 65+47± Rt. to
Sta. 69+03 Rt.
Construct: Type "3" Concrete Spillway
(For Typ. Details see Sht. No. H21)
Underdrain Cleanout
Install: 6" Underdrain Pipe

Estimated Quantities
Ditch and Channel Excavation = 10 C.Y.
Type "3" Concrete Spillway = 30 L.F.
6" Perforated Underdrain Pipe = 352 L.F.
6" Nonperforated Underdrain Pipe = 8 L.F.
Cleanout = 2 EA.
Grouted Rubble Paving = L.S. (0.5 CY)

Sta. 69+16± Rt. to
Sta. 72+00 Rt.
Construct: Type "3" Concrete Spillway
Underdrain Cleanout
Install: 6" Underdrain Pipe

Estimated Quantities
Ditch and Channel Excavation = 10 C.Y.
Type "3" Concrete Spillway = 30 L.F.
6" Perforated Underdrain Pipe = 283 L.F.
6" Nonperforated Underdrain Pipe = 5 L.F.
Cleanout = 1 EA.
Grouted Rubble Paving = L.S. (0.5 CY)

6/13/97 Revised Drainage Plans.
DATE REVISION

STATE OF HAWAII
DEPARTMENT OF TRANSPORTATION
HIGHWAYS DIVISION

DRAINAGE PLAN

PALI HIGHWAY RESURFACING
Country Club Rd. to Tunnel Entrance,
Including Both Rds. to Lookout
Project No. 61A-01-97M

Scale: 1"=40' Date: May 1997


SHEET No. H7 OF 24 SHEETS

ADD. 47

ORIGINAL PLAN	DATE
4/13/97	
TRACED BY A. Noma	
DESIGNED BY C. Matsuda	
CHECKED BY	

FED. ROAD DIST. NO.	STATE	PROJ. NO.	FISCAL YEAR	SHEET NO.	TOTAL SHEETS
HAWAII	HAW.	61A-01-97M	1997	48	84

TRUE NORTH
SCALE: 1" = 40'

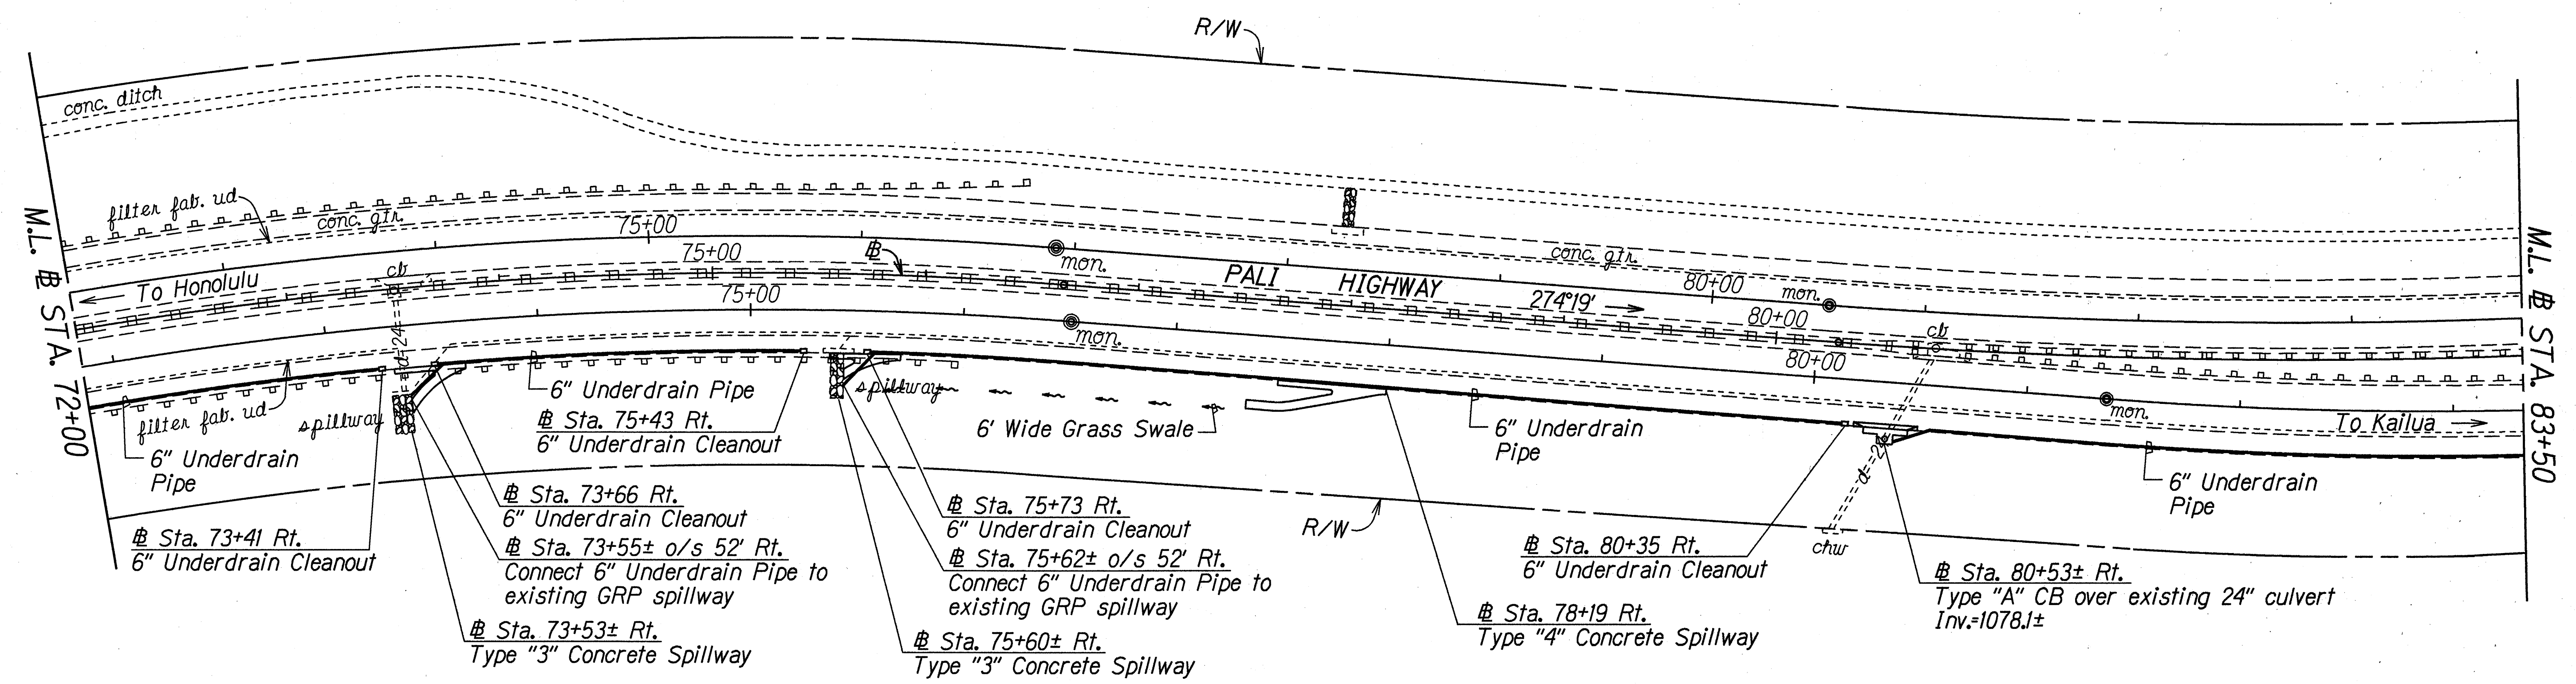

ORIGINAL PLAN	DATE
SURVEY PLOTTED BY	4/13/97
DRAWN BY	A. Noma
TRACED BY	C. Metcalfe
DESIGNED BY	C. Metcalfe
CHECKED BY	K. H. H. H.

Sta. 72+00 Rt. to
Sta. 73+41 Rt.
Construct: Underdrain Cleanout
(For Typ. Details see Sht. No. H24)
Install: 6" Underdrain Pipe
Estimated Quantities
6" Perforated Underdrain Pipe = 122 L.F.
6" Nonperforated Underdrain Pipe = 3 L.F.
Cleanout = 1 EA.

Sta. 73+53± Rt. to
Sta. 75+43 Rt.
Construct: Type "3" Concrete Spillway
(For Typ. Details see Sht. No. H21)
Install: 6" Underdrain Pipe
Estimated Quantities
Ditch and Channel Excavation = 10 C.Y.
Type "3" Concrete Spillway = 30 L.F.
6" Perforated Underdrain Pipe = 192 L.F.
6" Nonperforated Underdrain Pipe = 8 L.F.
Cleanout = 2 EA.
Grouted Rubble Paving = L.S. (0.5 CY)


Sta. 75+60± Rt. to
Sta. 80+35 Rt.
Construct: Type "3" Concrete Spillway
(For Typ. Details see Sht. No. H21)
Type "4" Concrete Spillway
(For Typical Detail see Sht. No. H22)
6' Wide Grass Swale
(For Typical Detail see Sht. No. H23)
Underdrain Cleanouts
Install: 6" Underdrain Pipe
Estimated Quantities
Ditch and Channel Excavation = 20 C.Y.
Type "3" Concrete Spillway = 30 L.F.
Type "4" Concrete Spillway = 65 L.F.
6' Wide Grass Swale = 225 L.F.
6" Perforated Underdrain Pipe = 475 L.F.
6" Nonperforated Underdrain Pipe = 6 L.F.
Cleanout = 2 EA.
Grouted Rubble Paving = L.S. (0.5 CY)

Sta. 80+53± Rt. to
Sta. 83+50 Rt.
Construct: Type "A" Catch Basin
Install: 6" Underdrain Pipe
Estimated Quantities
Type "A" Catch Basin, 4.00 ft. to 4.99 ft. = 1 EA.
6" Perforated Underdrain Pipe = 292 L.F.
6" Nonperforated Underdrain Pipe = 2 L.F.

6/13/97	Revised Drainage Plans.
DATE	REVISION
STATE OF HAWAII DEPARTMENT OF TRANSPORTATION HIGHWAYS DIVISION	
DRAINAGE PLAN	
PALI HIGHWAY RESURFACING Country Club Rd. to Tunnel Entrance, Including Both Rds. to Lookout Project No. 61A-01-97M	
Scale: 1"=40'	Date: May 1997
SHEET No. H8 OF 24 SHEETS	

FED. ROAD DIST. NO.	STATE	PROJ. NO.	FISCAL YEAR	SHEET NO.	TOTAL SHEETS
HAWAII	HAW.	61A-01-97M	1997	49	84

TRUE NORTH
SCALE: 1" = 40'

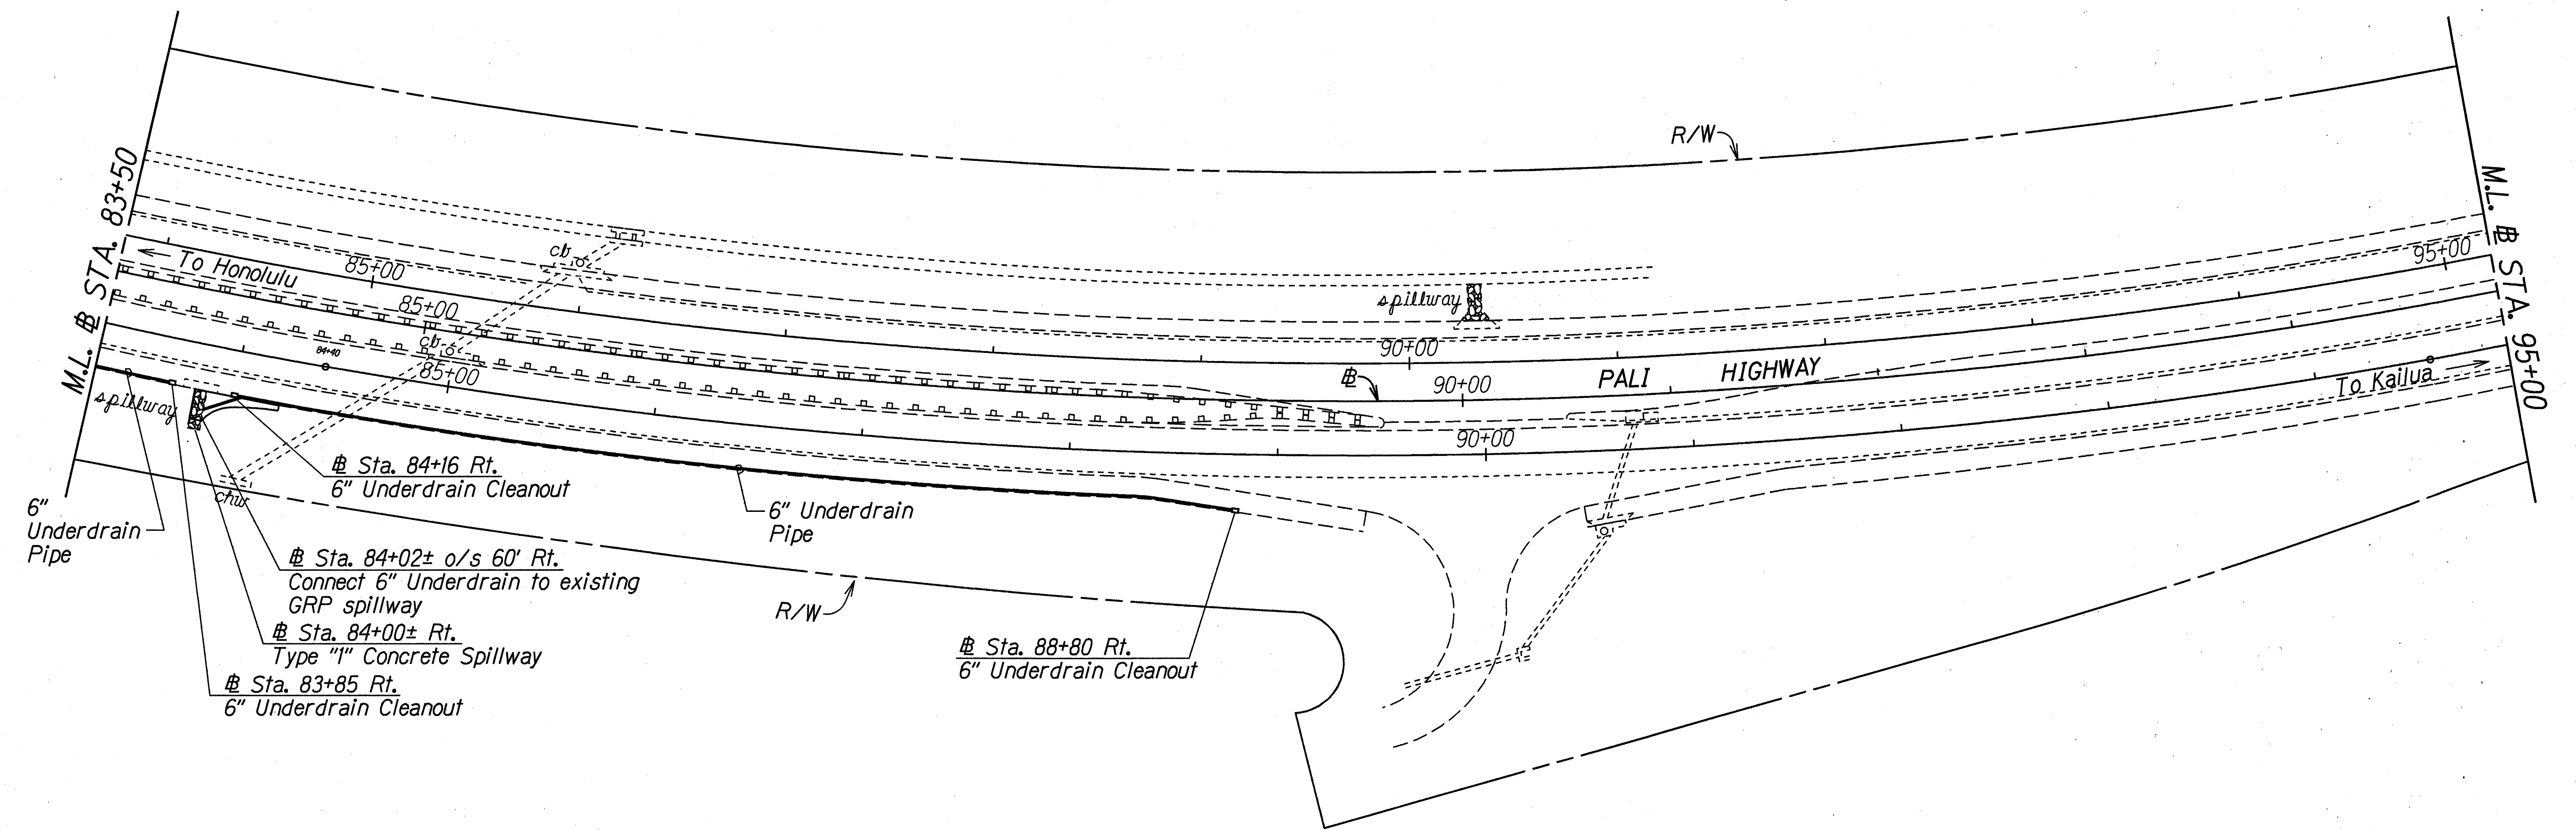

6" Underdrain Pipe
 # Sta. 84+16 Rt.
 6" Underdrain Cleanout
 # Sta. 84+02± o/s 60' Rt.
 Connect 6" Underdrain to existing GRP spillway
 # Sta. 84+00± Rt.
 Type "I" Concrete Spillway
 # Sta. 83+85 Rt.
 6" Underdrain Cleanout

Sta. 88+80 Rt.
 6" Underdrain Cleanout





Sta. 83+50 Rt. to
 # Sta. 83+85 Rt.
 Construct: Underdrain Cleanout
 (For Typ. Details see Sht. No. H24)
 Install: 6" Underdrain Pipe
 Estimated Quantities
 6" Perforated Underdrain Pipe = 32 L.F.
 6" Nonperforated Underdrain Pipe = 3 L.F.
 Cleanout = 1 EA.

Sta. 84+00± Rt. to
 # Sta. 88+80 Rt.
 Construct: Type "I" Concrete Spillway
 (For Typ. Details see Sht. No. H19)
 Underdrain Cleanout
 Install: 6" Underdrain Pipe
 Estimated Quantities
 Ditch and Channel Excavation = 7 C.Y.
 Type "I" Spillway = 35 L.F.
 6" Perforated Underdrain Pipe = 476 L.F.
 6" Nonperforated Underdrain Pipe = 8 L.F.
 Cleanout = 2 EA.
 Grouted Rubble Paving = L.S. (0.5 C.Y.)

ORIGINAL PLAN	DATE
SURVEY PLOTTED BY	4/13/97
DRAWN BY A. Noma	
TRACED BY	
DESIGNED BY C. Matsuda	
CHECKED BY	
NOTED BY	

6/13/97	Revised Drainage Plans.
DATE	REVISION
STATE OF HAWAII DEPARTMENT OF TRANSPORTATION HIGHWAYS DIVISION DRAINAGE PLAN PALI HIGHWAY RESURFACING Country Club Rd. to Tunnel Entrance, Including Both Rds. to Lookout Project No. 61A-01-97M	
Scale: 1"=40'	Date: May 1997
SHEET No. H9 OF 24 SHEETS	

FED. ROAD DIST. NO.	STATE	FED. AID PROJ. NO.	FISCAL YEAR	SHEET NO.	TOTAL SHEETS
HAWAII	HAW.	61A-01-97M	1997	50	84

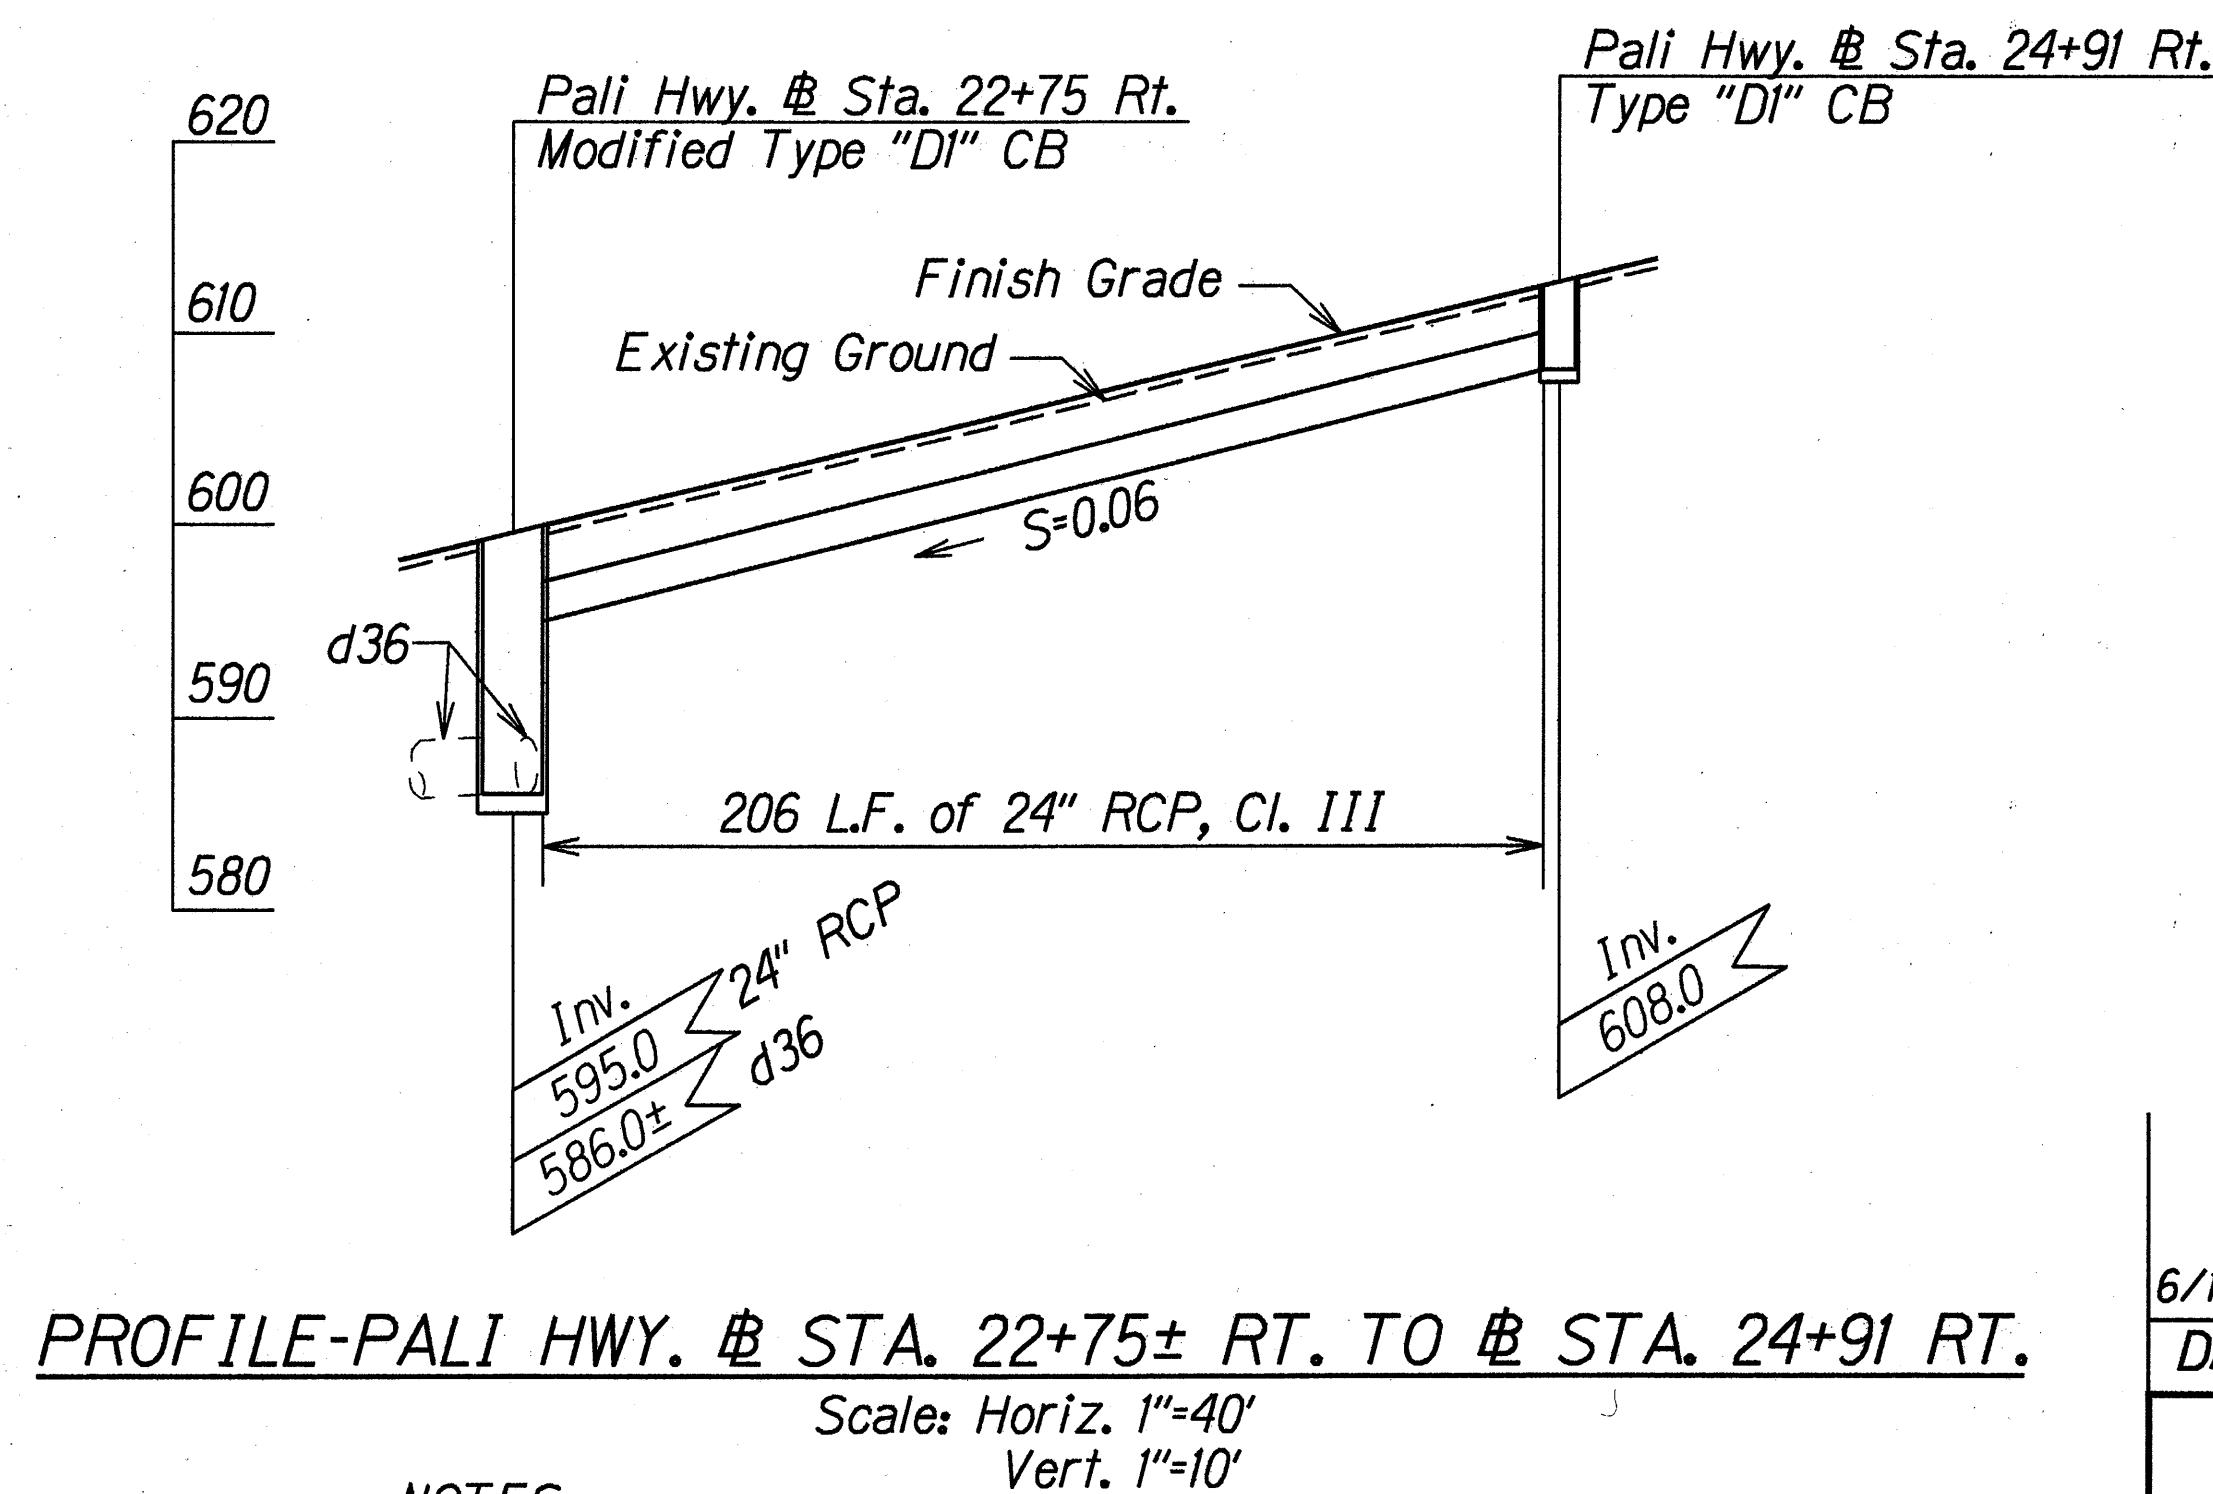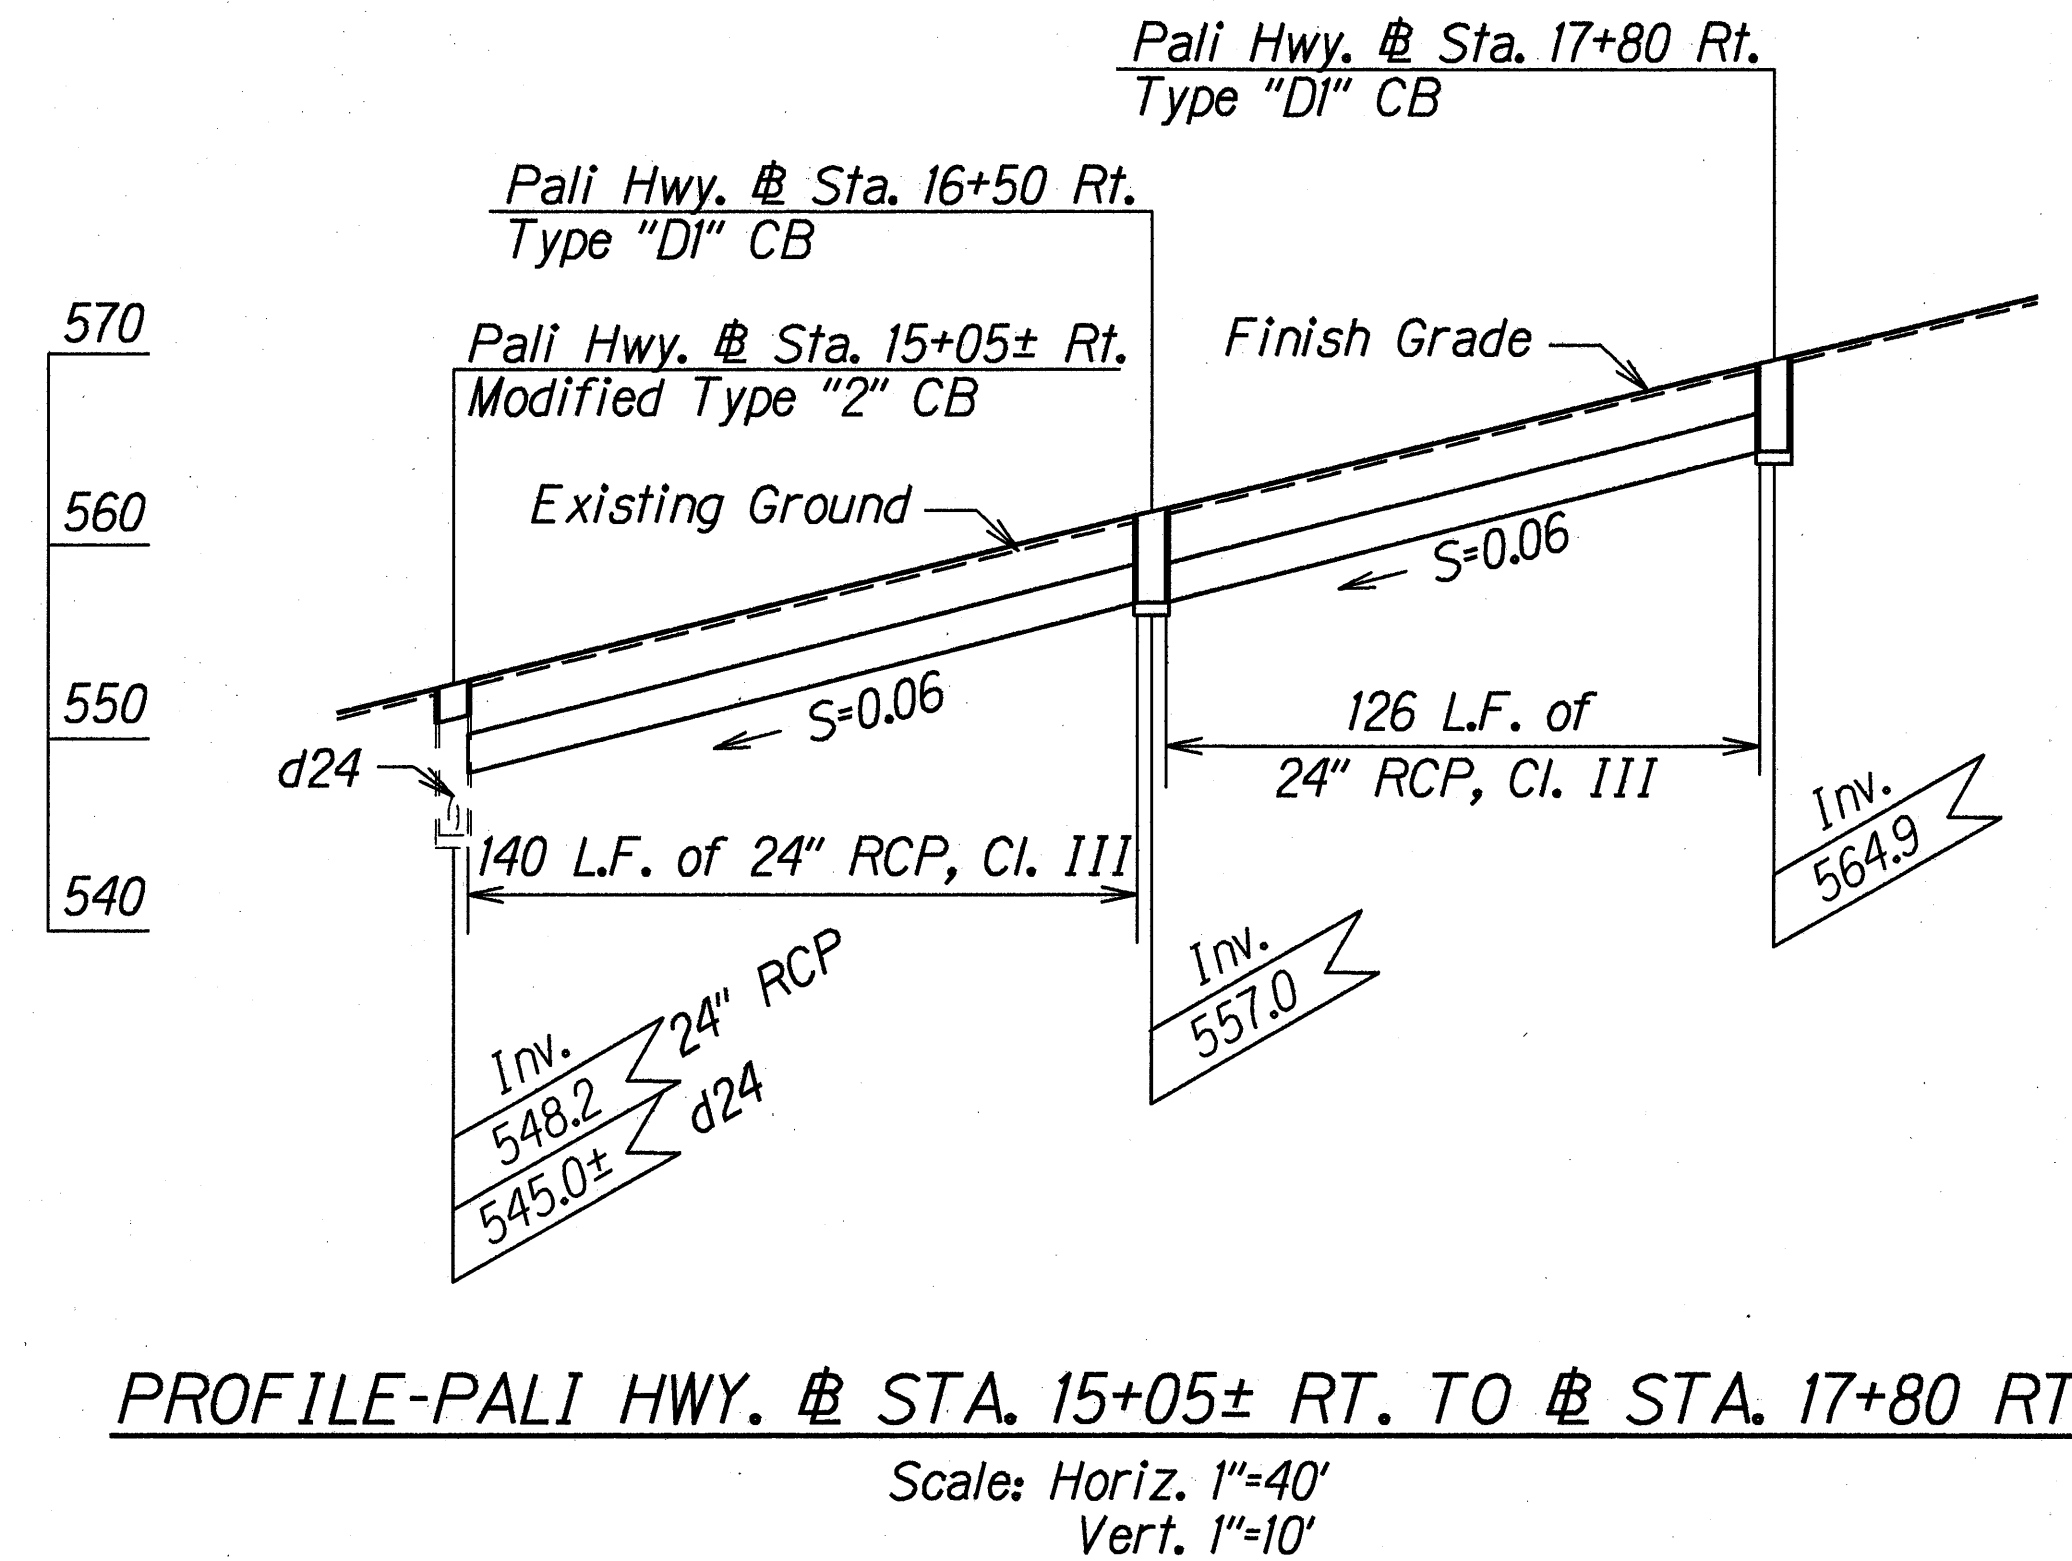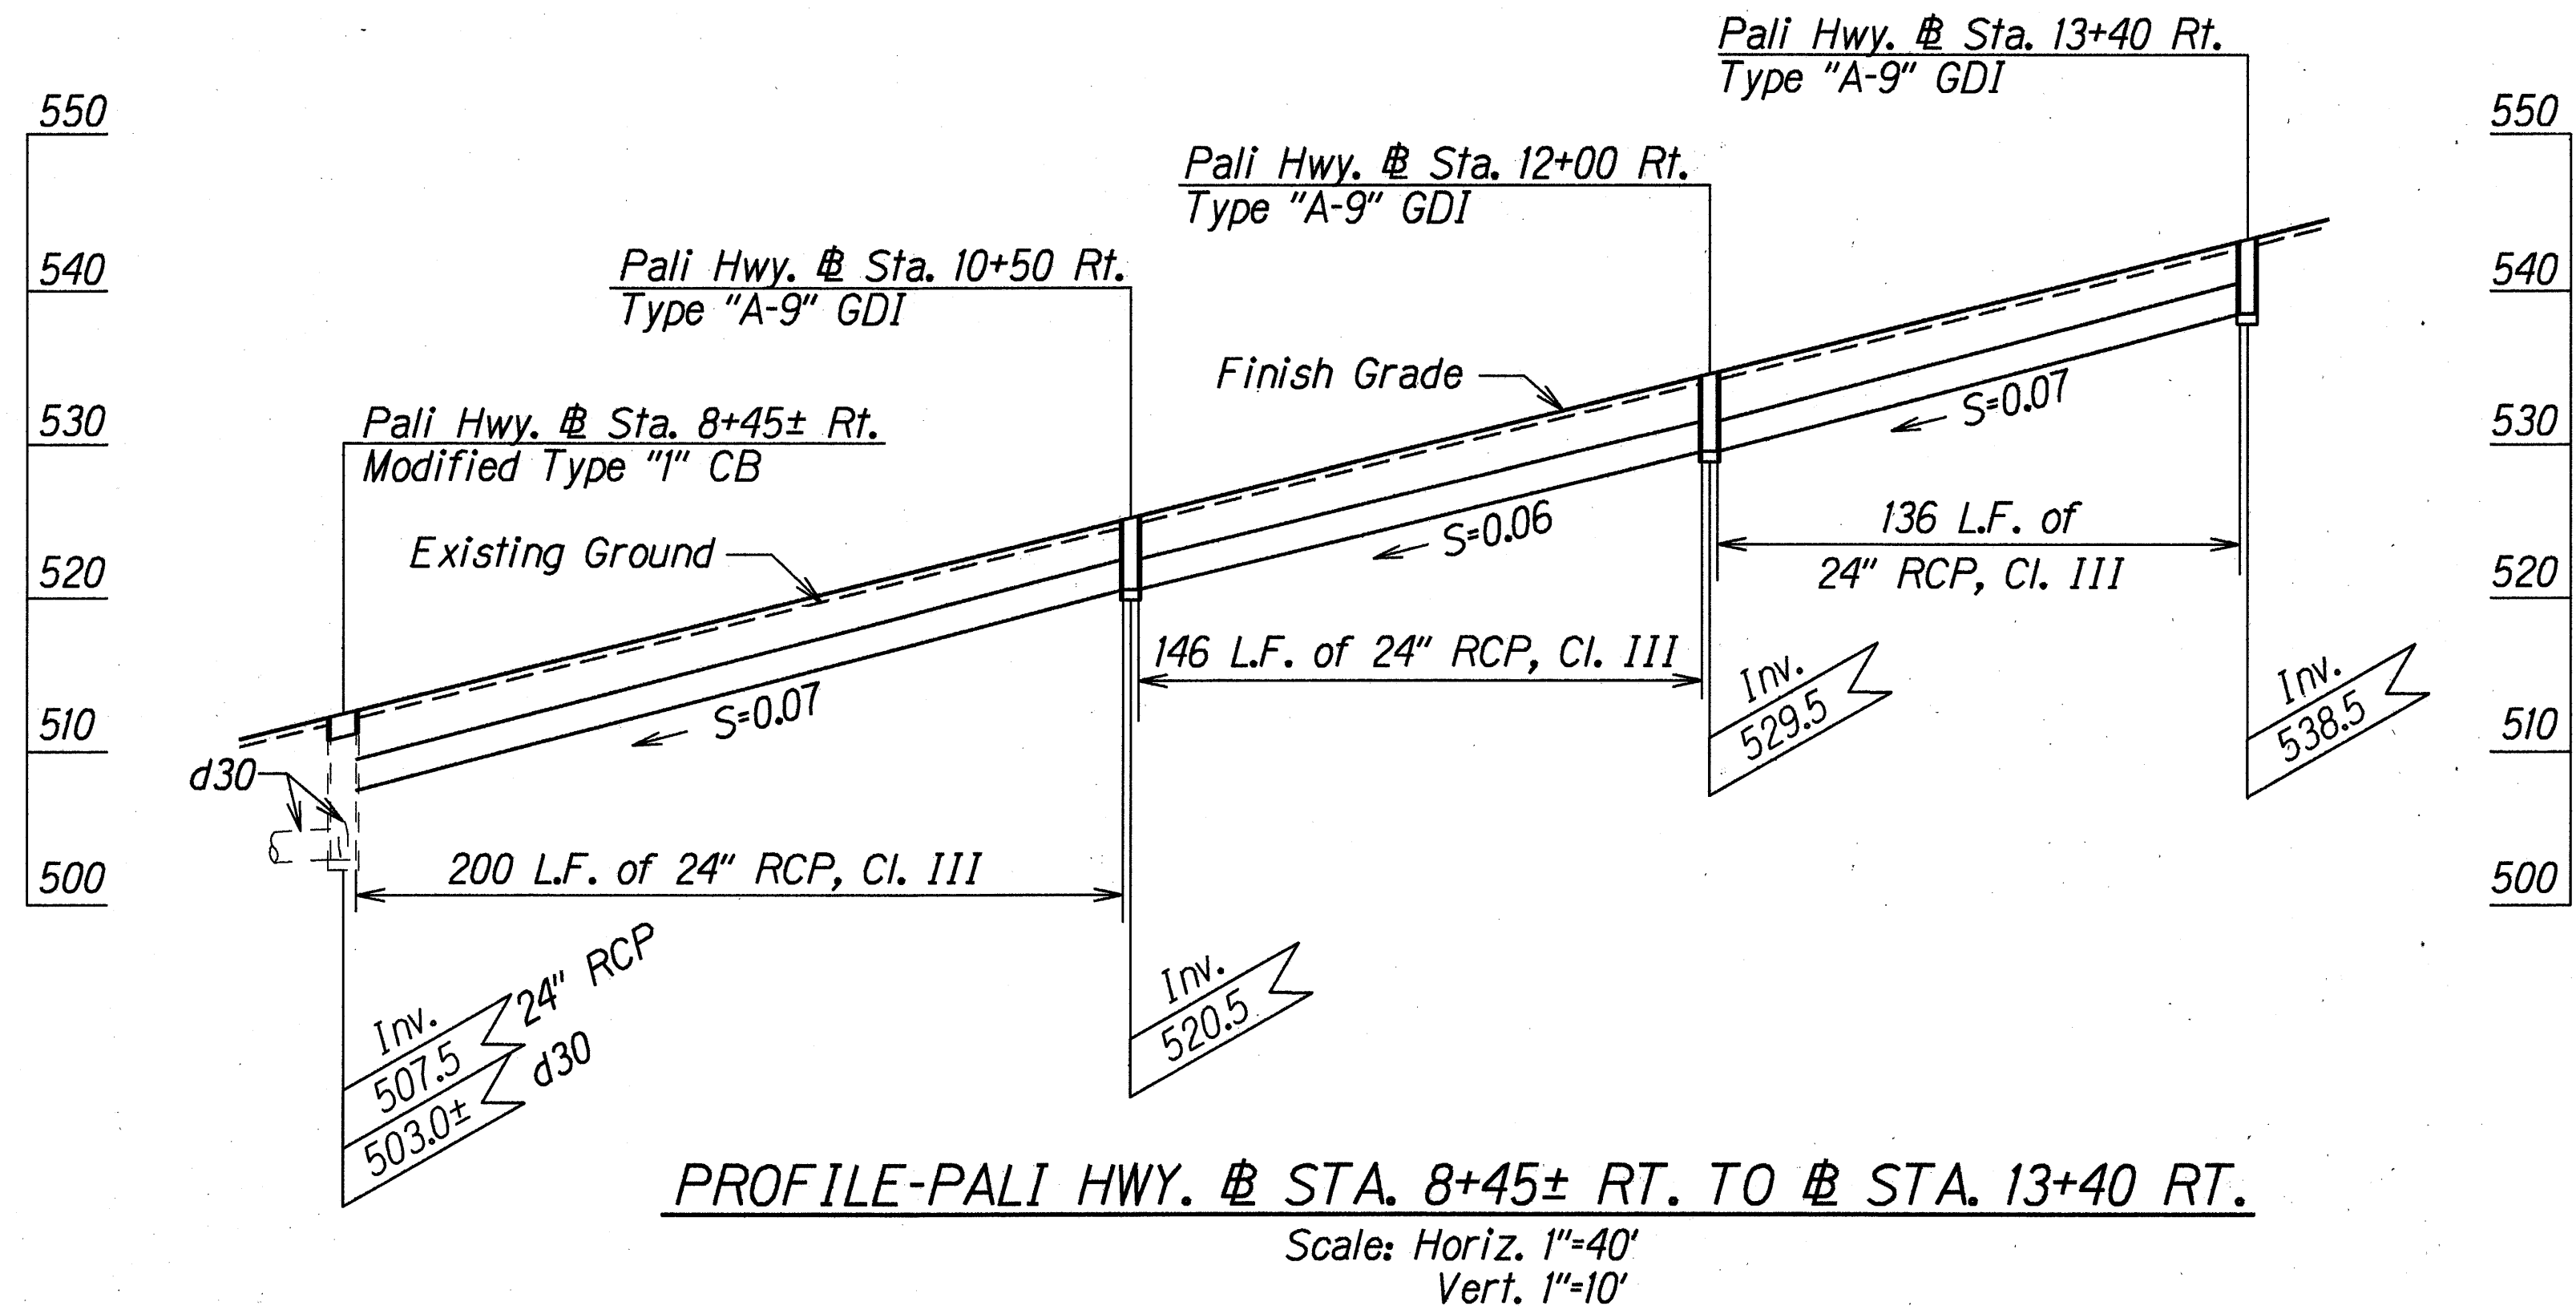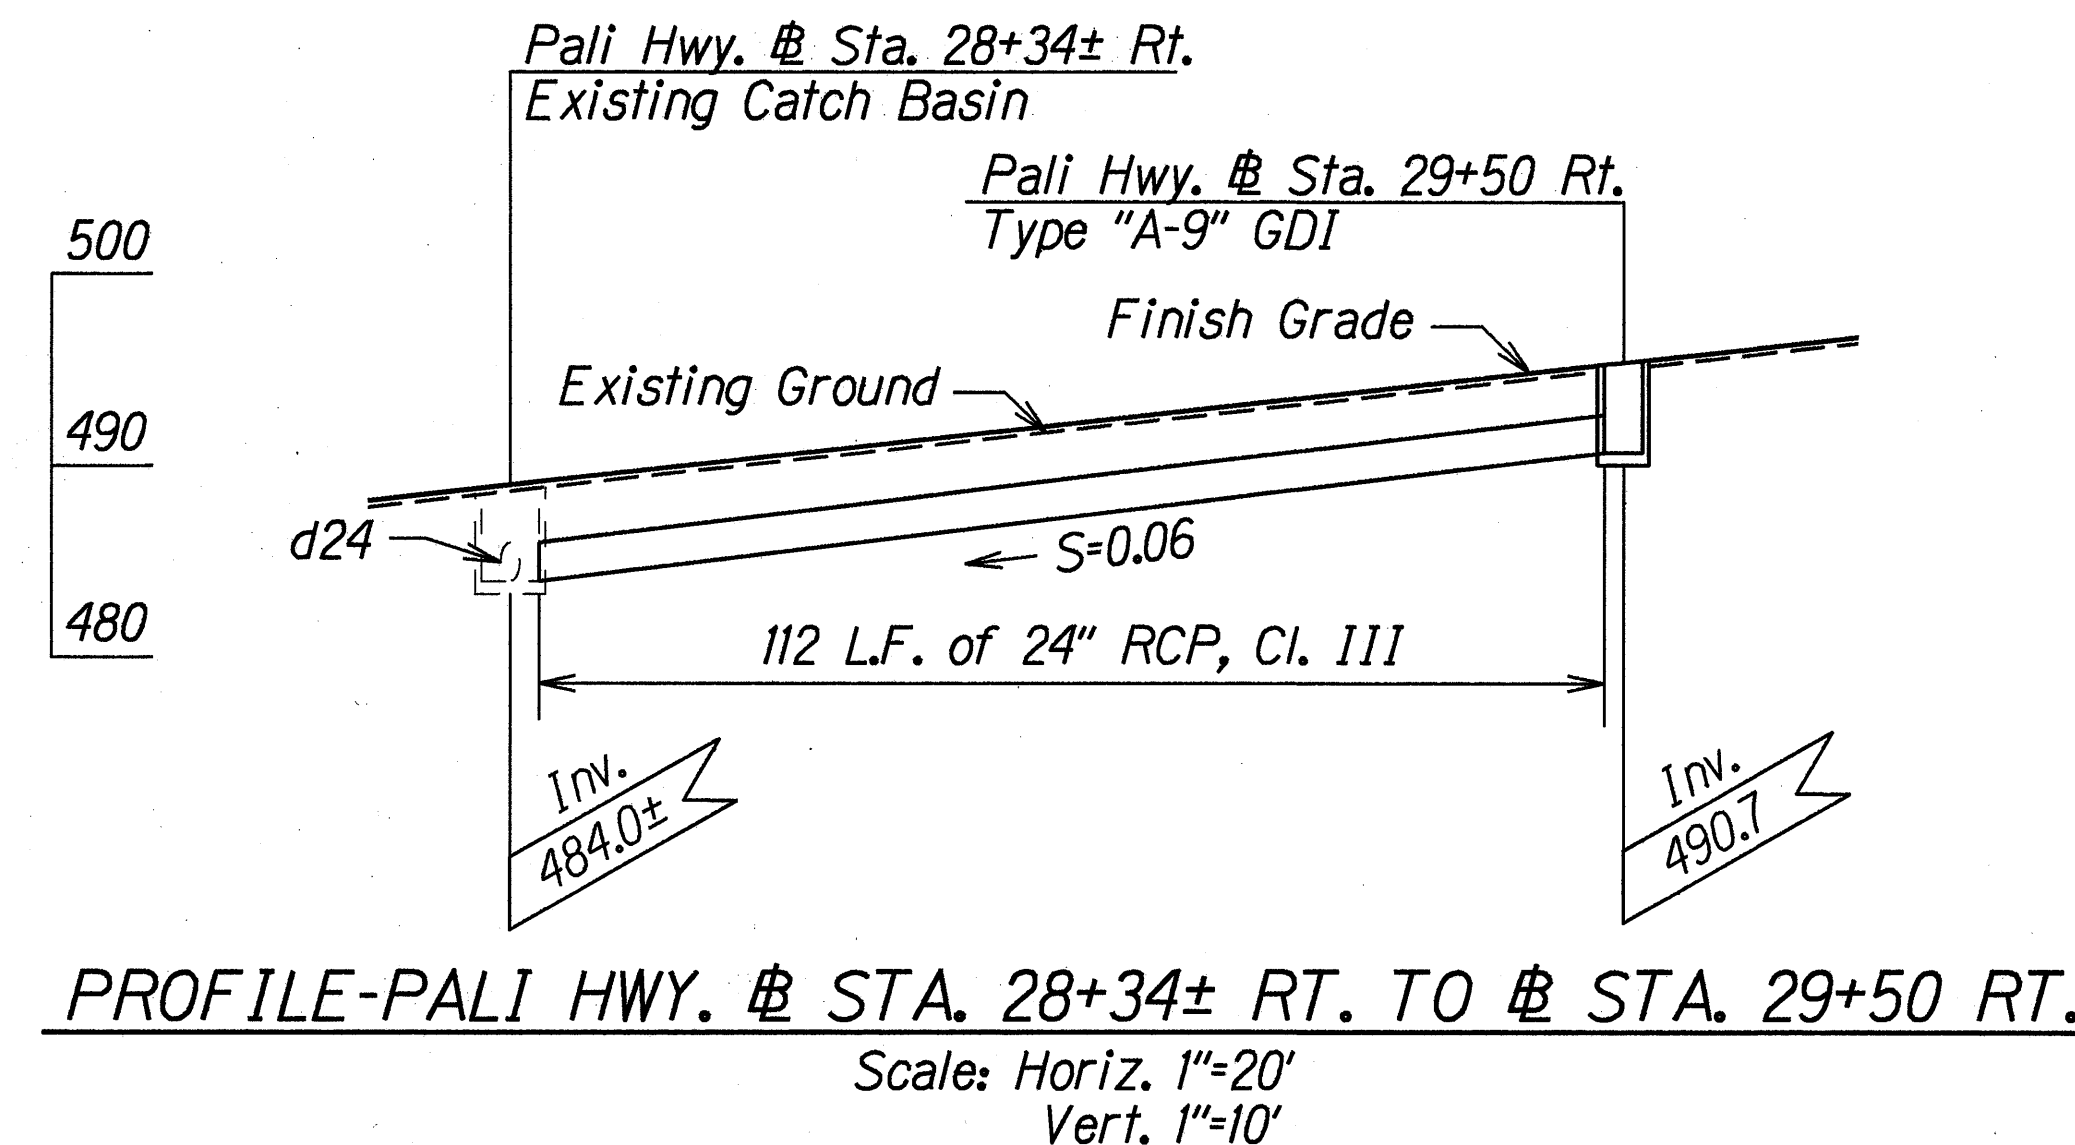

NOTES

- Existing ground and finish grade elevations shown were interpolated from as-built plans. The actual inverts of the 24-inch reinforced concrete pipe shall be located a minimum of 4'-3" below finish grade.
- The Contractor shall verify the inverts of all proposed drainage structures shown on the profiles.

6/13/97	Revised Drainage Profiles.
DATE	REVISION

STATE OF HAWAII
DEPARTMENT OF TRANSPORTATION
HIGHWAYS DIVISION

DRAINAGE PROFILES


PALI HIGHWAY RESURFACING
Country Club Rd. to Tunnel Entrance,
Including Both Rds. to Lookout
Project No. 61A-01-97M

Scale: As Shown Date: May 1997


SHEET No. H10 OF 24 SHEETS

SURVEY PLOTTED BY	DATE
DRAWN BY	4/30/97
NOTES	
CHECKED BY	
ORIGINAL PLAN	
NOTES	
CHECKED BY	

FED. ROAD DIST. NO.	STATE	FED. AID PROJ. NO.	FISCAL YEAR	SHEET NO.	TOTAL SHEETS
HAWAII	HAW.	61A-01-97M	1997	51	84

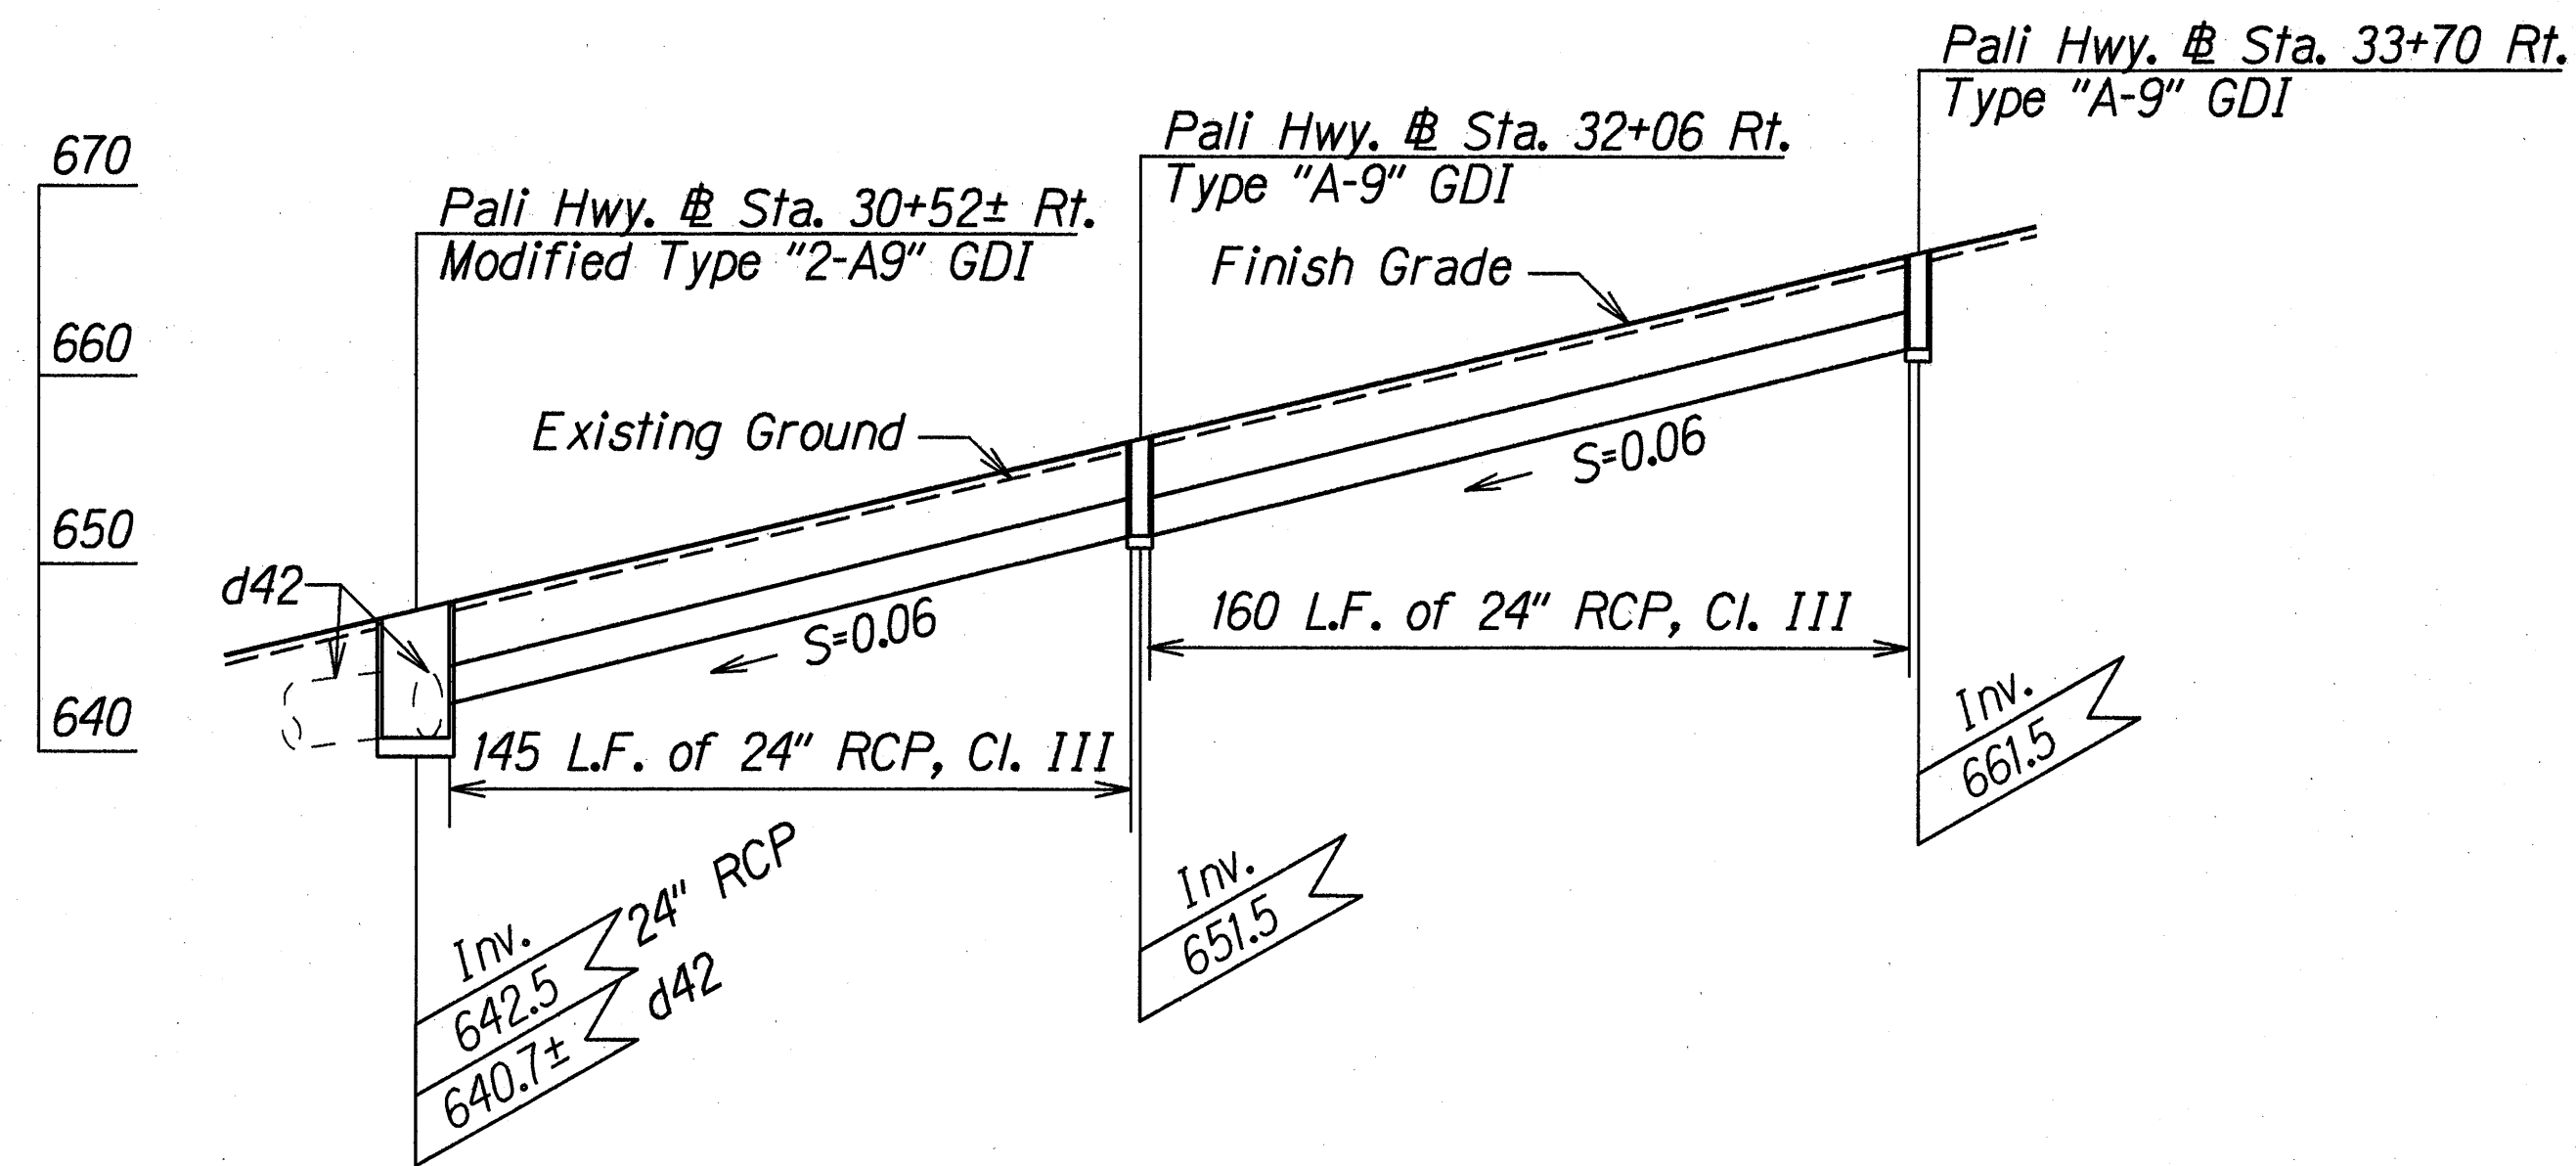

PROFILE-PALI HWY. @ STA. 30+52± RT. TO @ STA. 33+70 RT.
Scale: Horiz. 1"=40'
Vert. 1"=10'

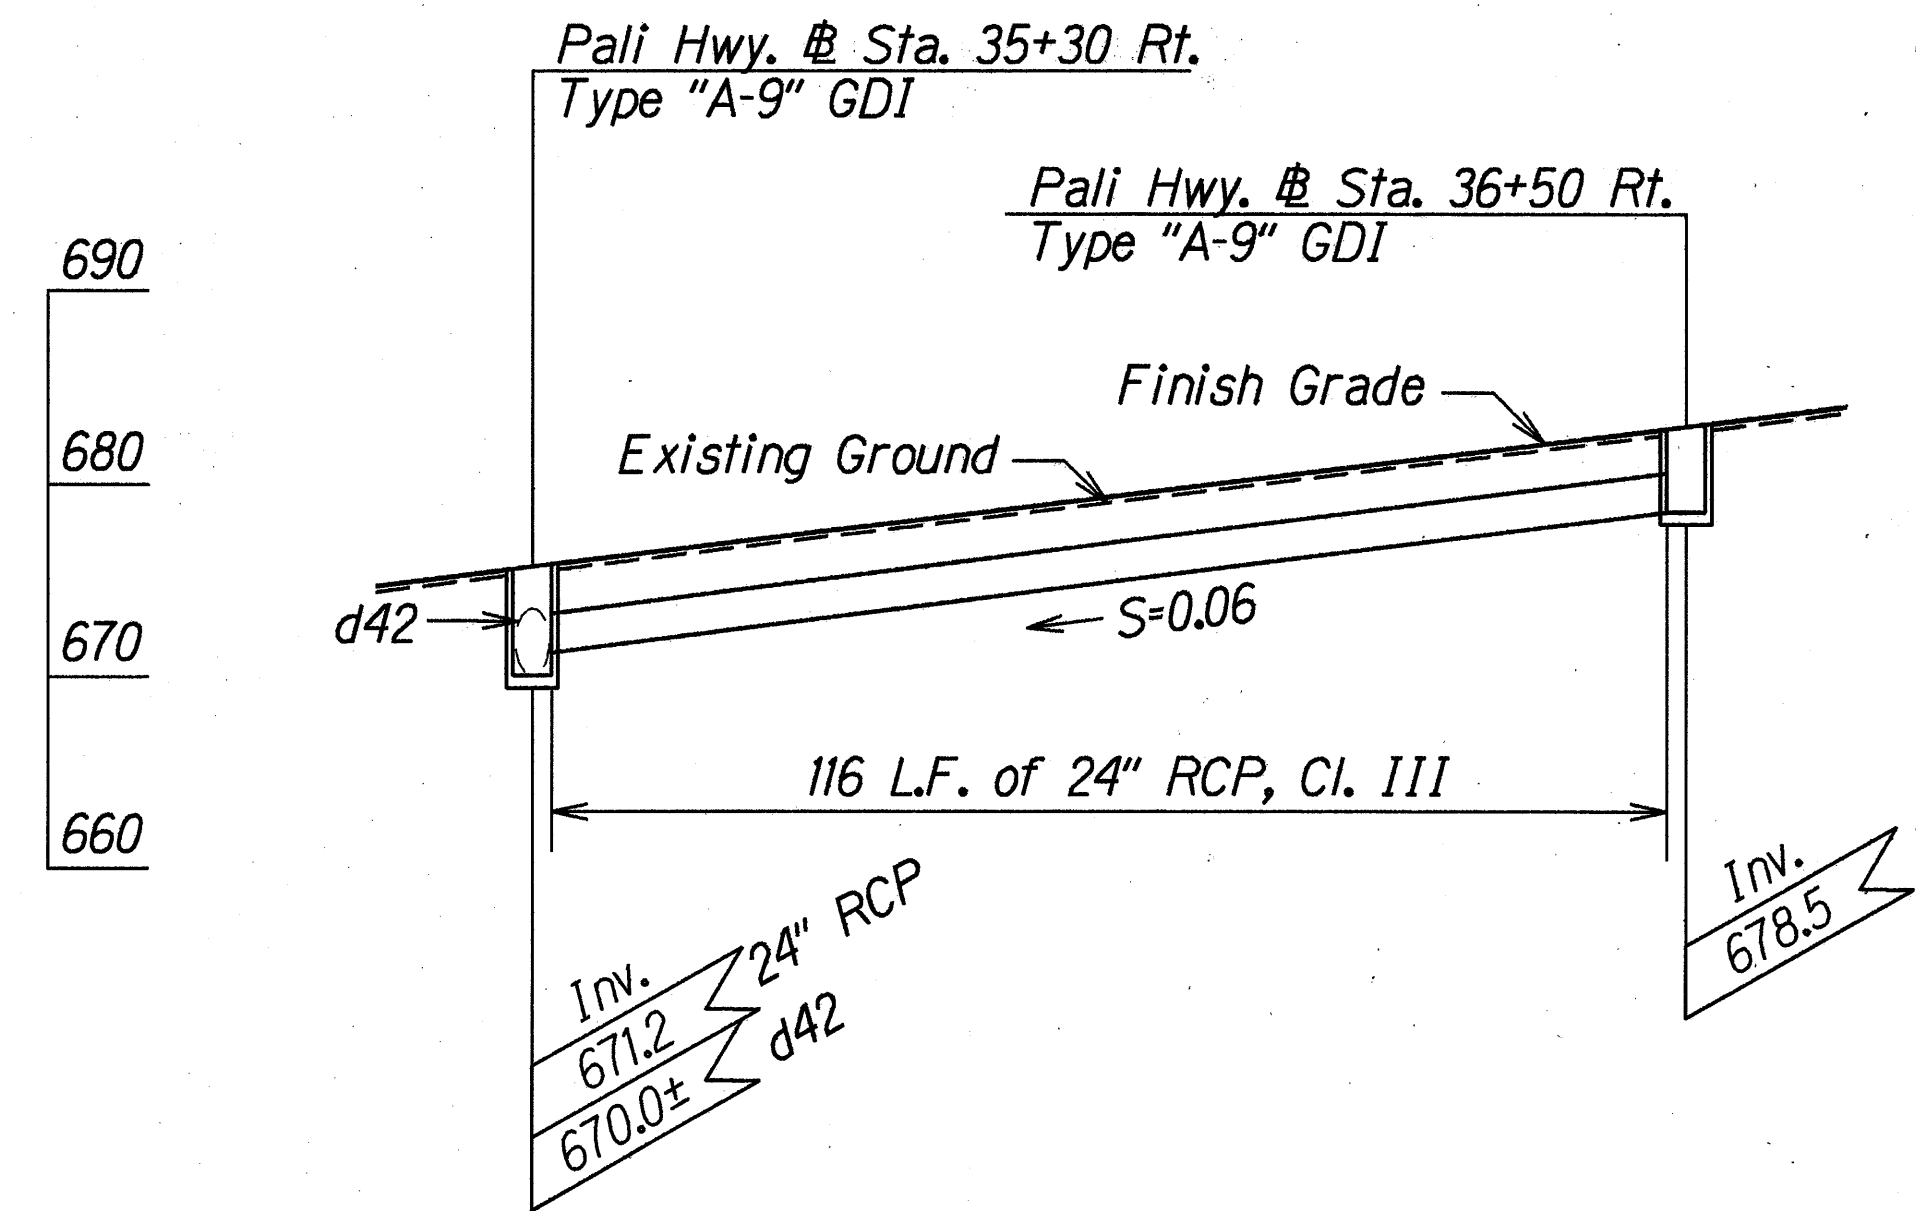


PROFILE-PALI HWY. @ STA. 35+30± RT. TO @ STA. 36+50 RT.
Scale: Horiz. 1"=20'
Vert. 1"=10'

ORIGINAL PLAN	SURVEY PLOTTED BY	DATE
NOTED	DRAWN BY	5/3/97
dh2	TRACED BY	
dh2	CHECKED BY	
dh2	QUANTITIES BY	
dh2		

- NOTES**
- Existing ground and finish grade elevations shown were interpolated from as-built plans. The actual inverts of the 24-inch reinforced concrete pipe shall be located a minimum of 4'-3" below finish grade.
 - The Contractor shall verify the inverts of all proposed drainage structures shown on the profiles.


6/13/97	Revised Drainage Profiles.
DATE	REVISION
STATE OF HAWAII DEPARTMENT OF TRANSPORTATION HIGHWAYS DIVISION DRAINAGE PROFILES <u>PALI HIGHWAY RESURFACING</u> <u>Country Club Rd. to Tunnel Entrance,</u> <u>Including Both Rds. to Lookout</u> <u>Project No. 61A-01-97M</u> Scale: As Shown Date: May 1997 SHEET No. 51 OF 24 SHEETS	

FED. ROAD DIST. NO.	STATE	FED. AID PROJ. NO.	FISCAL YEAR	SHEET NO.	TOTAL SHEETS
HAWAII	HAW.	61A-01-97M	1997	ADD. 51 S-1	84

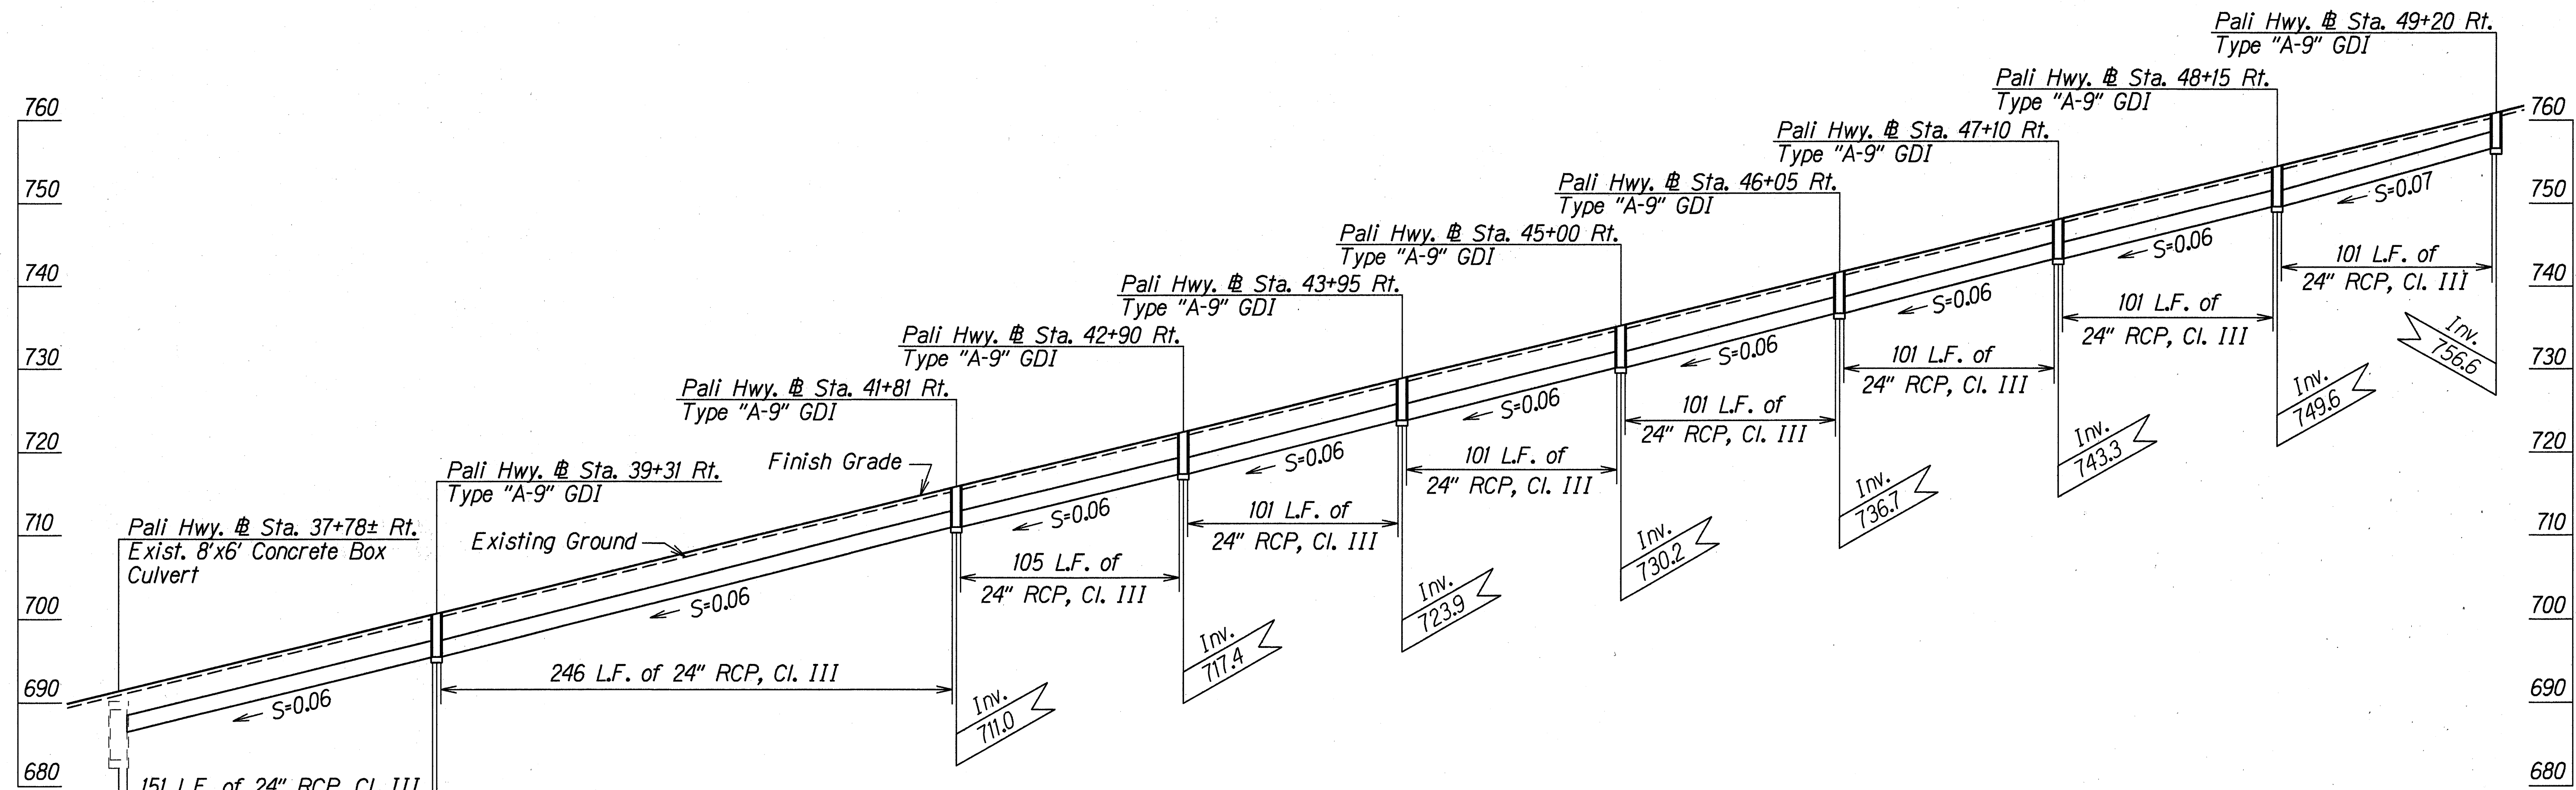

PROFILE-PALI HWY. STA. 37+78± RT. TO STA. 49+20 RT.

Scale: Horiz. 1"=40'
Vert. 1"=10'

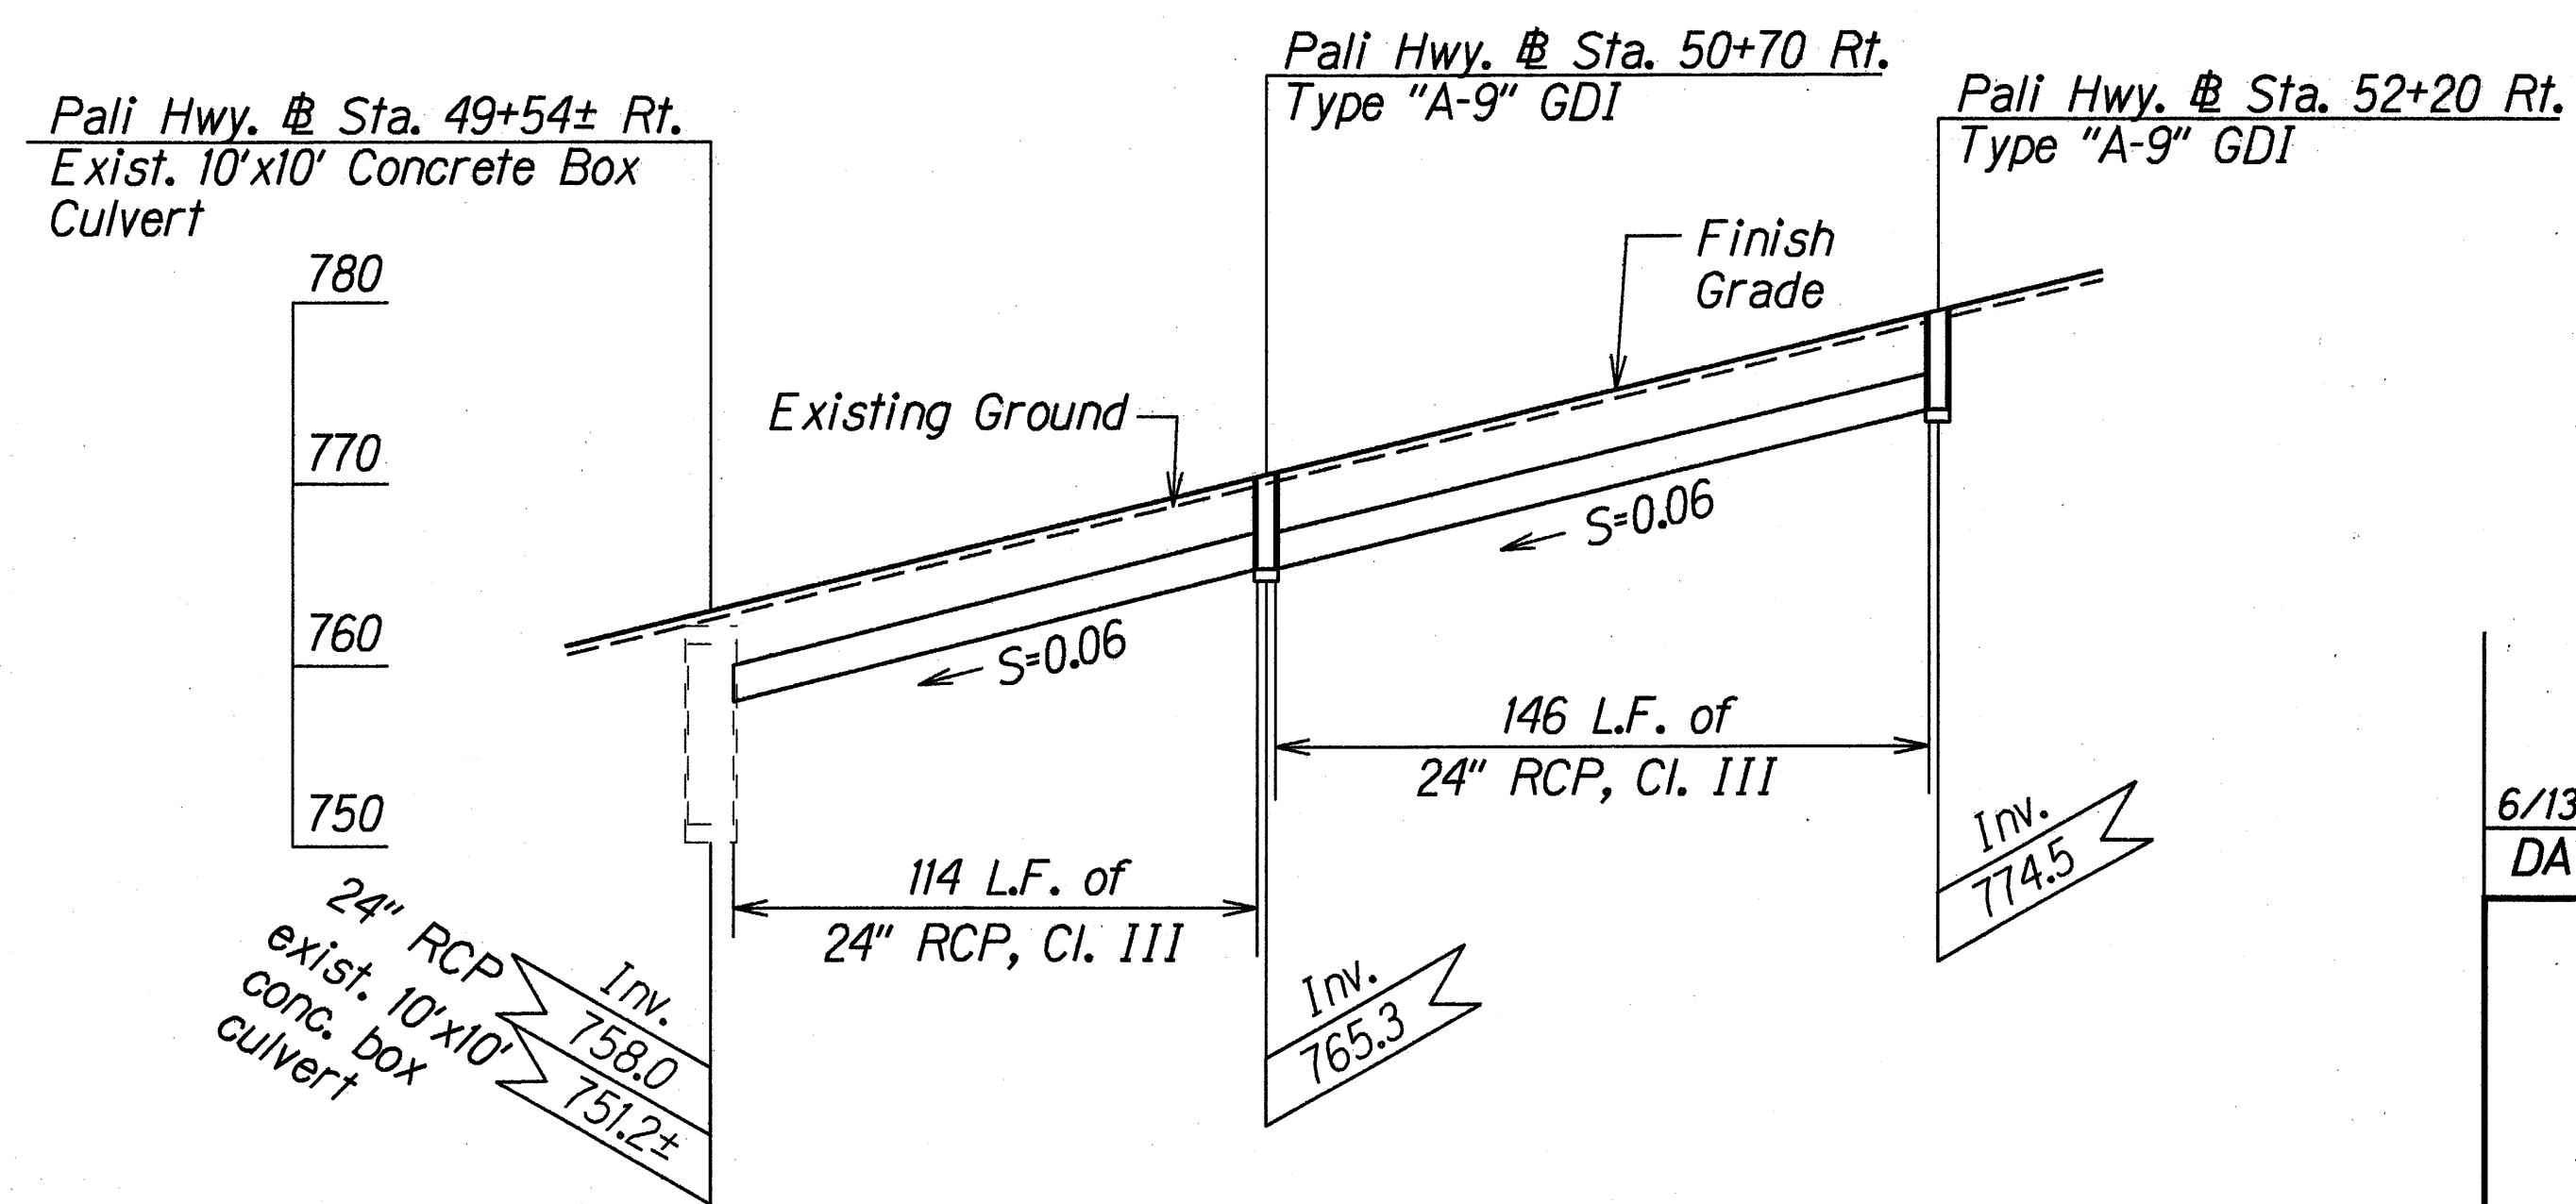

PROFILE-PALI HWY. STA. 49+54± RT. TO STA. 52+20 RT.

Scale: Horiz. 1"=40'
Vert. 1"=10'

NOTES

- Existing ground and finish grade elevations shown were interpolated from as-built plans. The actual inverts of the 24-inch reinforced concrete pipe shall be located a minimum of 4'-3" below finish grade.
- The Contractor shall verify the inverts of all proposed drainage structures shown on the profiles.

SURVEY PLOTTED BY	DATE
DRAWN BY A. Noma	5/3/97
CHECKED BY B. Tode	
NOTES BY B. Tode	
QUANTITIES BY B. Tode	
CHECKED BY B. Tode	

6/13/97	Added Drainage Profiles.
DATE	REVISION

STATE OF HAWAII
DEPARTMENT OF TRANSPORTATION
HIGHWAYS DIVISION


DRAINAGE PROFILES

PALI HIGHWAY RESURFACING
Country Club Rd. to Tunnel Entrance,
Including Both Rds. to Lookout
Project No. 61A-01-97M


Scale: As Shown Date: May 1997

SHEET No. H11A OF 24 SHEETS

FED. ROAD DIST. NO.	STATE	FED. AID PROJ. NO.	FISCAL YEAR	SHEET NO.	TOTAL SHEETS
HAWAII	HAW.	61A-01-97M	1997	52	84

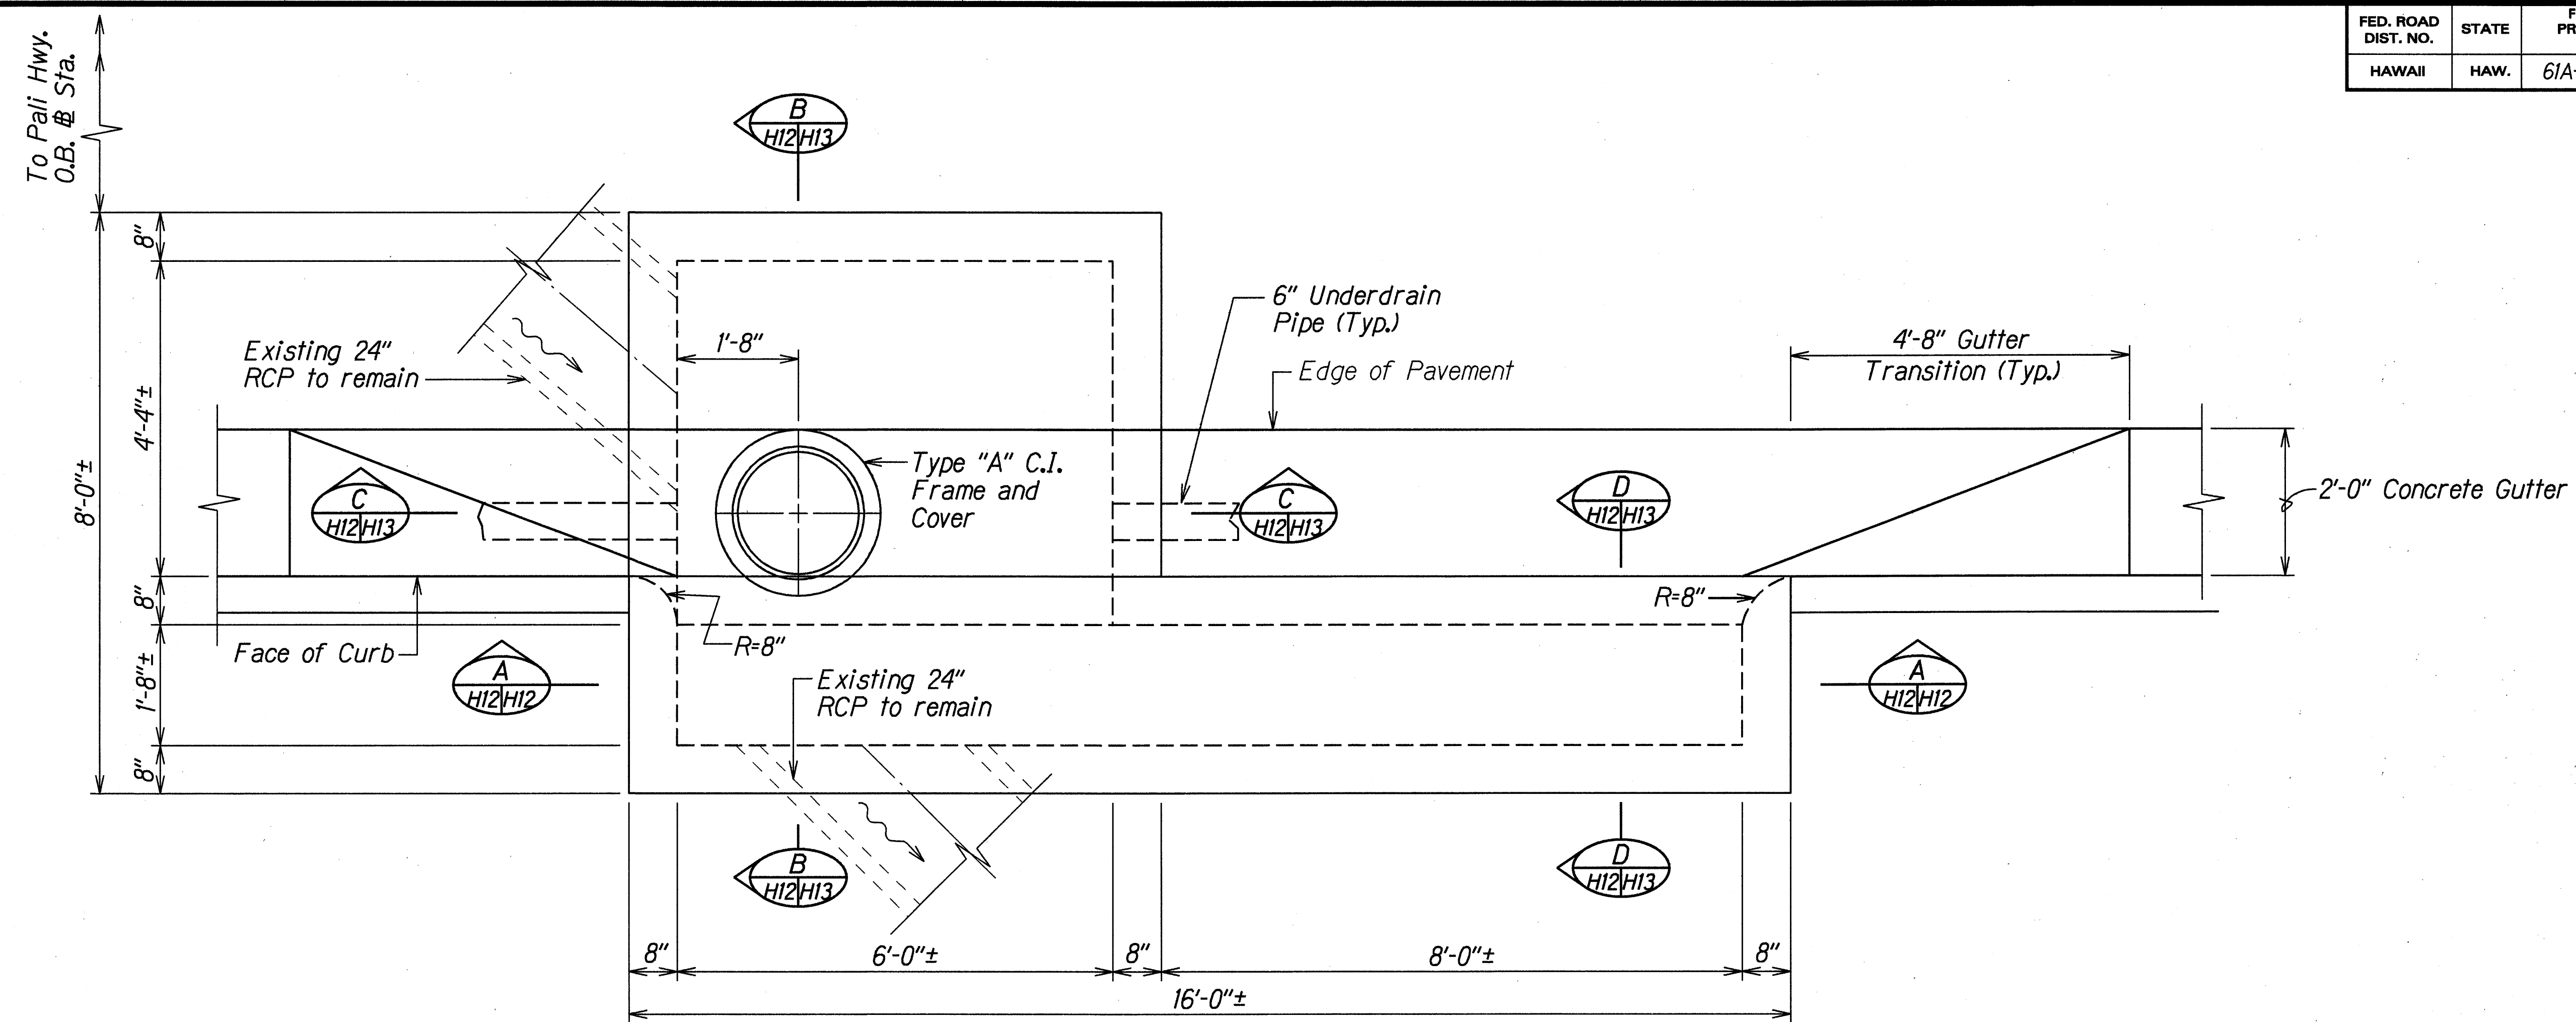

PLAN

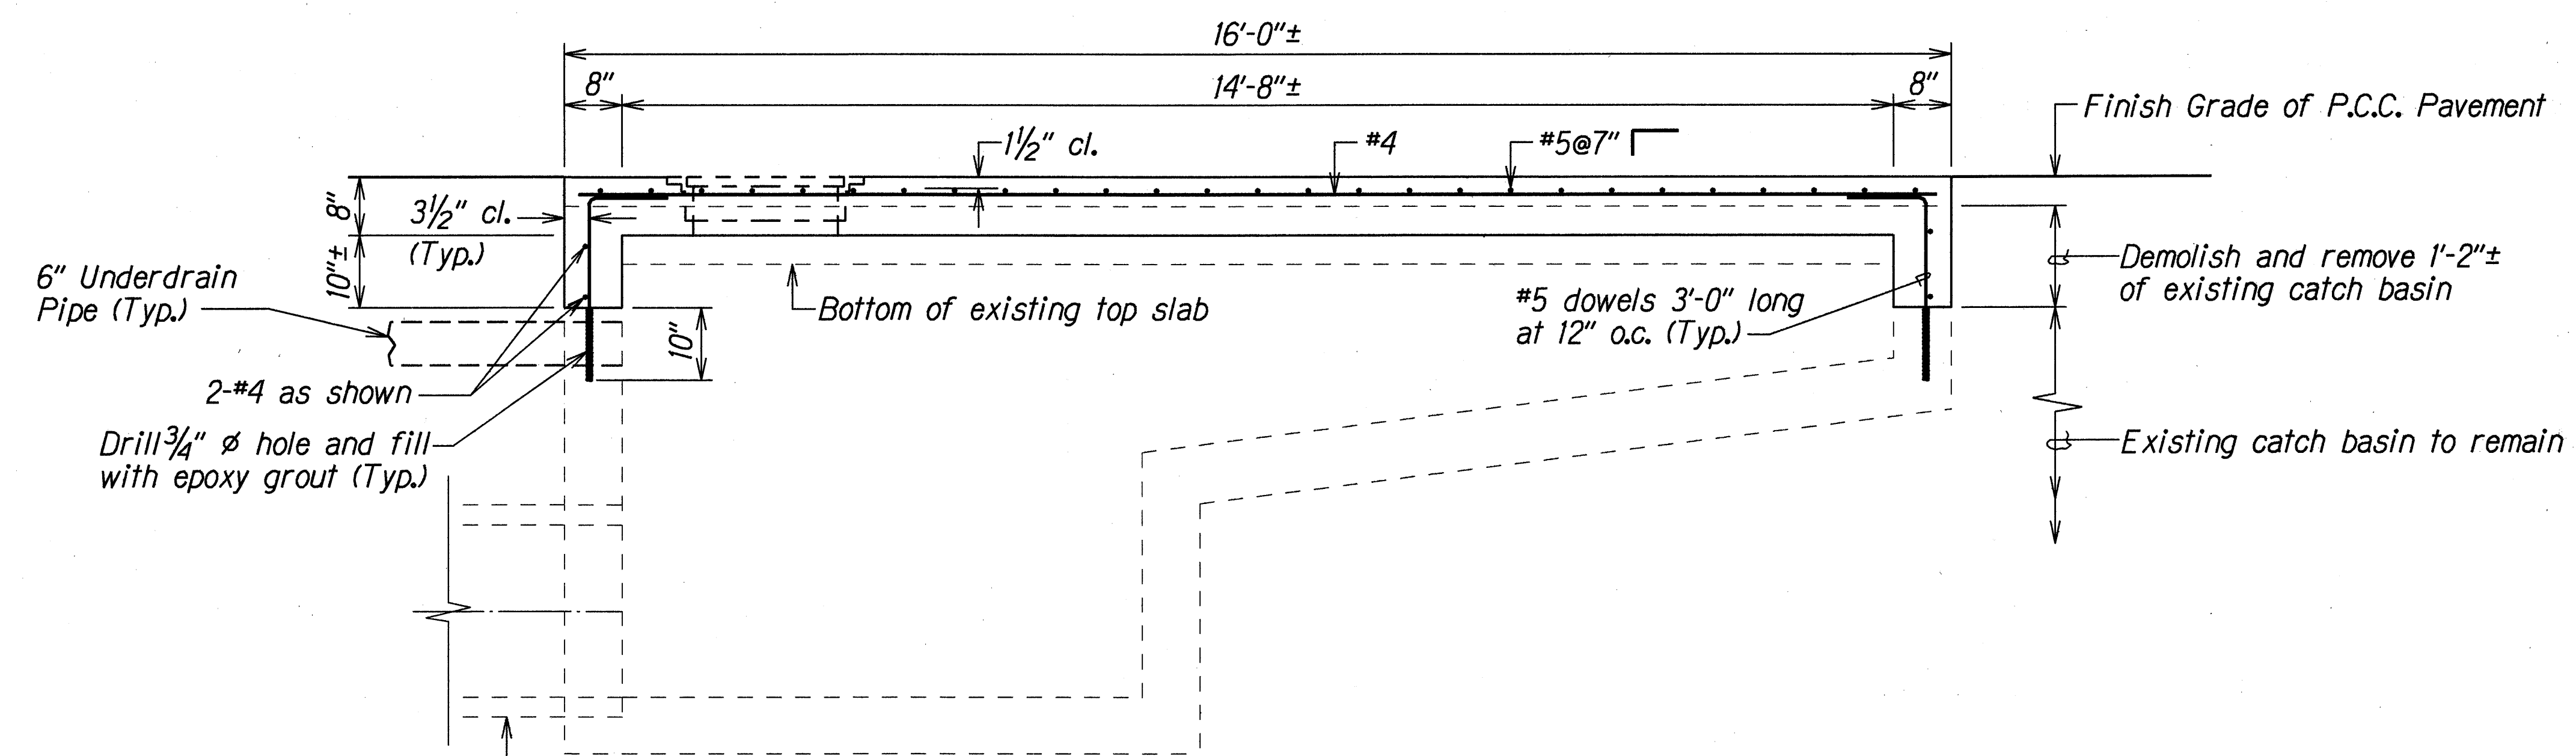

SECTION A
H12/H12

DETAILS OF MODIFIED TYPE "1" CATCH BASIN

ORIGINAL PLAN	DATE
SURVEY PLOTTED BY	
DRAWN BY	
DESIGNED BY	
CHECKED BY	

STATE OF HAWAII
DEPARTMENT OF TRANSPORTATION
HIGHWAYS DIVISION


DRAINAGE DETAILS

PALI HIGHWAY RESURFACING
Country Club Rd. to Tunnel Entrance
Including Both Rds. to Lookouts
Project. No. 61A-01-97M


Scale: 3/4"=1'-0" Date: May, 1997

SHEET No. H12 OF 24 SHEETS


FED. ROAD DIST. NO.	STATE	FED. AID PROJ. NO.	FISCAL YEAR	SHEET NO.	TOTAL SHEETS
HAWAII	HAW.	61A-01-97M	1997	53	84

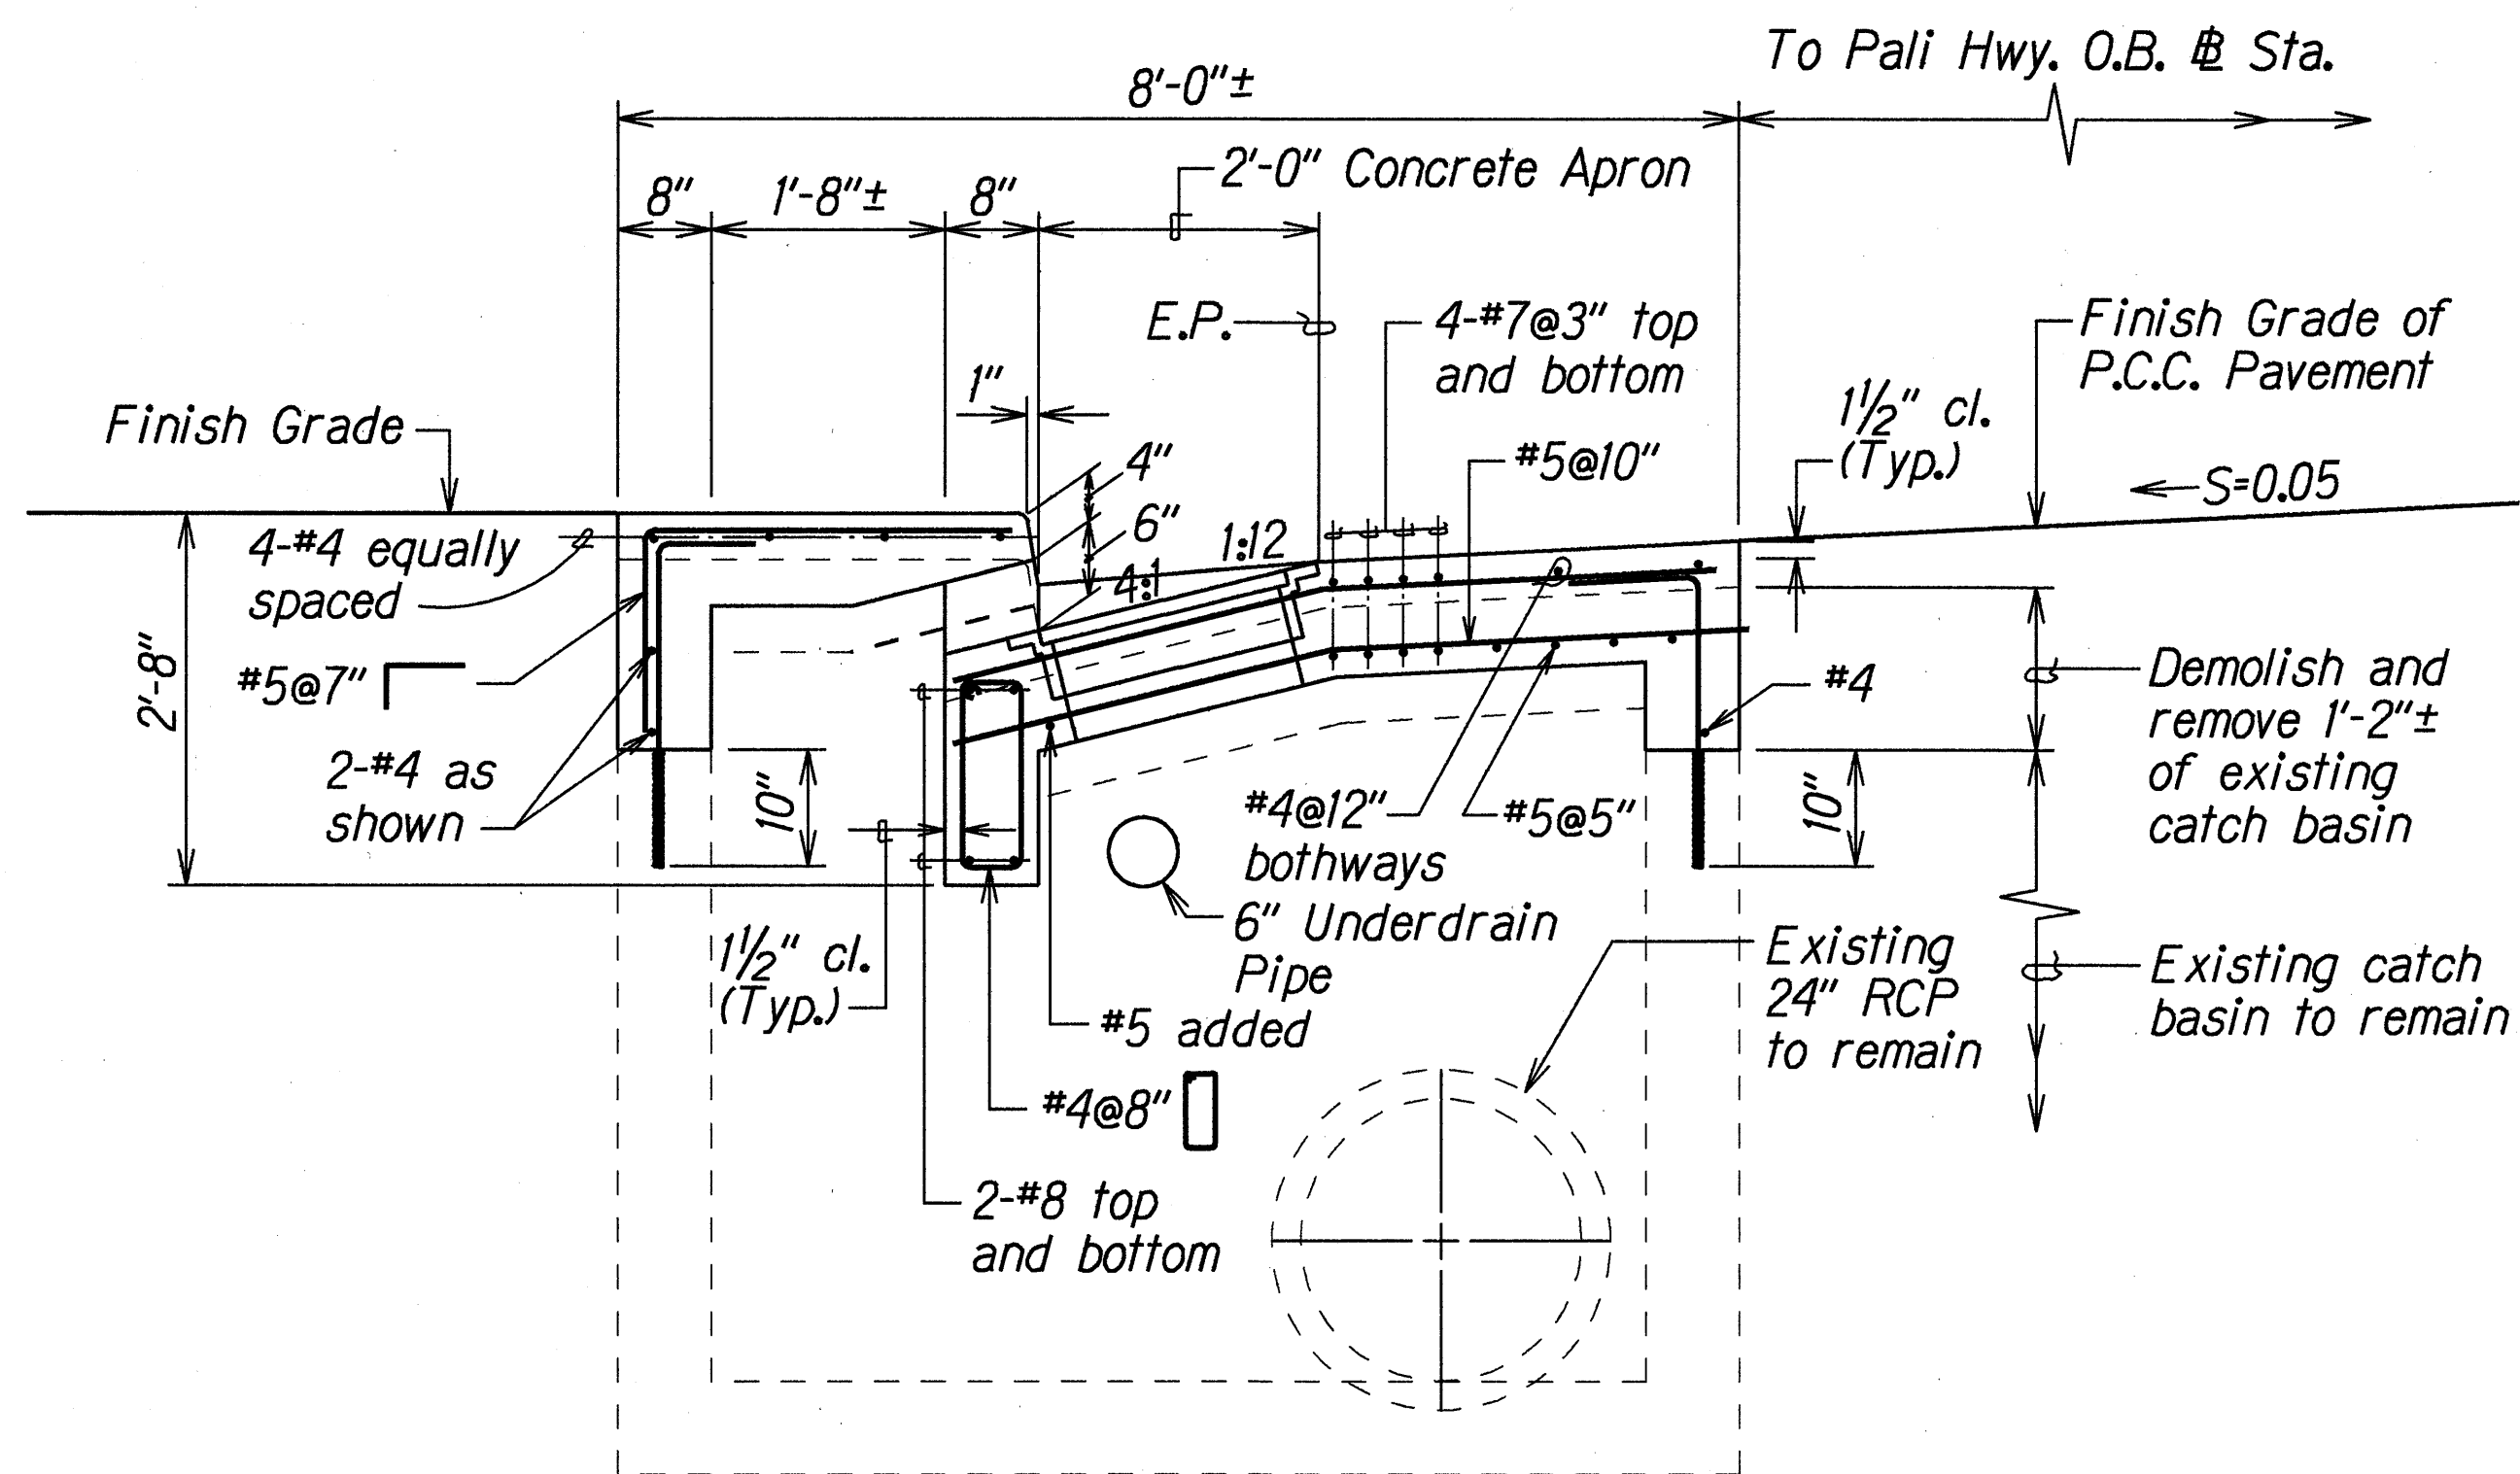

SECTION B
HI2/H13

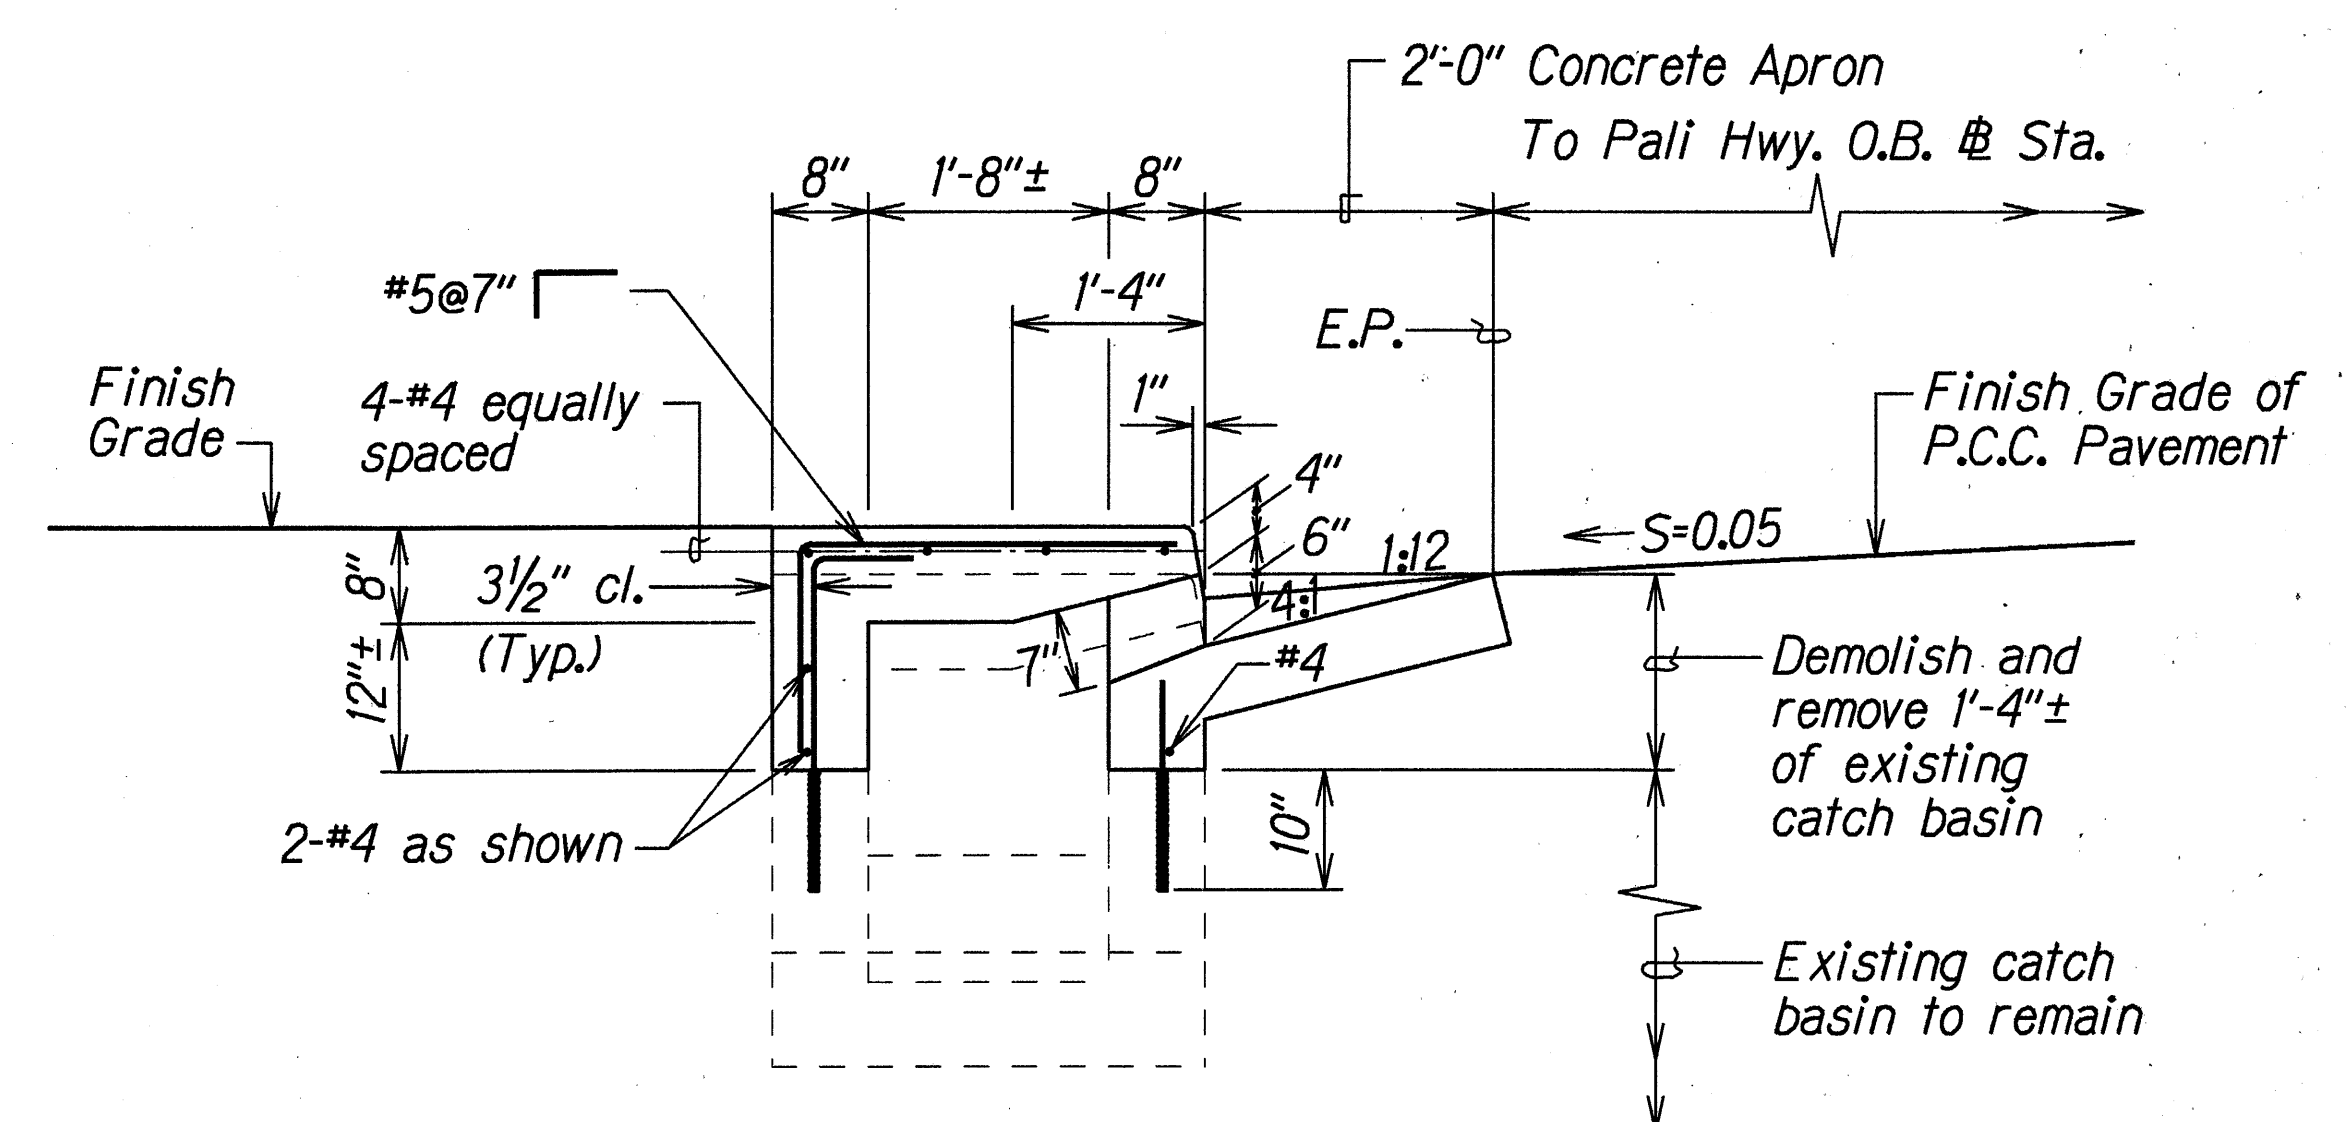

SECTION D
HI2/H13

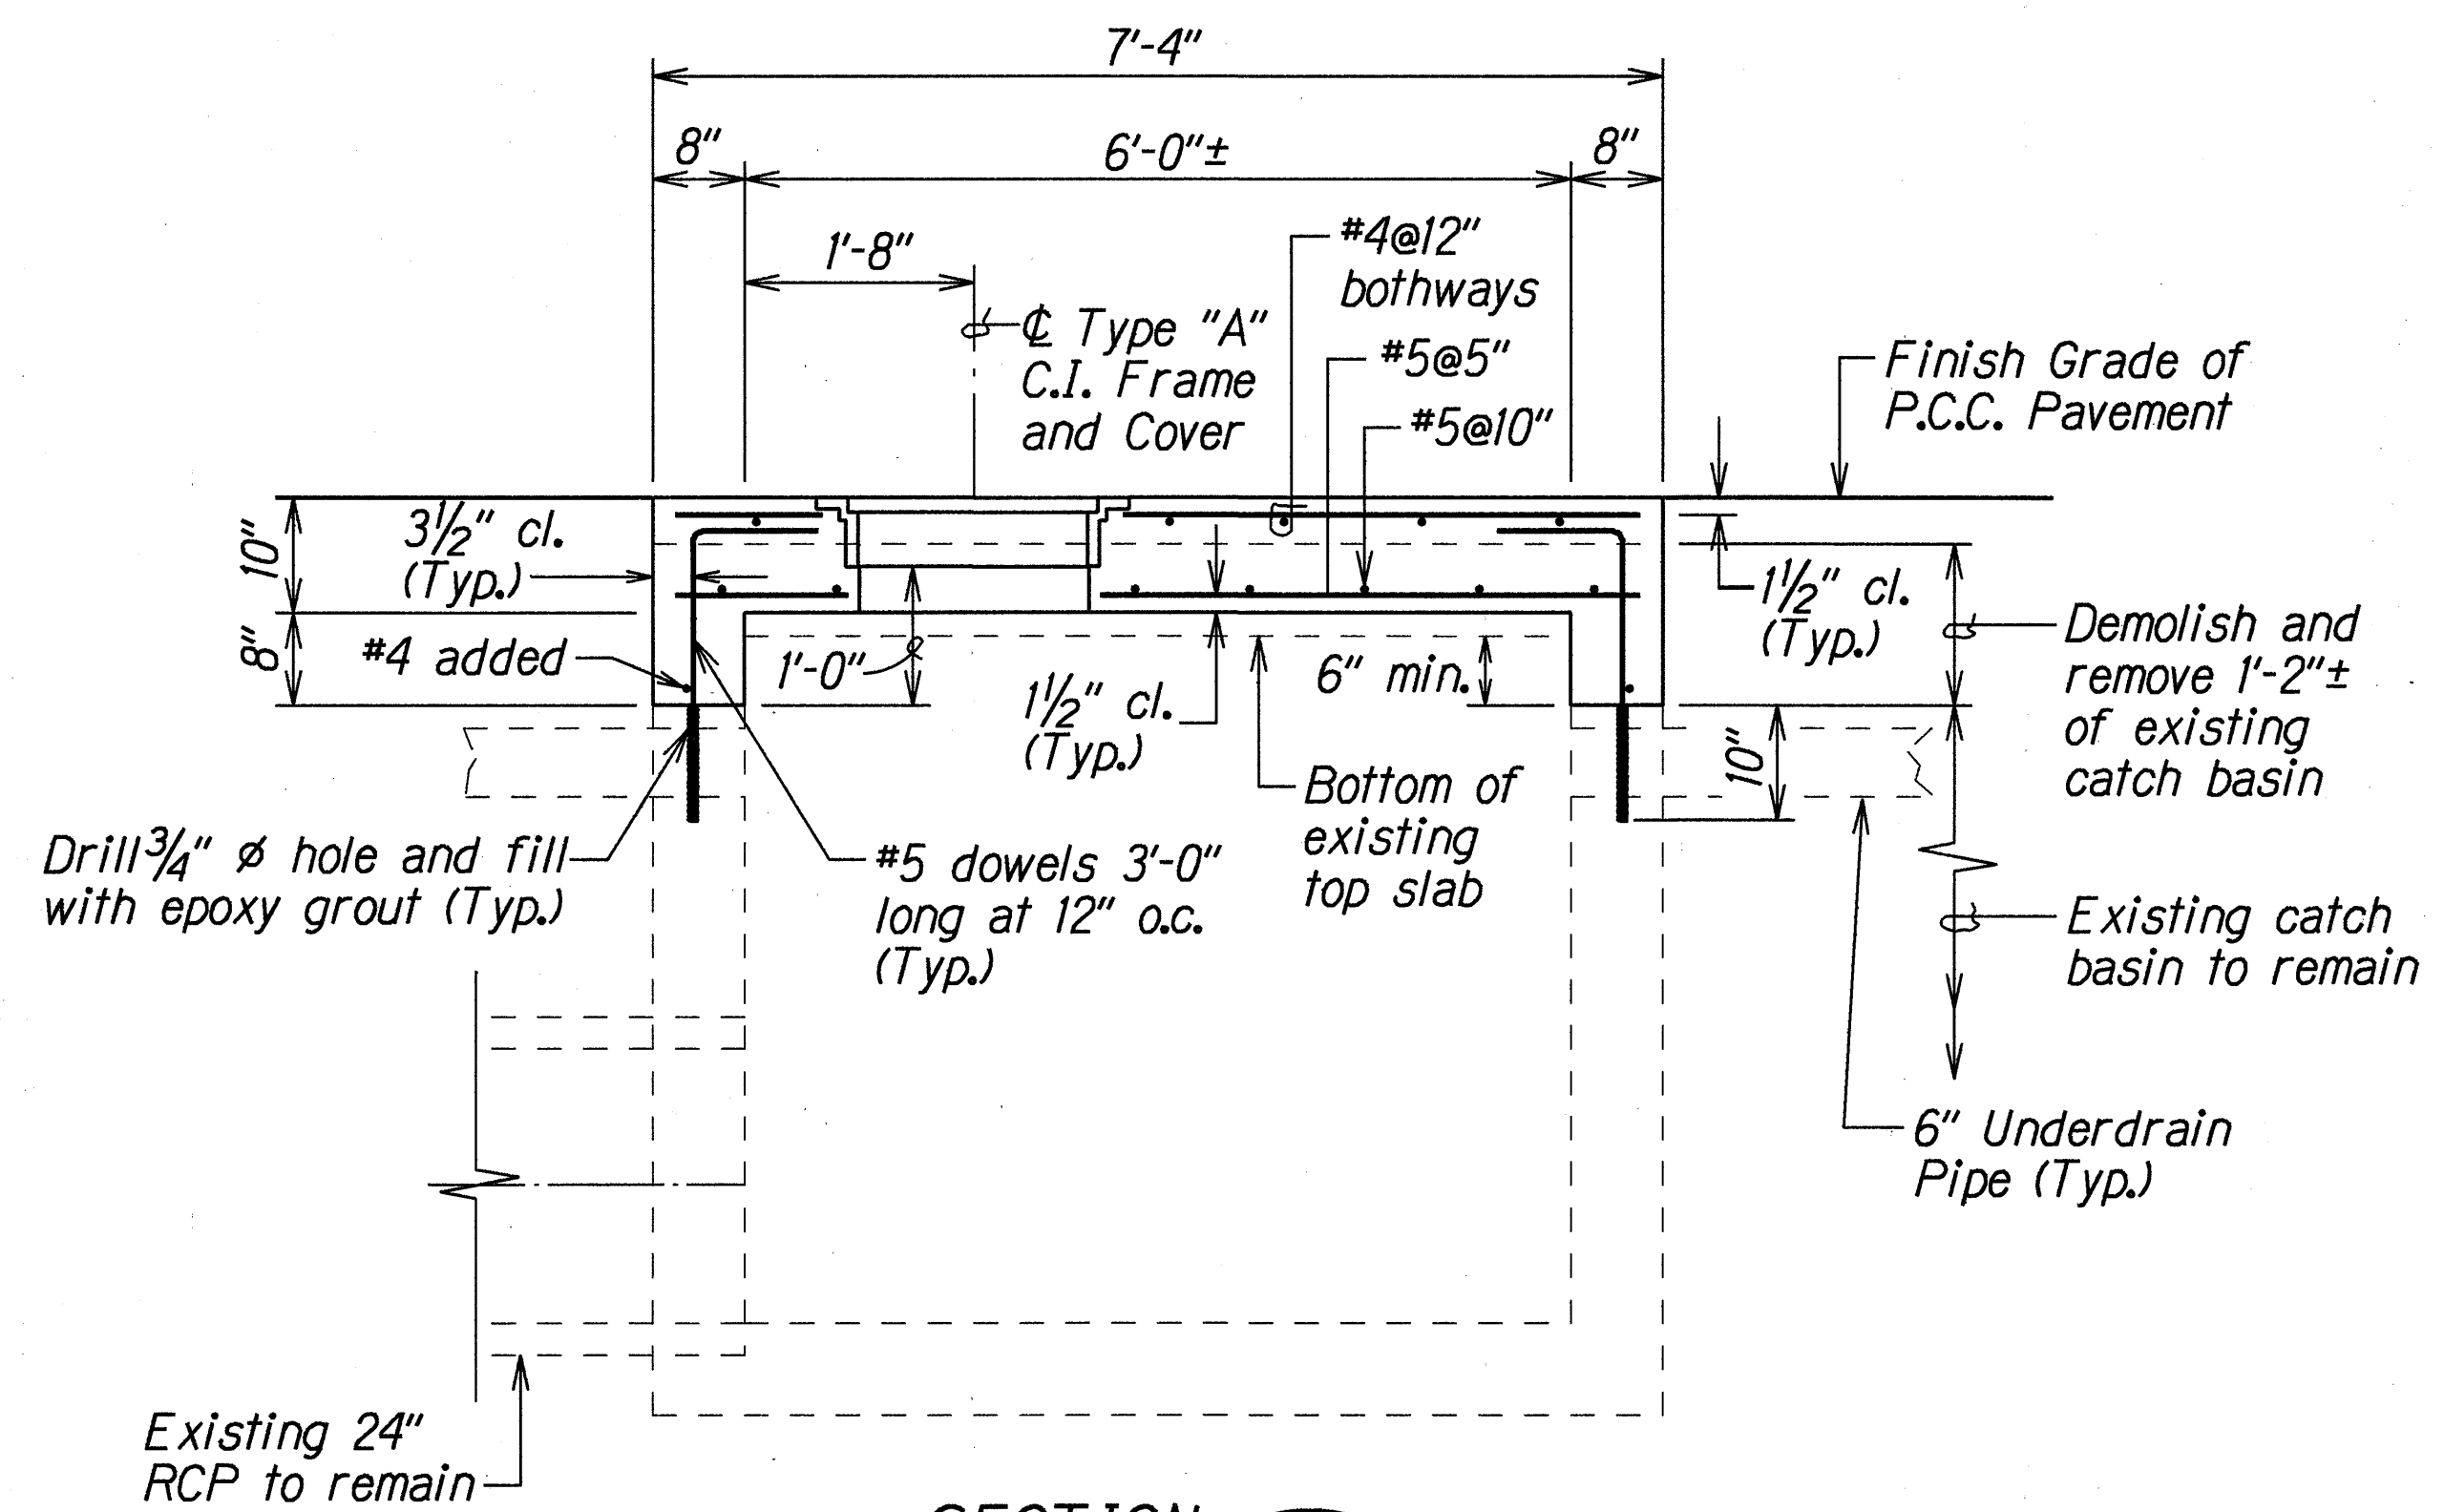

SECTION C
HI2/H13

DETAILS OF MODIFIED TYPE "1" CATCH BASIN

ORIGINAL PLAN	DATE
SURVEY PLOTTED BY	
DRAWN BY	
DESIGNED BY	
CHECKED BY	

STATE OF HAWAII
DEPARTMENT OF TRANSPORTATION
HIGHWAYS DIVISION
DRAINAGE DETAILS
PALI HIGHWAY RESURFACING
Country Club Rd. to Tunnel Entrance
Including Both Rds. to Lookouts
Project. No. 61A-01-97M
Scale: 3/4"=1'-0" Date: May, 1997
SHEET No. H13 OF 24 SHEETS

FED. ROAD DIST. NO.	STATE	FED. AID PROJ. NO.	FISCAL YEAR	SHEET NO.	TOTAL SHEETS
HAWAII	HAW.	61A-01-97M	1997	54	84

PLAN

Overall width: 19'-6"±

Concrete Gutter Transition: 4'-8" (each side)

6" Underdrain Pipe (Typ.)

Type "A" C.I. Frame and Cover

6" Conc. Gutter

Exist. 24" RCP to remain (Typ.)

Labels: A, B, C, D (H14/H14)

SECTION A

Width: 19'-6"±

Depth: 18'-2"±

Reinforcement: #5@7", #4

Finish Grade of PCC Pav't.

Demolish and remove 1'-2"± of existing catch basin

Exist. catch basin to remain

Exist. 24" RCP to remain (Typ.)

Drill 3/4"Ø hole and fill with epoxy grout (Typ.)

#5 Dowels 3'-0" long @ 12" o.c. (Typ.)

2-#4 as shown

SECTION B

Width: 8'-0"±

Depth: 8'-3"±

Reinforcement: #4@12" bothways, #5@10"

6" Underdrain Pipe (Typ.)

Exist. 24" RCP to remain (Typ.)

Demolish and remove 1'-2"± of existing catch basin

Exist. catch basin to remain

SECTION C

Width: 8'-3"±

Depth: 8'-3"±

Reinforcement: #5@7", 3-#4 equally spaced, 2-#4 as shown, 2-#8 top & bottom, #4@8"

6" Underdrain Pipe

Exist. catch basin to remain

SECTION D

Width: 2'-3"±

Depth: 2'-0"±

Reinforcement: #5@7", 3-#4 equally spaced, 2-#4 as shown, #4

6" Conc. Gutter

Exist. catch basin to remain

DETAILS OF MODIFIED TYPE "2" CATCH BASIN

STATE OF HAWAII
DEPARTMENT OF TRANSPORTATION
HIGHWAYS DIVISION

DRAINAGE DETAILS

PALI HIGHWAY RESURFACING
Country Club Rd. to Tunnel Entrance,
Including Both Rds. to Lookout
Project No. 61A-01-97M

Scale: 1/2"=1'-0" Date: May 1997

SHEET No. H14 OF 24 SHEETS

STATE OF HAWAII
DEPARTMENT OF TRANSPORTATION
HIGHWAYS DIVISION


DRAINAGE DETAILS

PALI HIGHWAY RESURFACING
Country Club Rd. to Tunnel Entrance,
Including Both Rds. to Lookout
Project No. 61A-01-97M

Scale: 1/2"=1'-0" Date: May 1997

SHEET No. **H14** OF **24** SHEETS

FED. ROAD DIST. NO.	STATE	FED. AID PROJ. NO.	FISCAL YEAR	SHEET NO.	TOTAL SHEETS
HAWAII	HAW.	61A-01-97M	1997	55	84

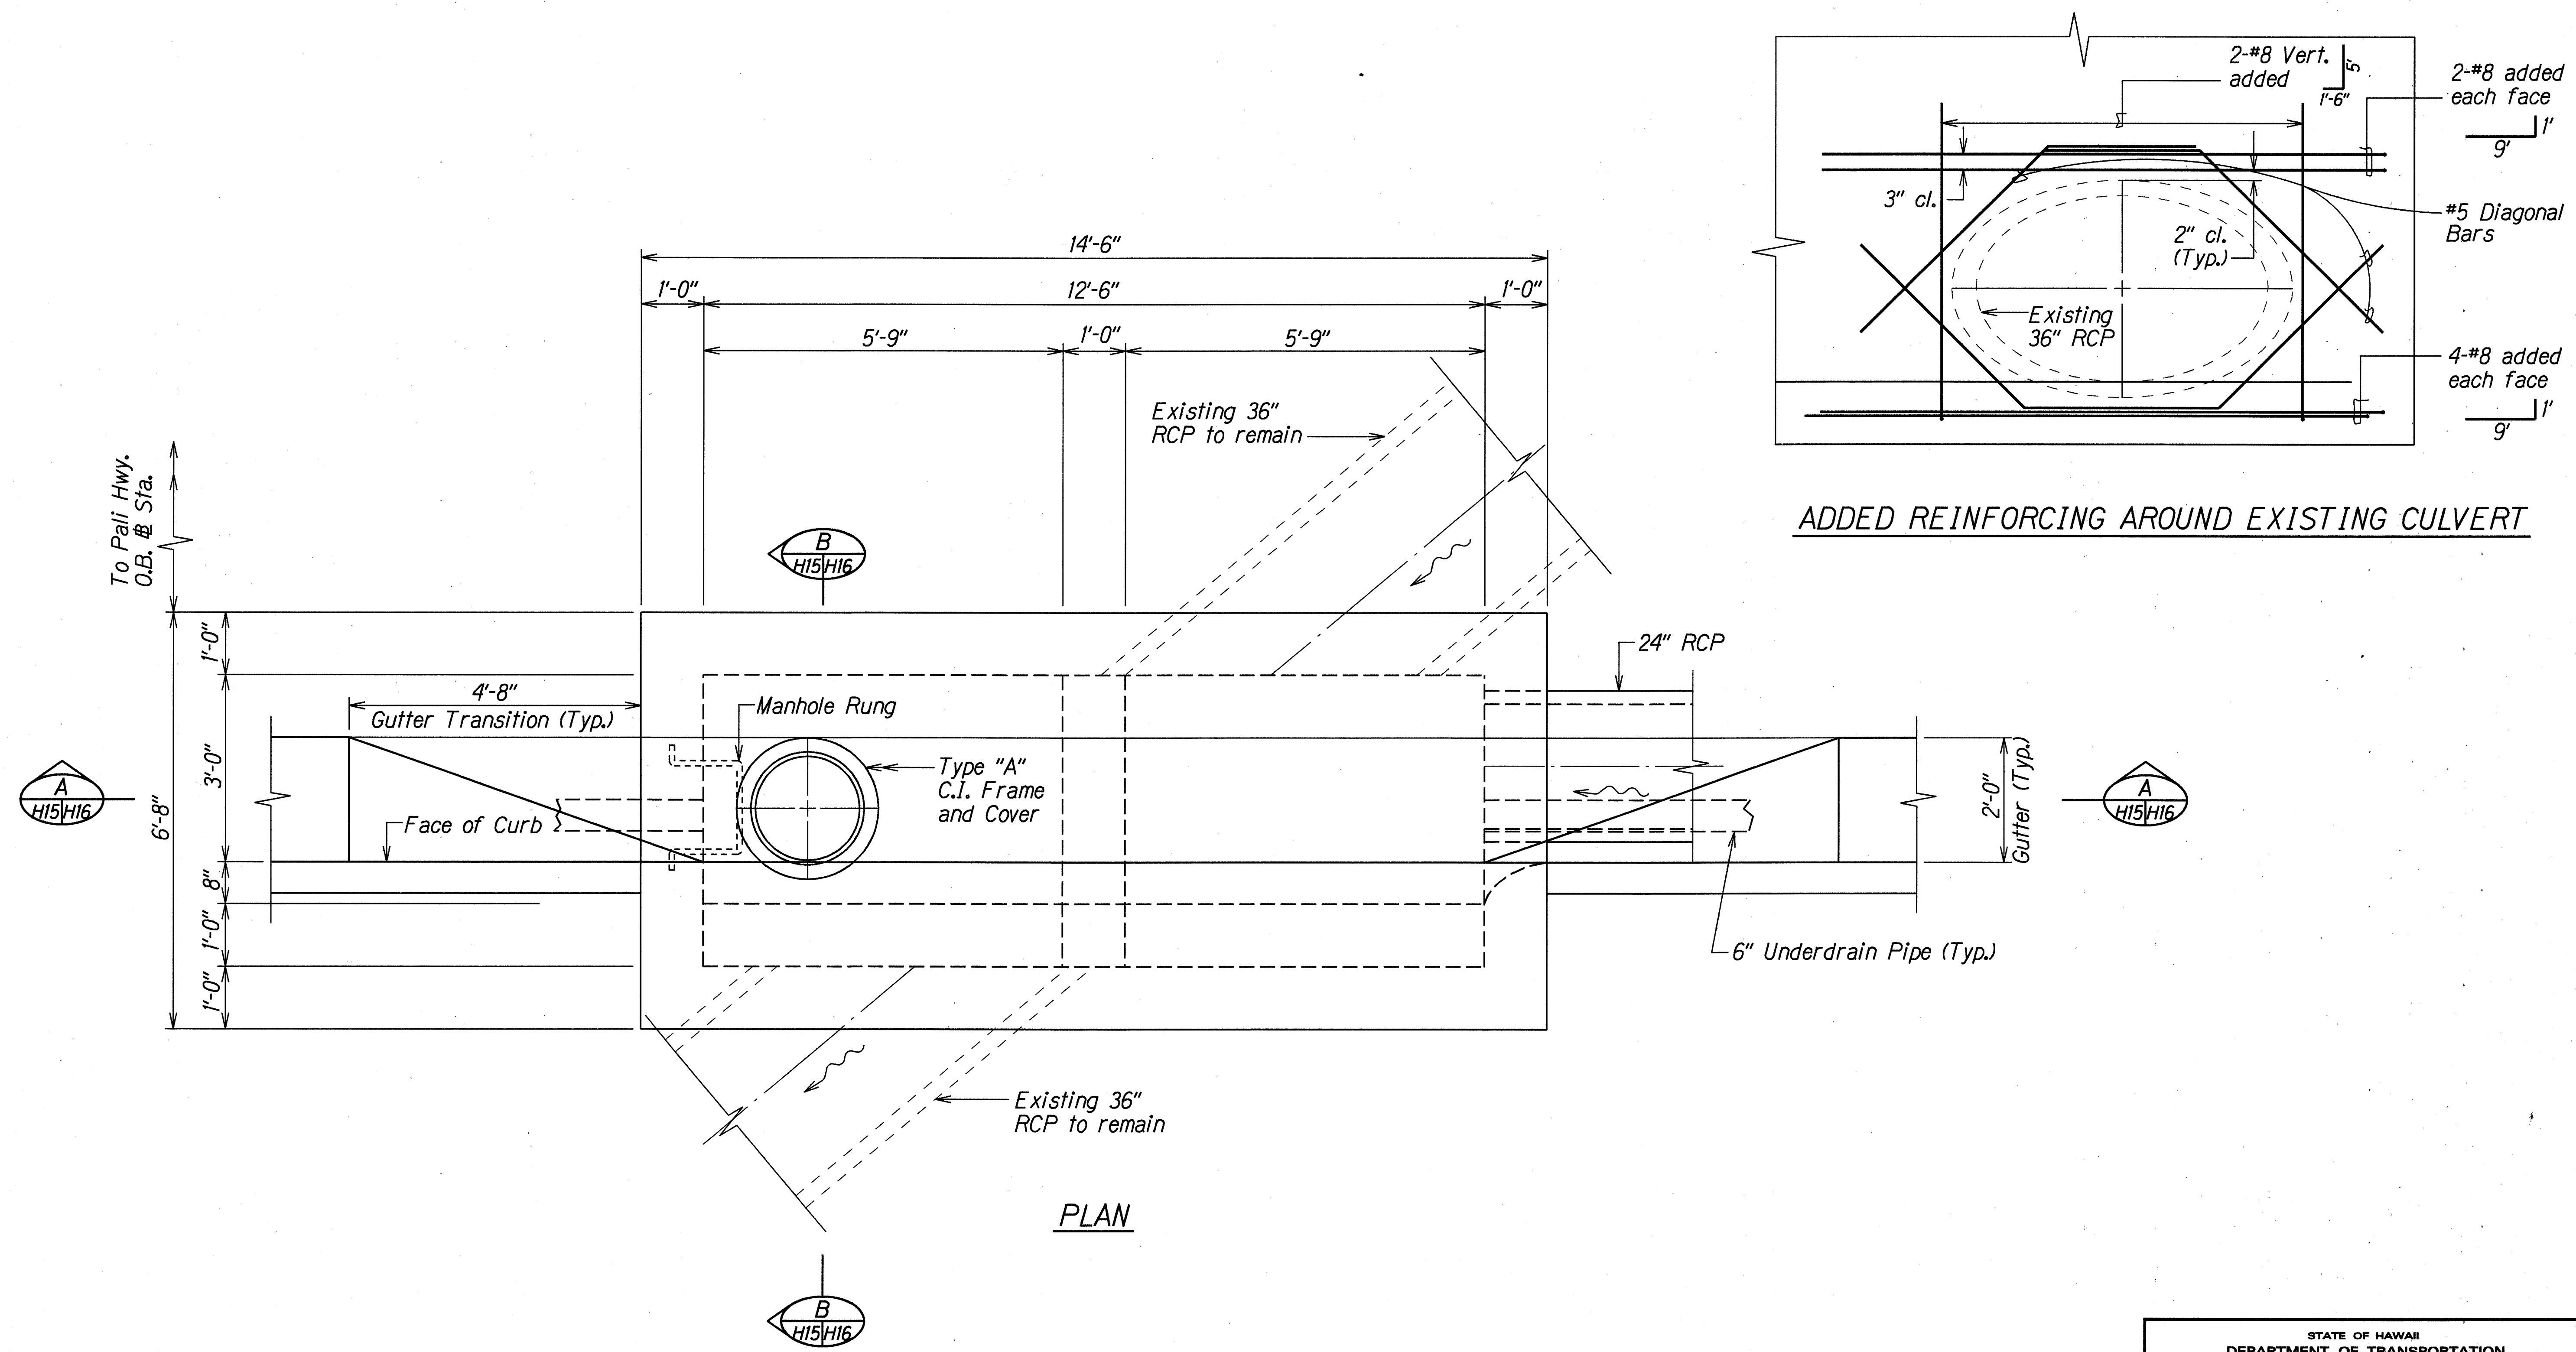

ORIGINAL PLAN	SURVEY PLOTTED BY	DATE
NOTE BOOK	DRAWN BY Curtis Matsuda & Russell Sato	May 1997
dhz/courtspl	CHECKED BY C. Matsuda	
spc/cadagn	CHECKED BY	

STATE OF HAWAII
DEPARTMENT OF TRANSPORTATION
HIGHWAYS DIVISION



DRAINAGE DETAILS

PALI HIGHWAY RESURFACING
Country Club Rd. to Tunnel Entrance,
Including Both Rds. to Lookout
Project No. 61A-01-97M

Scale: 3/4"=1'-0" Date: May 1997

SHEET No. H15 OF 24 SHEETS

FED. ROAD DIST. NO.	STATE	FED. AID PROJ. NO.	FISCAL YEAR	SHEET NO.	TOTAL SHEETS
HAWAII	HAW.	61A-01-97M	1997	56	84

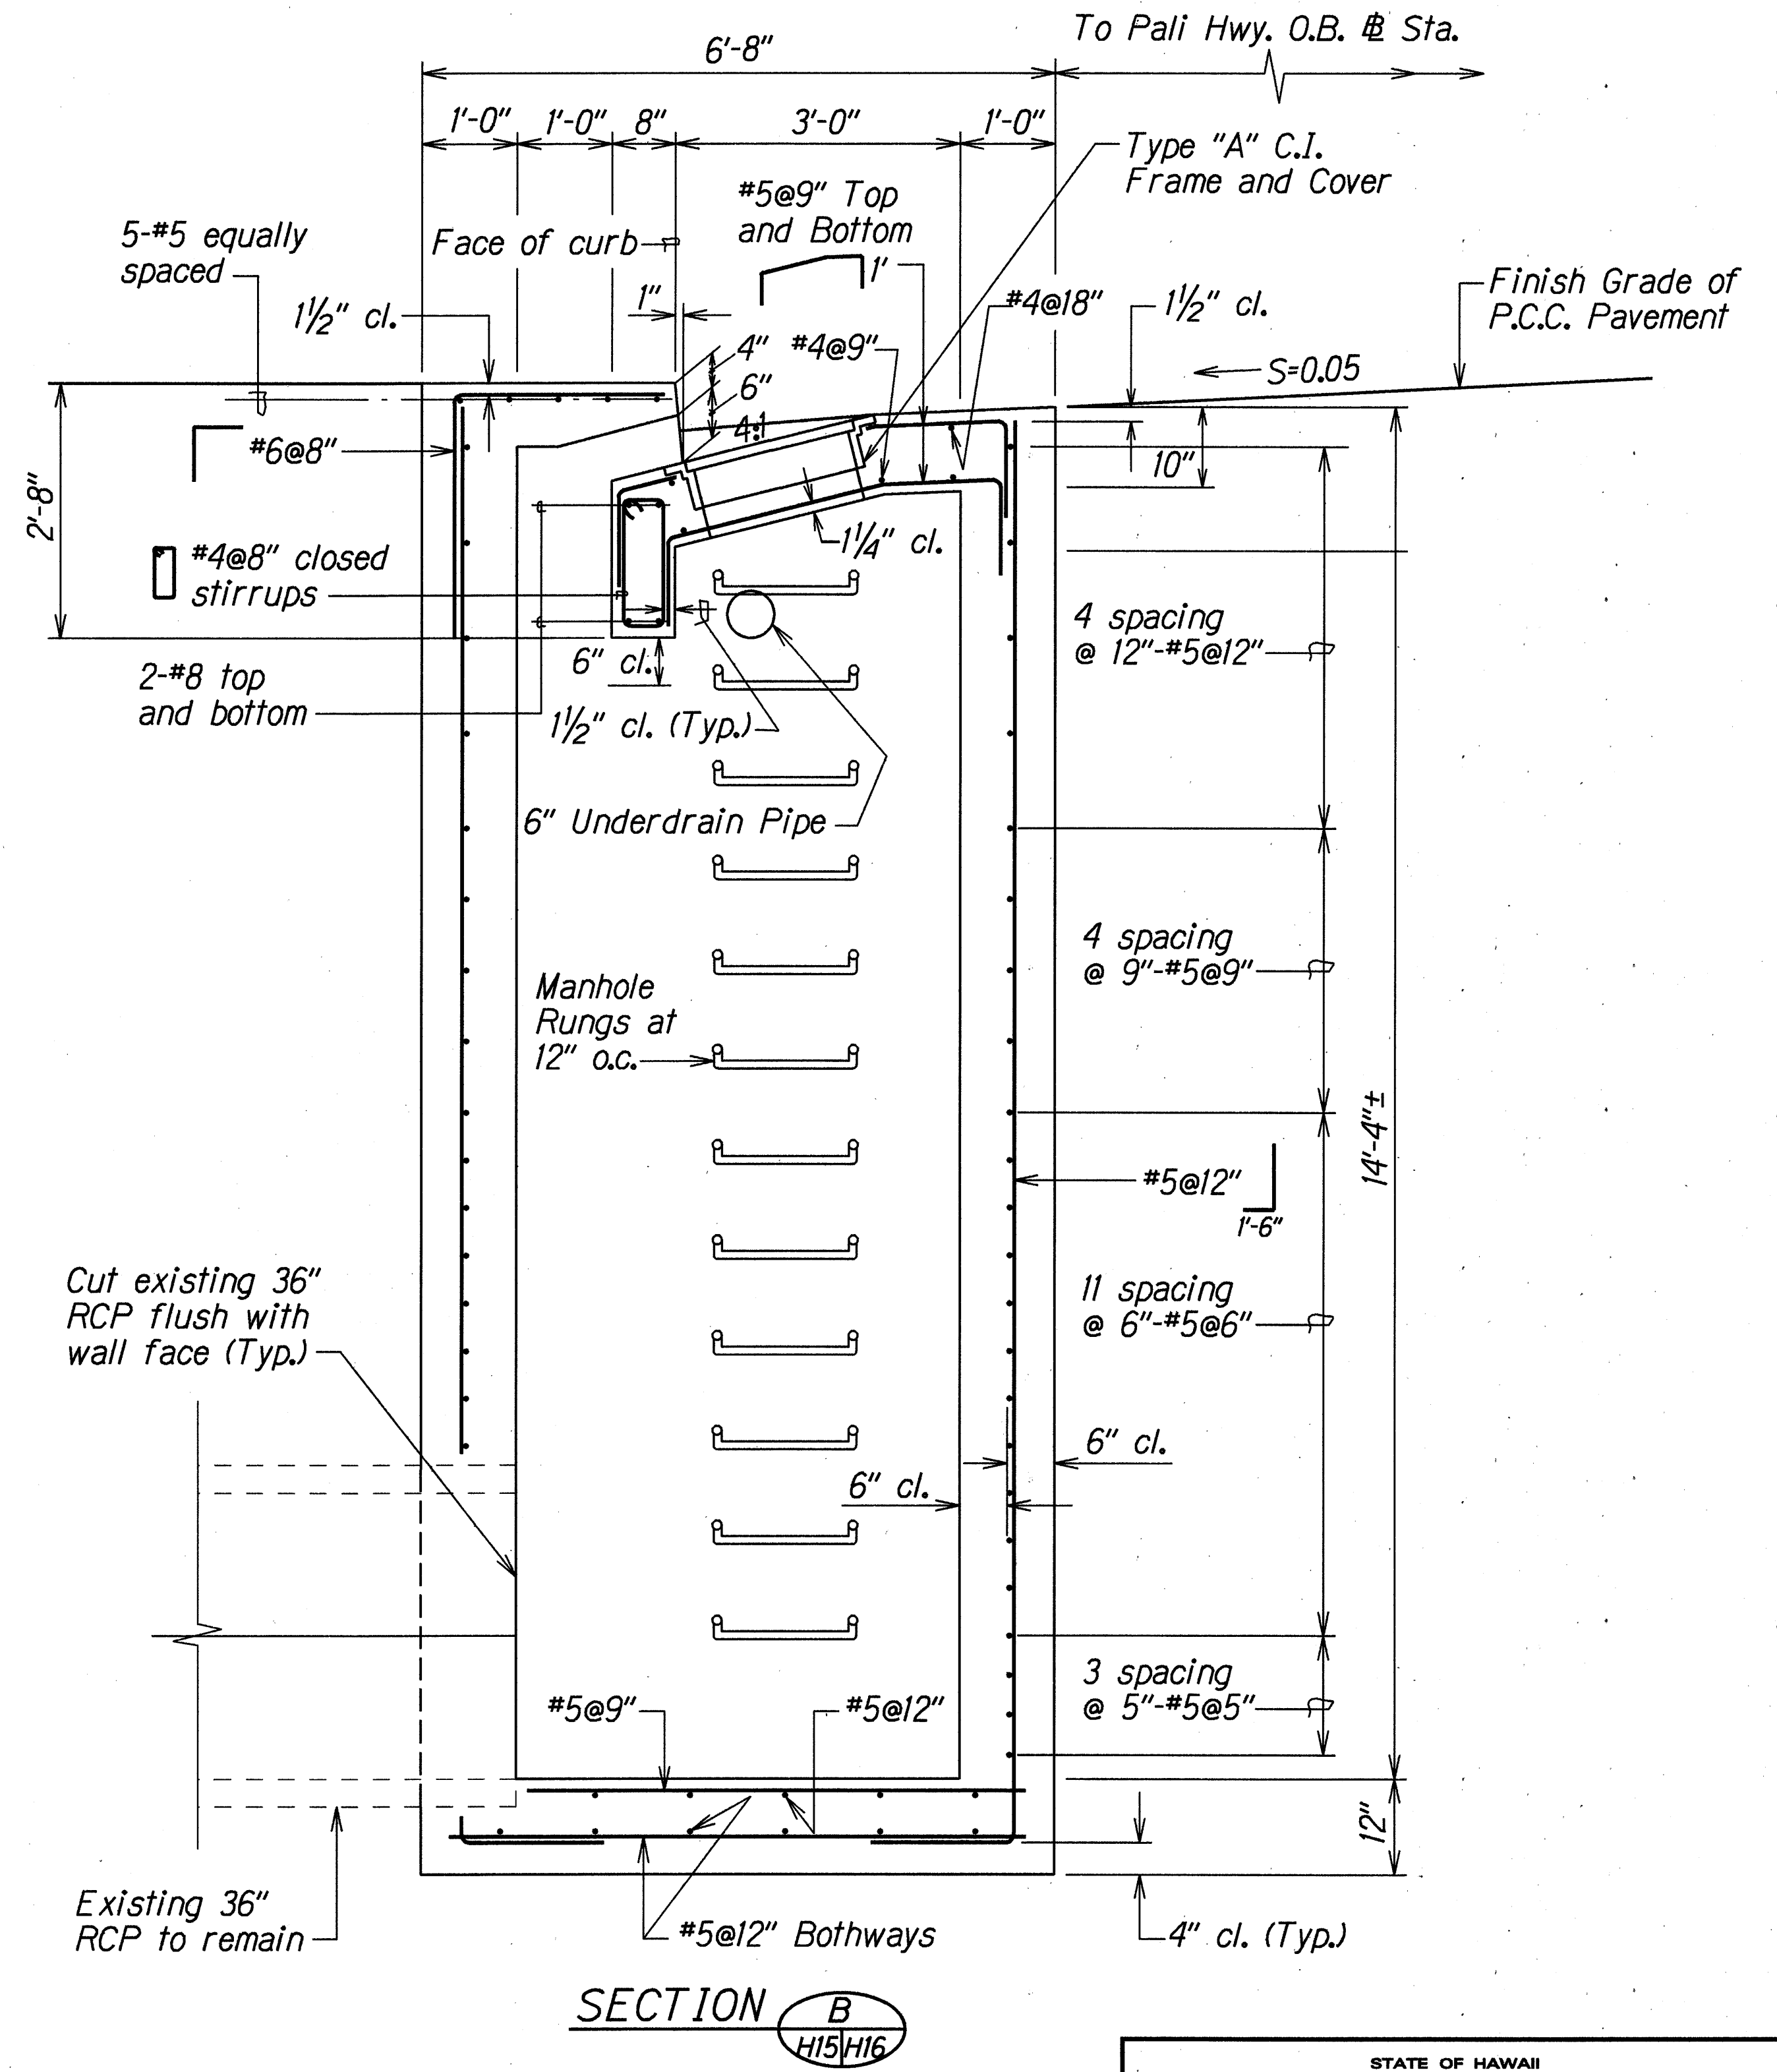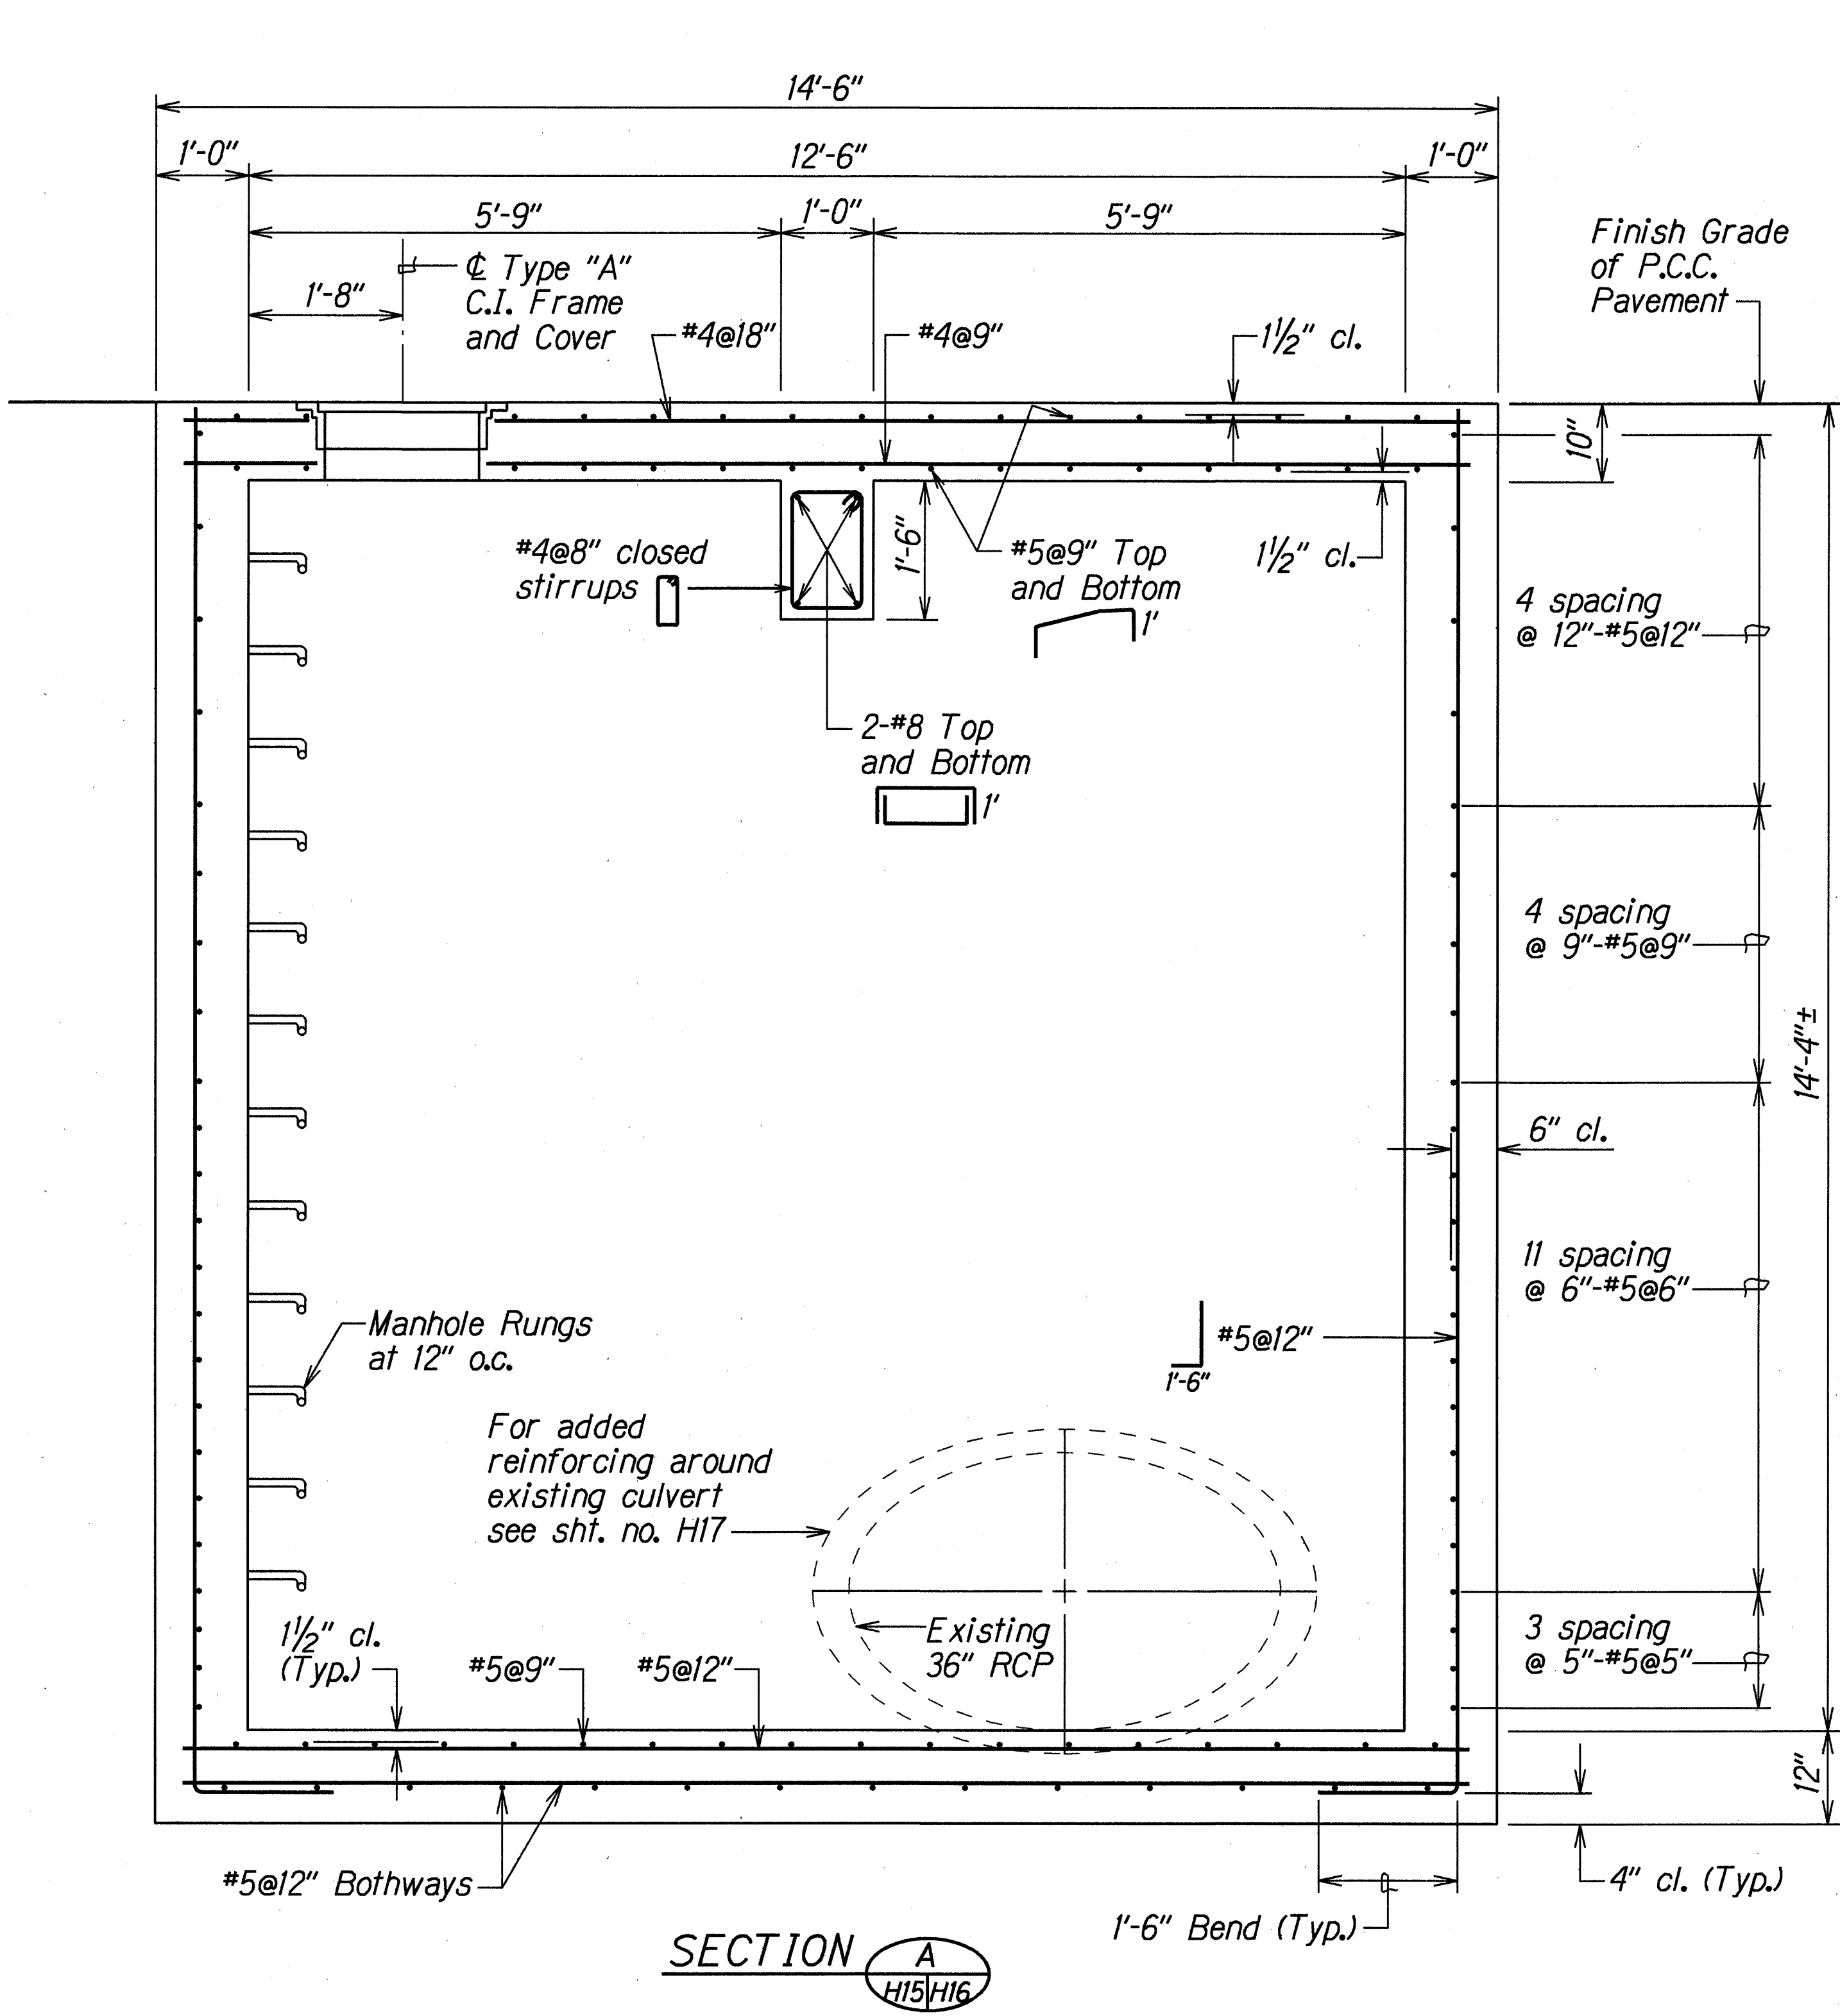

DETAILS OF MODIFIED TYPE "DI" CATCH BASIN

STATE OF HAWAII
DEPARTMENT OF TRANSPORTATION
HIGHWAYS DIVISION



DRAINAGE DETAILS

PALI HIGHWAY RESURFACING
Country Club Rd. to Tunnel Entrance,
Including Both Rds. to Lookout
Project No. 61A-01-97M

Scale: 3/4"=1'-0" Date: May 1997

SHEET No. H16 OF 24 SHEETS

FED. ROAD DIST. NO.	STATE	PROJ. NO.	FISCAL YEAR	SHEET NO.	TOTAL SHEETS
HAWAII	HAW.	61A-01-97M	1999	C.O. 56 S-1	84

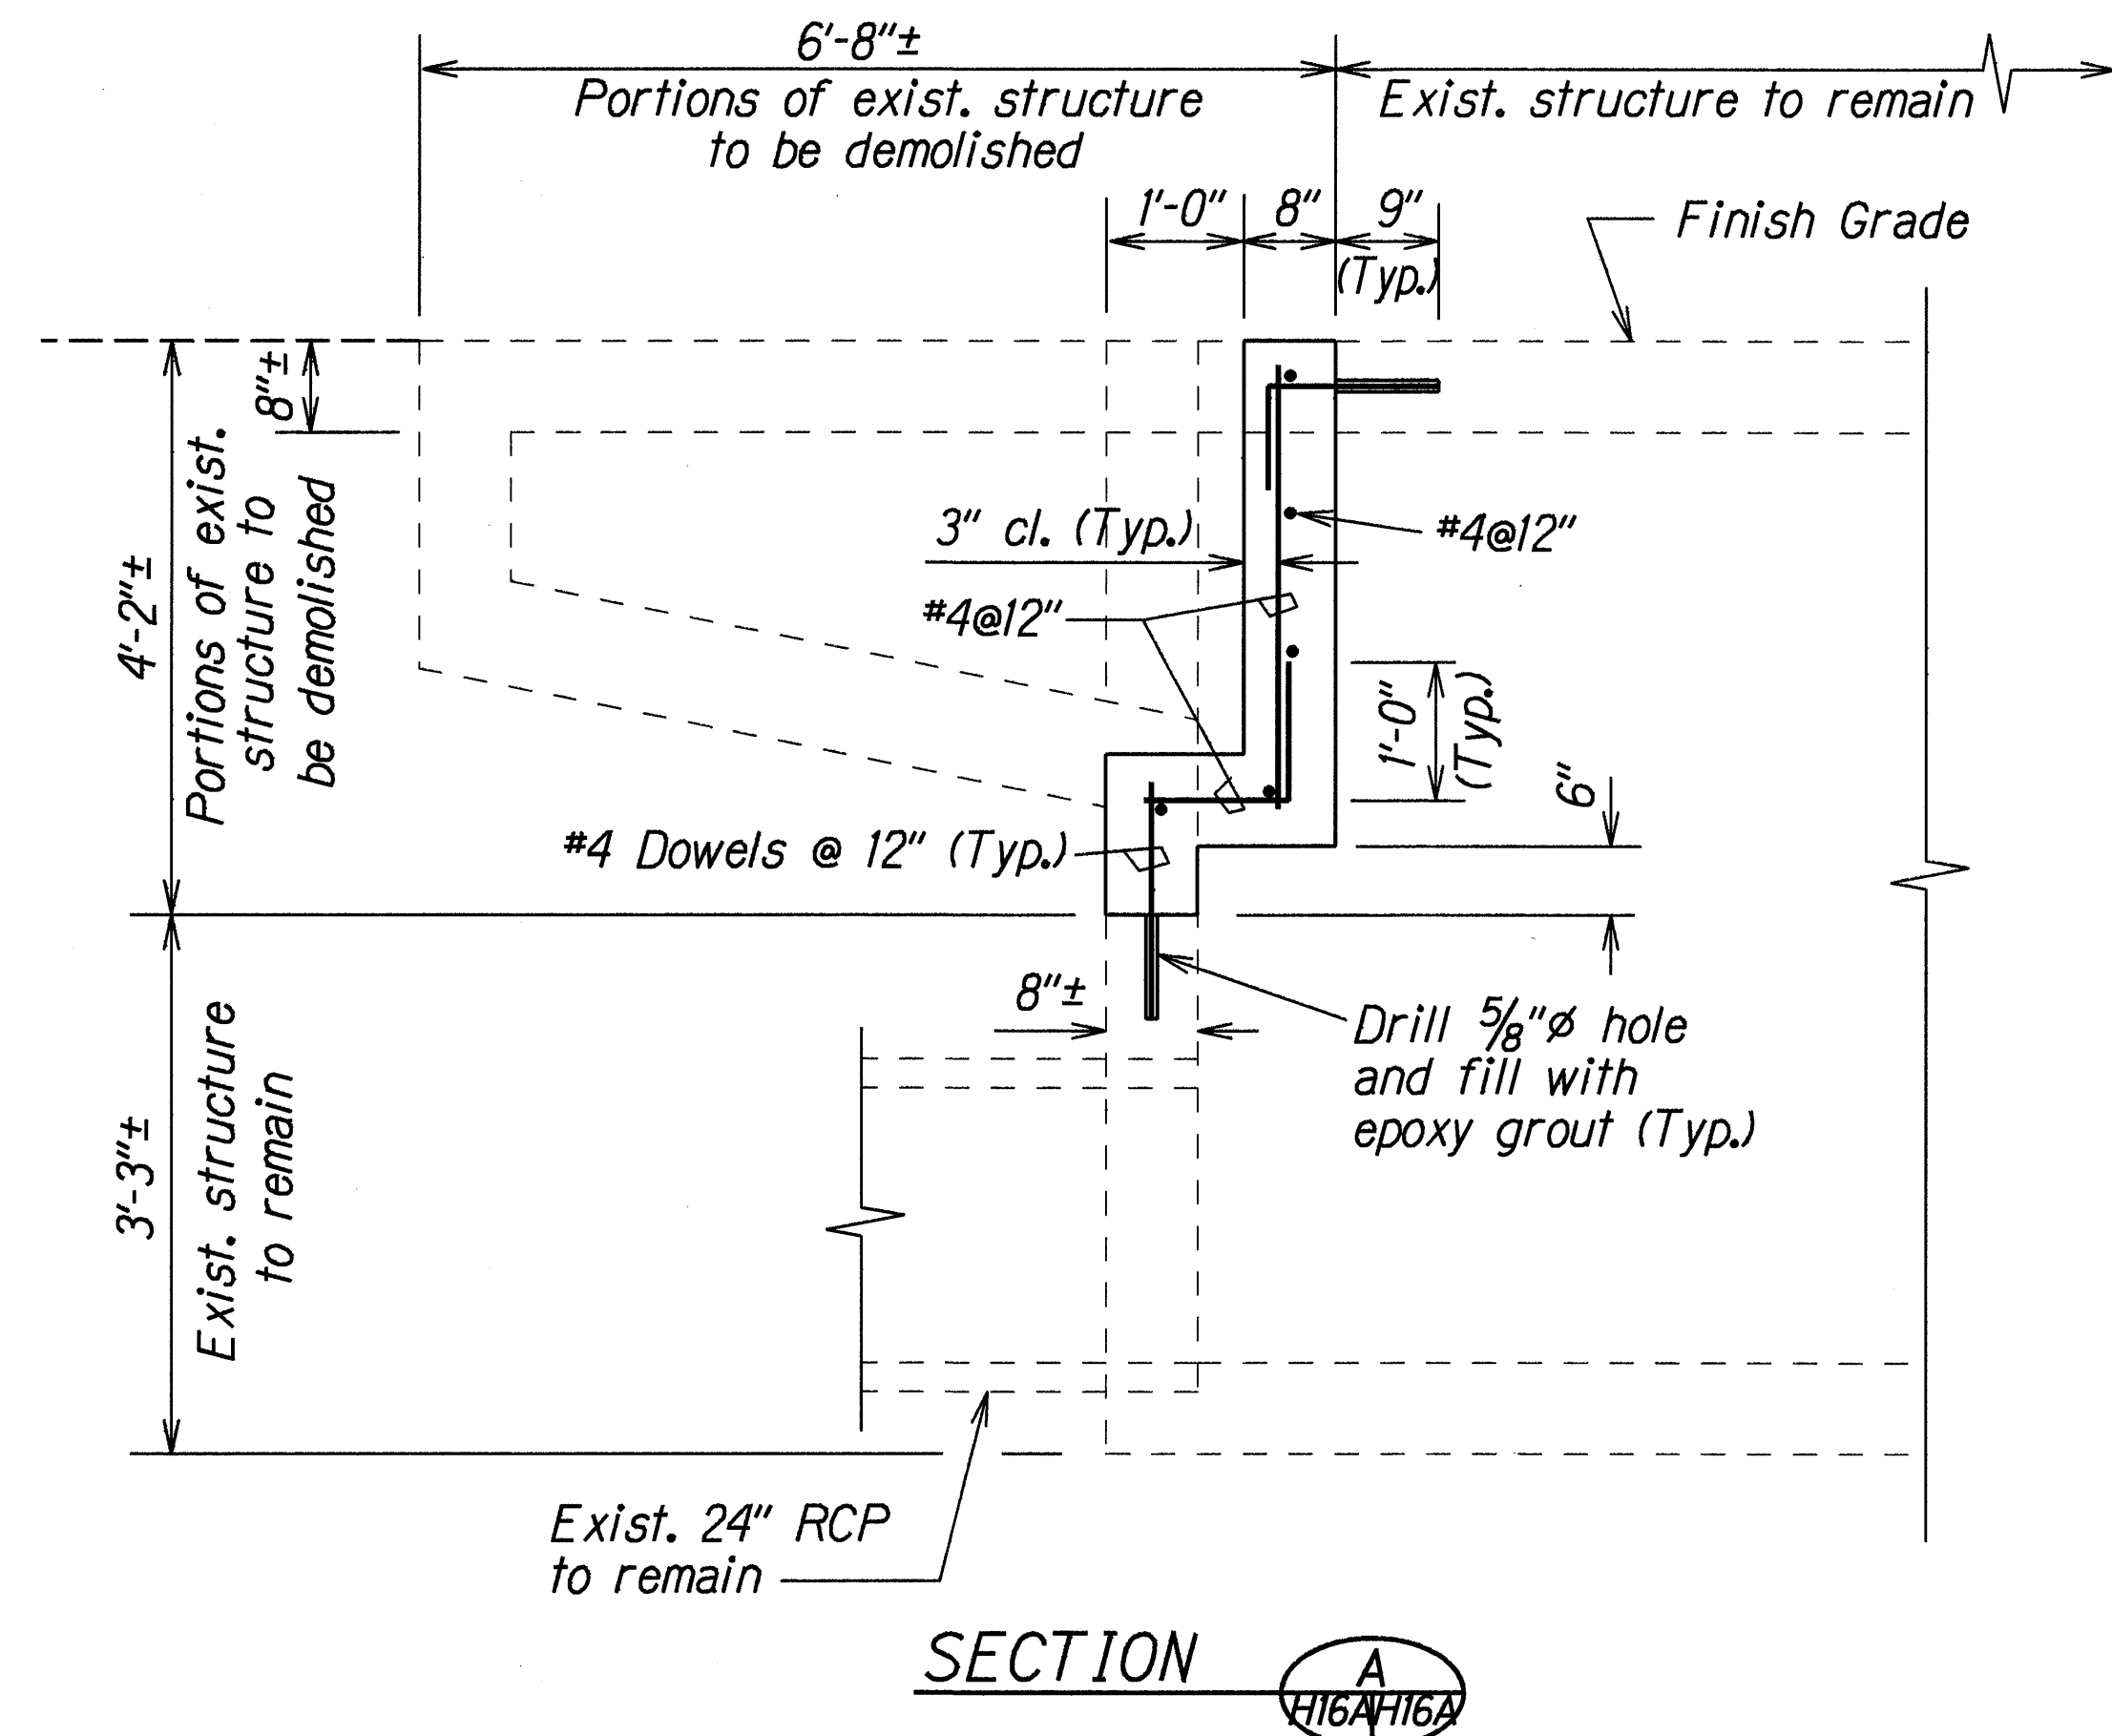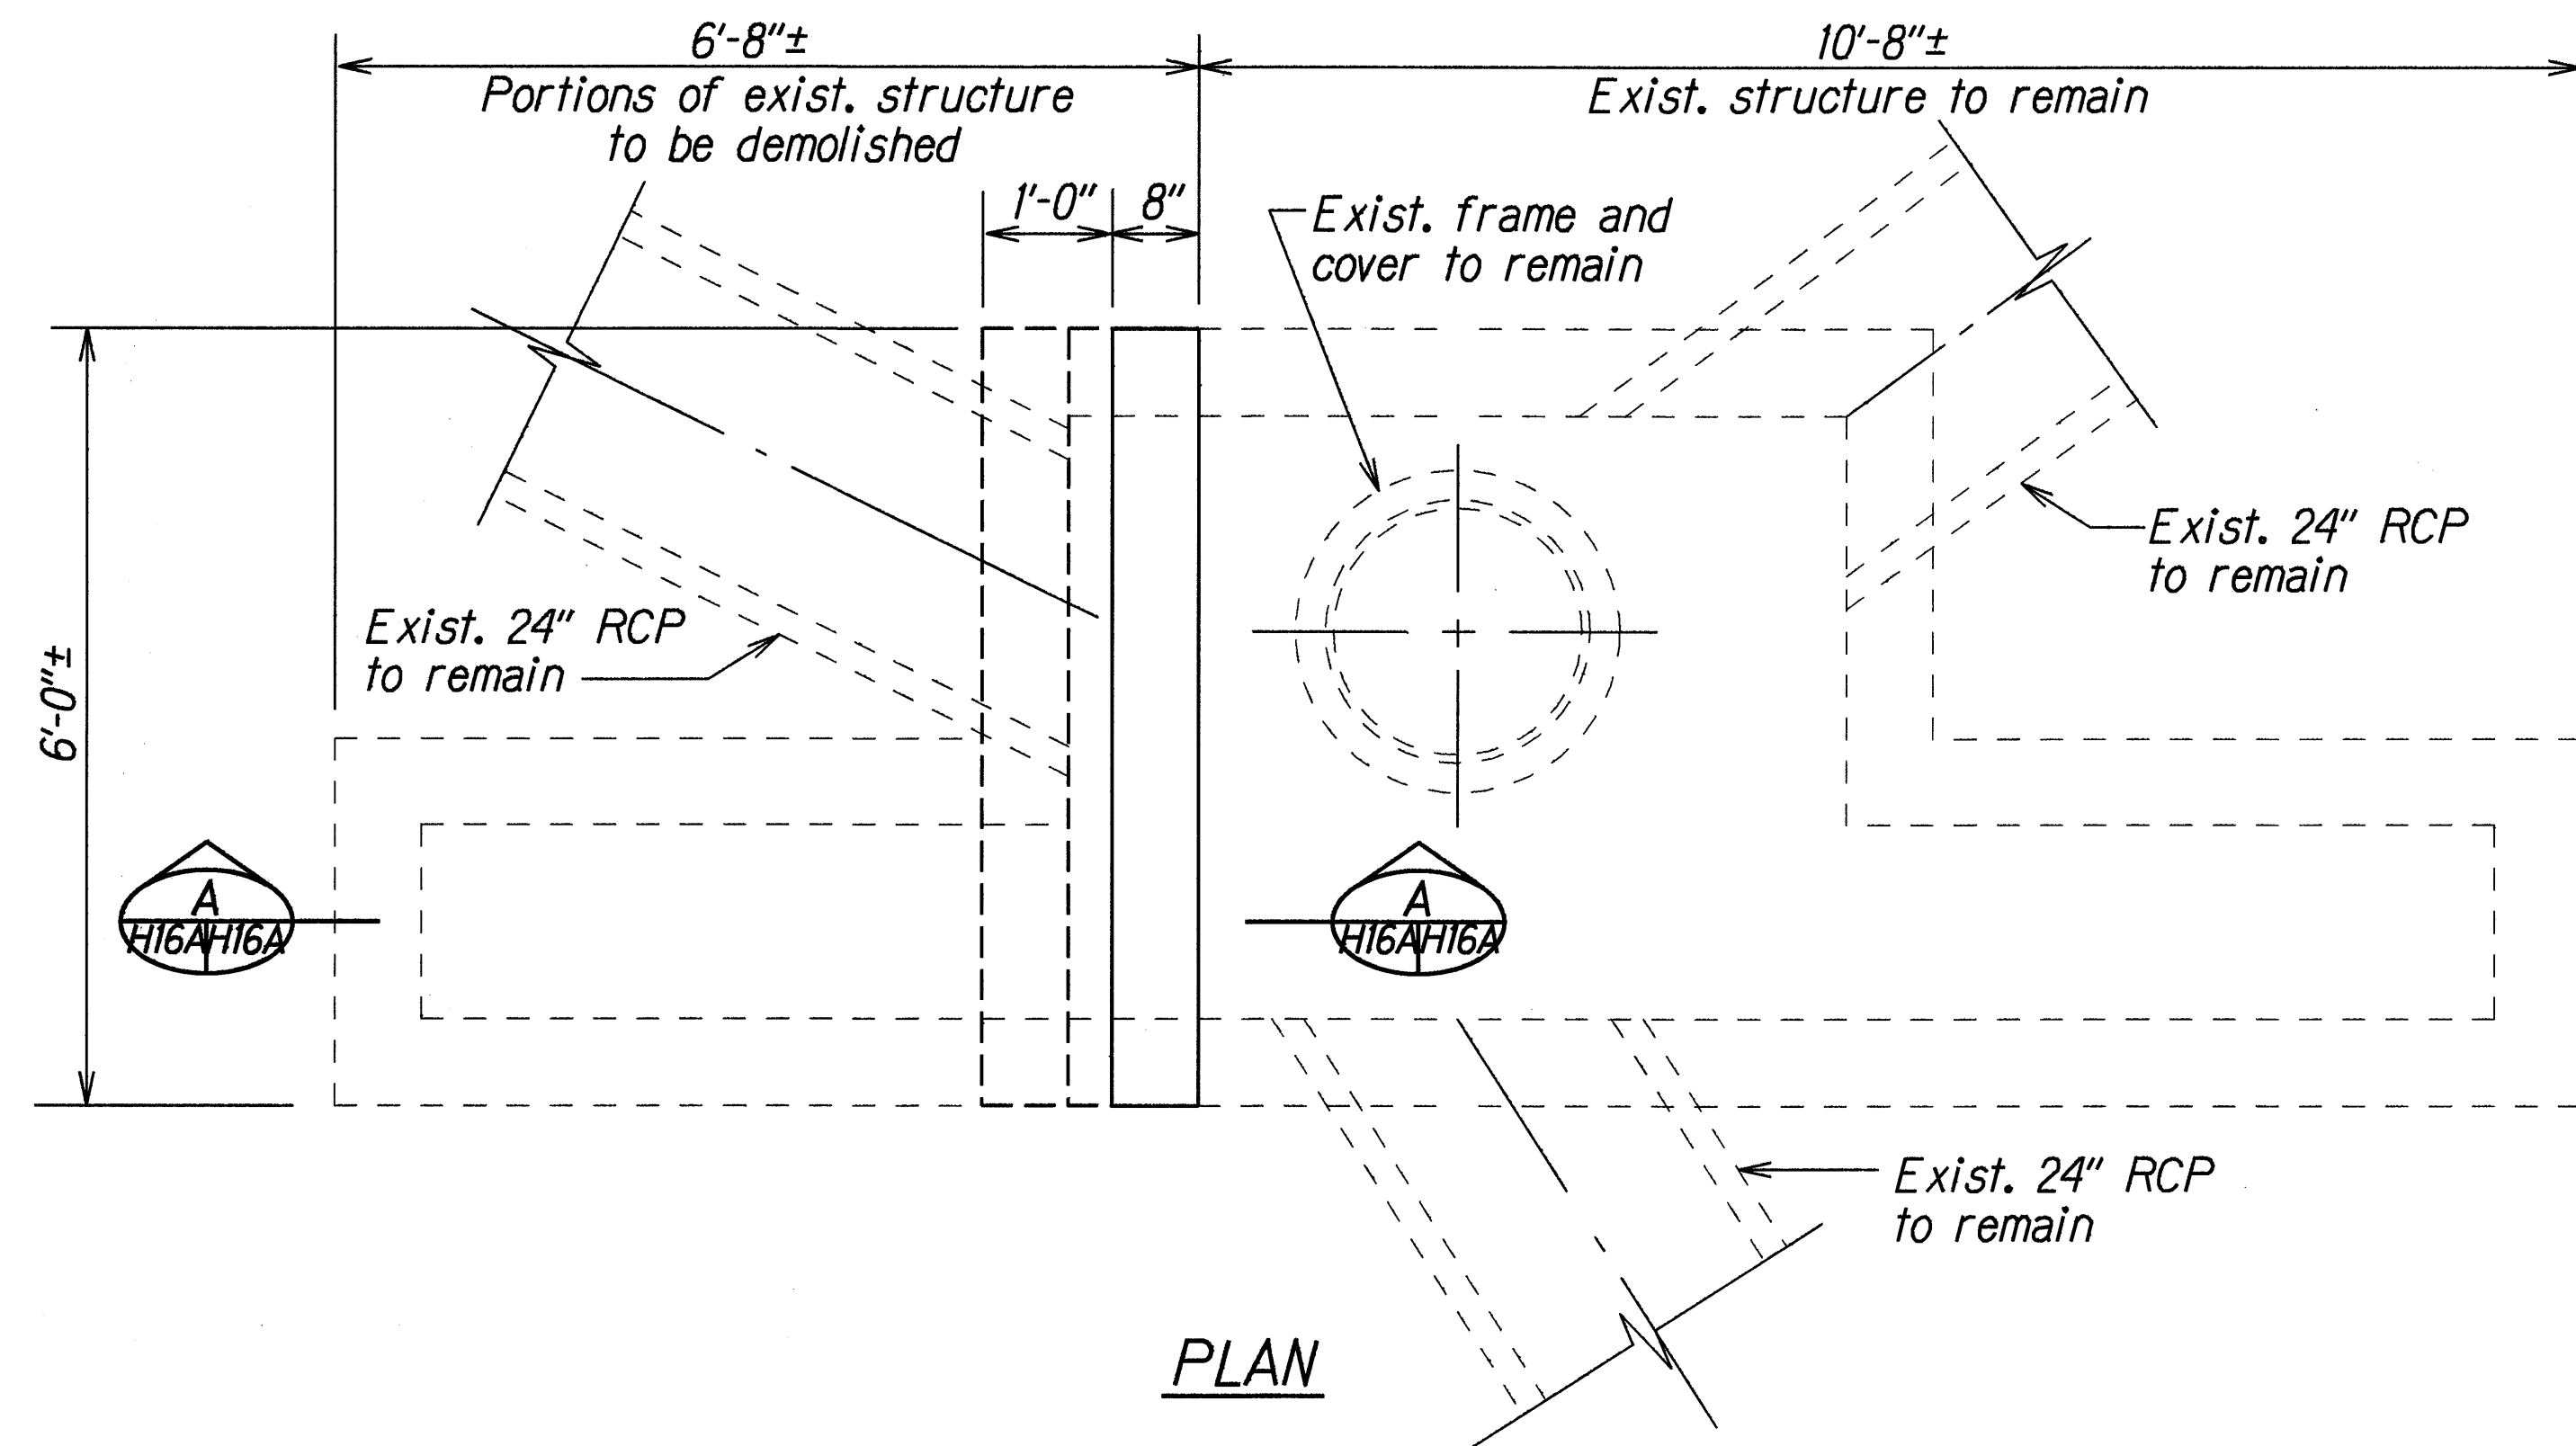


DETAILS OF MODIFIED TYPE "A" CATCH BASIN AT STA. 2+94± RT.


ORIGINAL PLAN	DATE	1/14/99
SURVEY PLOTTED BY		
DRAWN BY		
NOTED BY		
CHECKED BY		

1/27/99	Added Drainage Details Sheet
DATE	REVISION
STATE OF HAWAII DEPARTMENT OF TRANSPORTATION HIGHWAYS DIVISION DRAINAGE DETAILS <u>PALI HIGHWAY RESURFACING</u> <u>Country Club Rd. to Tunnel Entrance,</u> <u>Including Both Rds. to Lookout</u> <u>Project No. 61A-01-97M</u> Scale: 3/4"=1'-0" Date: Jan. 1999 SHEET No. H16A OF 24 SHEETS	


FED. ROAD DIST. NO.	STATE	PROJ. NO.	FISCAL YEAR	SHEET NO.	TOTAL SHEETS
HAWAII	HAW.	61A-01-97M	1999	C.O. 56 S-2	84

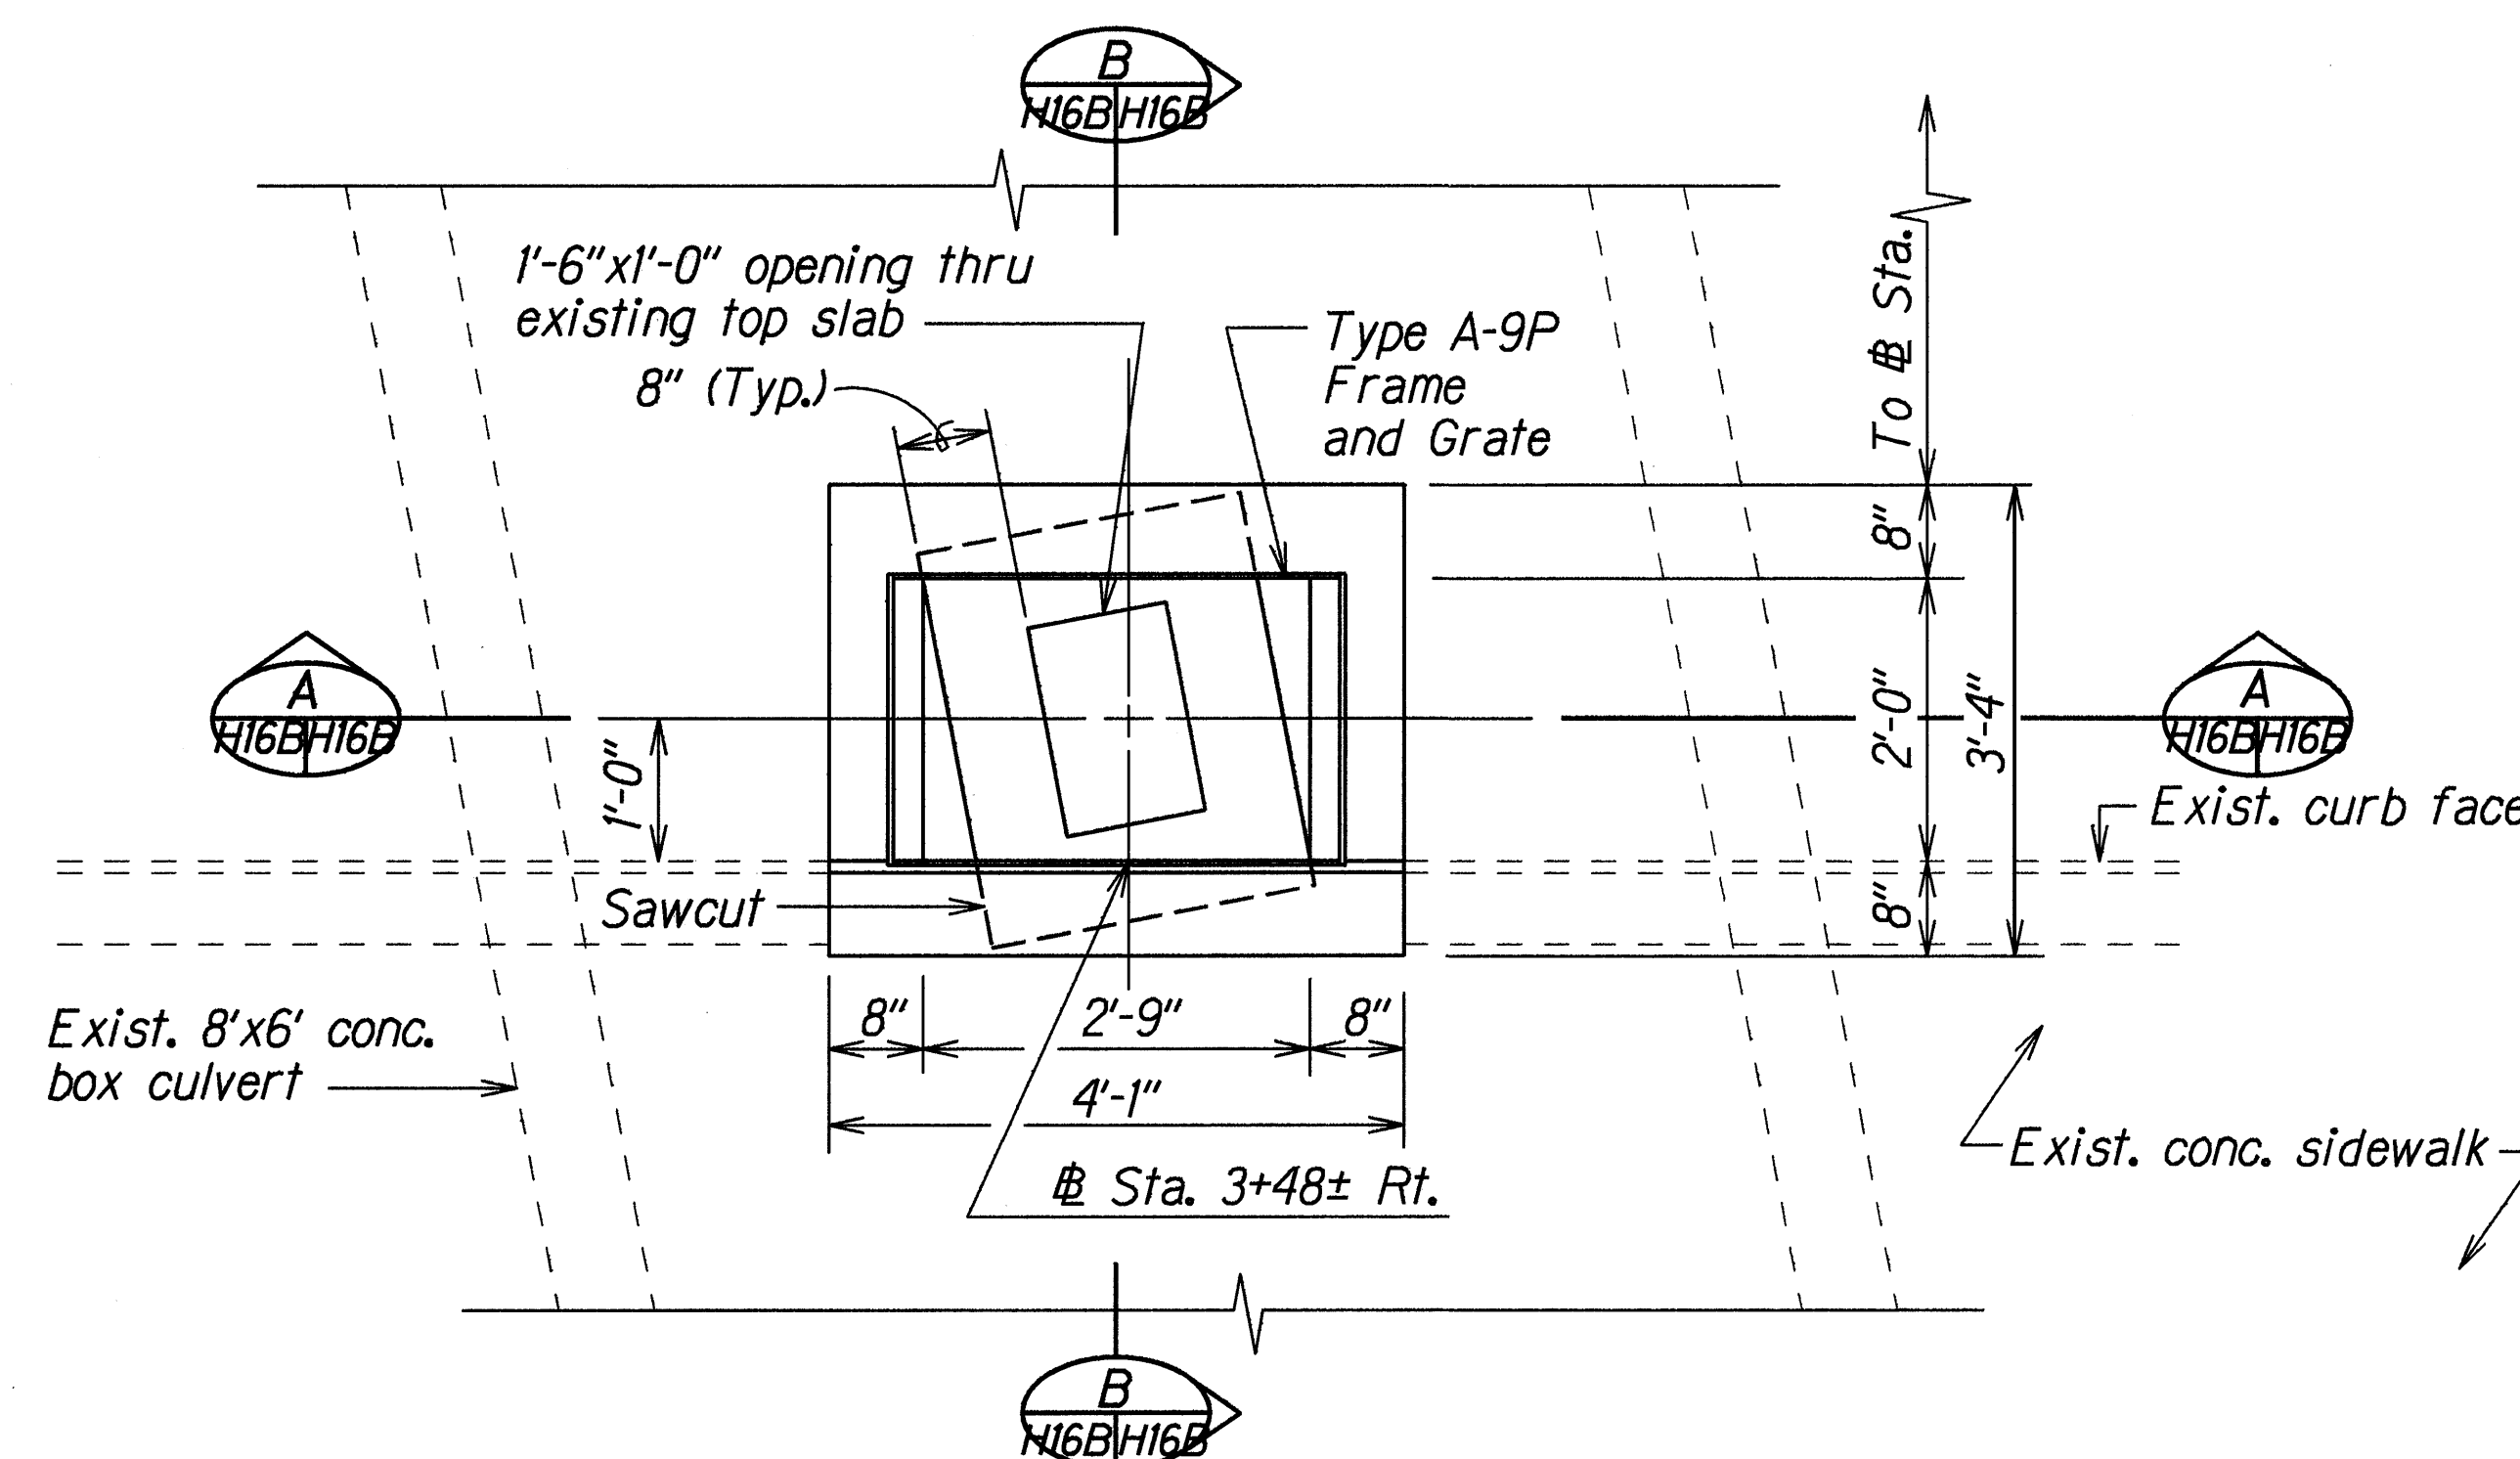


PLAN
Scale: $\frac{3}{4}$ "=1'-0"

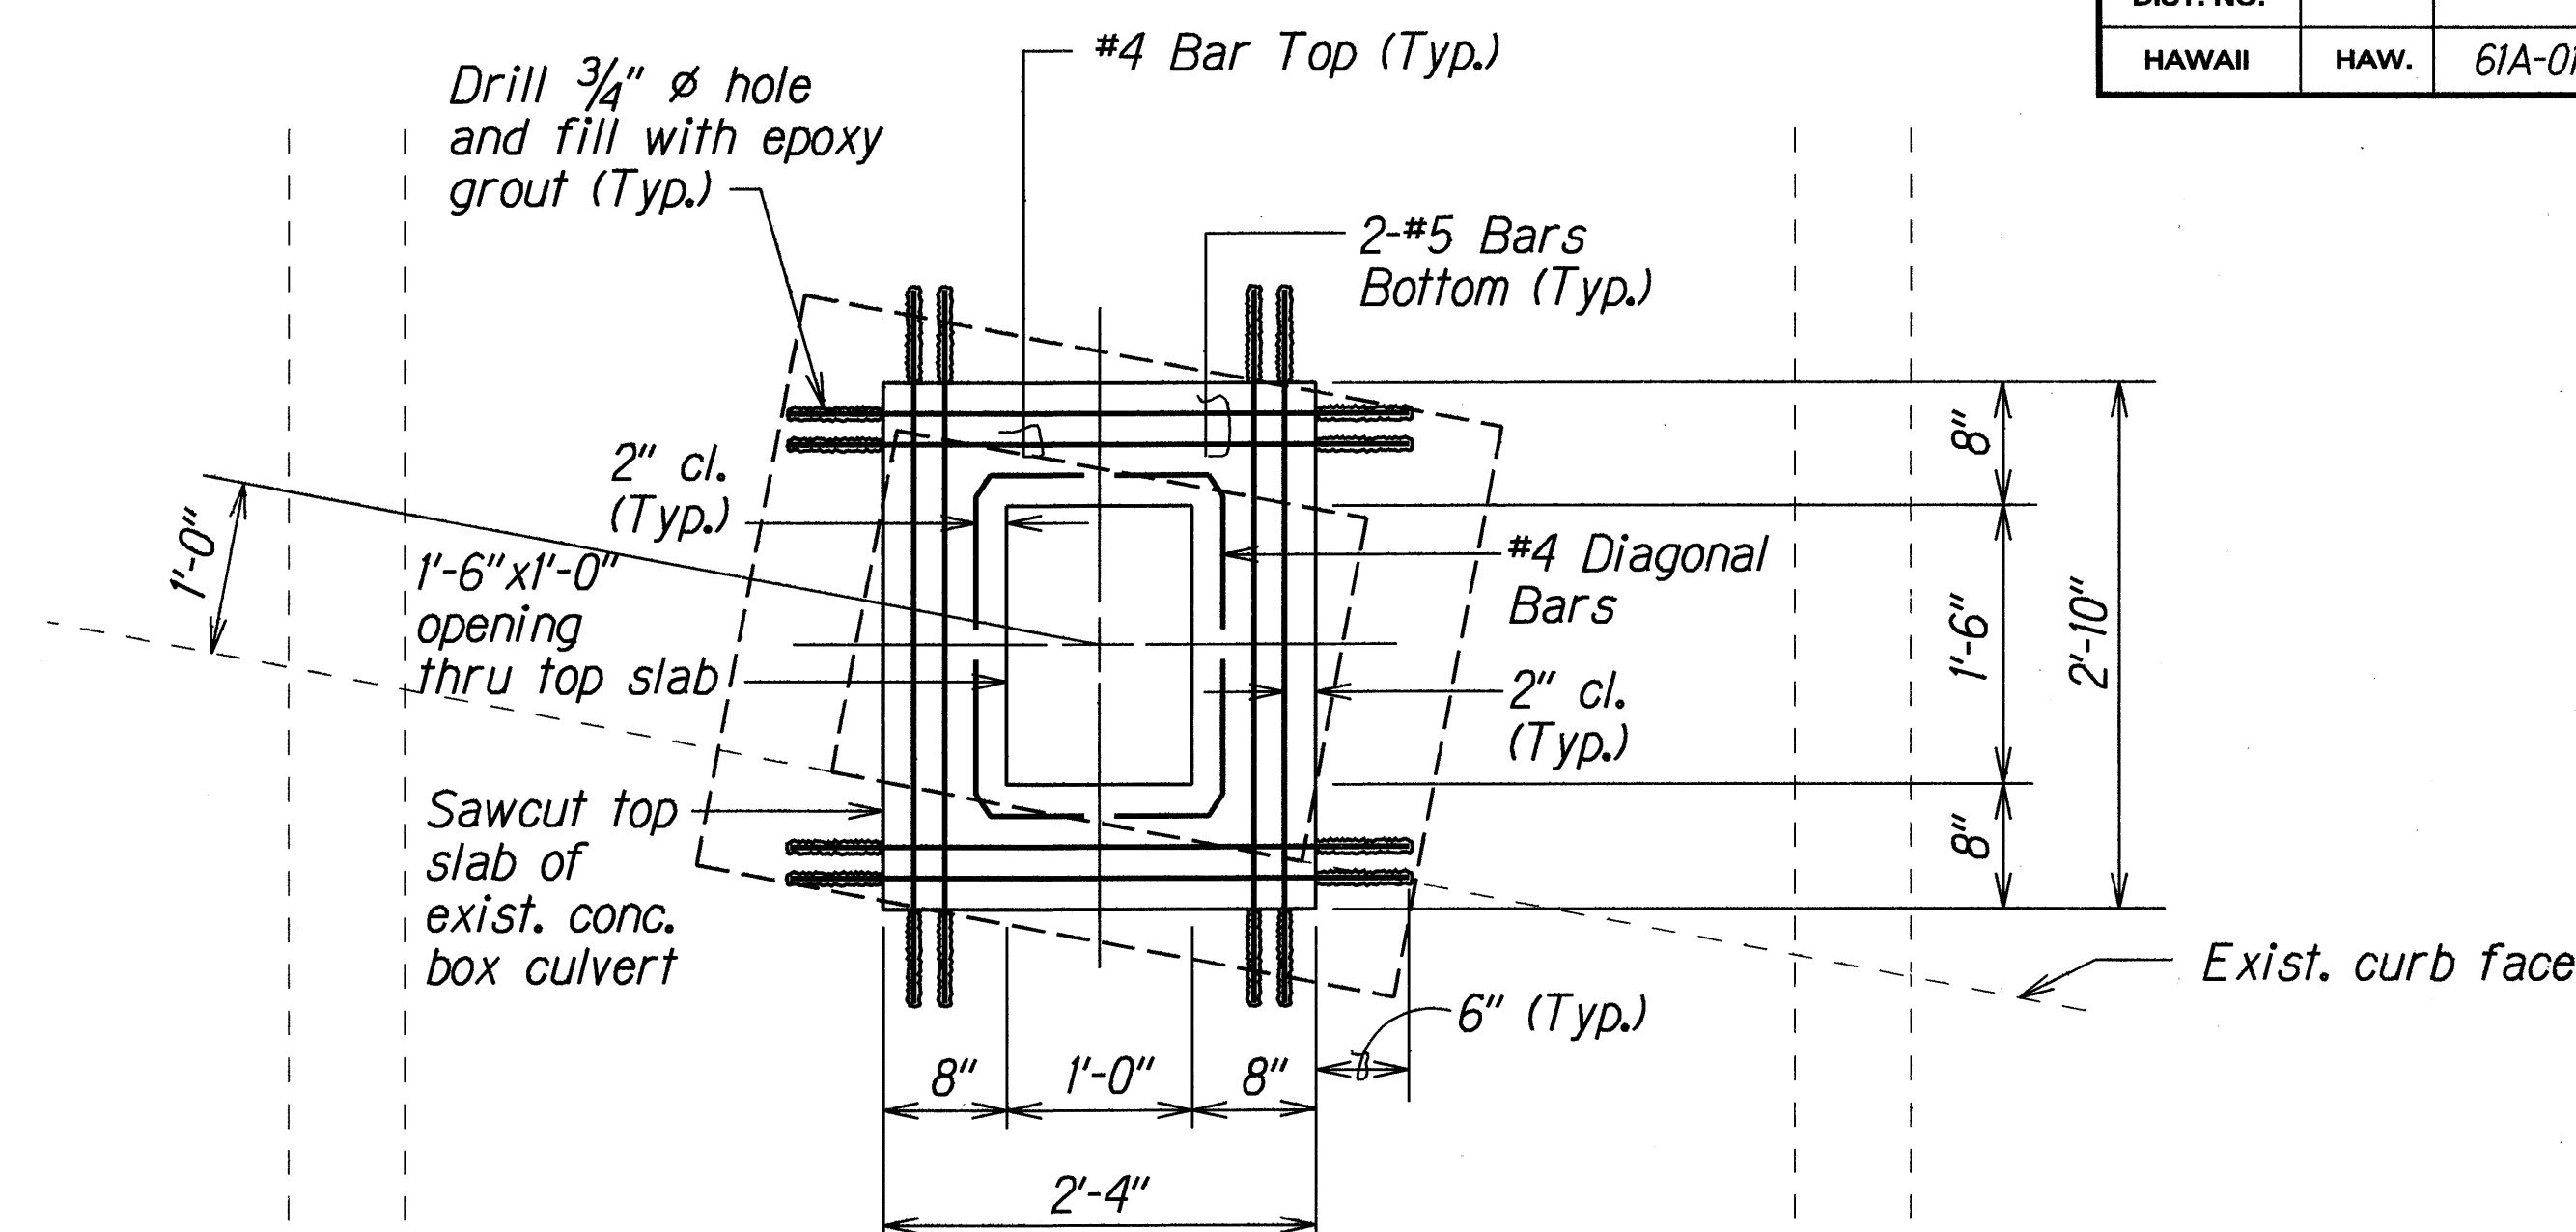


PLAN VIEW OF REINFORCING FOR TOP SLAB OPENING
Scale: 1"=1'-0"

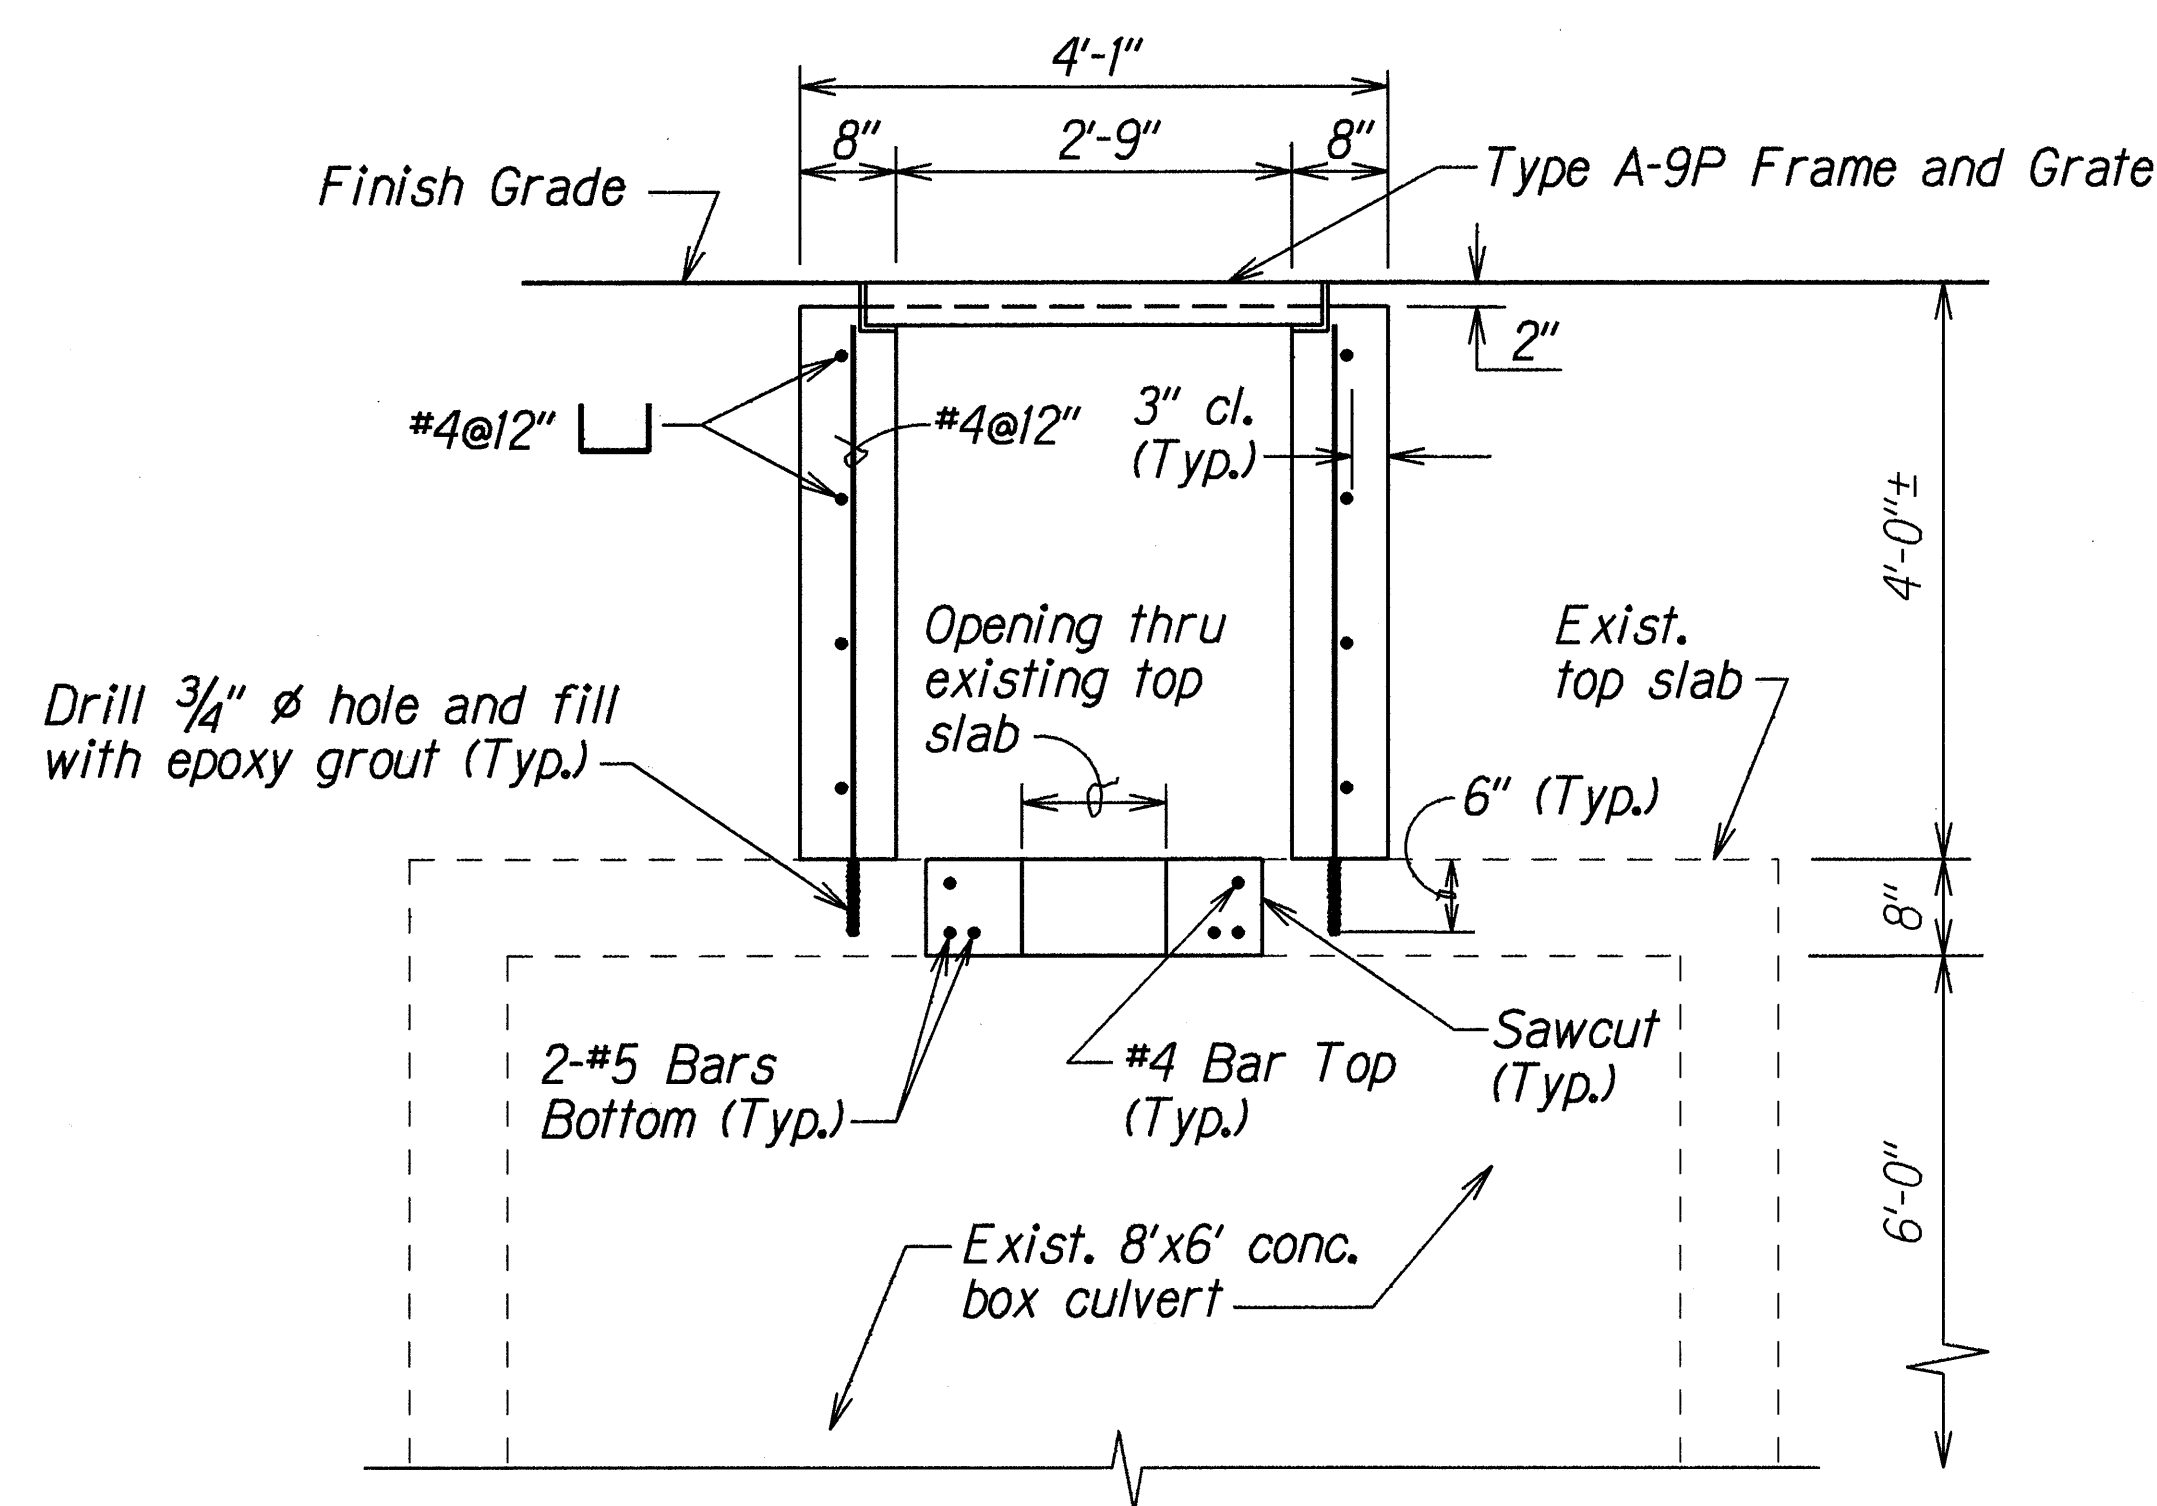


SECTION A
Scale: $\frac{3}{4}$ "=1'-0"

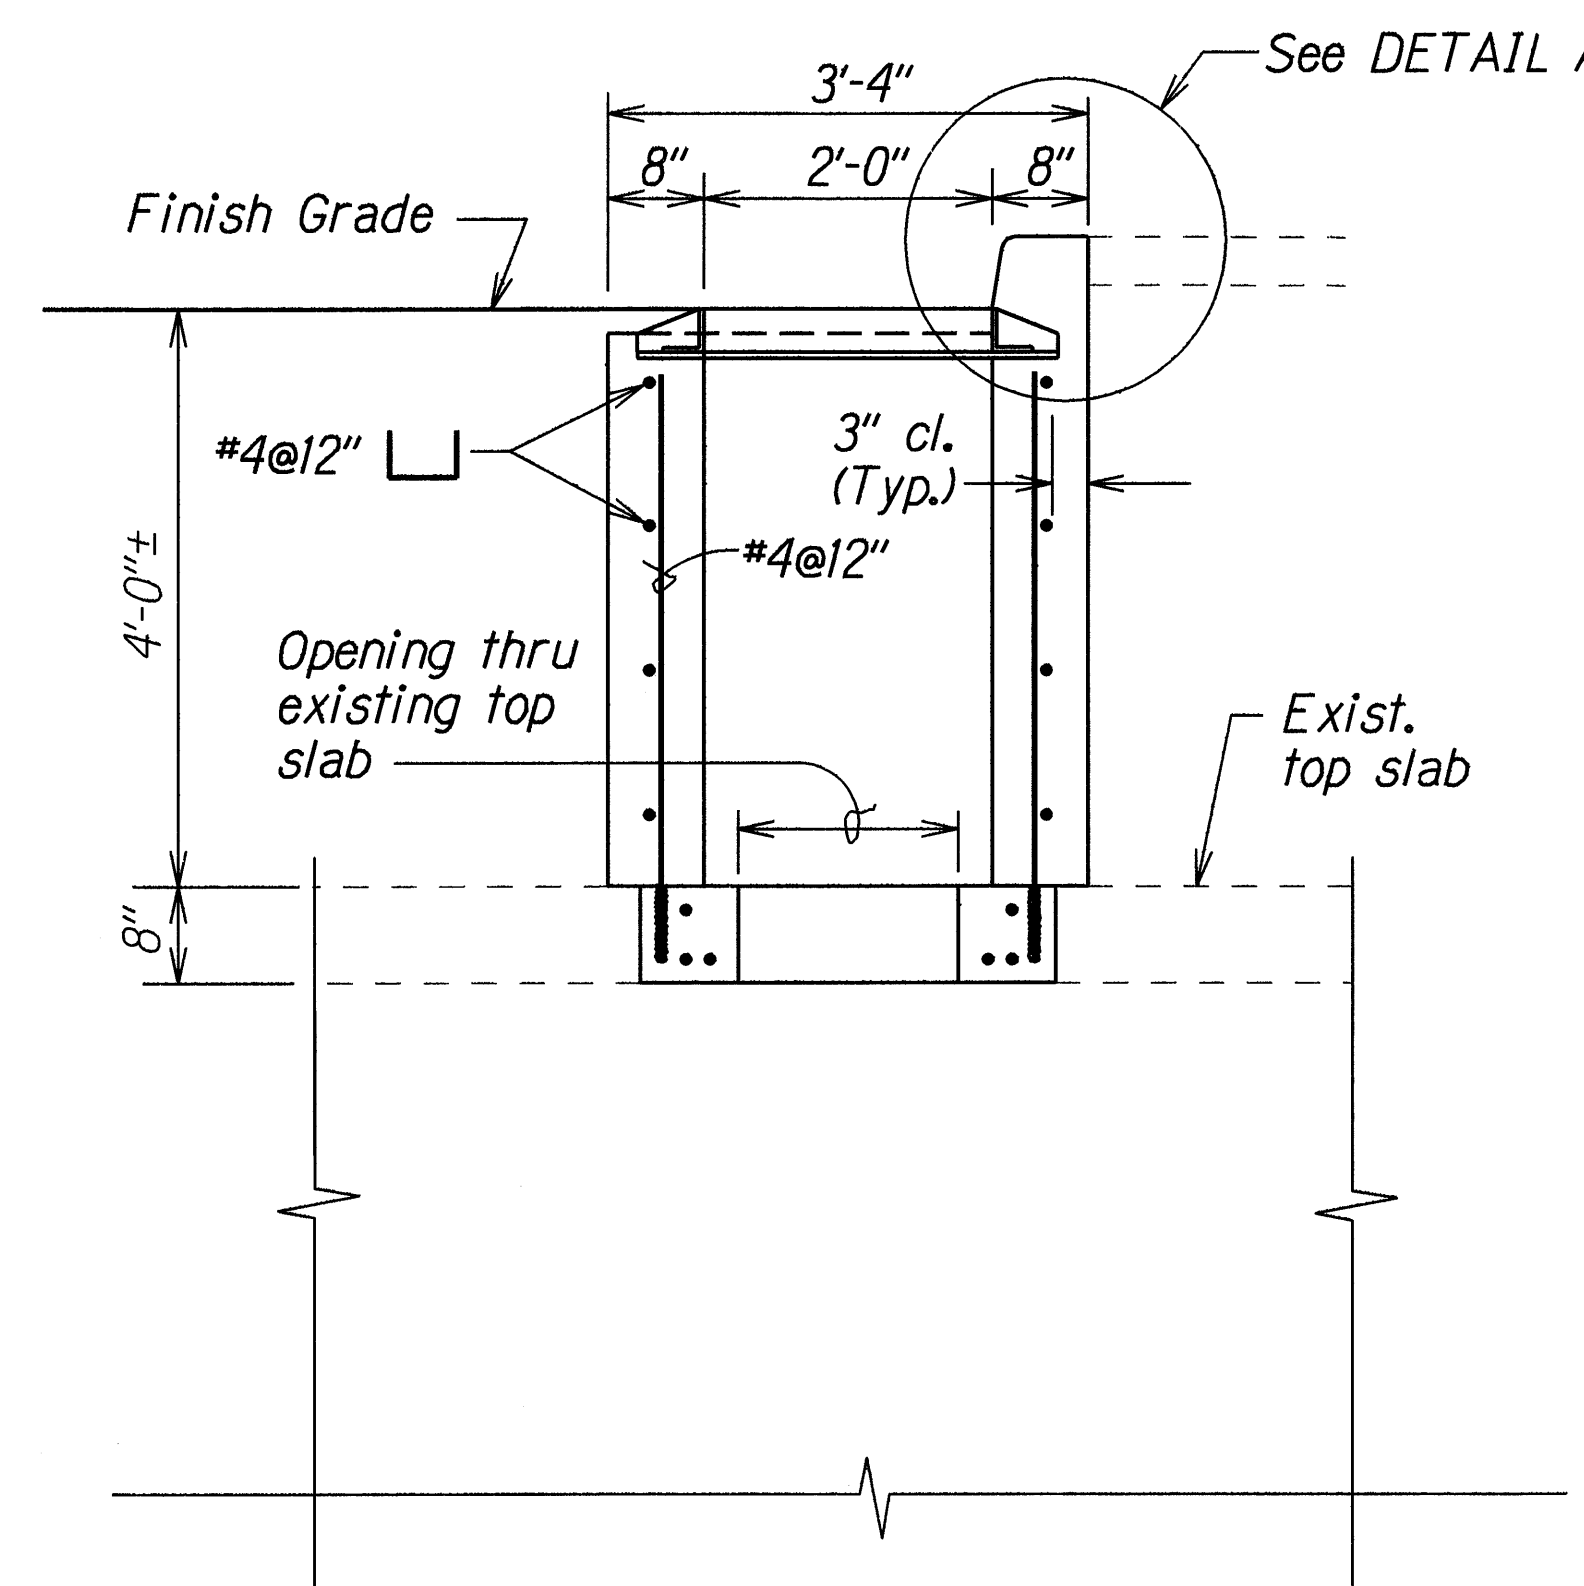

SECTION B
Scale: $\frac{3}{4}$ "=1'-0"

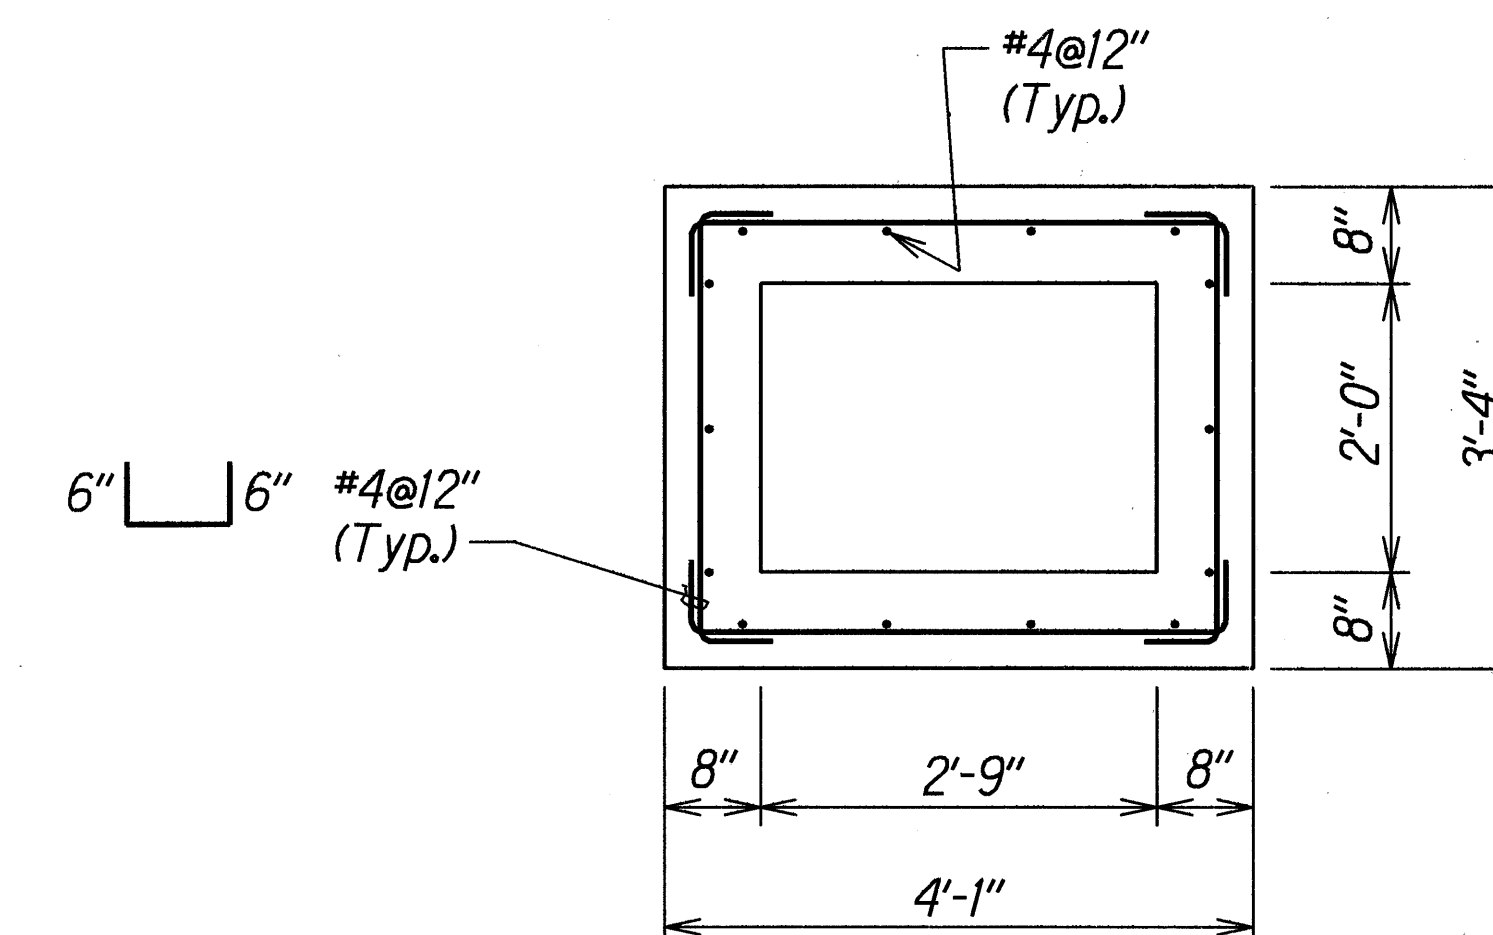

PLAN VIEW OF WALL REINFORCING
Scale: $\frac{3}{4}$ "=1'-0"

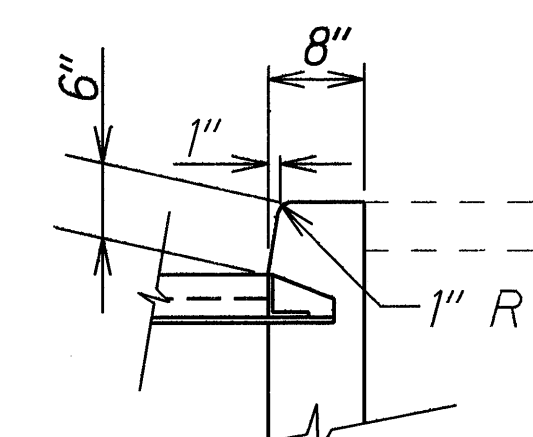

DETAIL A

DETAILS OF MODIFIED TYPE "A-9P" GDI AT STA. 3+48± RT.

ORIGINAL PLAN	DATE	1/14/99
DRAWN BY	A. Nishida & R. Sato	
CHECKED BY	C. Matsuda	
NOTED BY	dh2carlscap	
QUANTITIES BY	dh2carlscap	
CHECKED BY	dh2carlscap	

1-27-99 Added Drainage Details Sheet

DATE REVISION


STATE OF HAWAII
DEPARTMENT OF TRANSPORTATION
HIGHWAYS DIVISION
DRAINAGE DETAILS
PALI HIGHWAY RESURFACING
Country Club Rd. to Tunnel Entrance,
Including Both Rds. to Lookout
Project No. 61A-01-97M

Scale: As Noted Date: Jan. 1999


SHEET No. H16B OF 24 SHEETS

C.O. 56 S-2


FED. ROAD DIST. NO.	STATE	FED. AID PROJ. NO.	FISCAL YEAR	SHEET NO.	TOTAL SHEETS
HAWAII	HAW.	61A-01-97M	1997	59	84

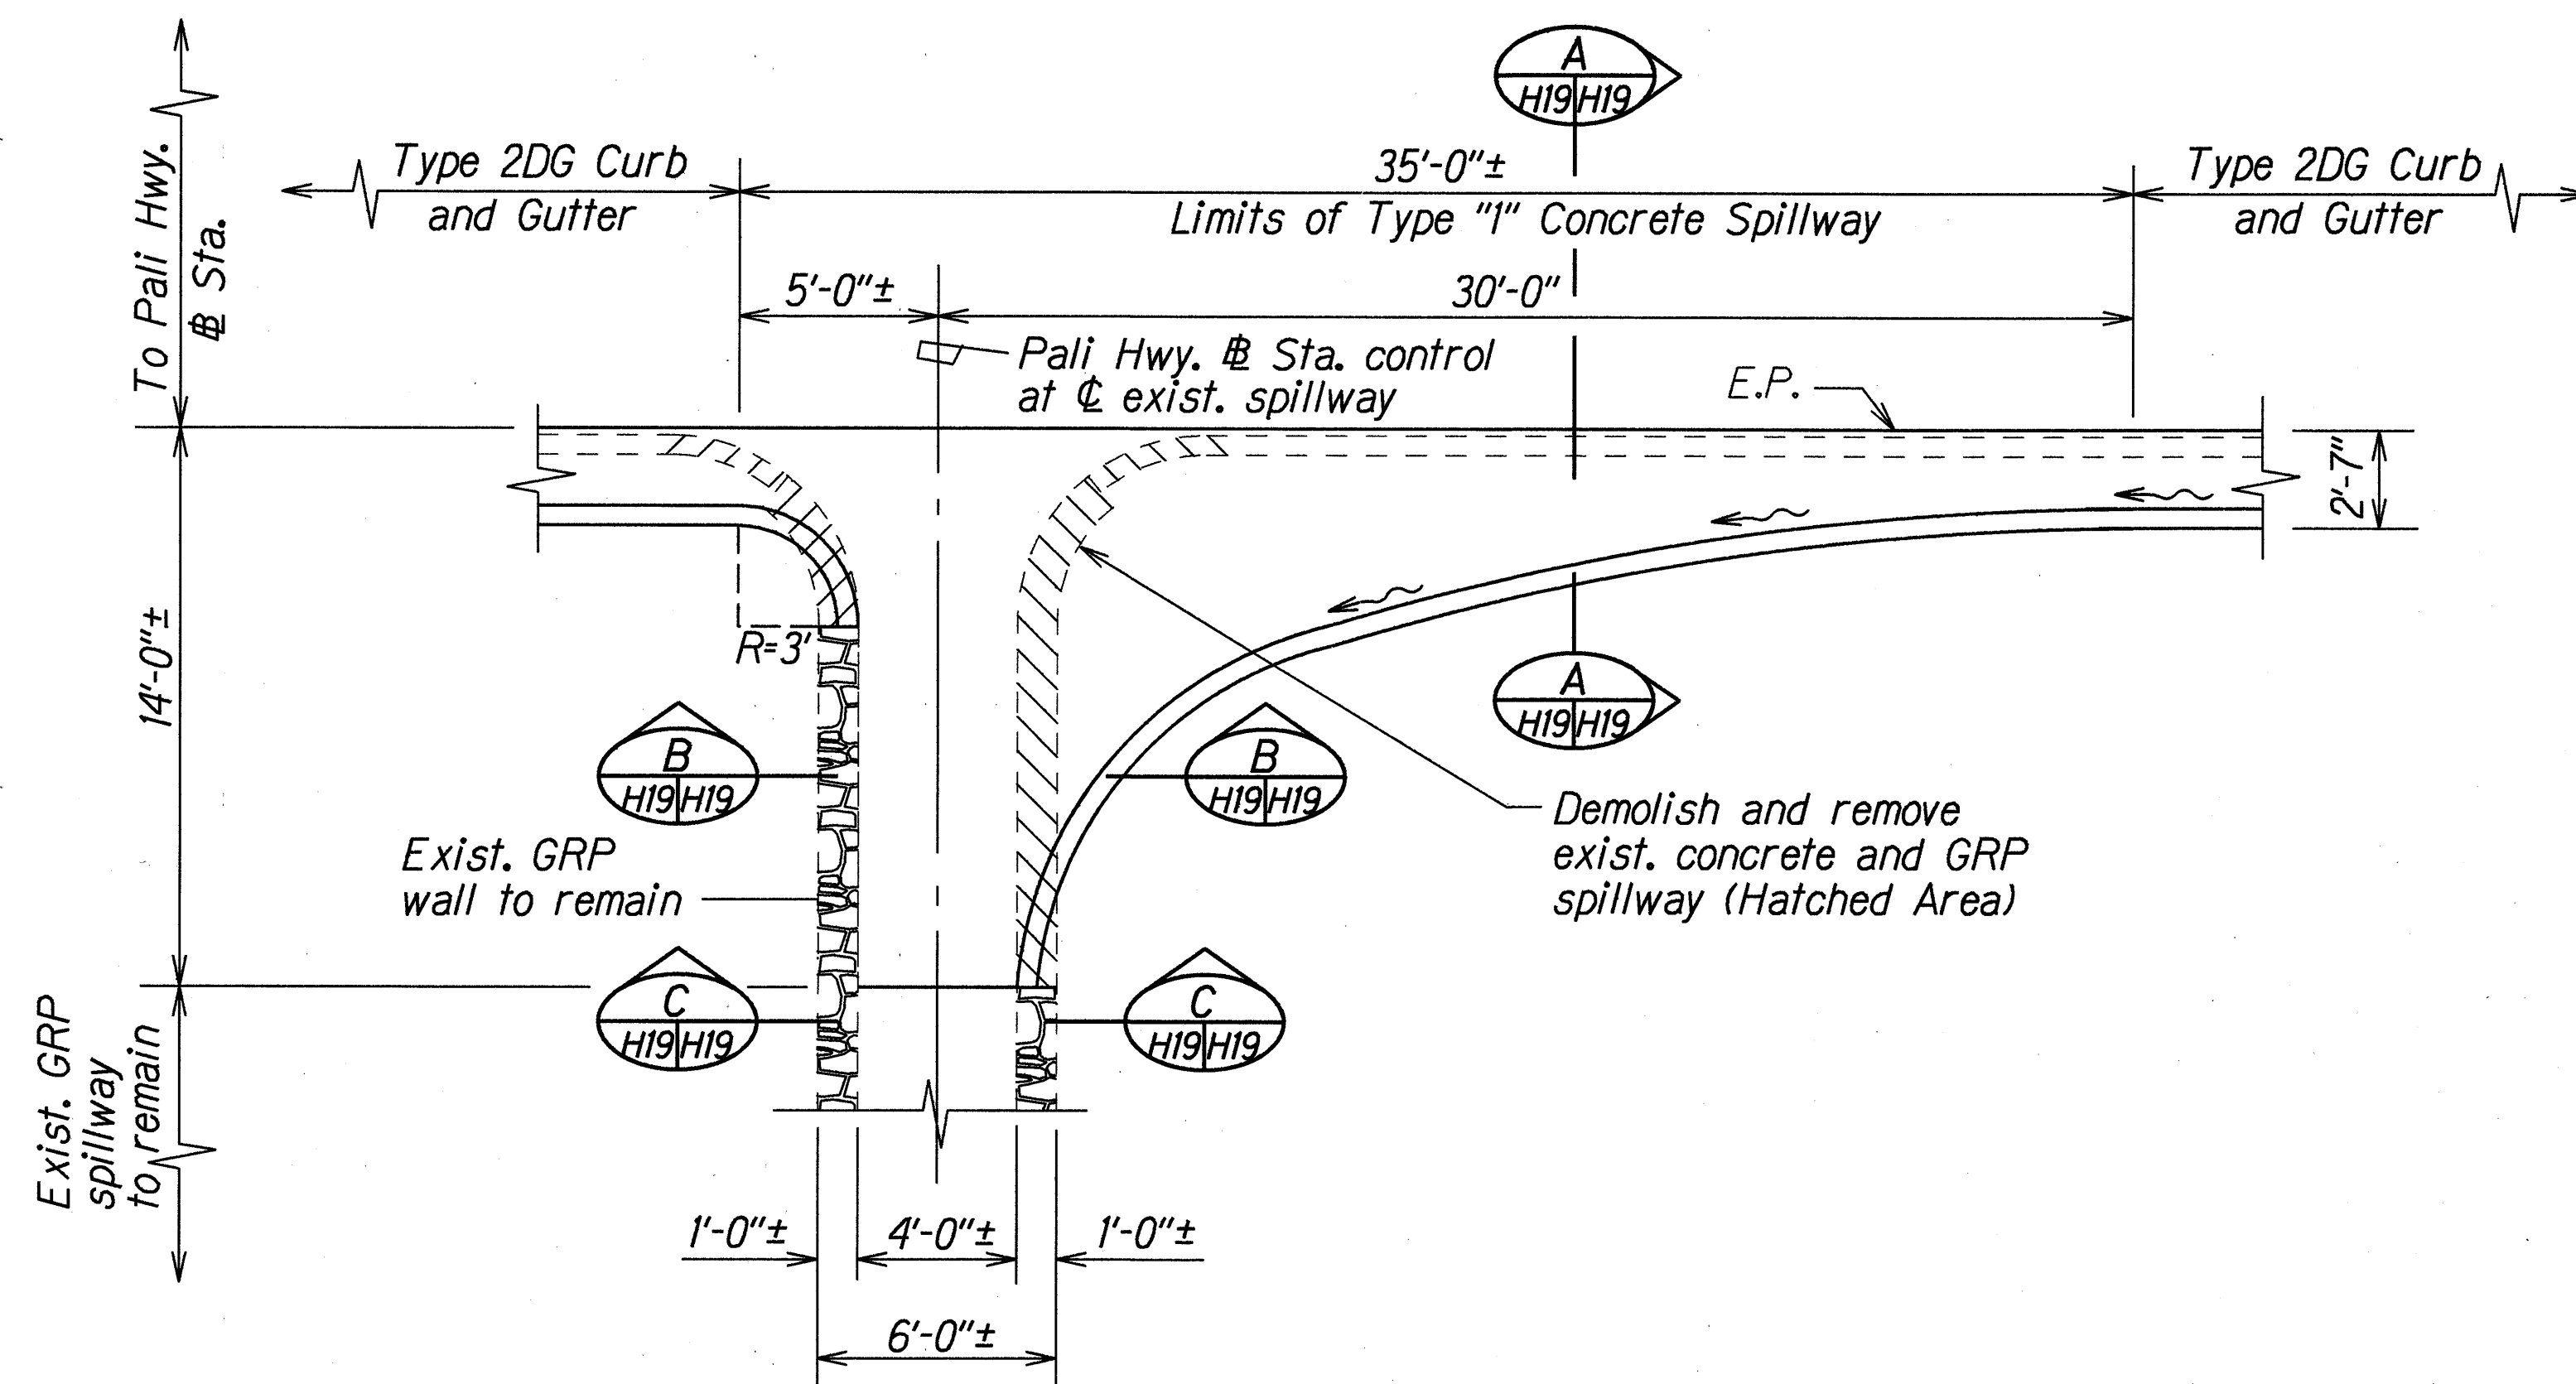


PLAN
Scale: 1/4"=1'-0"

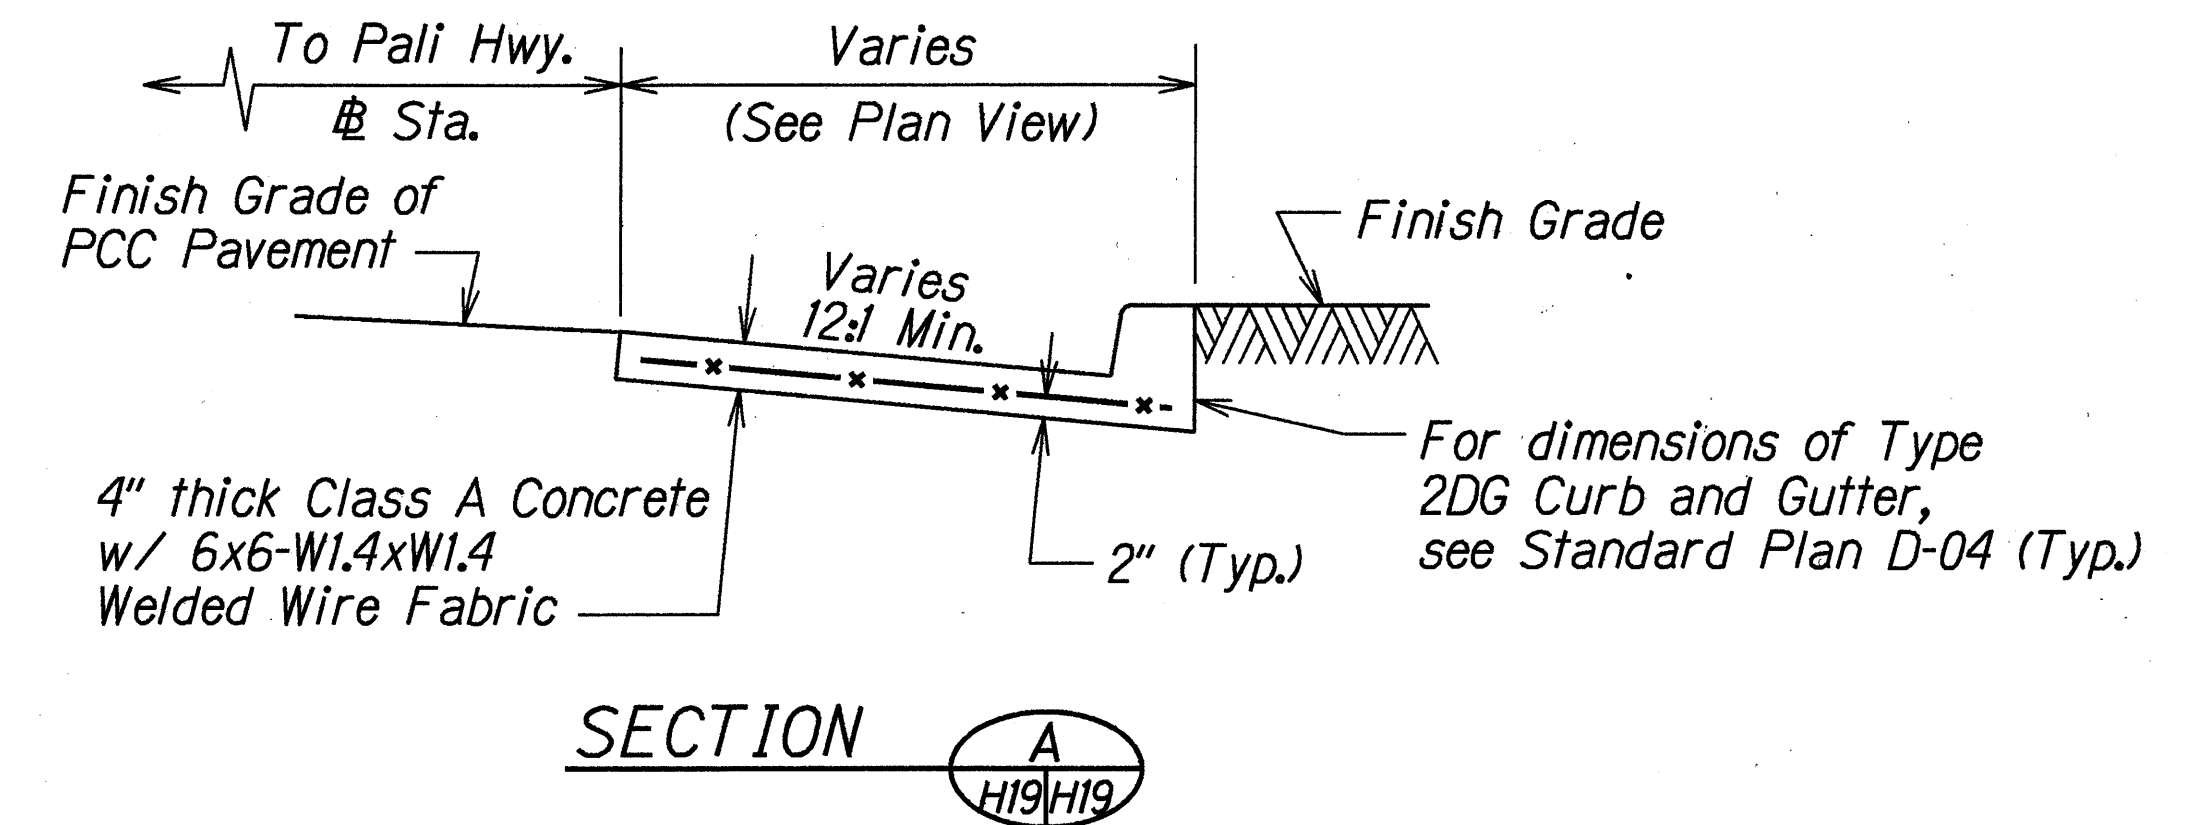

SECTION A-A
H19/H19

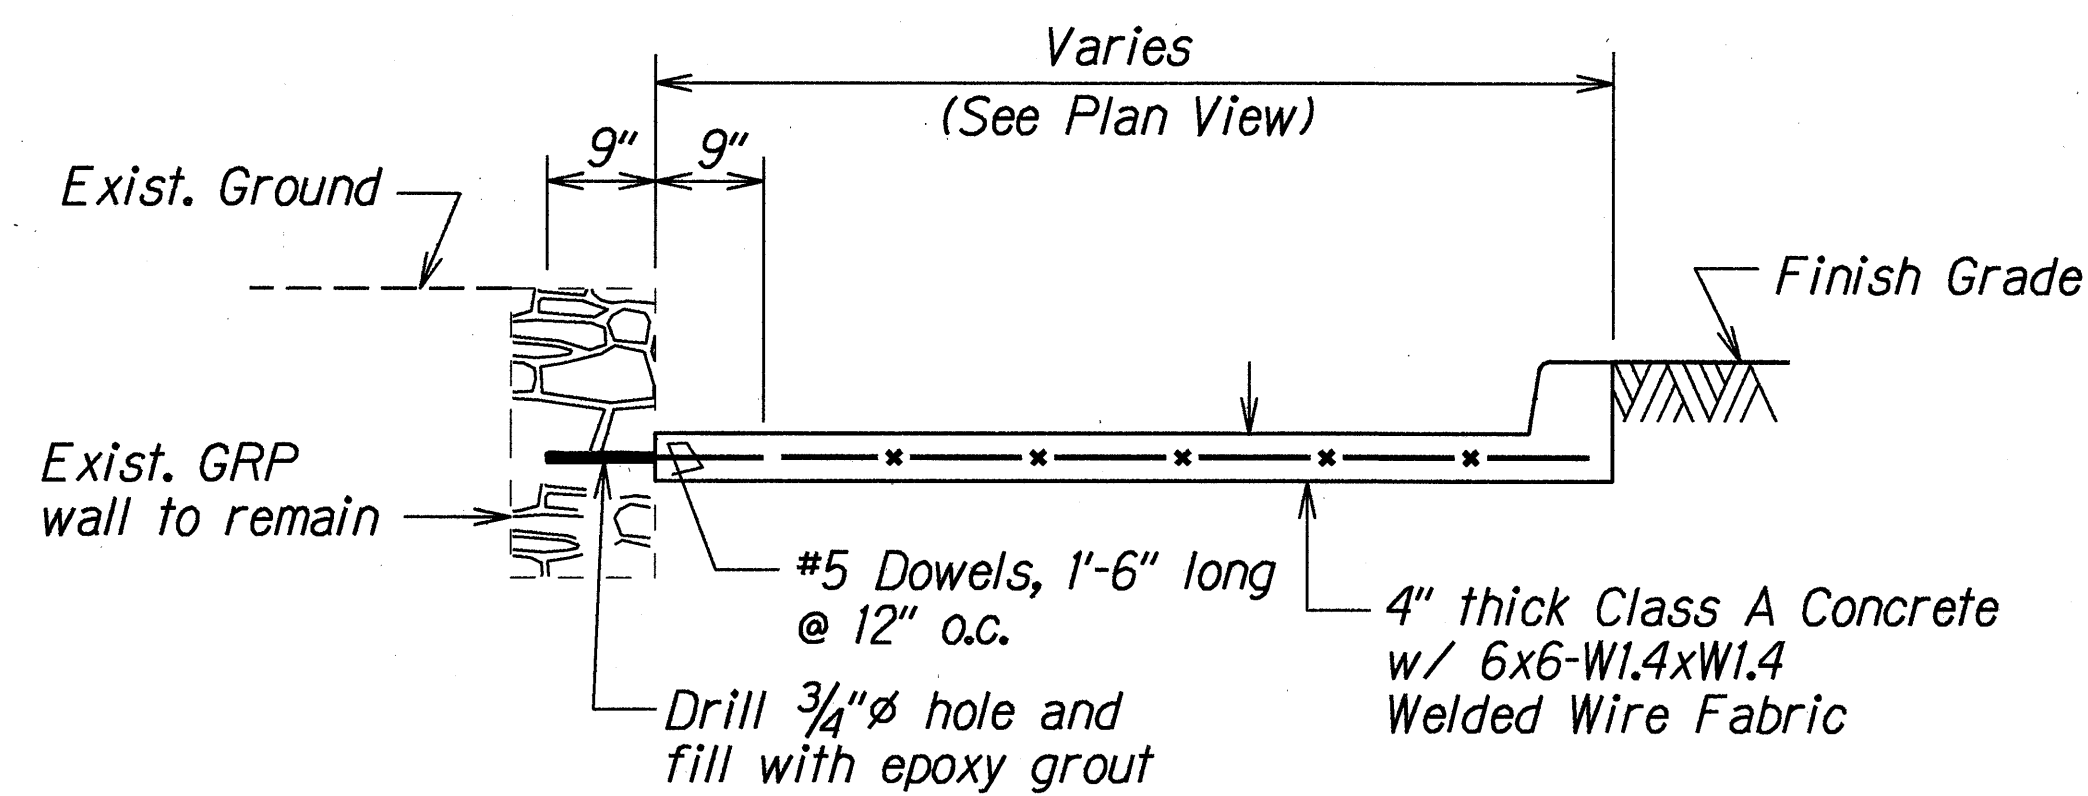

SECTION B-B
H19/H19

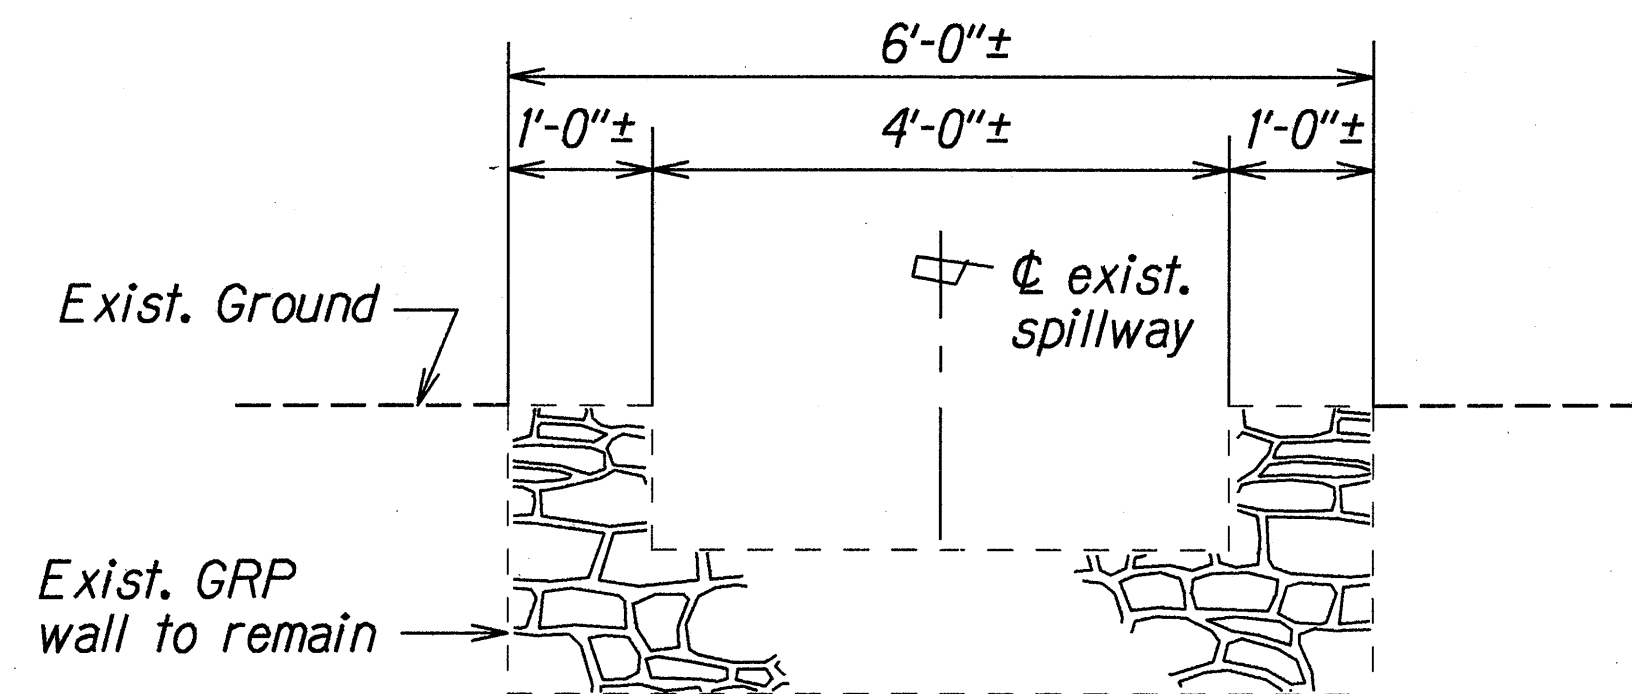


SECTION C-C
H19/H19


TYPICAL DETAILS OF TYPE "I" CONCRETE SPILLWAY

STATE OF HAWAII
DEPARTMENT OF TRANSPORTATION
HIGHWAYS DIVISION
DRAINAGE DETAILS
PALI HIGHWAY RESURFACING
Country Club Rd. to Tunnel Entrance,
Including Both Rds. to Lookout
Project No. 61A-01-97M
Scale: 3/4"=1'-0" Date: May 1997
SHEET No. H19 OF 24 SHEETS


FED. ROAD DIST. NO.	STATE	FED. AID PROJ. NO.	FISCAL YEAR	SHEET NO.	TOTAL SHEETS
HAWAII	HAW.	61A-01-97M	1997	60	84

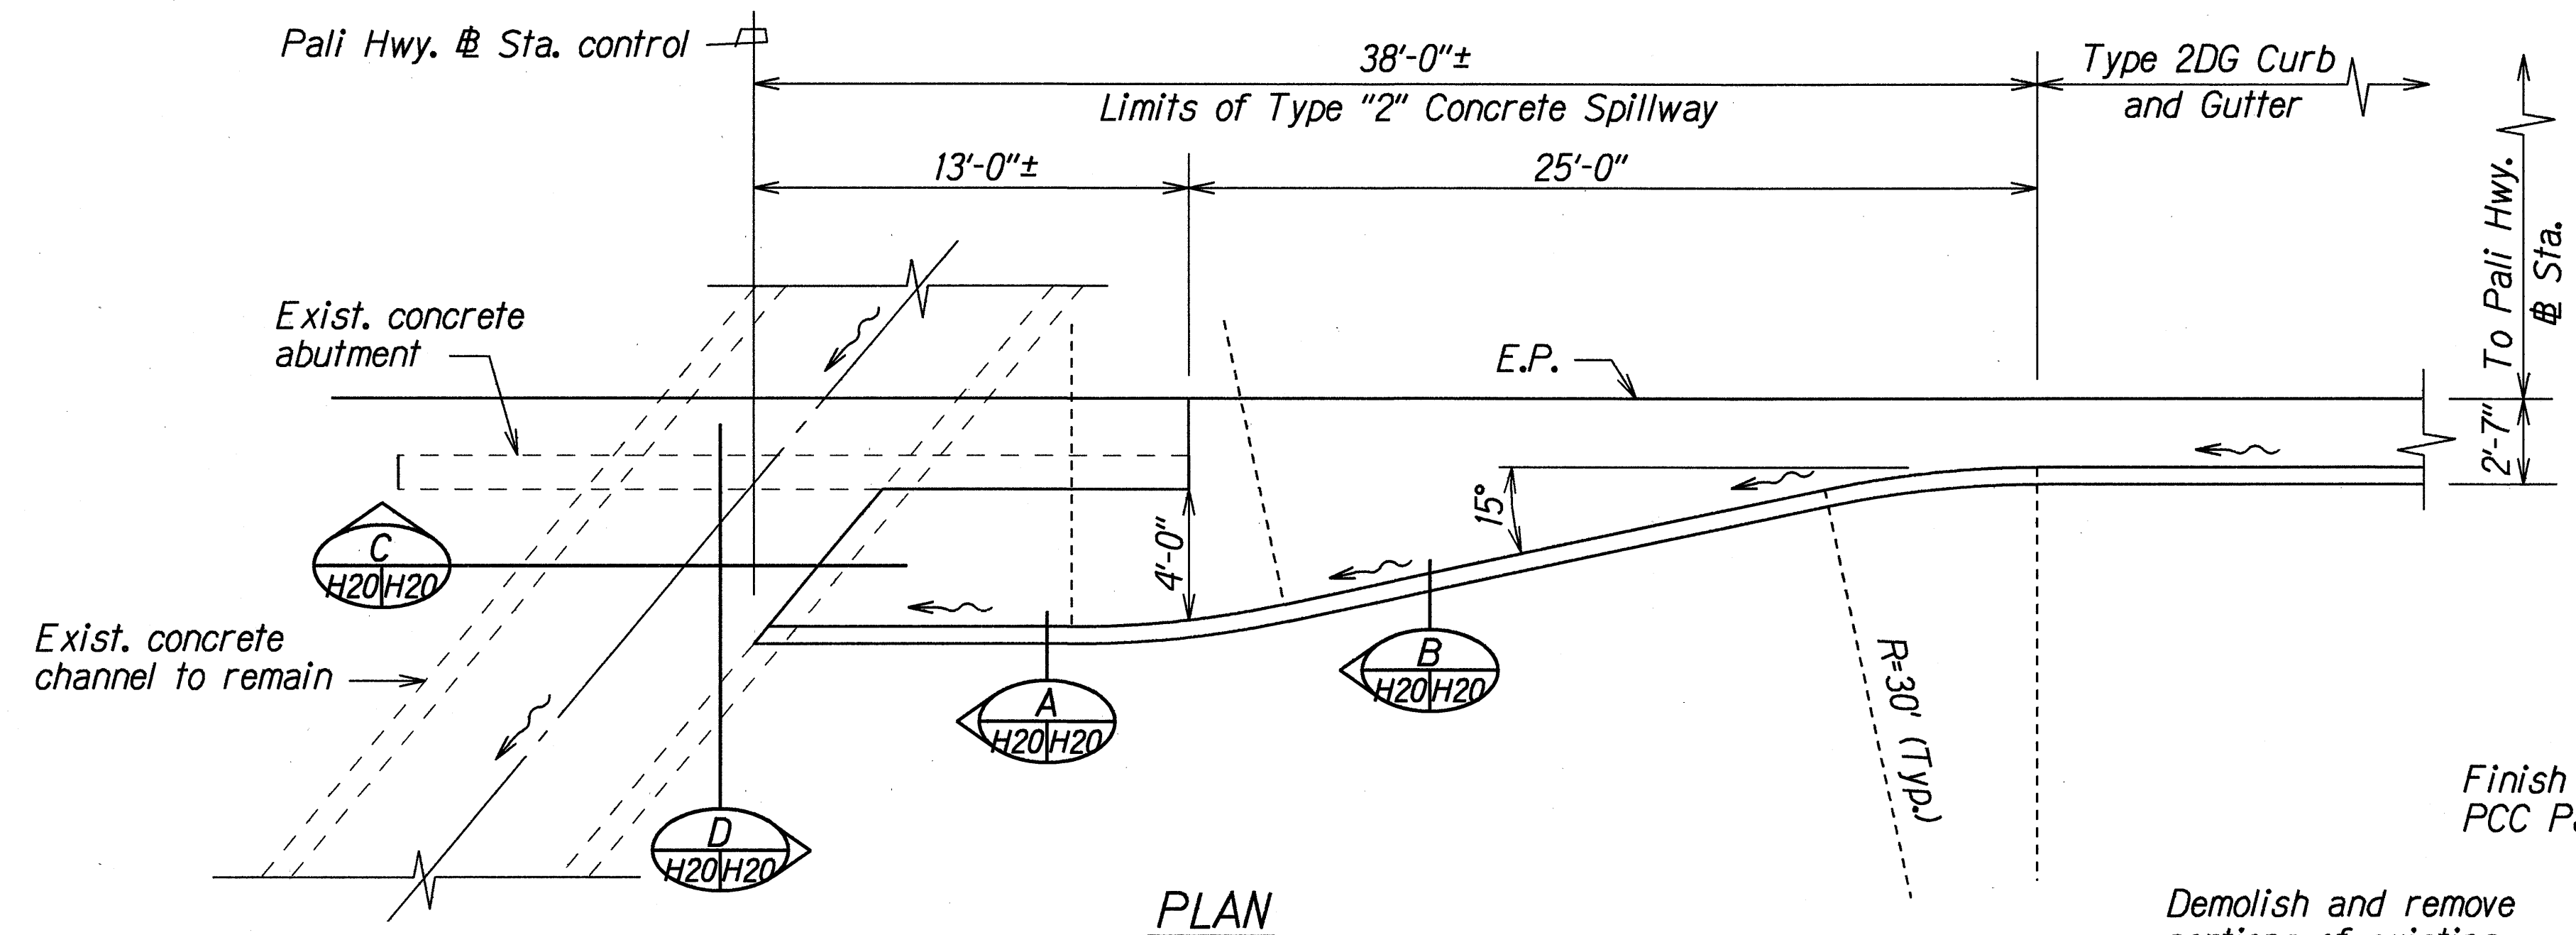


PLAN
Scale: 1/4"=1'-0"

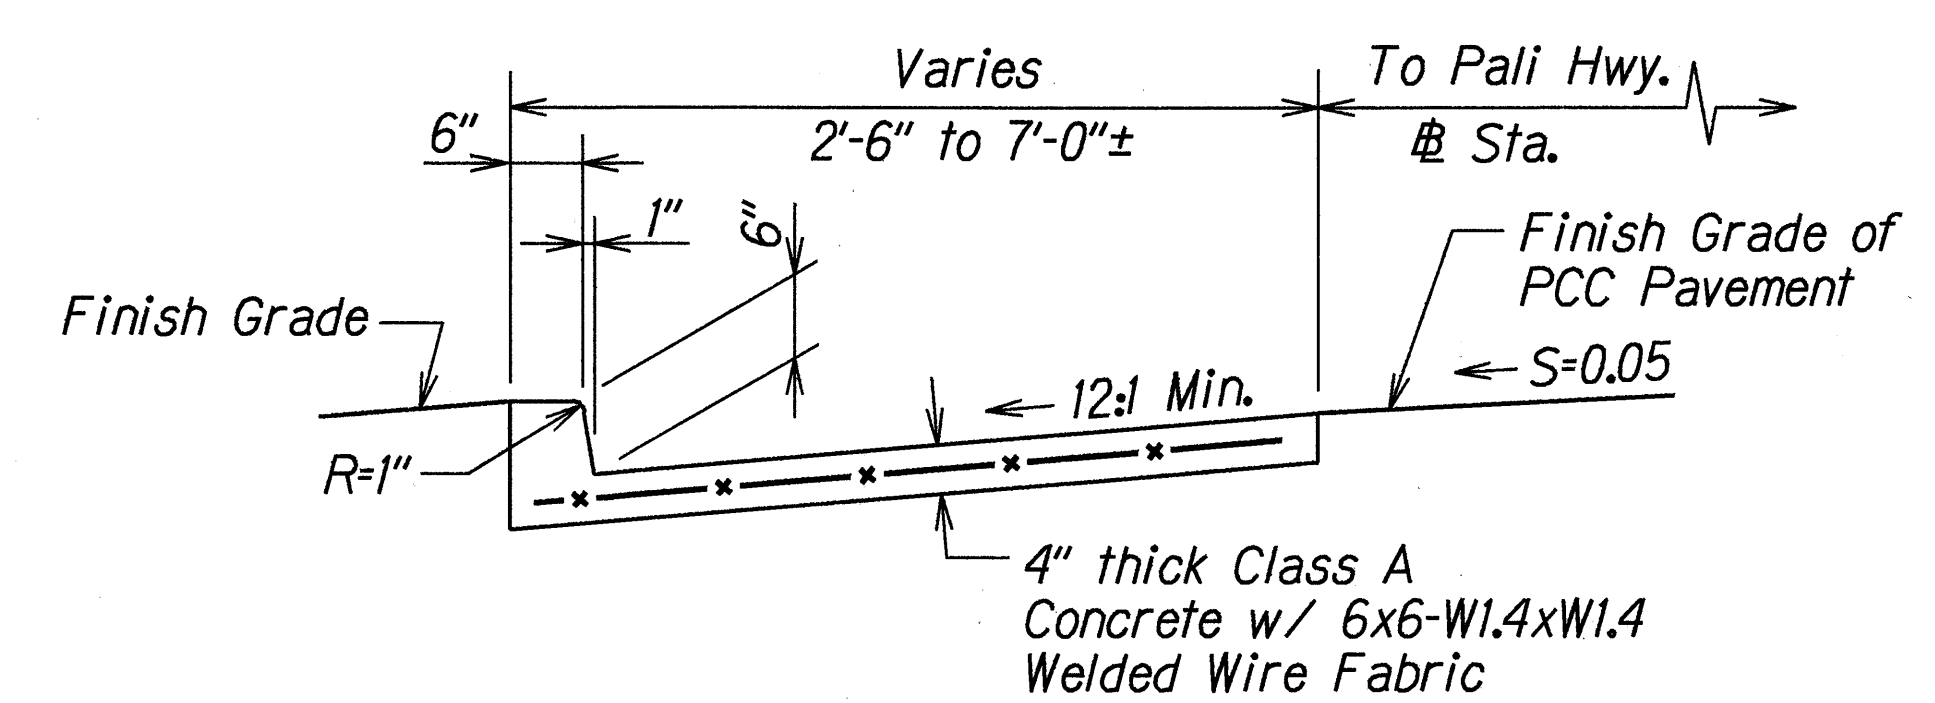


SECTION B
H20/H20

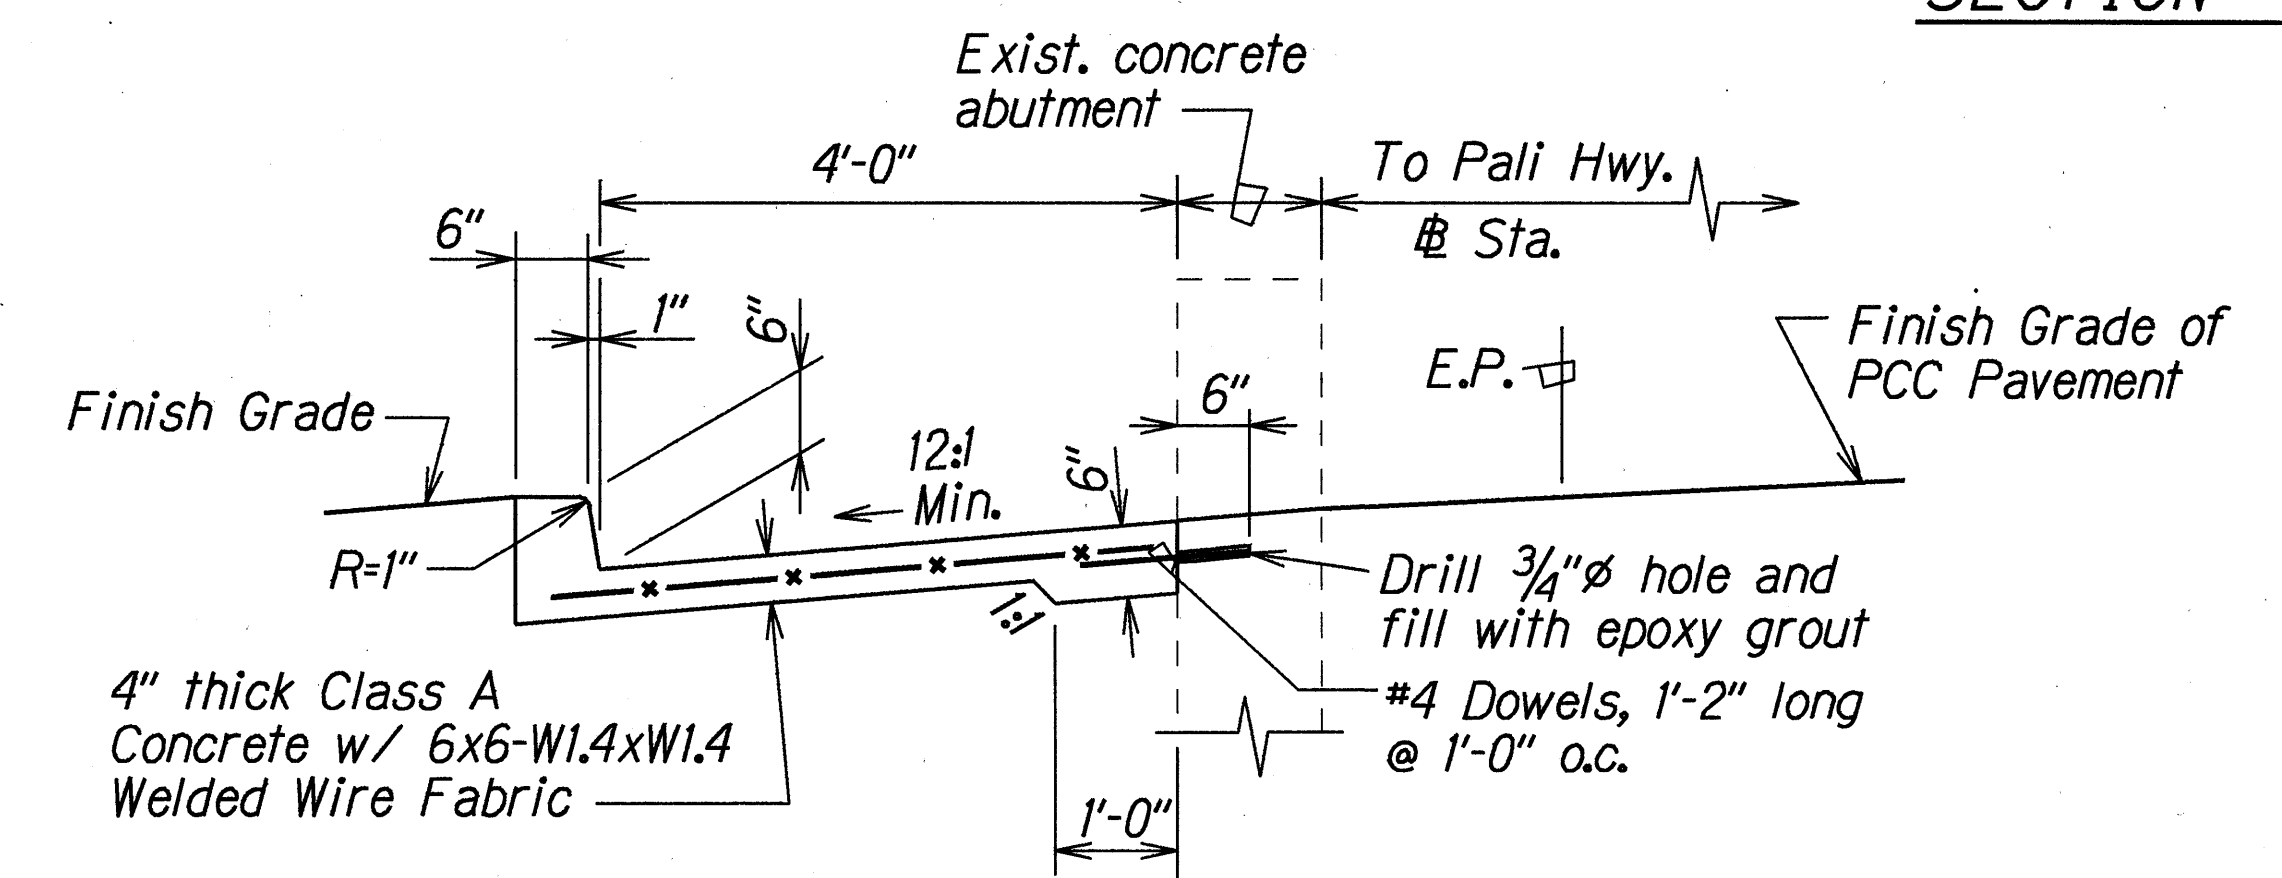

SECTION A
H20/H20

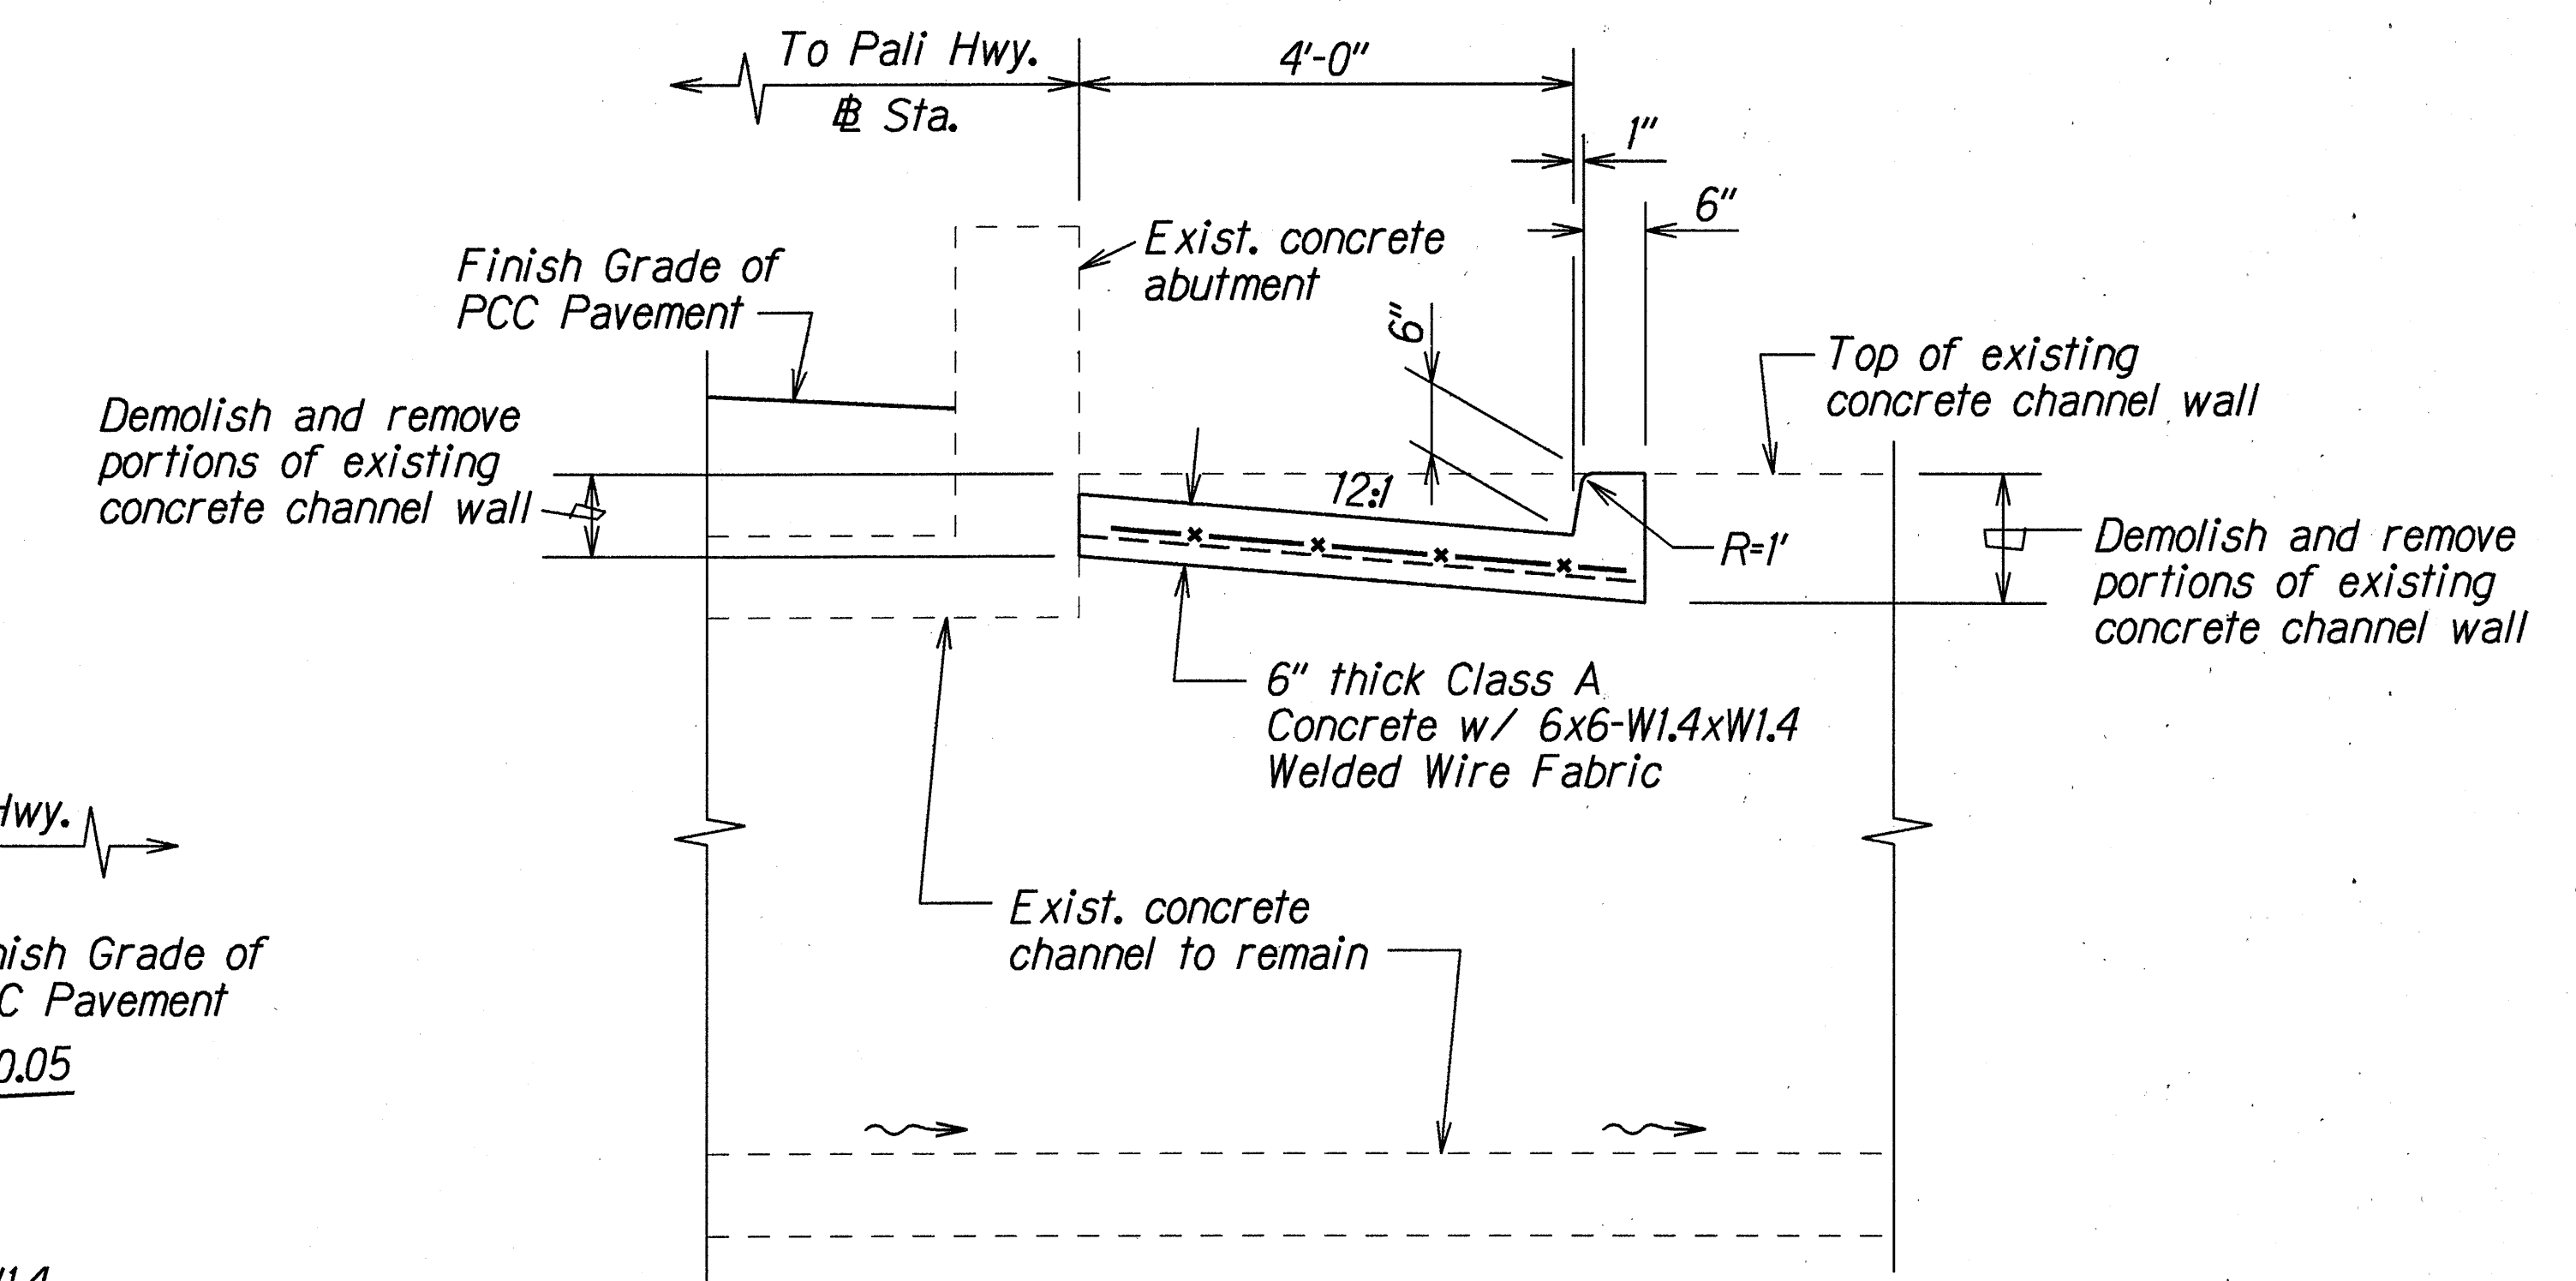

SECTION D
H20/H20

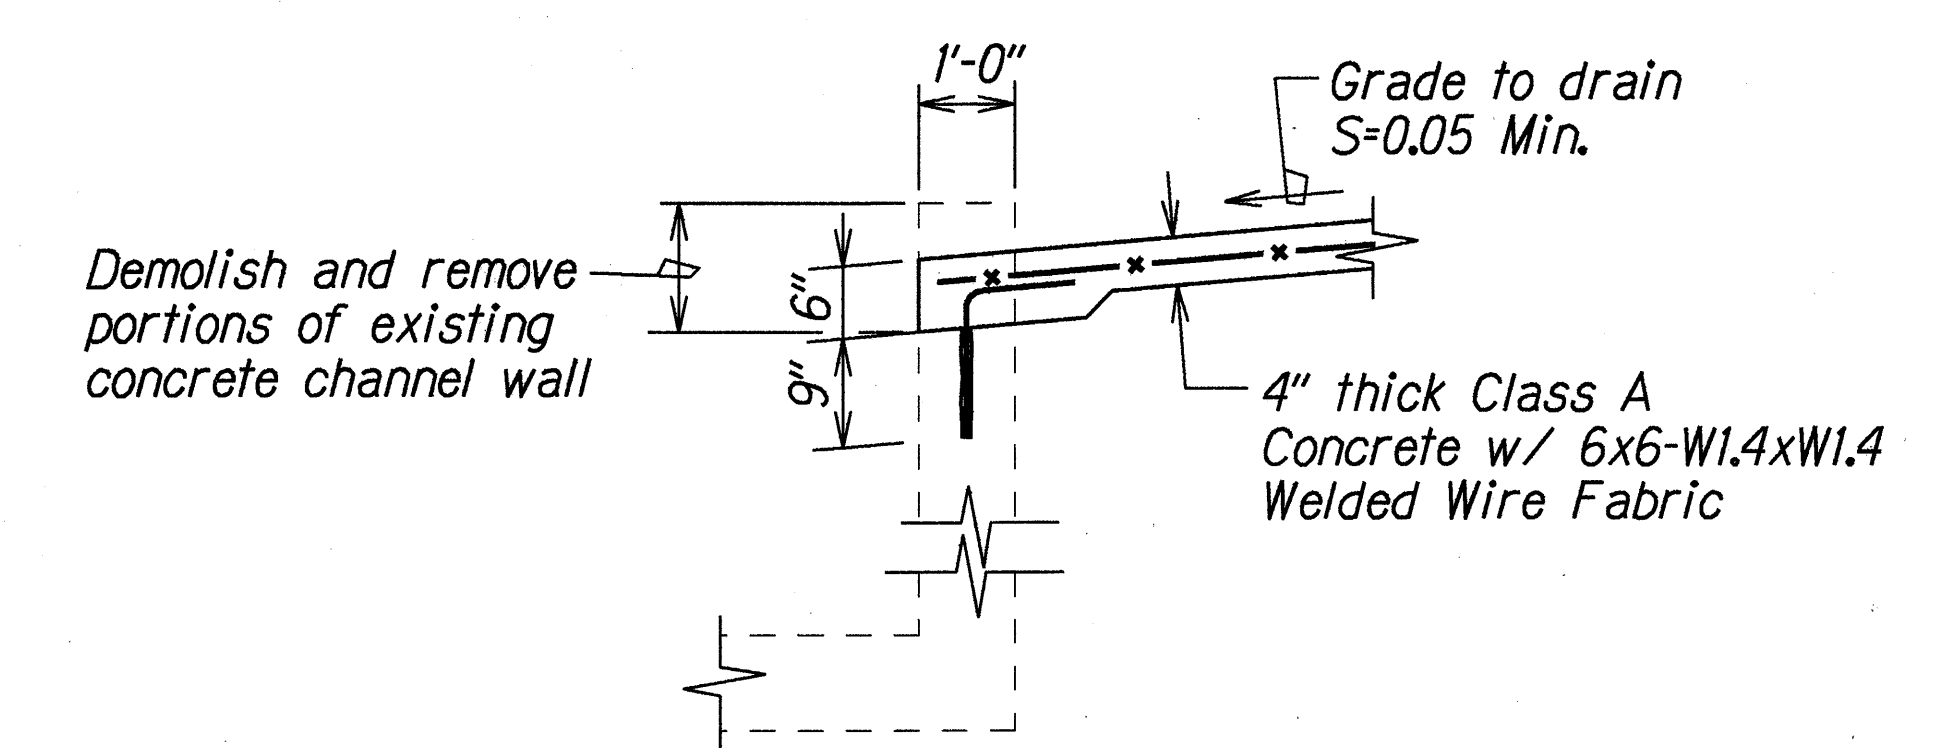

SECTION C
H20/H20

TYPICAL DETAILS OF TYPE "2" CONCRETE SPILLWAY

ORIGINAL PLAN	DATE
SURVEY PLOTTED BY	5/6/97
DRAWN BY	A. Noma
DESIGNED BY	C. Matsuda
CHECKED BY	dh22a/rhs/gh
DATE	5/6/97

STATE OF HAWAII
DEPARTMENT OF TRANSPORTATION
HIGHWAYS DIVISION



DRAINAGE DETAILS

PALI HIGHWAY RESURFACING
Country Club Rd. to Tunnel Entrance,
Including Both Rds. to Lookout
Project No. 61A-01-97M

Scale: 3/4"=1'-0" Date: May 1997

SHEET No. H20 OF 24 SHEETS

FED. ROAD DIST. NO.	STATE	FED. AID PROJ. NO.	FISCAL YEAR	SHEET NO.	TOTAL SHEETS
HAWAII	HAW.	61A-01-97M	1997	61	84

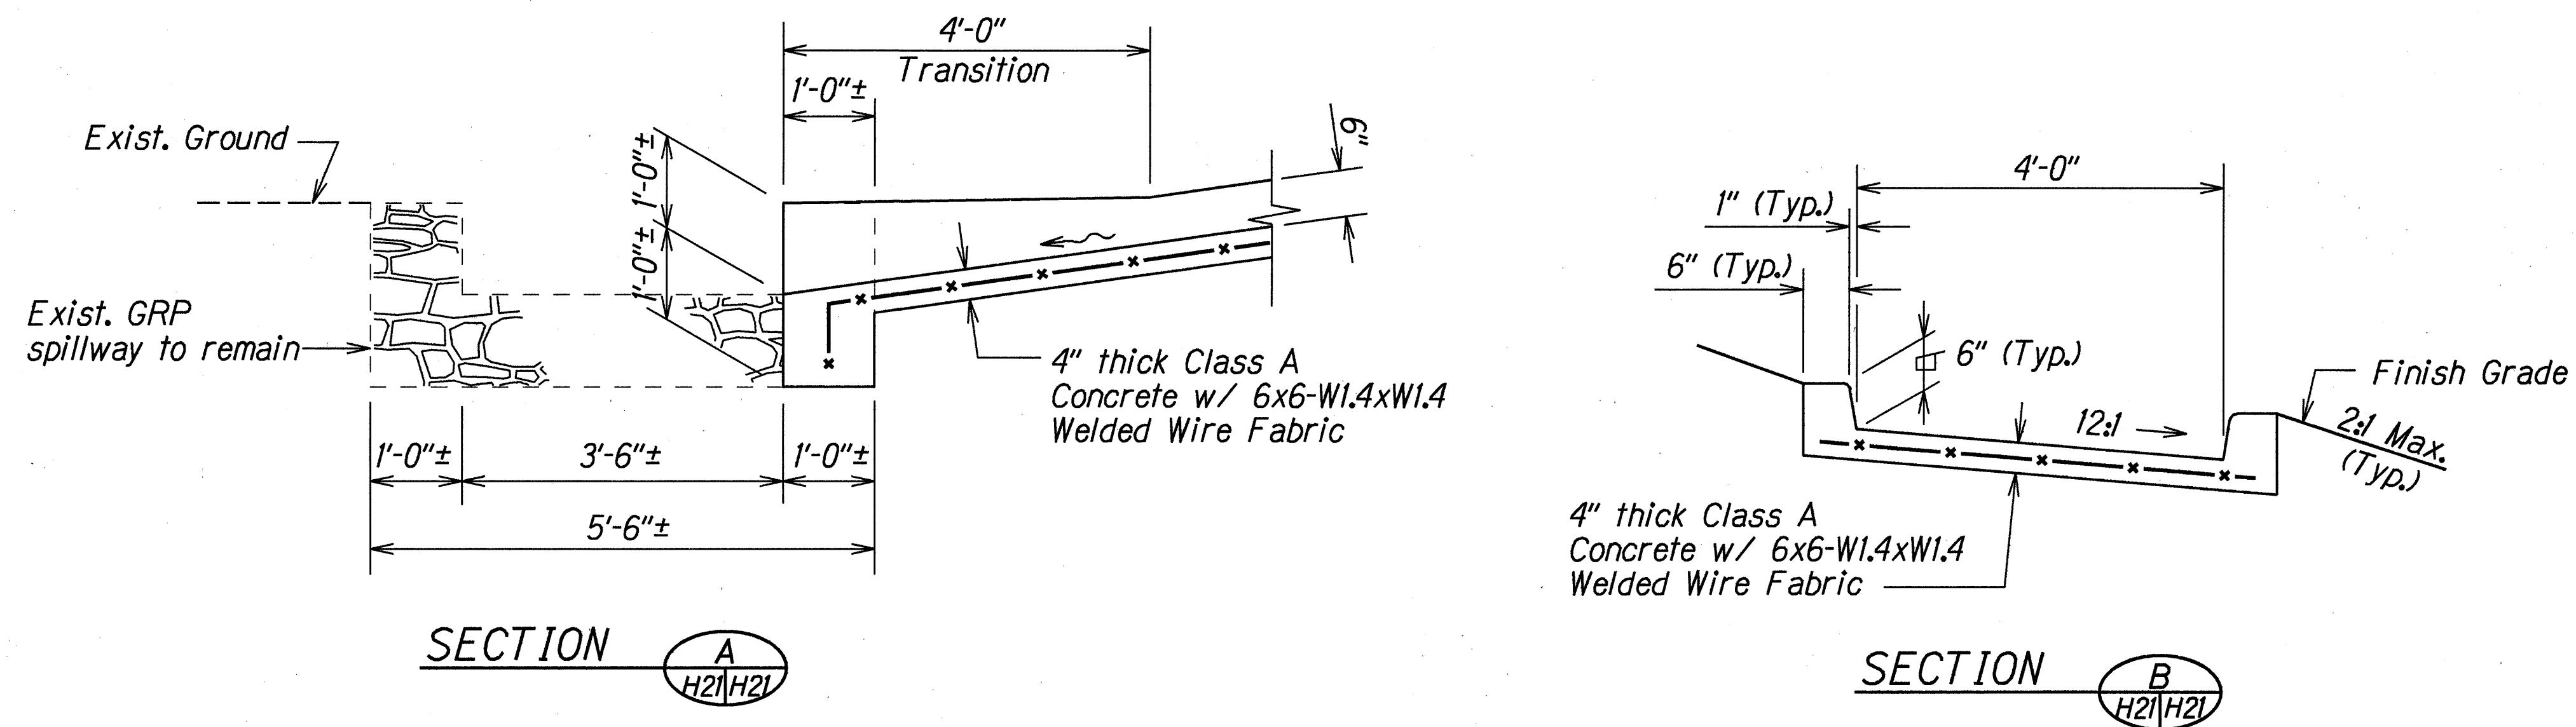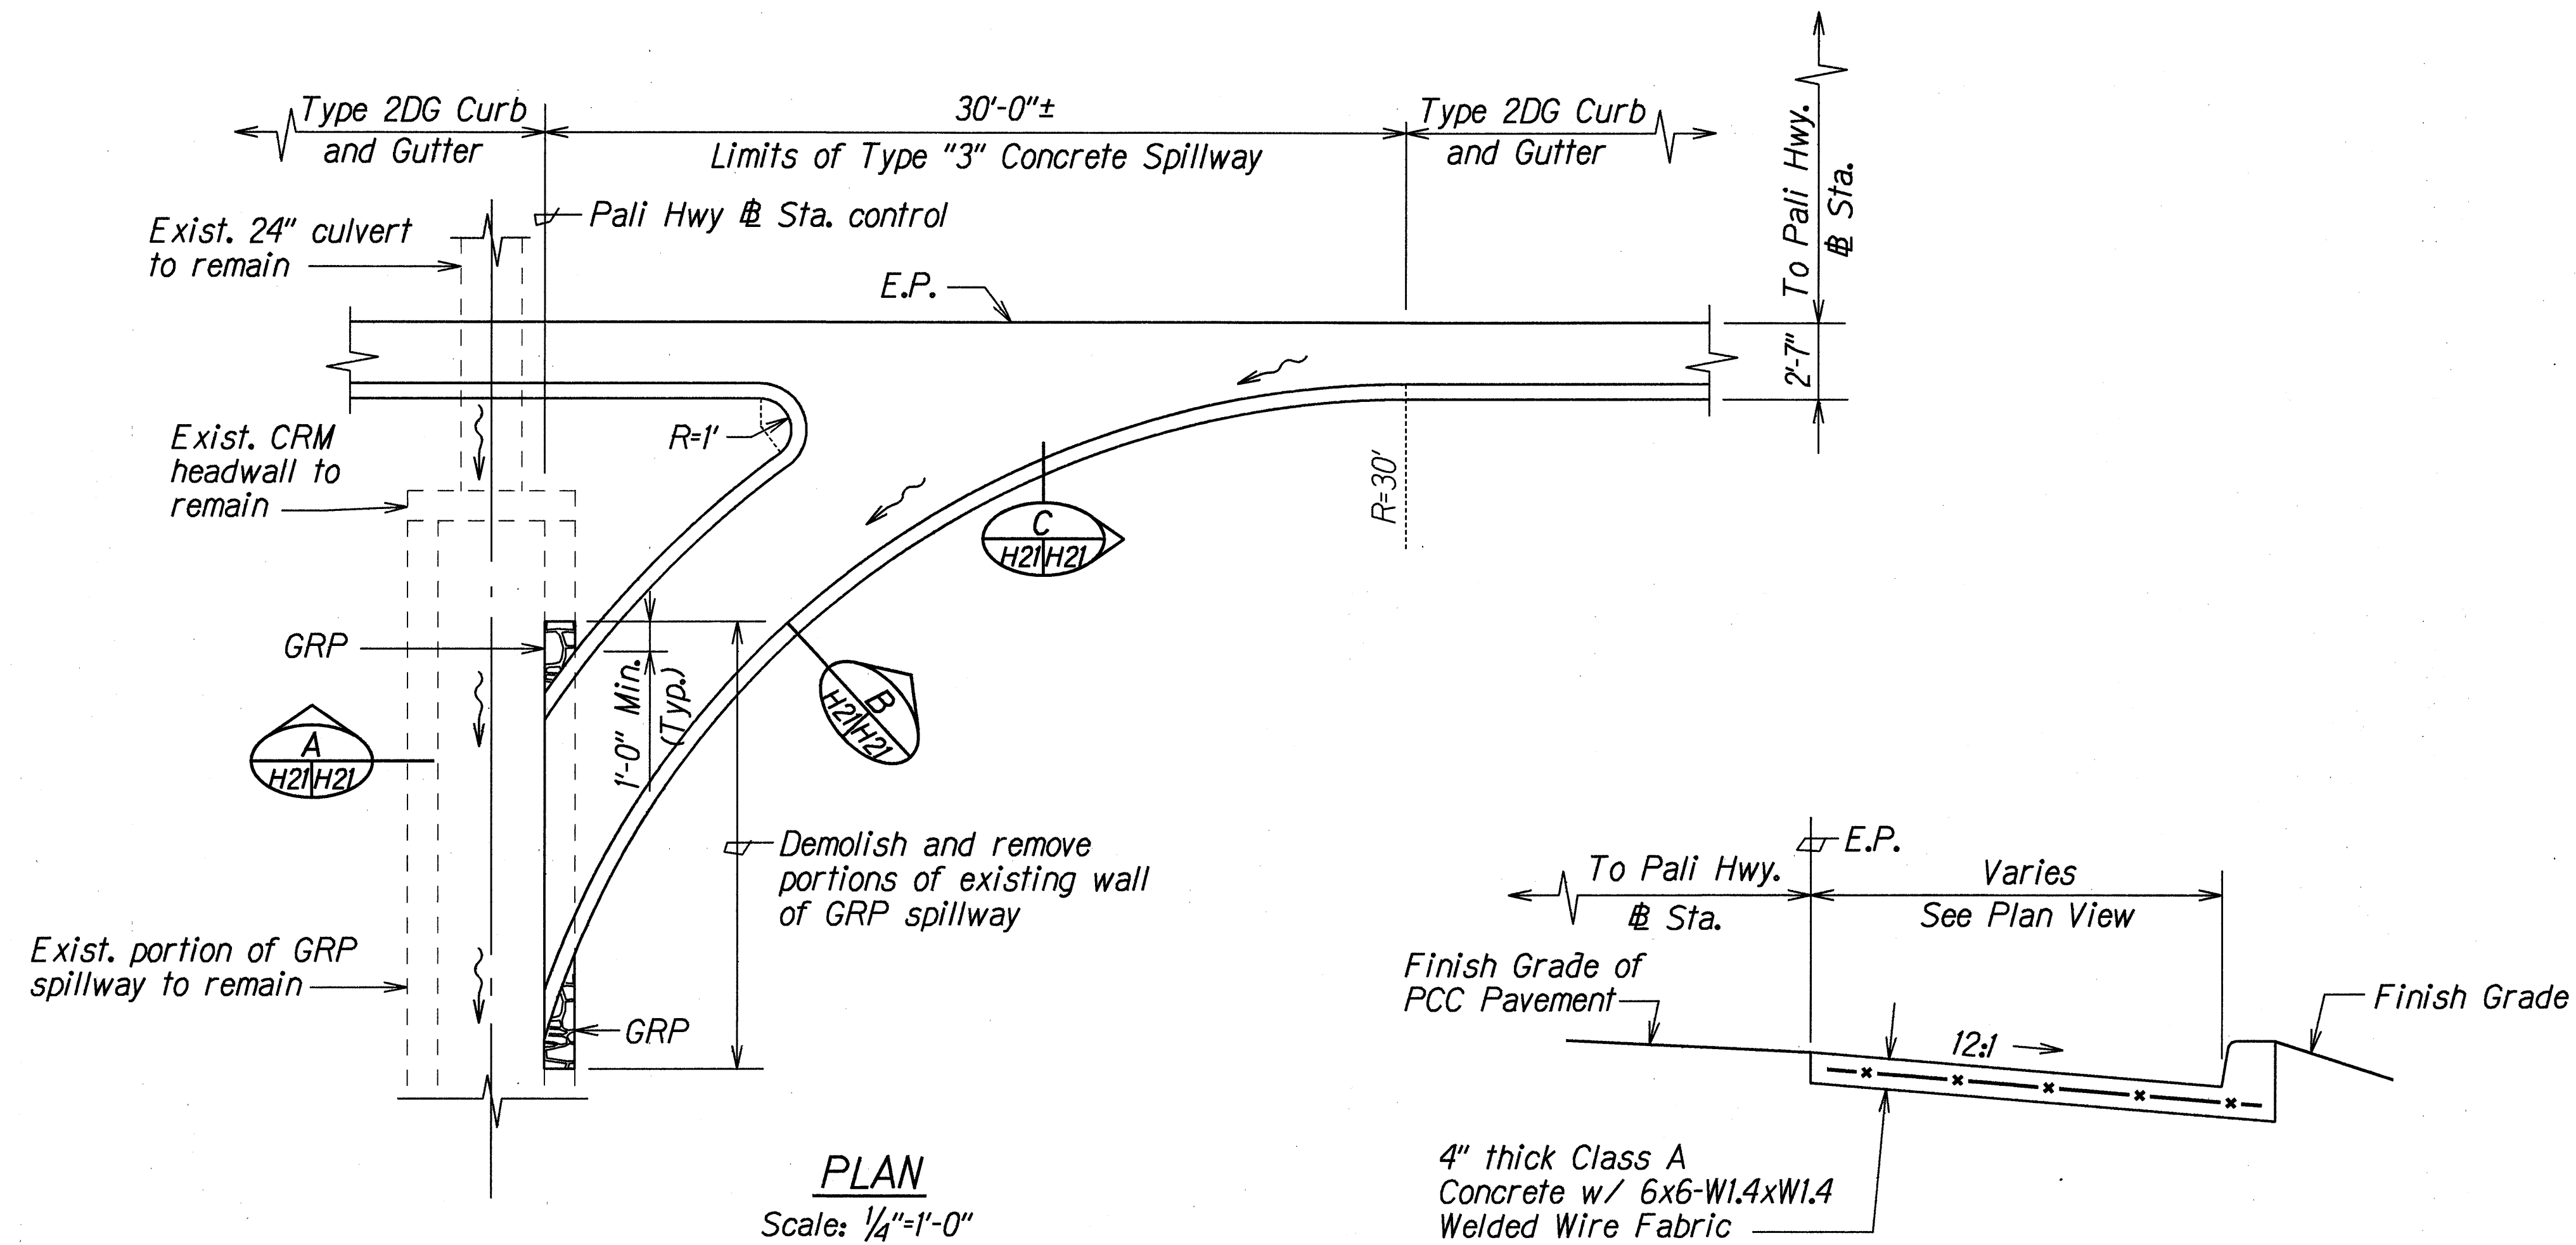

TYPICAL DETAILS OF TYPE "3" CONCRETE SPILLWAY

STATE OF HAWAII
DEPARTMENT OF TRANSPORTATION
HIGHWAYS DIVISION


DRAINAGE DETAILS

PALI HIGHWAY RESURFACING
Country Club Rd. to Tunnel Entrance,
Including Both Rds. to Lookout
Project No. 61A-01-97M


Scale: 3/4"=1'-0" Date: May 1997

SHEET No. H21 OF 24 SHEETS


FED. ROAD DIST. NO.	STATE	FED. AID PROJ. NO.	FISCAL YEAR	SHEET NO.	TOTAL SHEETS
HAWAII	HAW.	61A-01-97M	1997	62	84

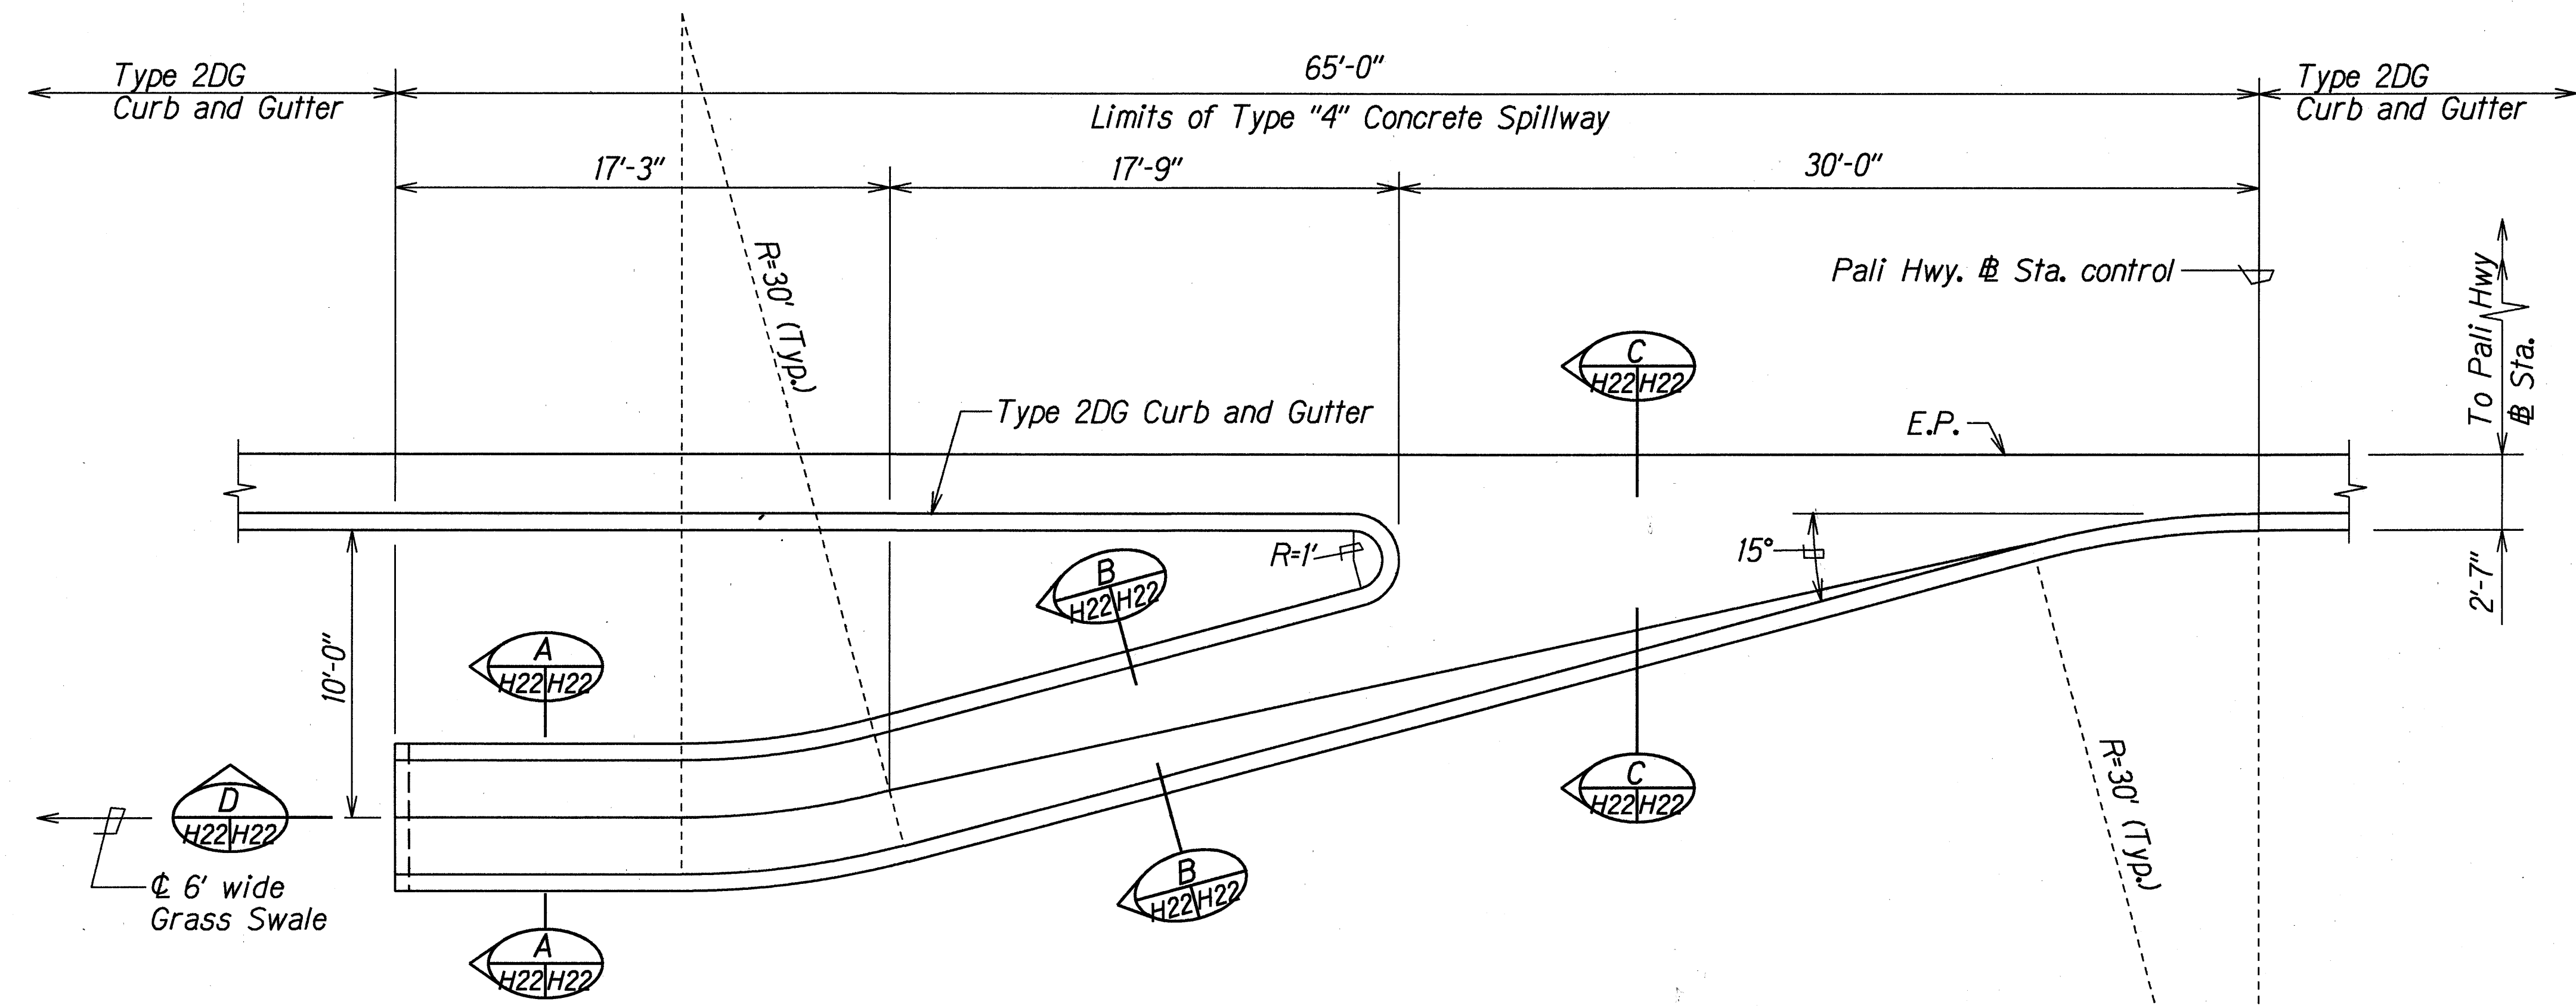


PLAN
Scale: 1/4" = 1'-0"

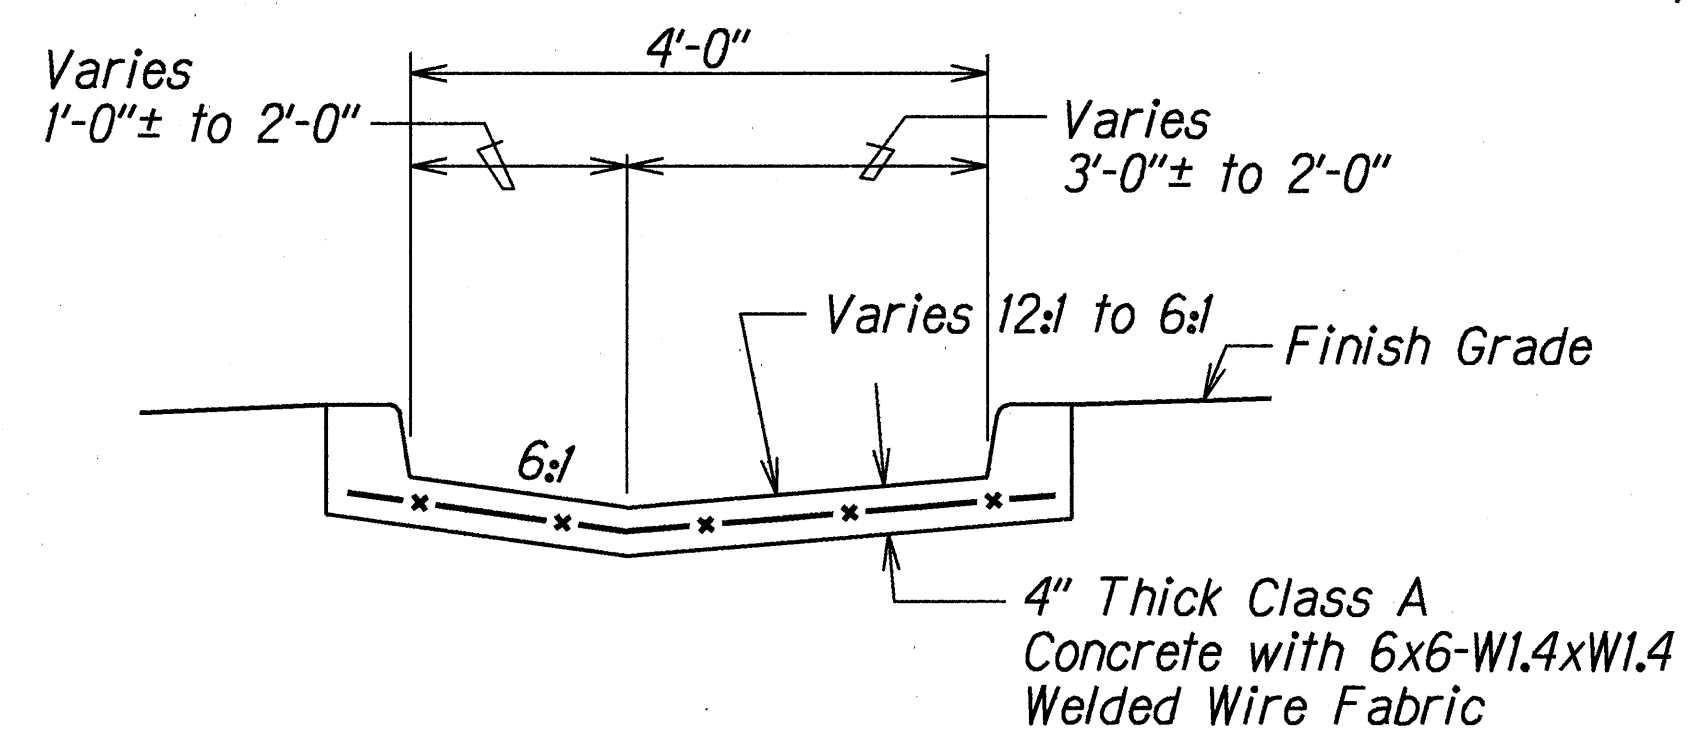


SECTION B
Scale: 3/4" = 1'-0"

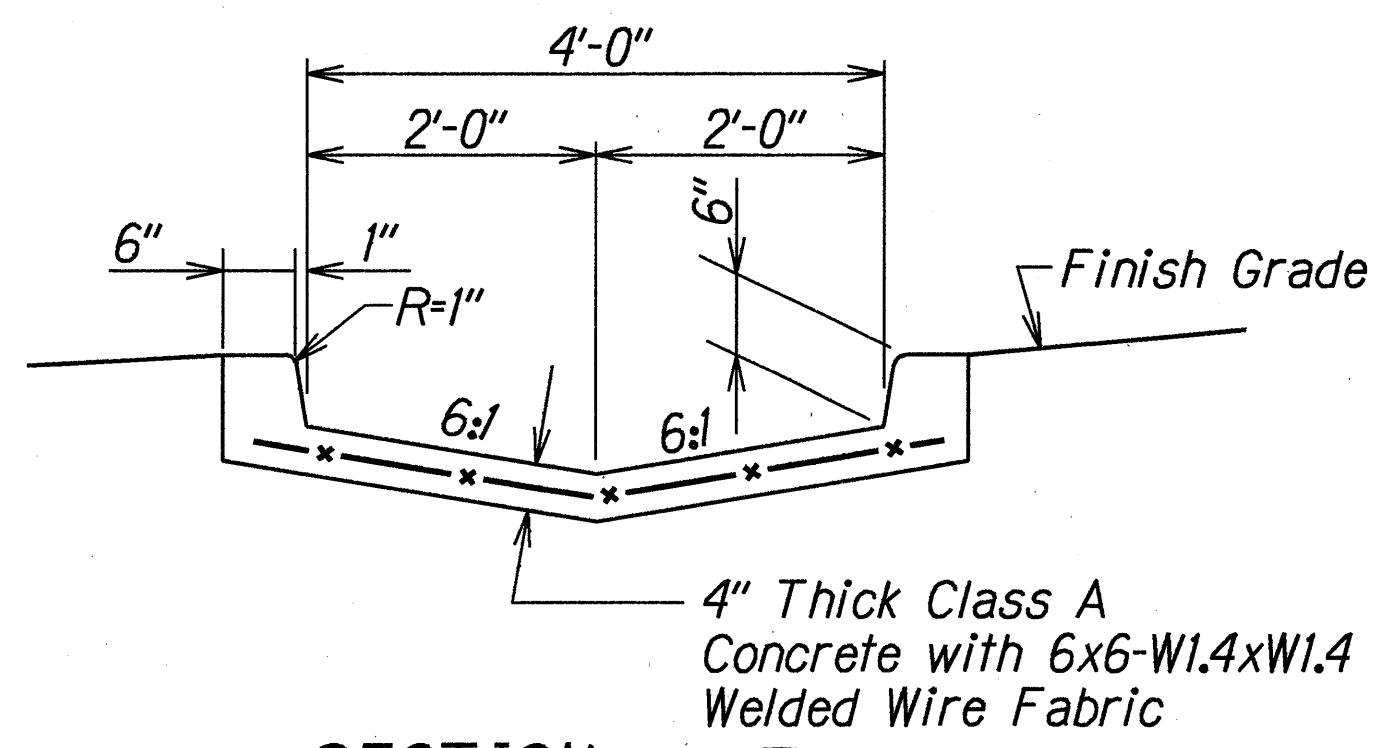

SECTION A
Scale: 3/4" = 1'-0"

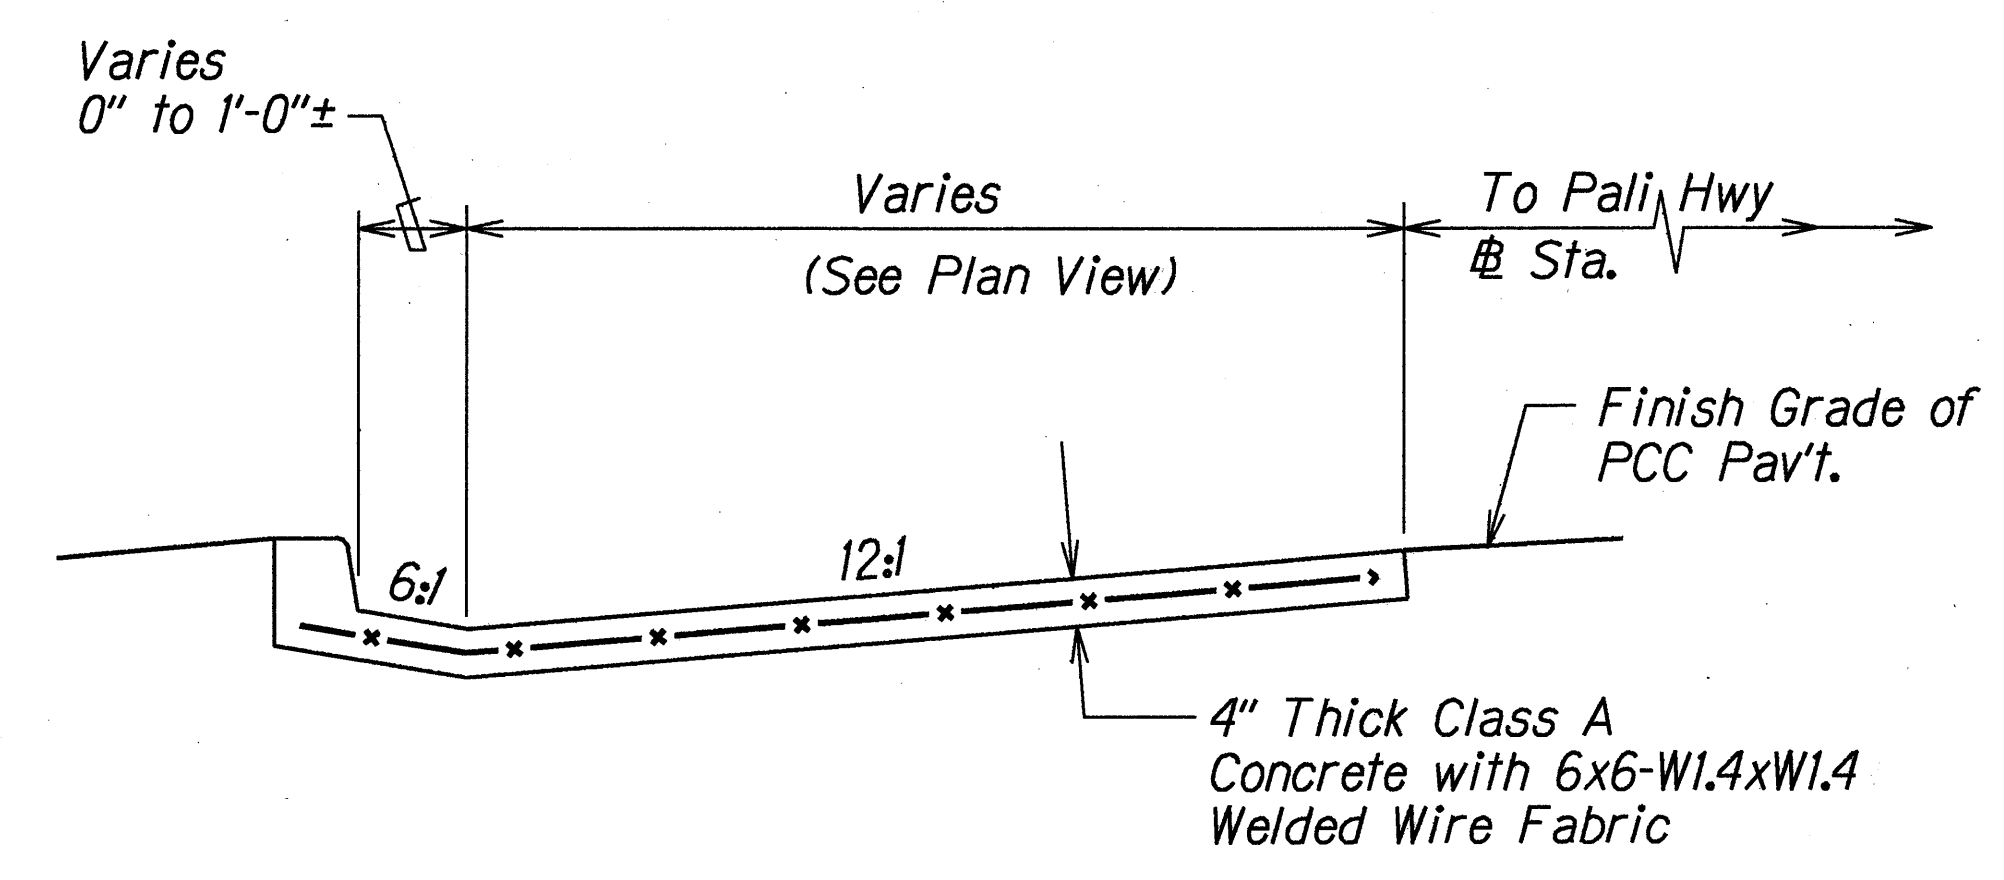

SECTION C
Scale: 3/4" = 1'-0"

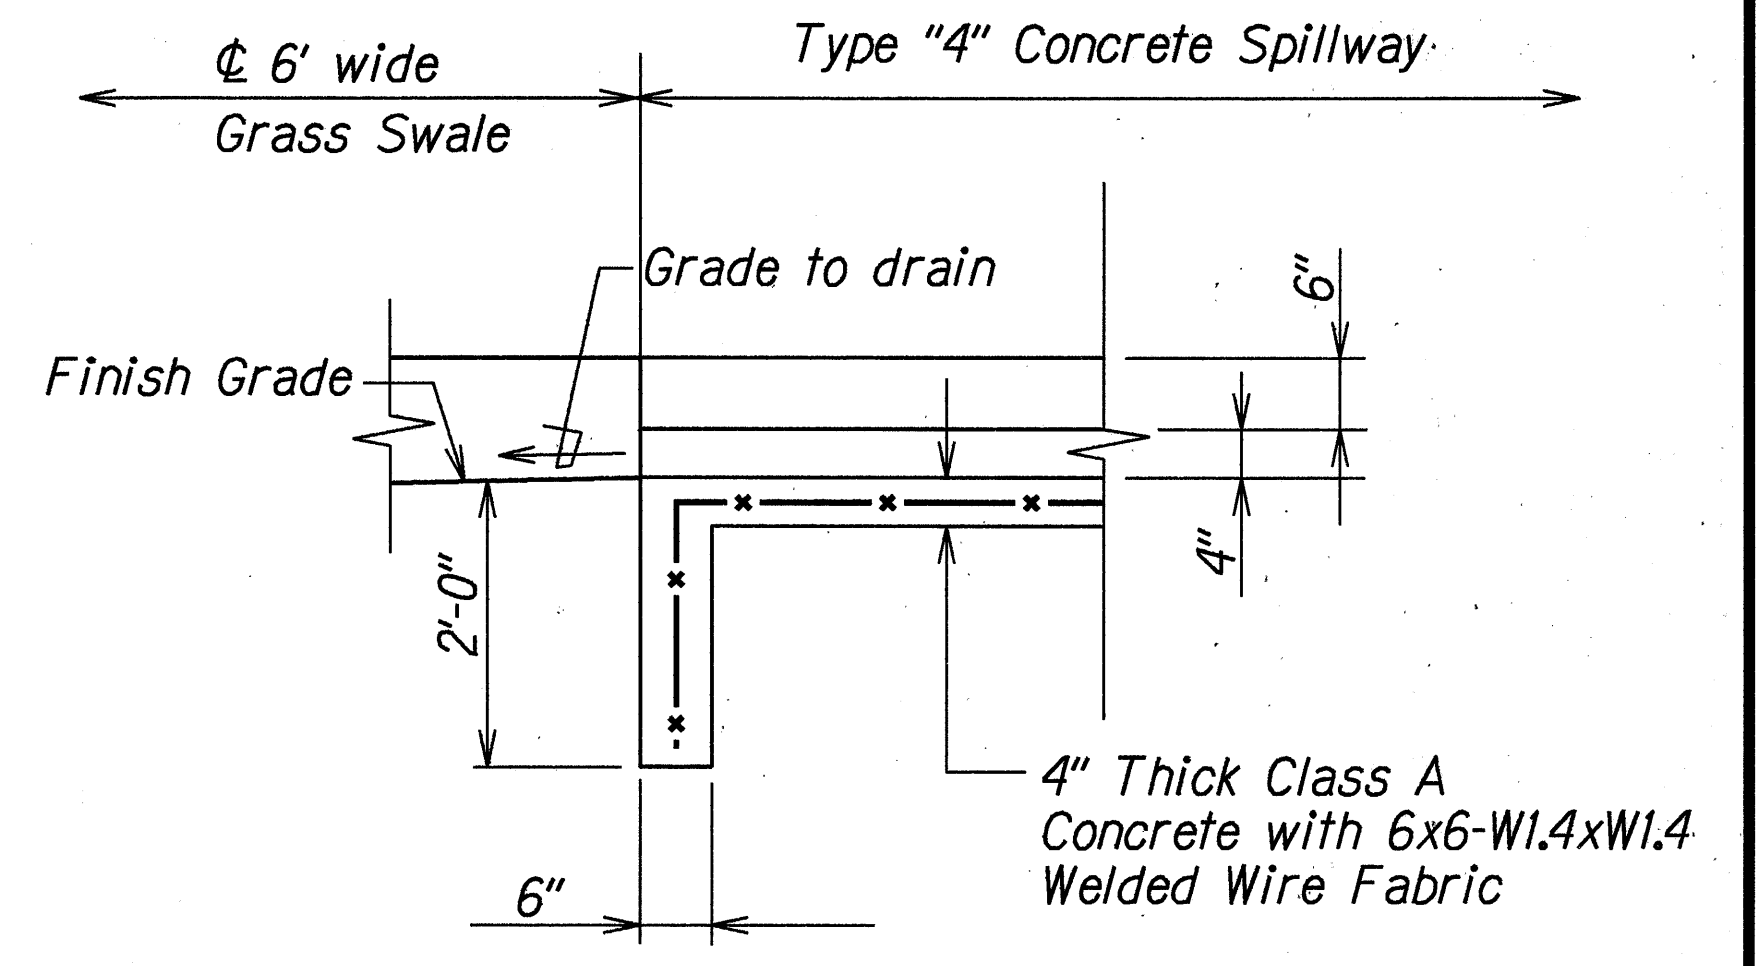

SECTION D
Scale: 3/4" = 1'-0"

DETAILS OF TYPE "4" CONCRETE SPILLWAY

ORIGINAL PLAN	DATE	4/19/97
SURVEY PLOTTED BY		
DRAWN BY		
TRACED BY		
NOTED BY		
CHECKED BY		

STATE OF HAWAII
DEPARTMENT OF TRANSPORTATION
HIGHWAYS DIVISION


DRAINAGE DETAILS

PALI HIGHWAY RESURFACING
Country Club Rd. to Tunnel Entrance,
Including Both Rds. to Lookout
Project No. 61A-01-97M


Scale: As Noted Date: May 1997

SHEET No. H22 OF 24 SHEETS

FED. ROAD DIST. NO.	STATE	FED. AID PROJ. NO.	FISCAL YEAR	SHEET NO.	TOTAL SHEETS
HAWAII	HAW.	61A-01-97M	1997	63	84

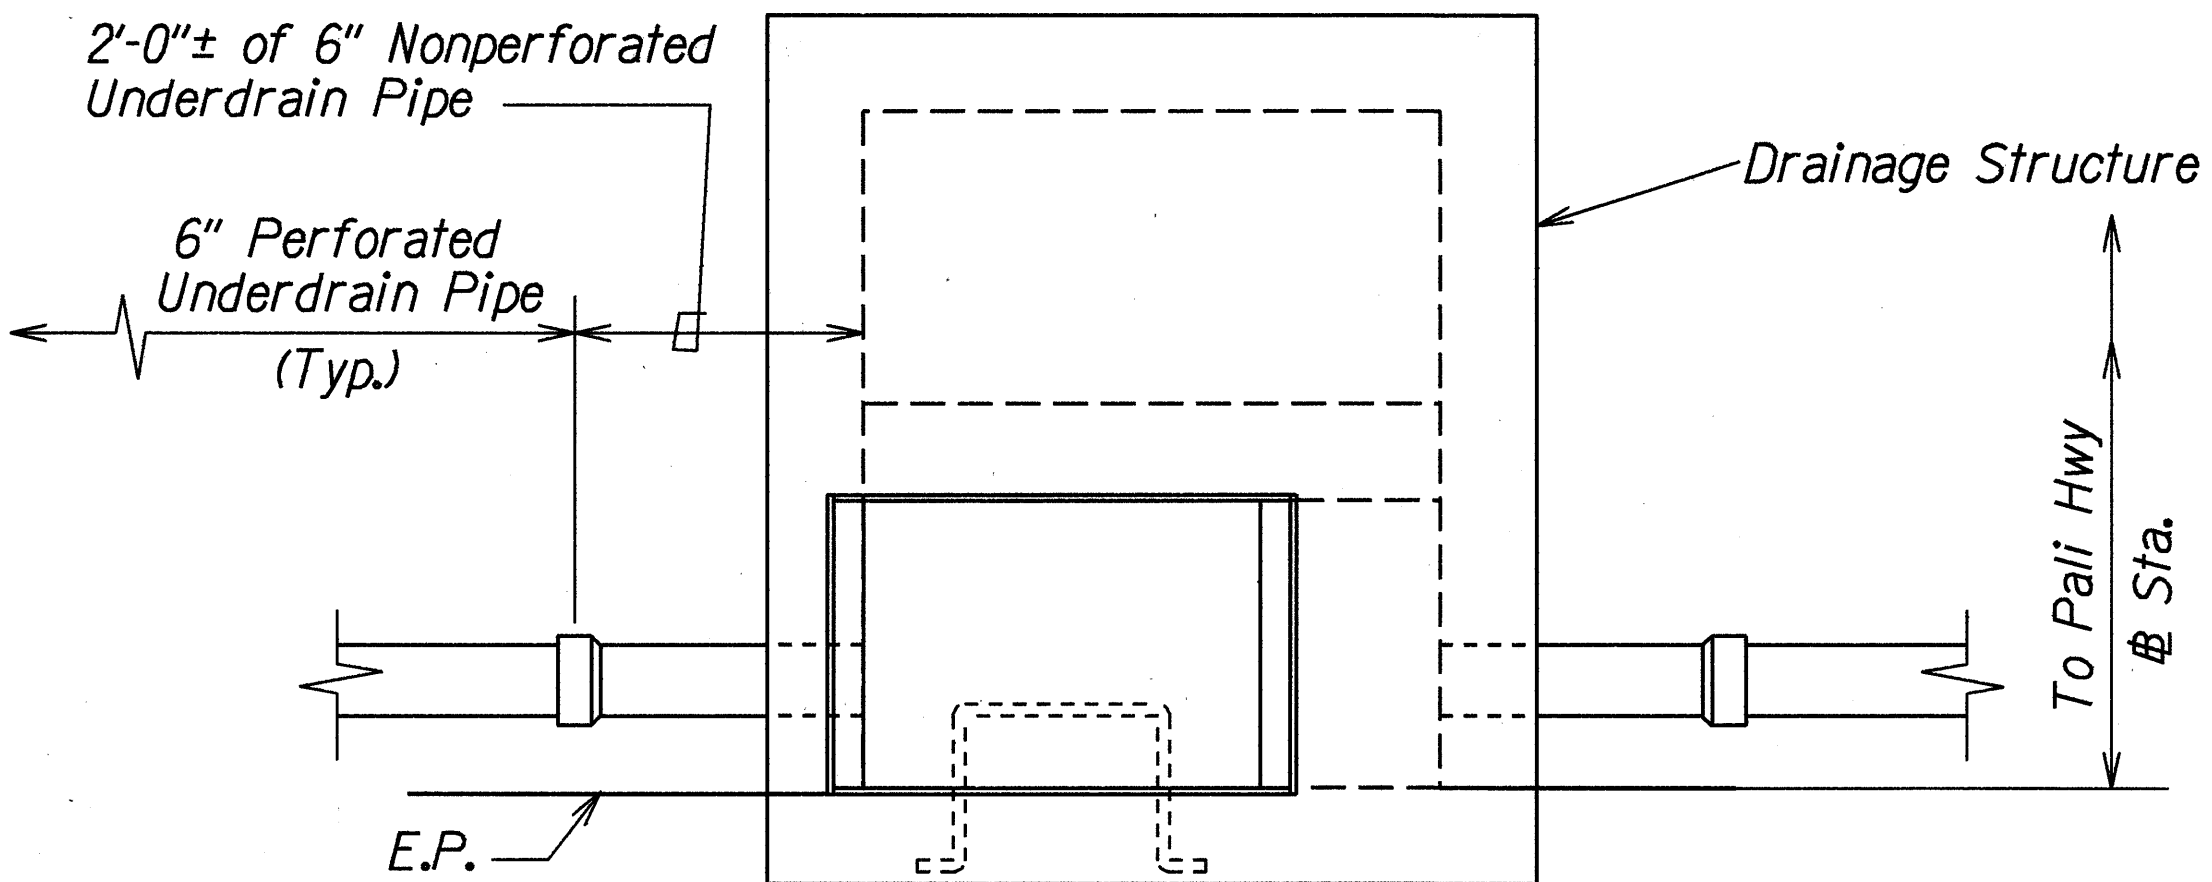


PLAN

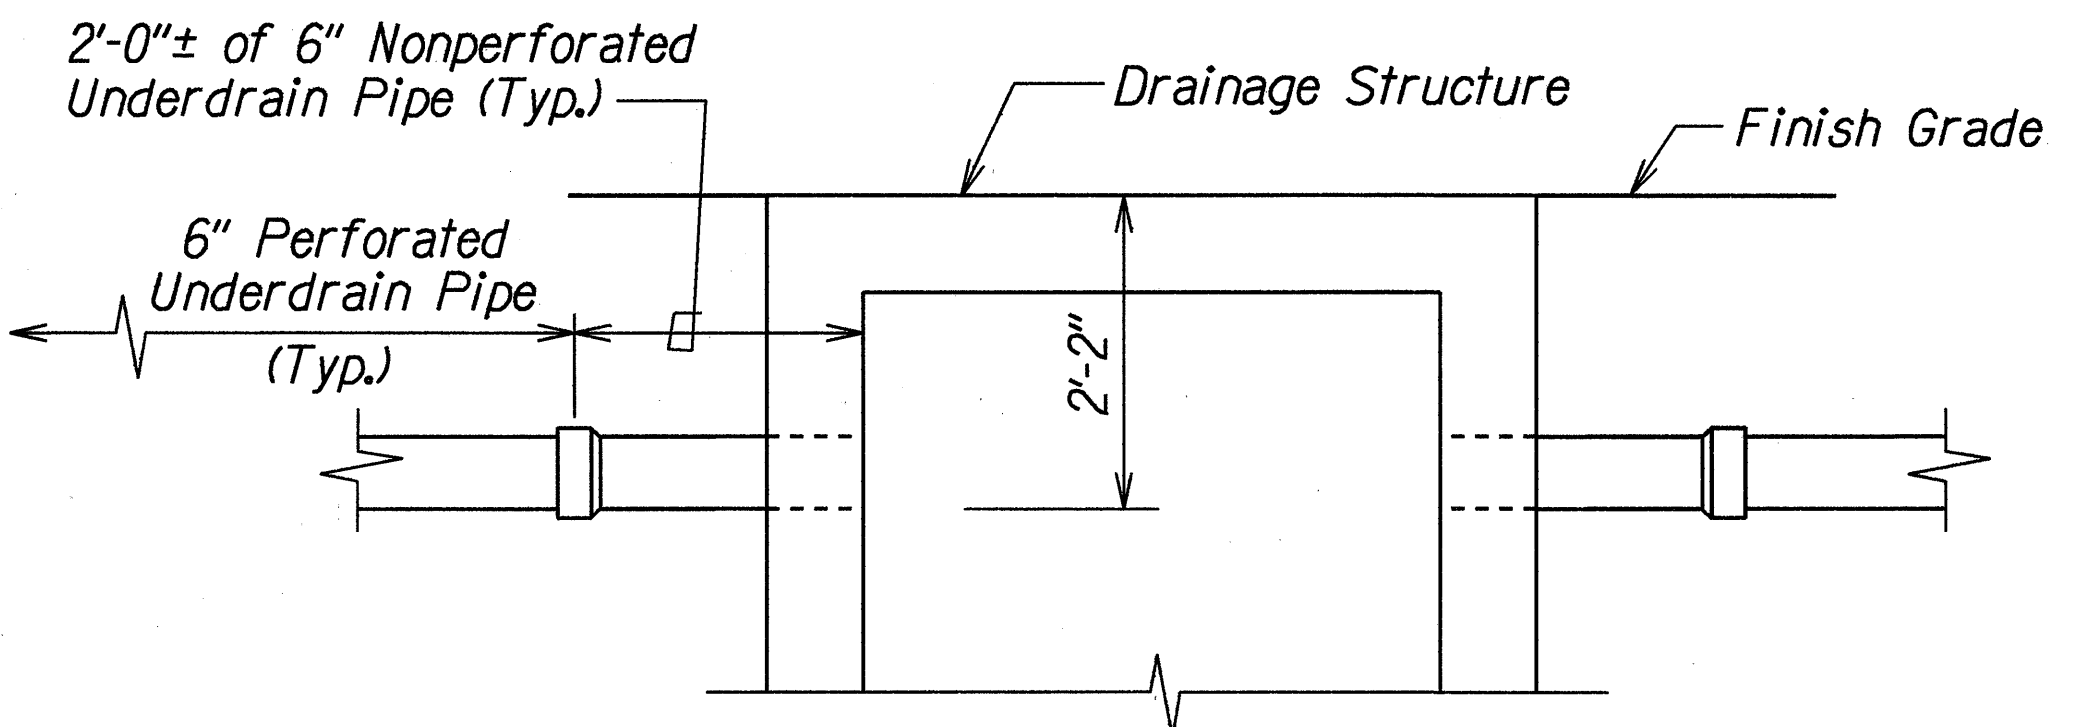

ELEVATION


TYPICAL DETAILS OF 6" UNDERDRAIN CONNECTION TO NEW DRAINAGE STRUCTURES

Scale: 3/4"=1'-0"

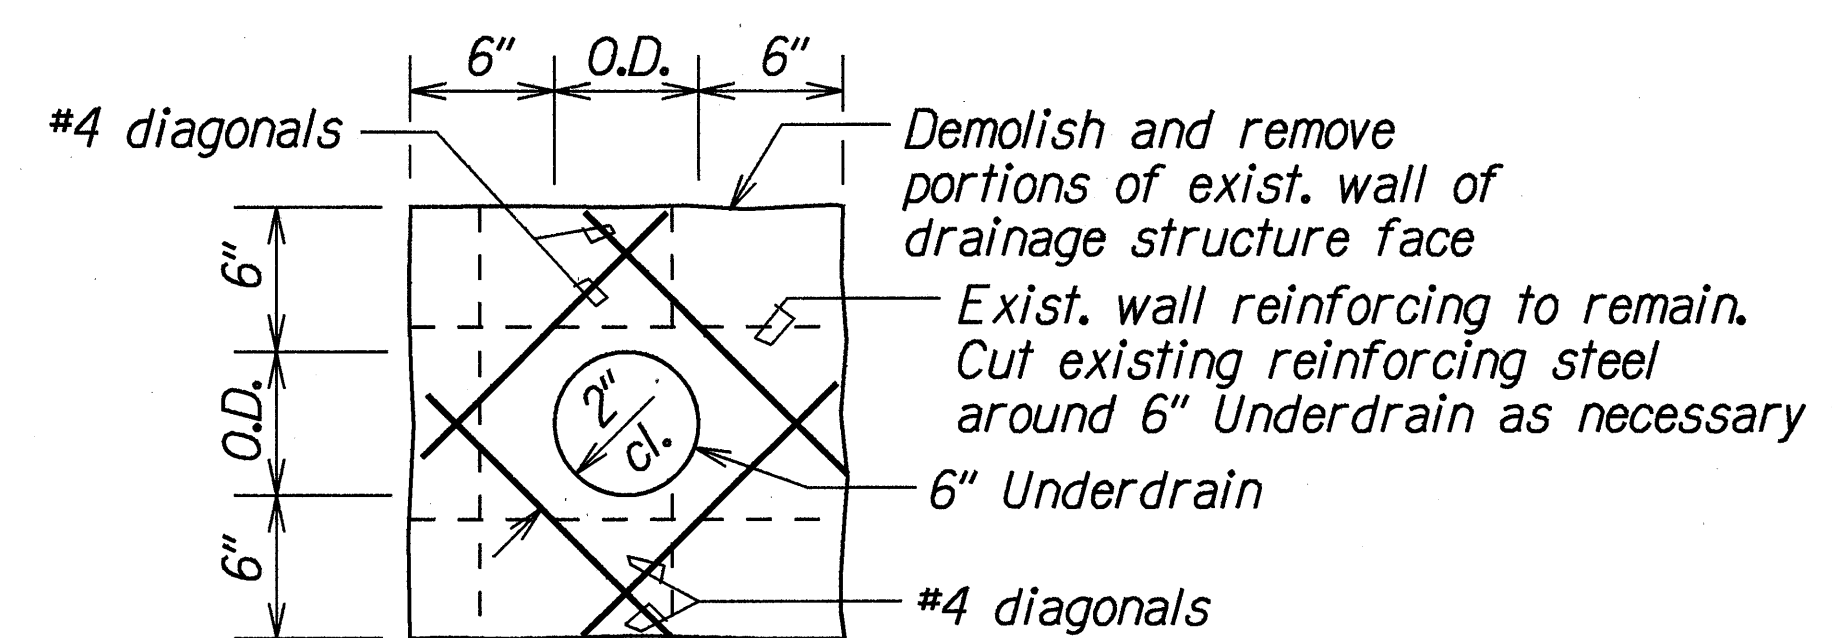


TYPICAL SECTION OF 6" UNDERDRAIN CONNECTION TO EXISTING DRAINAGE STRUCTURE

Scale: 1 1/2"=1'-0"

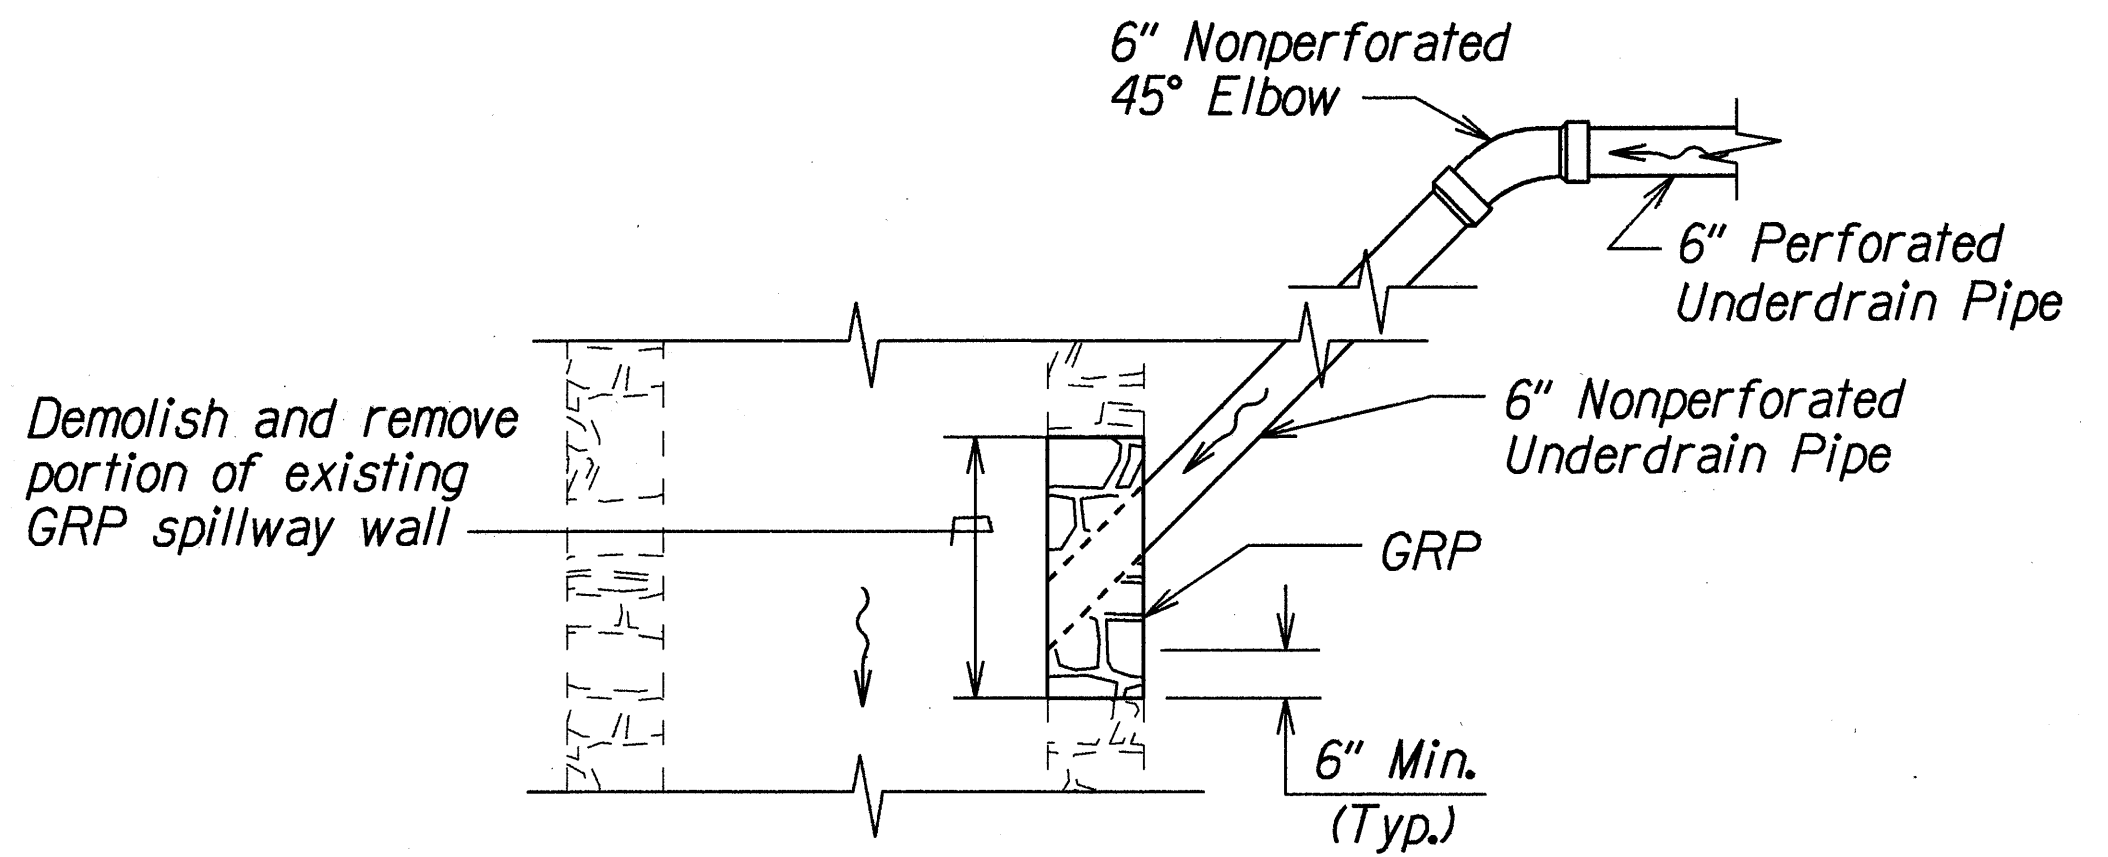


PLAN

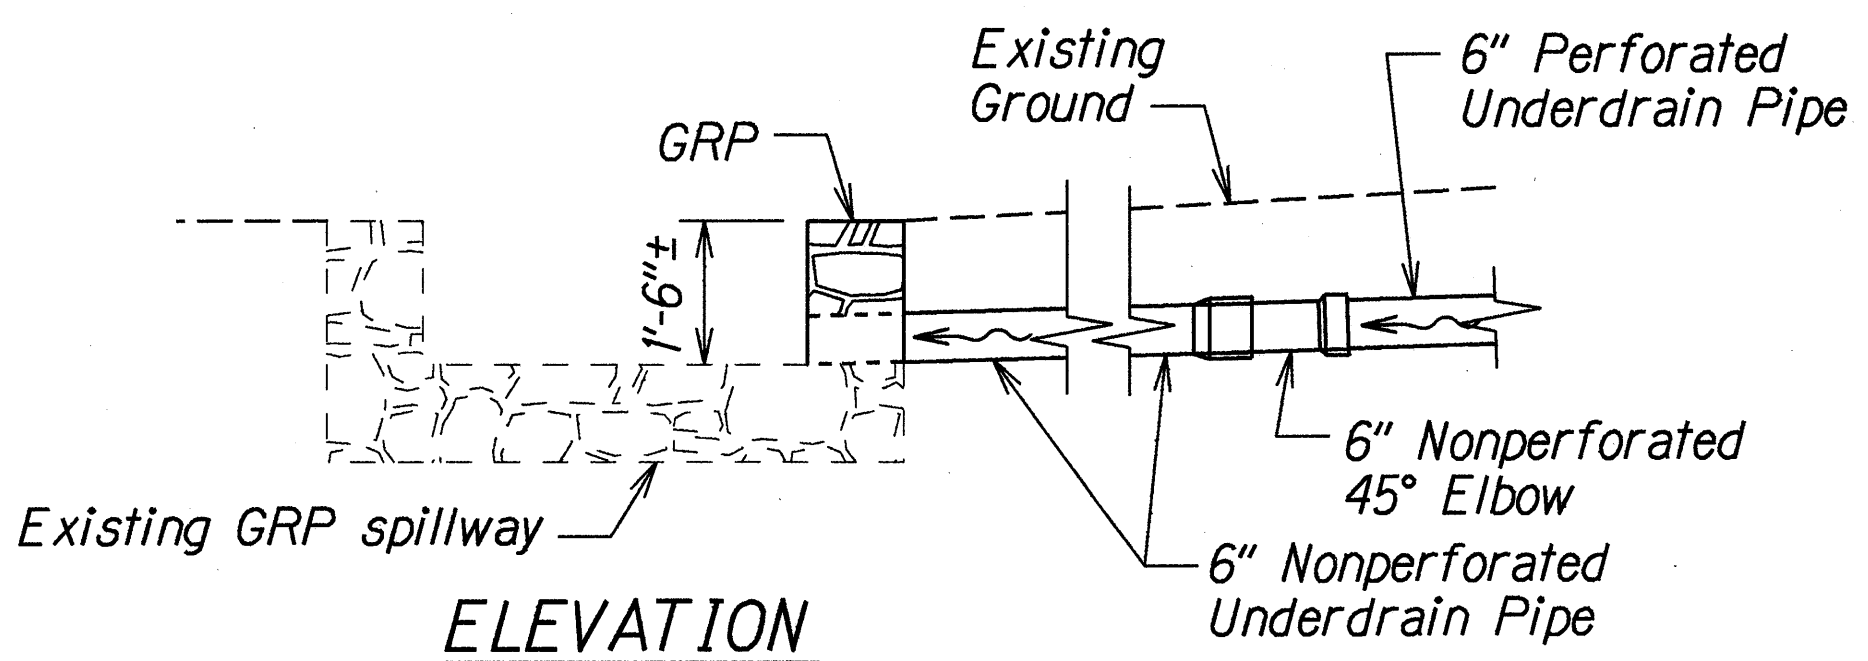

ELEVATION


TYPICAL DETAILS OF 6" UNDERDRAIN CONNECTION TO EXISTING GRP SPILLWAY

Scale: 1/2"=1'-0"

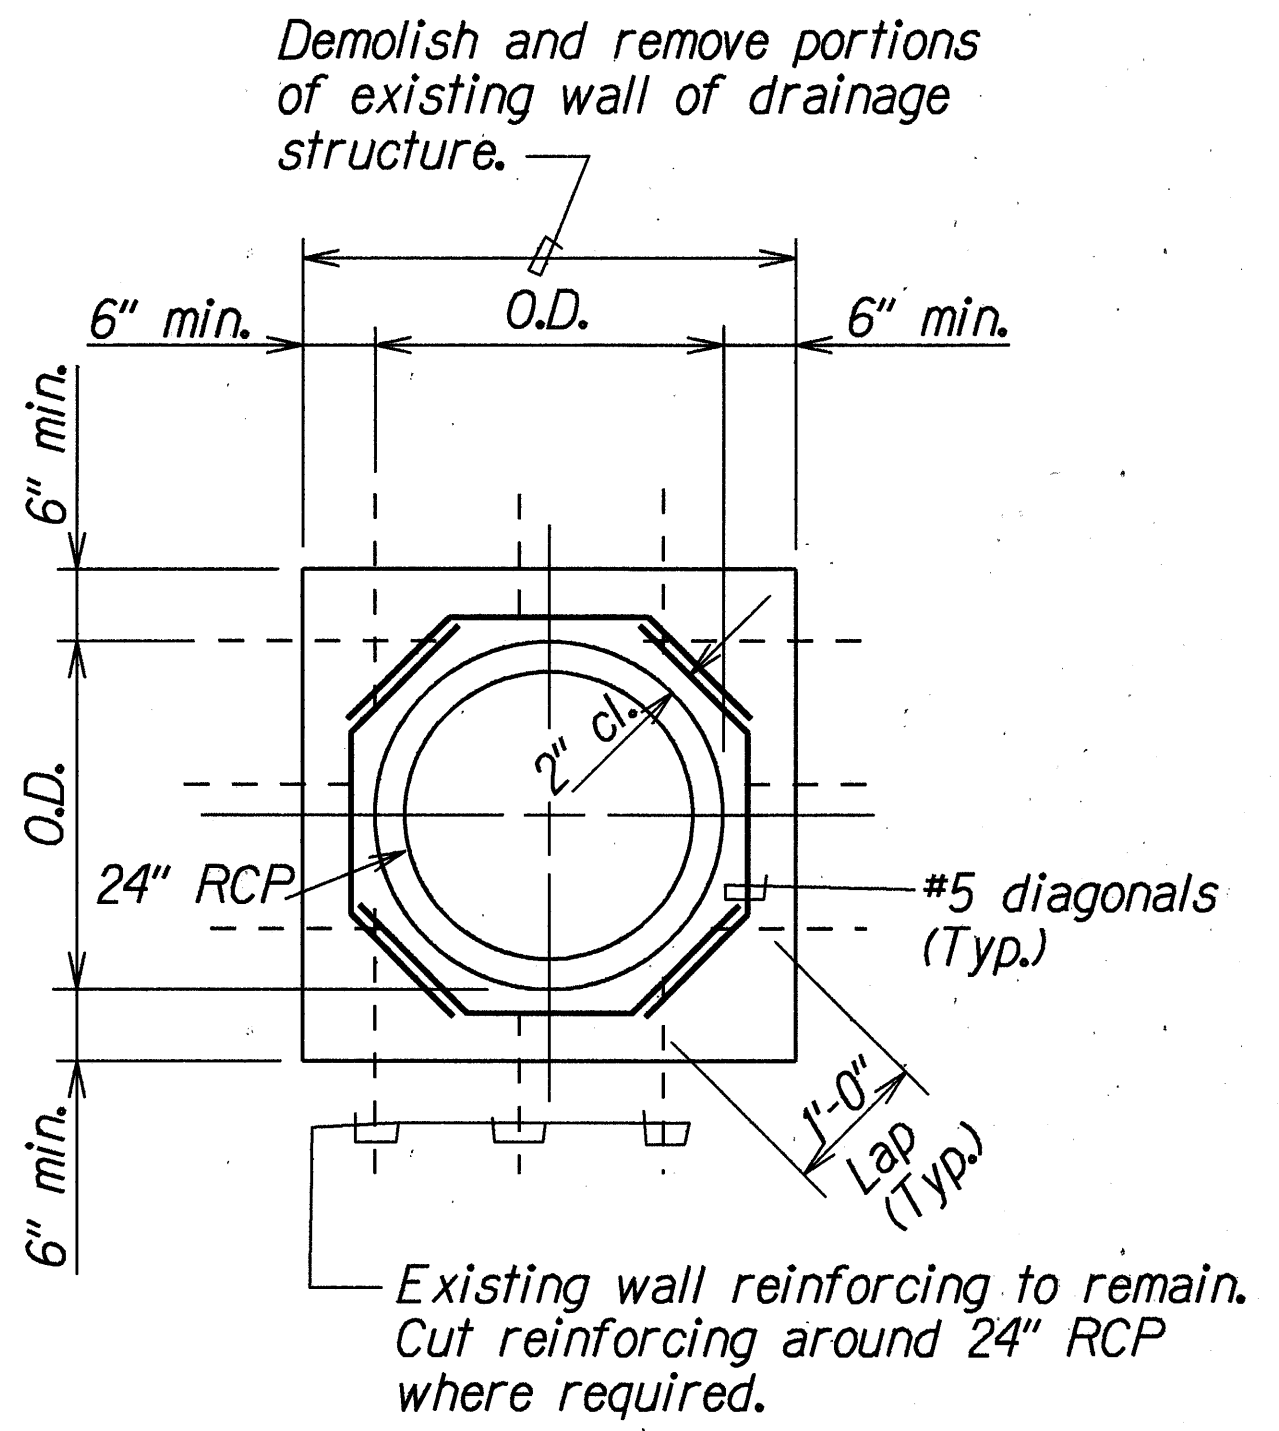


TYPICAL SECTION OF 24" RCP CONNECTION TO EXISTING STRUCTURE

Scale: 3/4"=1'-0"

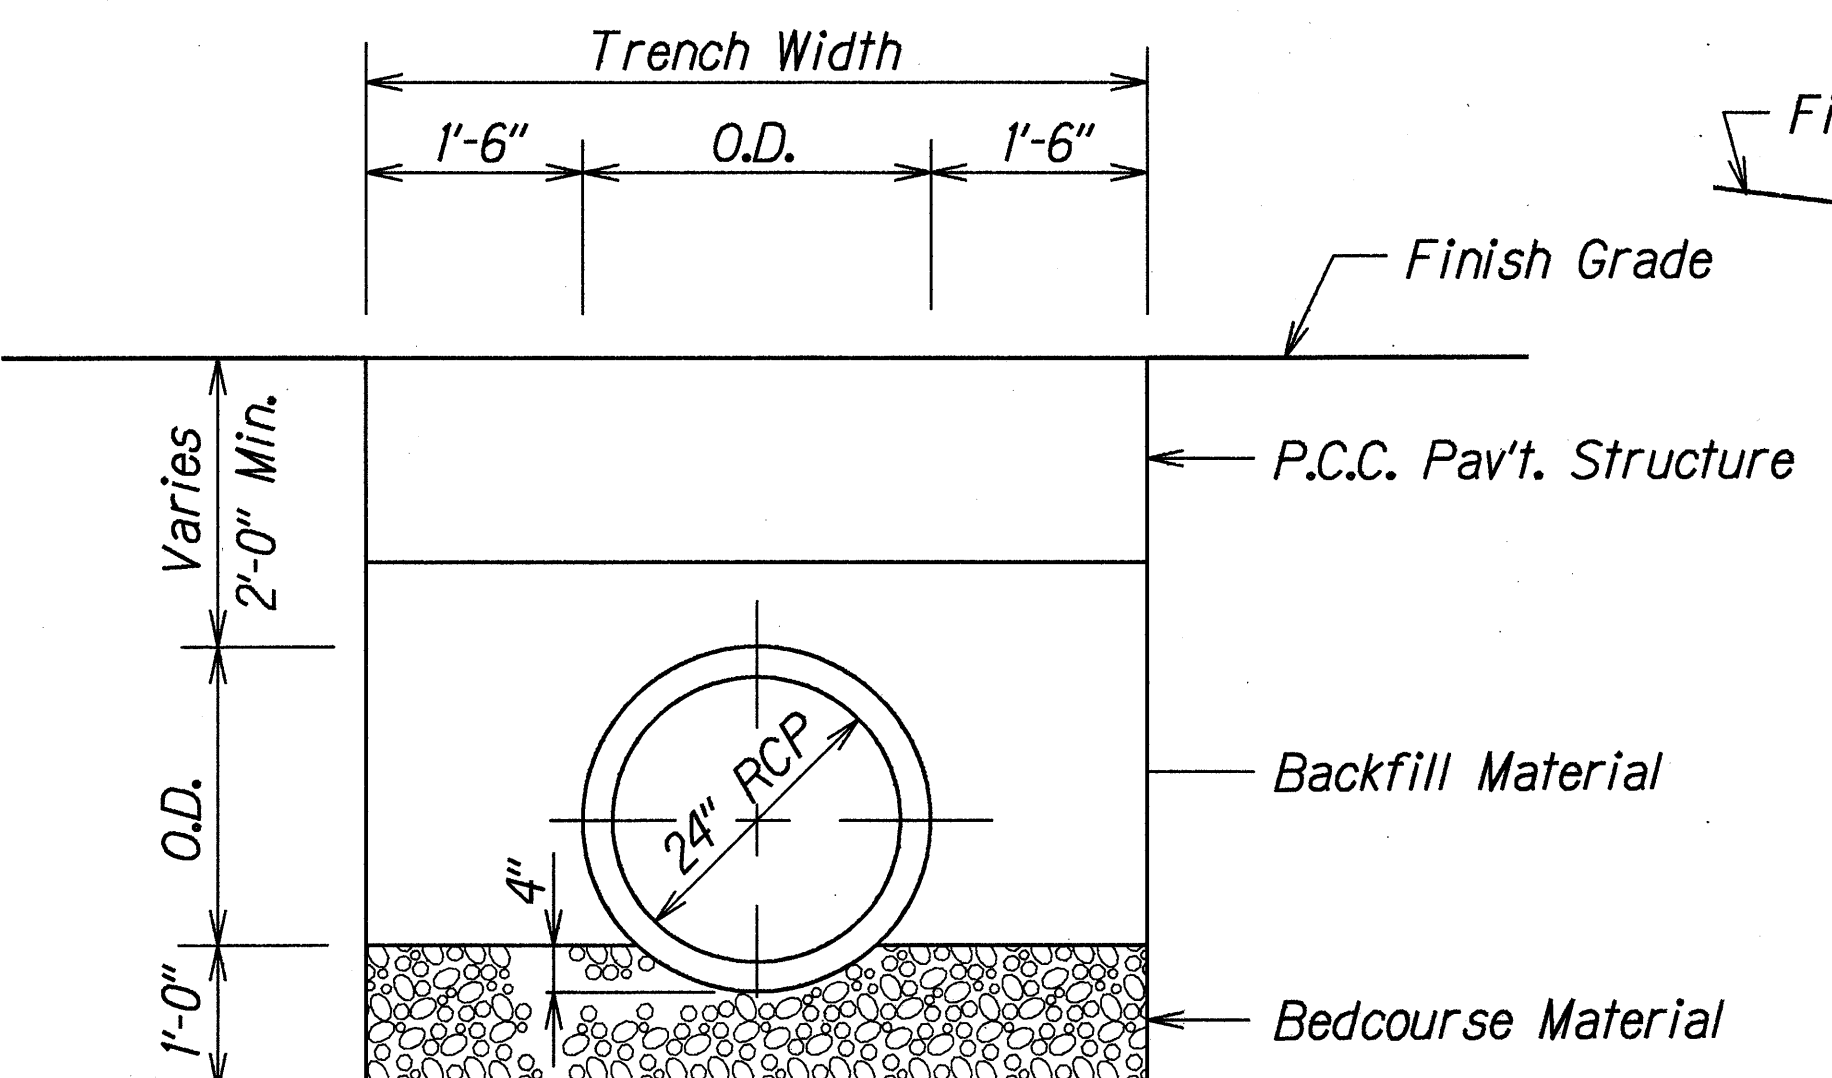

TYPICAL DETAIL OF CULVERT TRENCH RESTORATION

Not to Scale

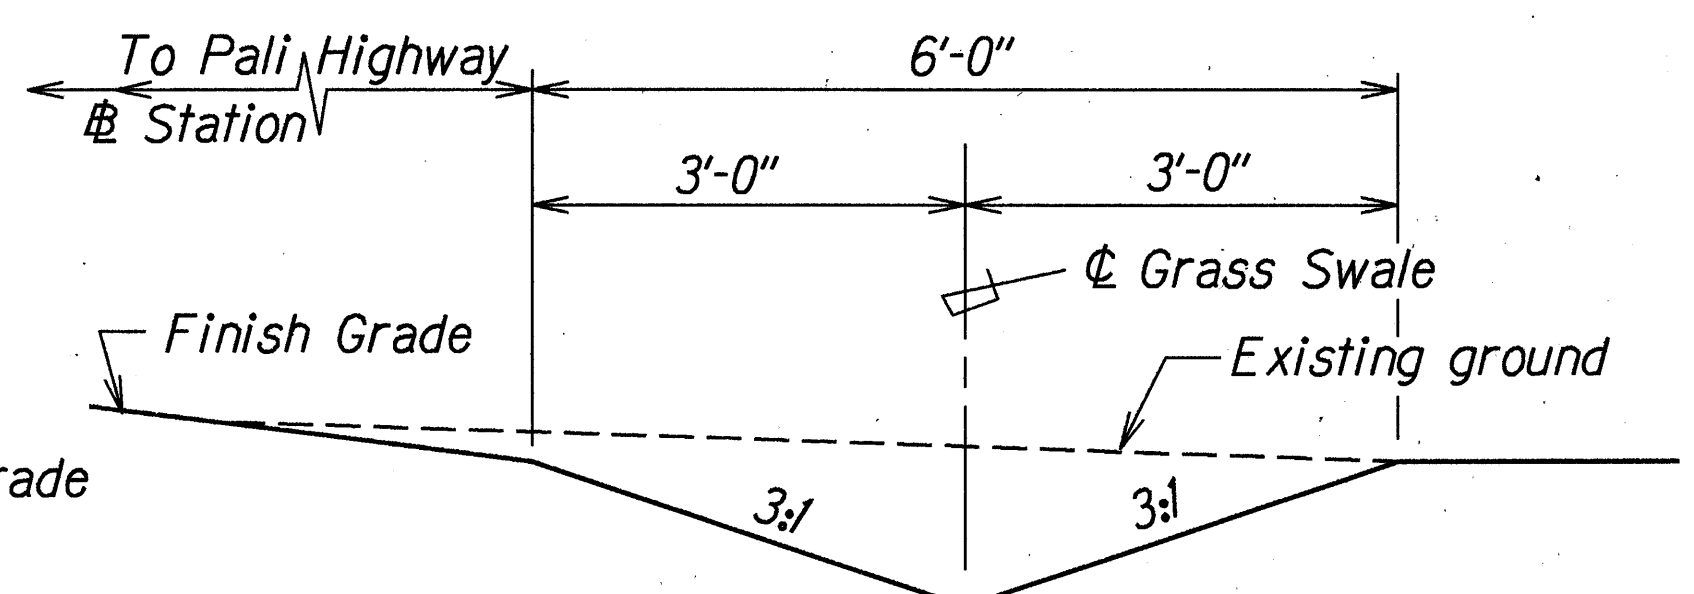

TYPICAL SECTION OF 6-FOOT WIDE GRASS SWALE


Scale: 3/4"=1'-0"

STATE OF HAWAII
DEPARTMENT OF TRANSPORTATION
HIGHWAYS DIVISION


DRAINAGE DETAILS
PALI HIGHWAY RESURFACING
Country Club Rd. to Tunnel Entrance,
Including Both Rds. to Lookout
Project No. 61A-01-97M
Scale: As Shown Date: May 1997

ORIGINAL	SURVEY PLOTTED BY	DATE
PLAN	DATE	4/23/97
NOTE BOOK	DESIGNED BY	C. M. M. M.
drawn by	CHECKED BY	NA. misc. sign

FED. ROAD DIST. NO.	STATE	FED. AID PROJ. NO.	FISCAL YEAR	SHEET NO.	TOTAL SHEETS
HAWAII	HAW.	61A-01-97M	1997	64	84

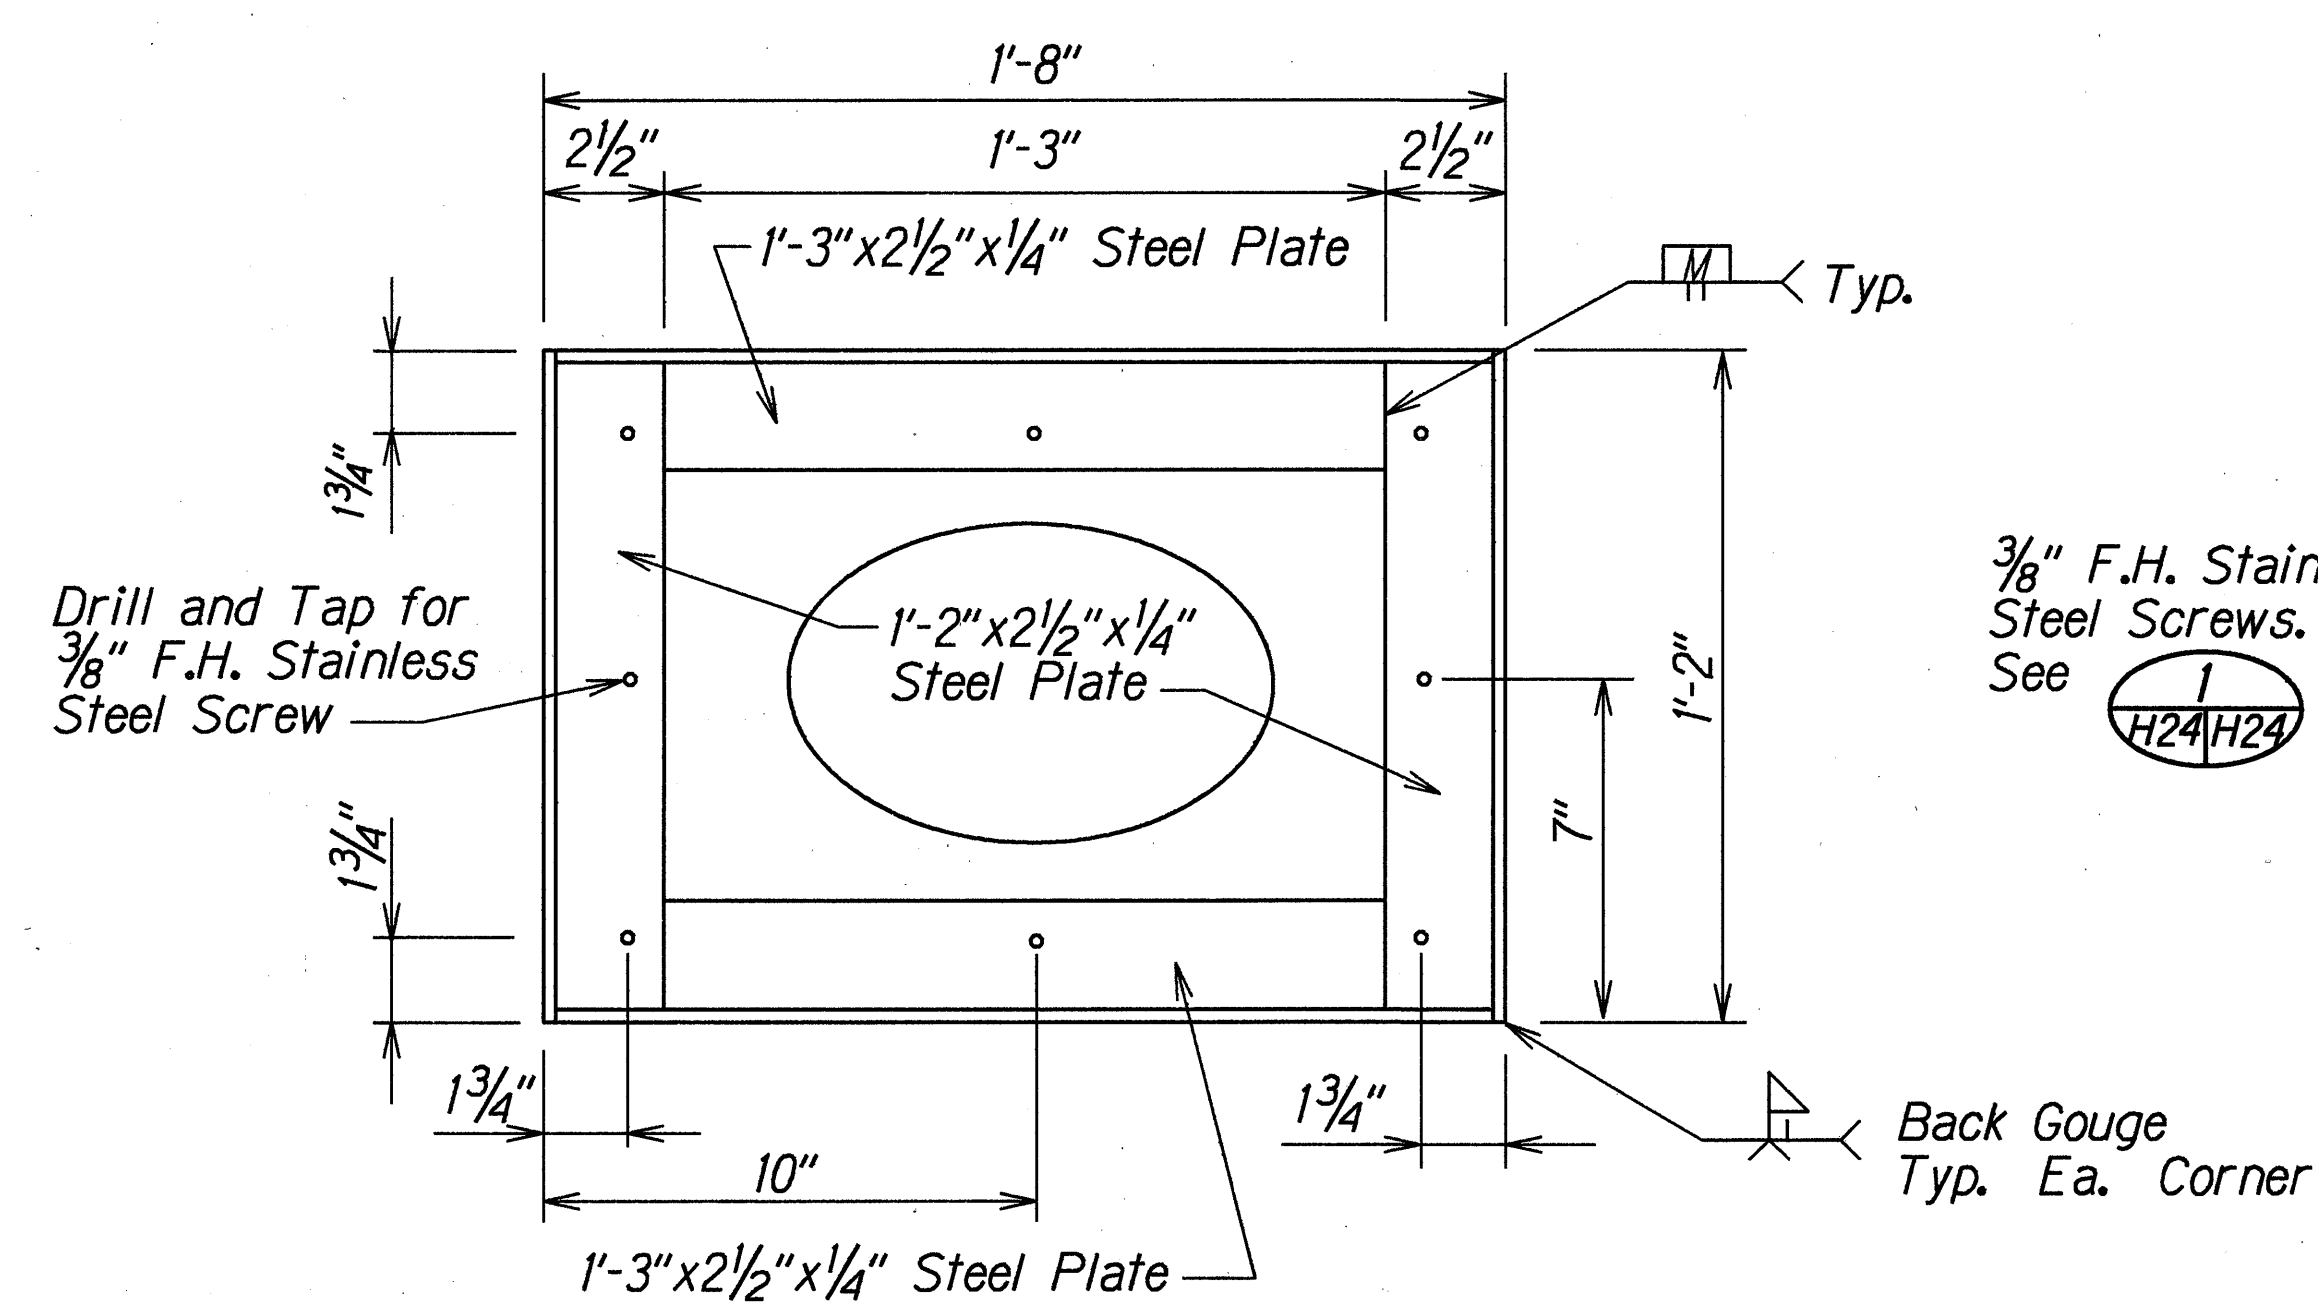


PLAN

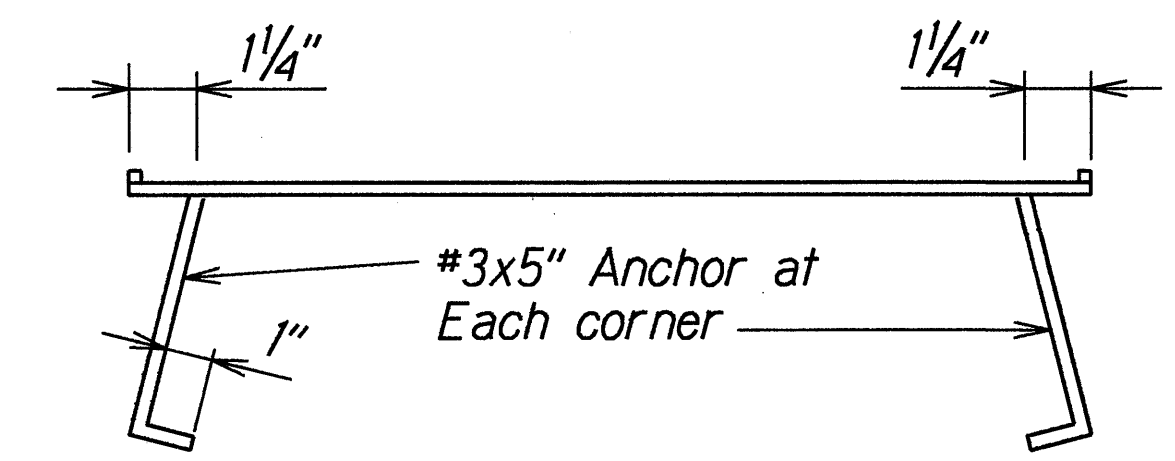


SECTION

DETAILS OF STEEL FRAME

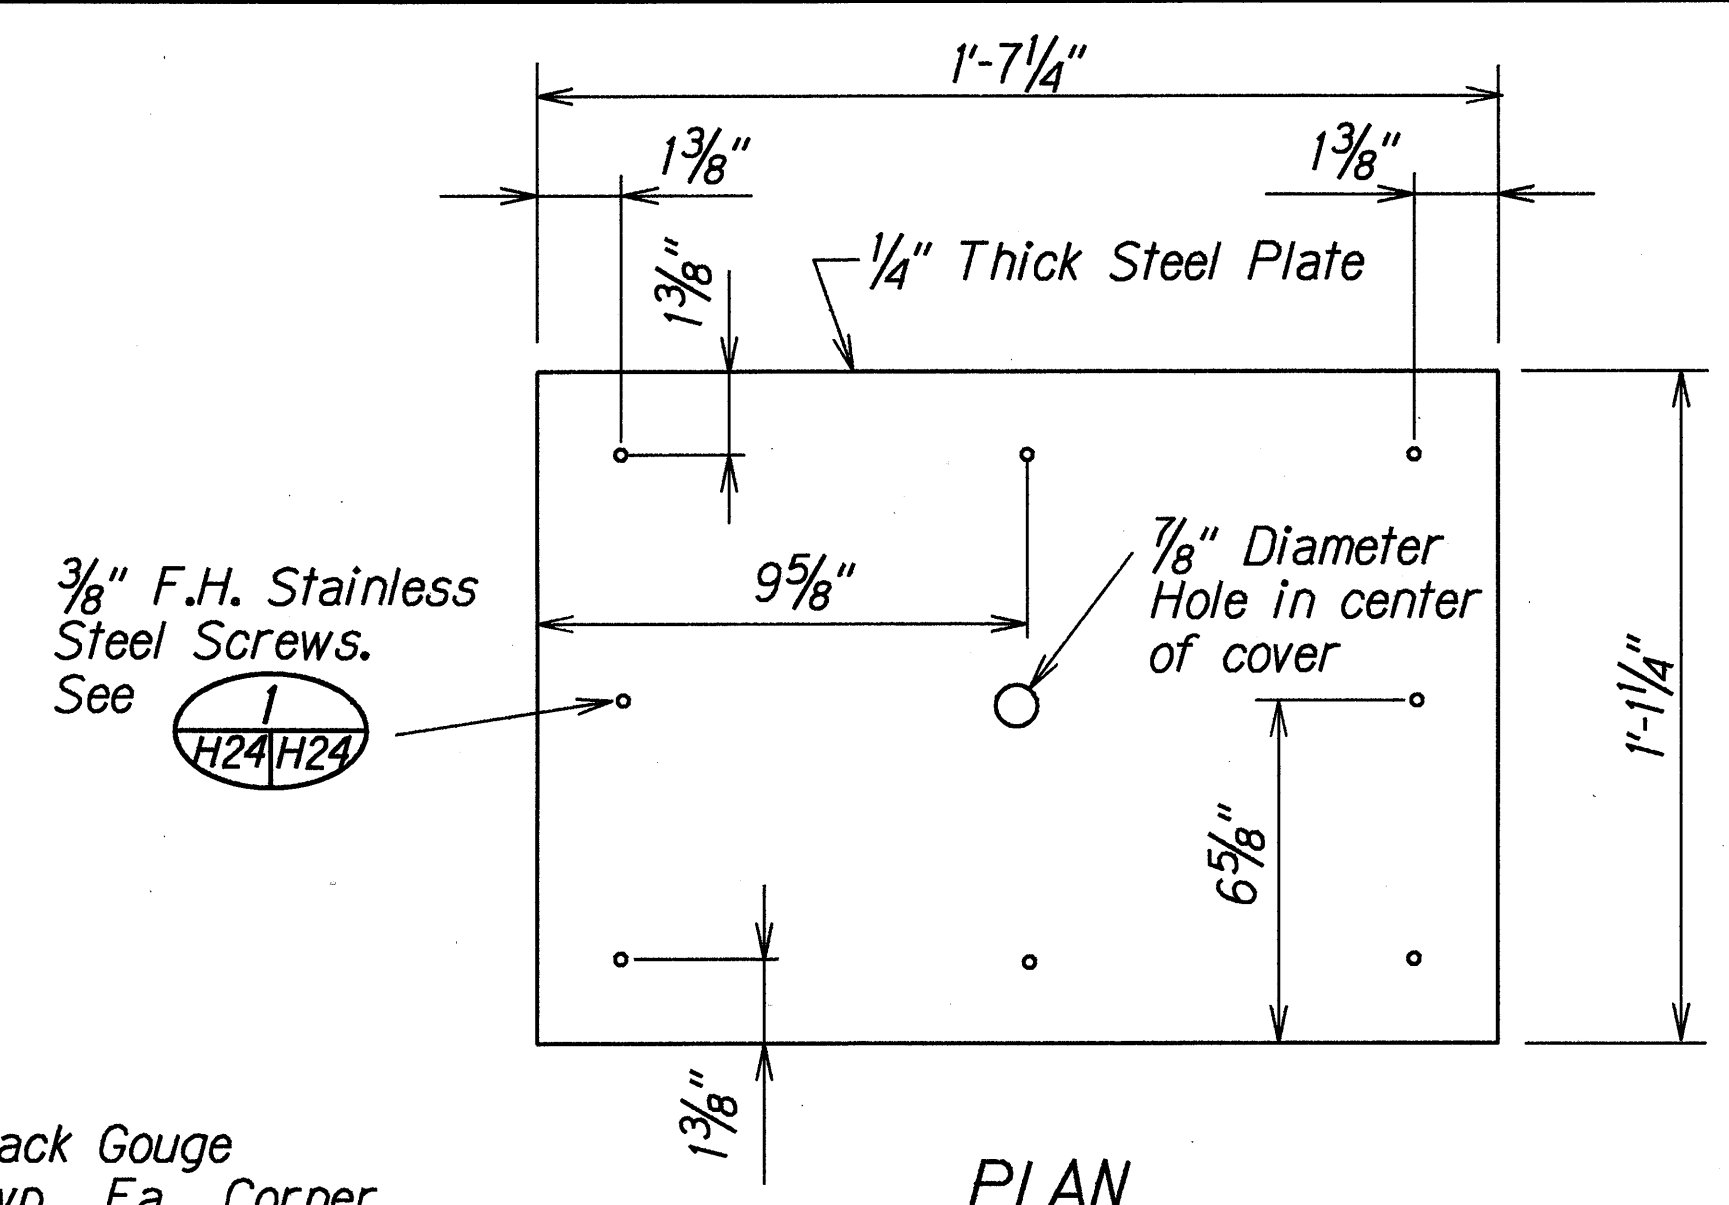

PLAN

DETAIL OF STEEL COVER

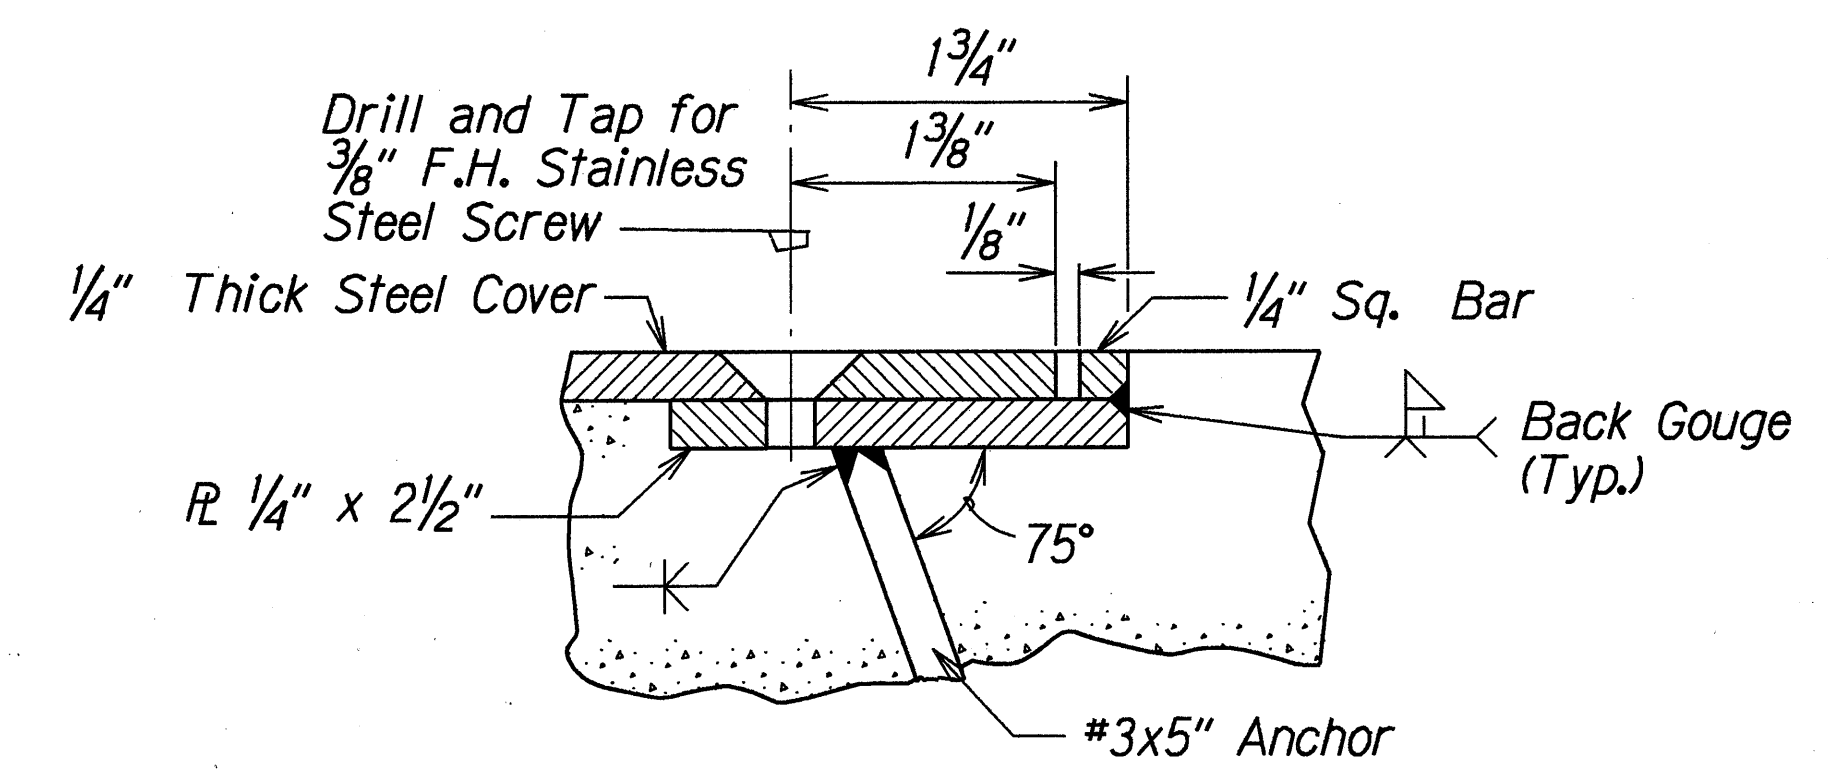


DETAIL Full Size

NOTE: All Steel Parts shall be galvanized in accordance with the requirements of ASTM A123.

DETAILS OF STEEL FRAME AND COVER FOR CLEANOUT


Scale: 3"=1'-0"

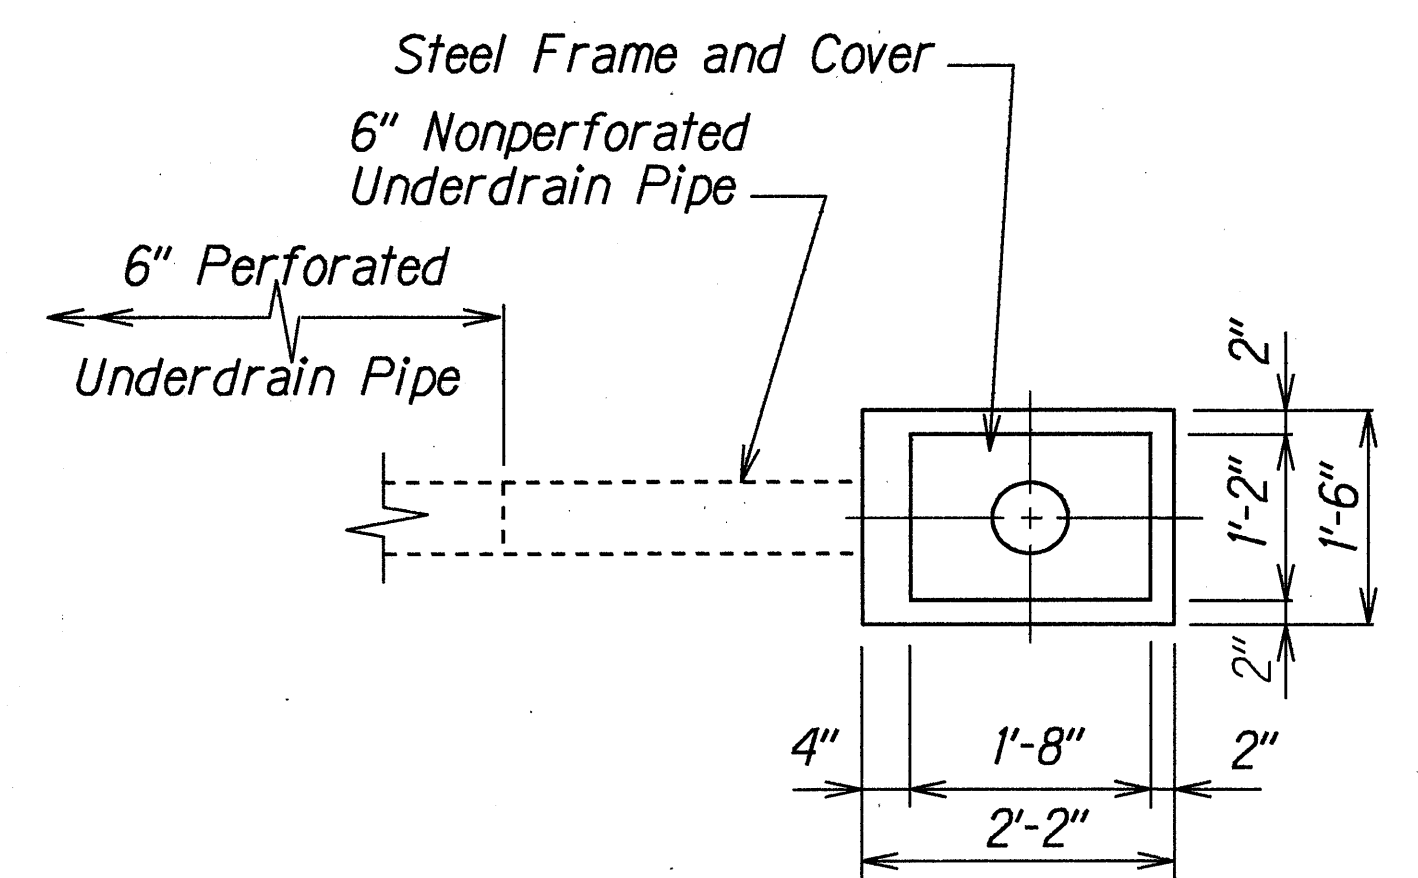

PLAN

TYPICAL DETAILS OF CLEANOUT

Scale: 3/4"=1'-0"

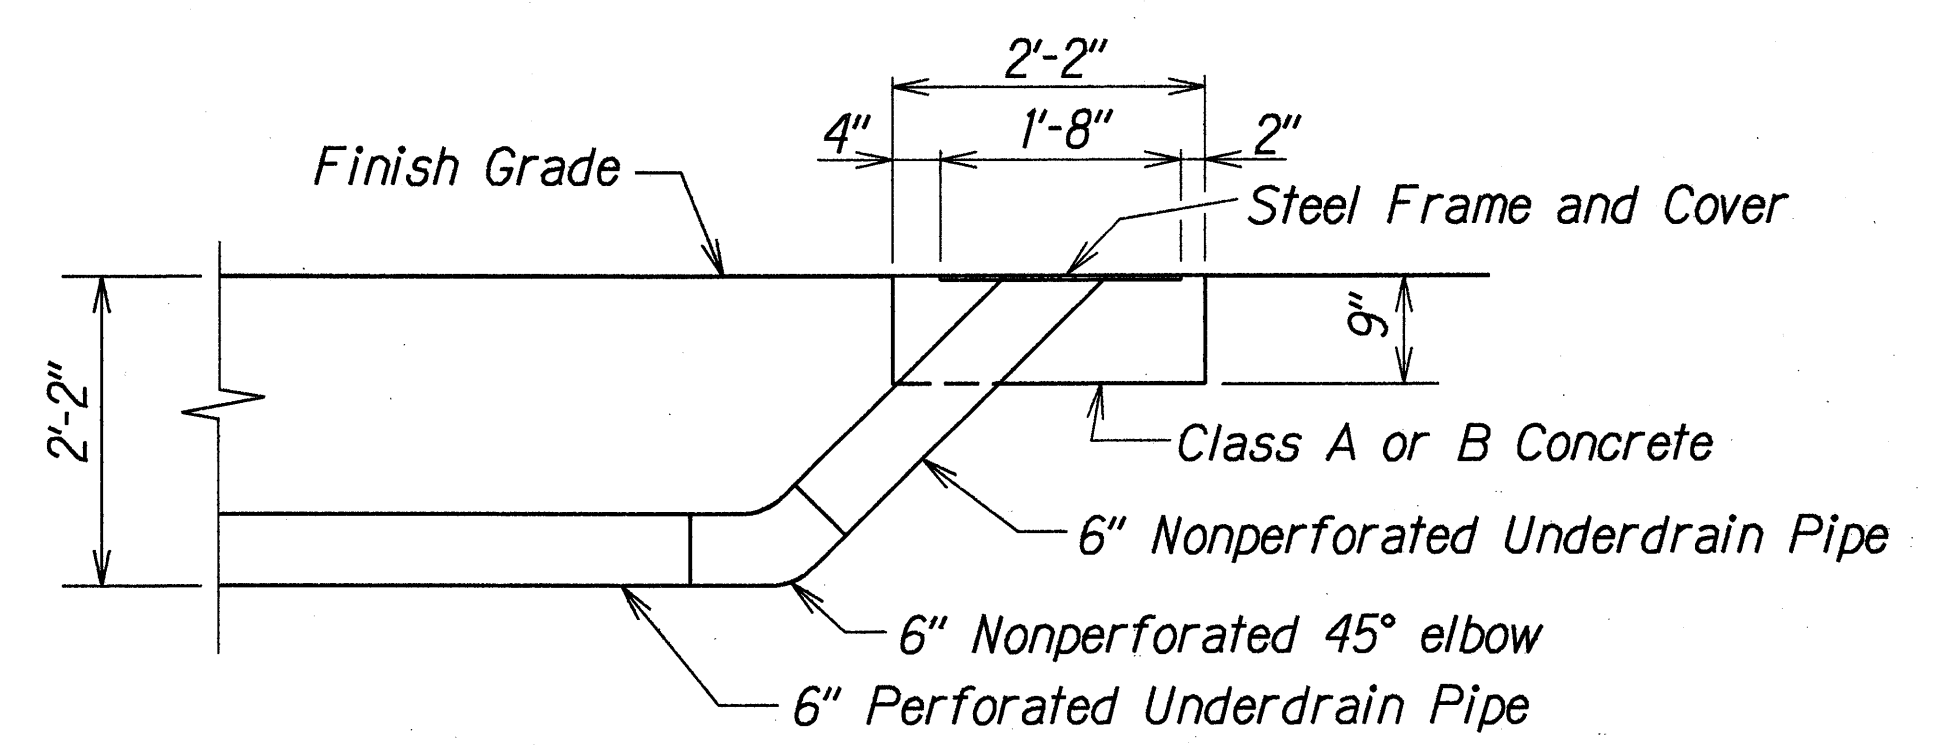

ELEVATION

ORIGINAL PLAN	DATE
SURVEY PLOTTED BY	4/29/97
DRAWN BY A. Nomura	
DESIGNED BY C. Matsuda	
CHECKED BY	
APPROVED BY	

STATE OF HAWAII
DEPARTMENT OF TRANSPORTATION
HIGHWAYS DIVISION

DRAINAGE PLAN
PALI HIGHWAY RESURFACING
Country Club Rd. to Tunnel Entrance,
Including Both Rds. to Lookout
Project No. 61A-01-97M

Scale: As Shown
SHEET No. H24 OF 24 SHEETS

Date: May 1997

GENERAL NOTES

GENERAL SPECIFICATIONS:

State of Hawaii, Department of Transportation Standard Specifications for Road and Bridge Construction, 1994 and Special Provisions

DESIGN SPECIFICATIONS:

1. AASHTO LRFD Bridge Design Specifications, First Edition including 1996 and 1997 Interim Revisions

MATERIALS:

- A. Reinforced Concrete: Class A, unless otherwise noted
B. Reinforced Steel: ASTM A 615, Grade 60
C. Admixture in concrete: See Special Provisions
D. All expansion and premolded joint filler shall be incidental to concrete and will not be paid for separately.
E. All structural steel shall be ASTM A 36 hot-dip galvanized after fabrication.
F. All anchor bolts, washers and nuts shall be ASTM A 325 hot-dip galvanized after fabrication, unless noted otherwise.
G. All welding shall be in accordance with the current edition of Reinforcing Steel Welding Code AWS D 1.4. Welding electrodes for structural steel shall be E 70.

CONSTRUCTION METHODS:

- A. Refer to Hawaii Standard Specifications for Road, Bridge and Public Works Construction, 1994 Edition and Special Provisions.
B. Except as noted otherwise, all vertical dimensions are measured plumb.
C. For concrete finish, see Standard Specifications and Special Provisions.
D. For steel reinforcing, stagger all splices where possible.
E. Steel reinforcing shall be supported, bent and placed as per the ACI Detailing Manual, 1994.
F. The minimum cover measured from the surface of the concrete to the face of any reinforcing bars shall be as follows, except as noted otherwise:
a. Concrete cast against a smooth surface or finished to a smooth surface: 2"
b. Concrete cast against and permanently exposed to earth: 3"
G. At time concrete is placed, reinforcing shall be free from mud, oil, laitance or other coatings adversely affecting bond capacity.
H. Reinforcement, dowels and other embedded items shall be positively secured before pouring.

- I. All existing concrete face receiving new concrete in the finish product shall be roughened and cleaned prior to placement of new pour. See Special Provisions for additional requirements.
J. All footings shall bear on firm undisturbed natural soils or properly compacted structural fill.
K. All existing reinforcing and anchor bolts that can be incorporated in the new work shall be bent or cut as required and cleaned before being utilized in the new work.
L. All existing reinforcing and anchor bolts that cannot be incorporated in the new work shall be completely removed or removed to a minimum depth of one and one-half (1½) inches below finish grade and the area patched with mortar.
M. Existing structure shown by dotted lines. Removal of existing concrete shall be done in such a manner as to preclude any damage to the existing structures. Large vibratory type of equipment will not be permitted in the removal operation, nor for drilling of holes. Only small vibratory hand tools accepted by the Engineer will be allowed. Any damage to the existing structure due to the Contractor's operation or negligence shall be repaired at his expense with no cost to the State.
N. Epoxy anchors shall be "Double Cartridge" type. Epoxies that require manual measuring or mixing shall not be allowed. See Special Provisions for additional requirements.

REFERENCE:


- A. Refer to Standard Plans for additional details and notes not covered by details and typical drawings.

GENERAL:

- A. All items noted incidental will not be paid for separately.
B. The Contractor shall verify the locations of all existing utility lines and notify their respective owners before commencing with any work.
C. The Contractor shall verify all grades and dimensions in the field before commencing with any work.
D. The Contractor shall be solely responsible for the protection of adjacent property, utilities and existing and new structures from damage due to construction. Repairing any damage shall be at the Contractor's own expense to the satisfaction of the Engineer at no cost to the State.
E. The Contractor shall conduct his work in such a manner and provide such temporary shoring or other measures as may be necessary to insure the safety of all concerned and to protect existing structures.
F. Unless noted otherwise, chamfer all exposed concrete edges three-quarters (¾) of an inch.

FED. ROAD DIST. NO.	STATE	PROJ. NO.	FISCAL YEAR	SHEET NO.	TOTAL SHEETS
HAWAII	HAW.	61A-01-97M	1998	C.O. 64 S-1	84

SYMBOLS

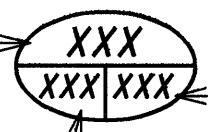Detail or Section designation →  Sheet No. Section is cut or Detail Location
Sheet No. Detail is drawn








ESTIMATED QUANTITIES

ITEM NO.	ITEM DESCRIPTION	UNIT	QUANTITY
411.2116	Unreinforced Concrete Pavement Over Existing Culvert	L.S.	(5 C.Y.)
503.1400	Concrete for Culvert Railing and Endpost	L.S.	(10 C.Y.)
606.3110	Guardrail, Type 3, w/Steel Post	L.F.	65 Ft.
606.3501	Guardrail, Type 3, Thrie Beam w/Steel Post	L.S.	(25 Ft.)

ORIGINAL PLAN	SURVEY PLOTTED BY	DATE
NOTE BOOK	DRAWN BY	AUG 1998
19014972	TRACED BY	AUG 1998
	NOTED BY	AUG 1998
	QUANTITIES BY	AUG 1998
	CHECKED BY	AUG 1998

8-24-98	Added Sheet
DATE	REVISION
STATE OF HAWAII DEPARTMENT OF TRANSPORTATION HIGHWAYS DIVISION P.C. PAVEMENT RECONSTRUCTION at EXISTING 10'x10' BOX CULVERT at STA. 49+72 GENERAL NOTES and ESTIMATED QUANTITIES PALI HIGHWAY RESURFACING Country Club Road to Tunnel Entrance Project No. 61A-01-97M Scale: As Noted Date: Aug. 1998	
SHEET No. 01 OF 3 SHEETS	

FED. ROAD DIST. NO.	STATE	PROJ. NO.	FISCAL YEAR	SHEET NO.	TOTAL SHEETS
HAWAII	HAW.	61A-01-97M	1998	C.O. 64 S-2	84

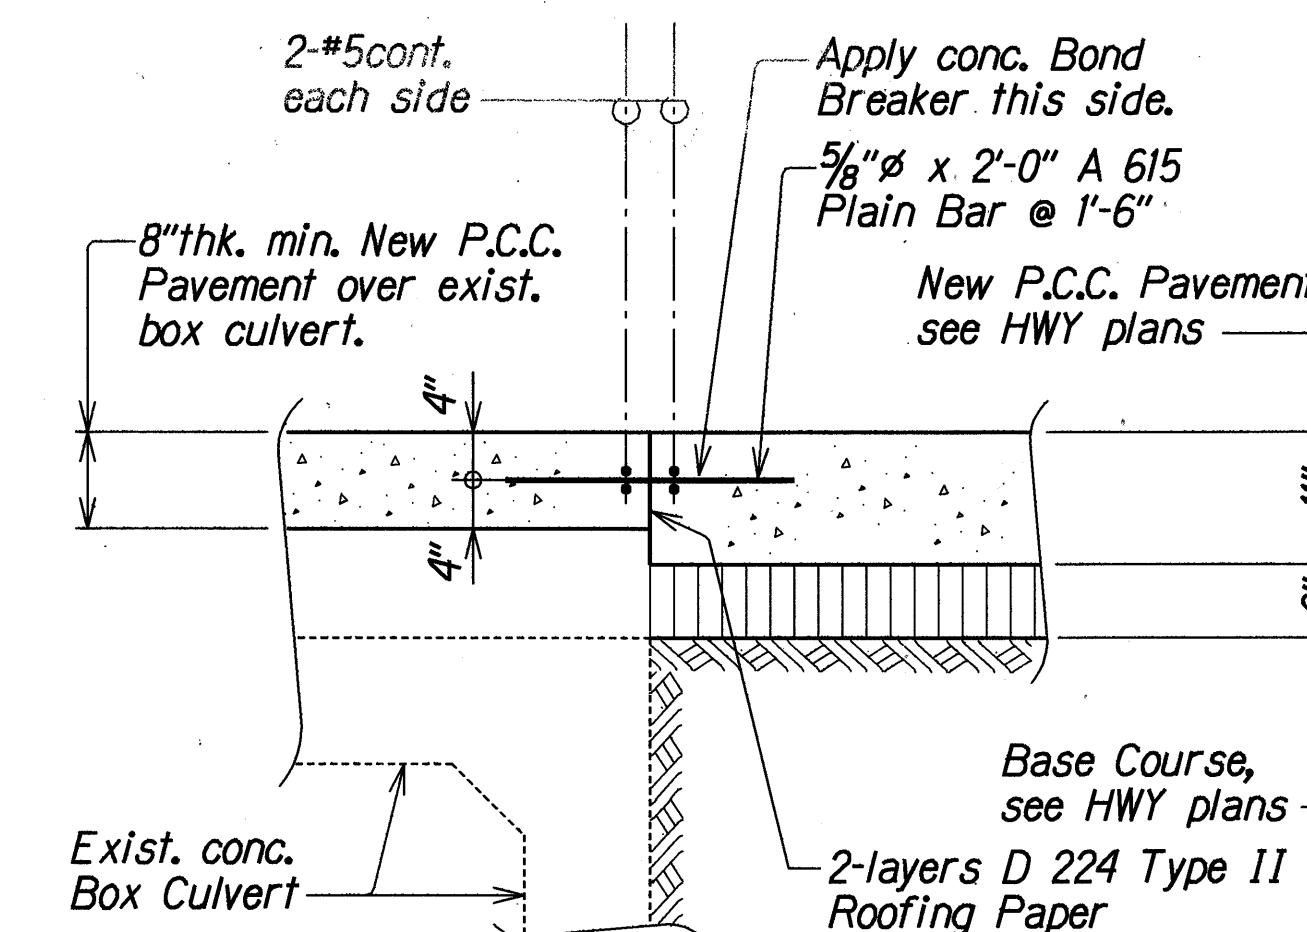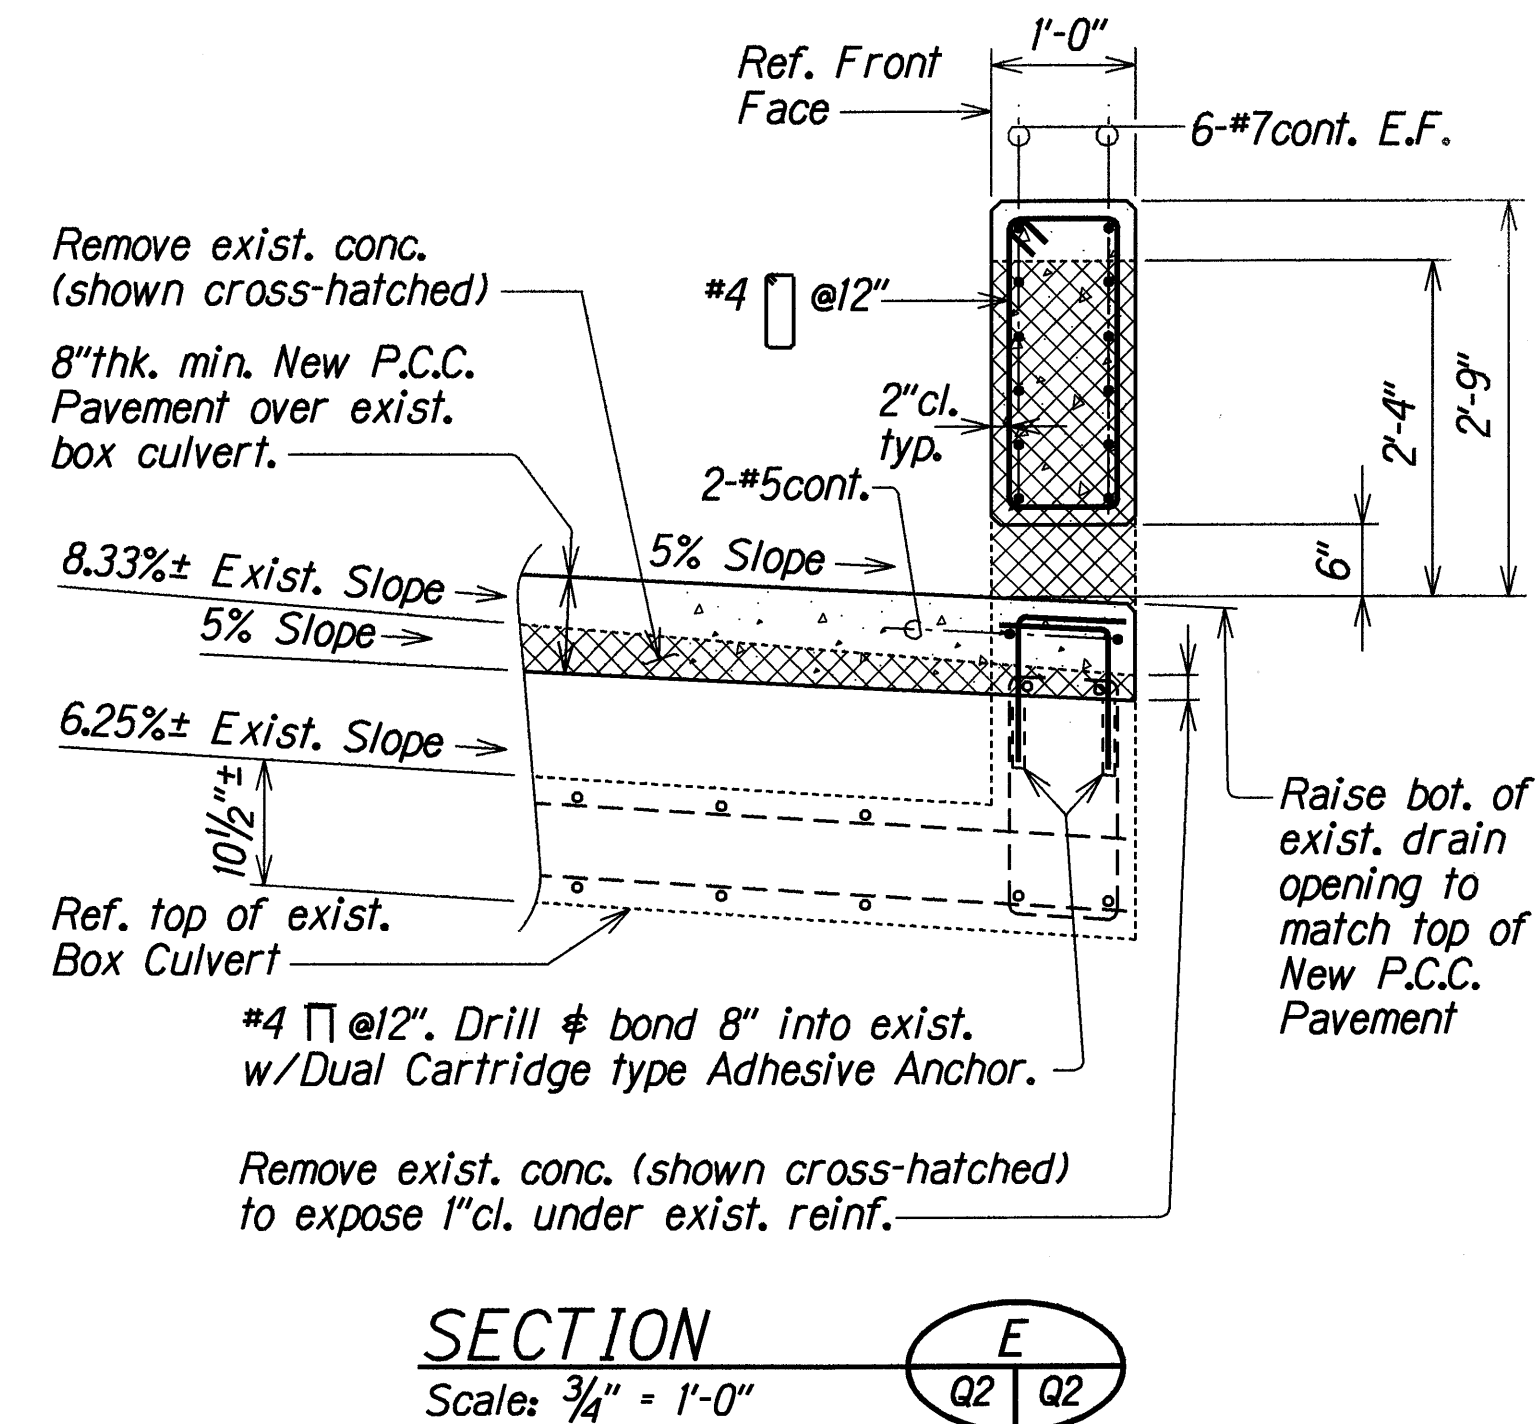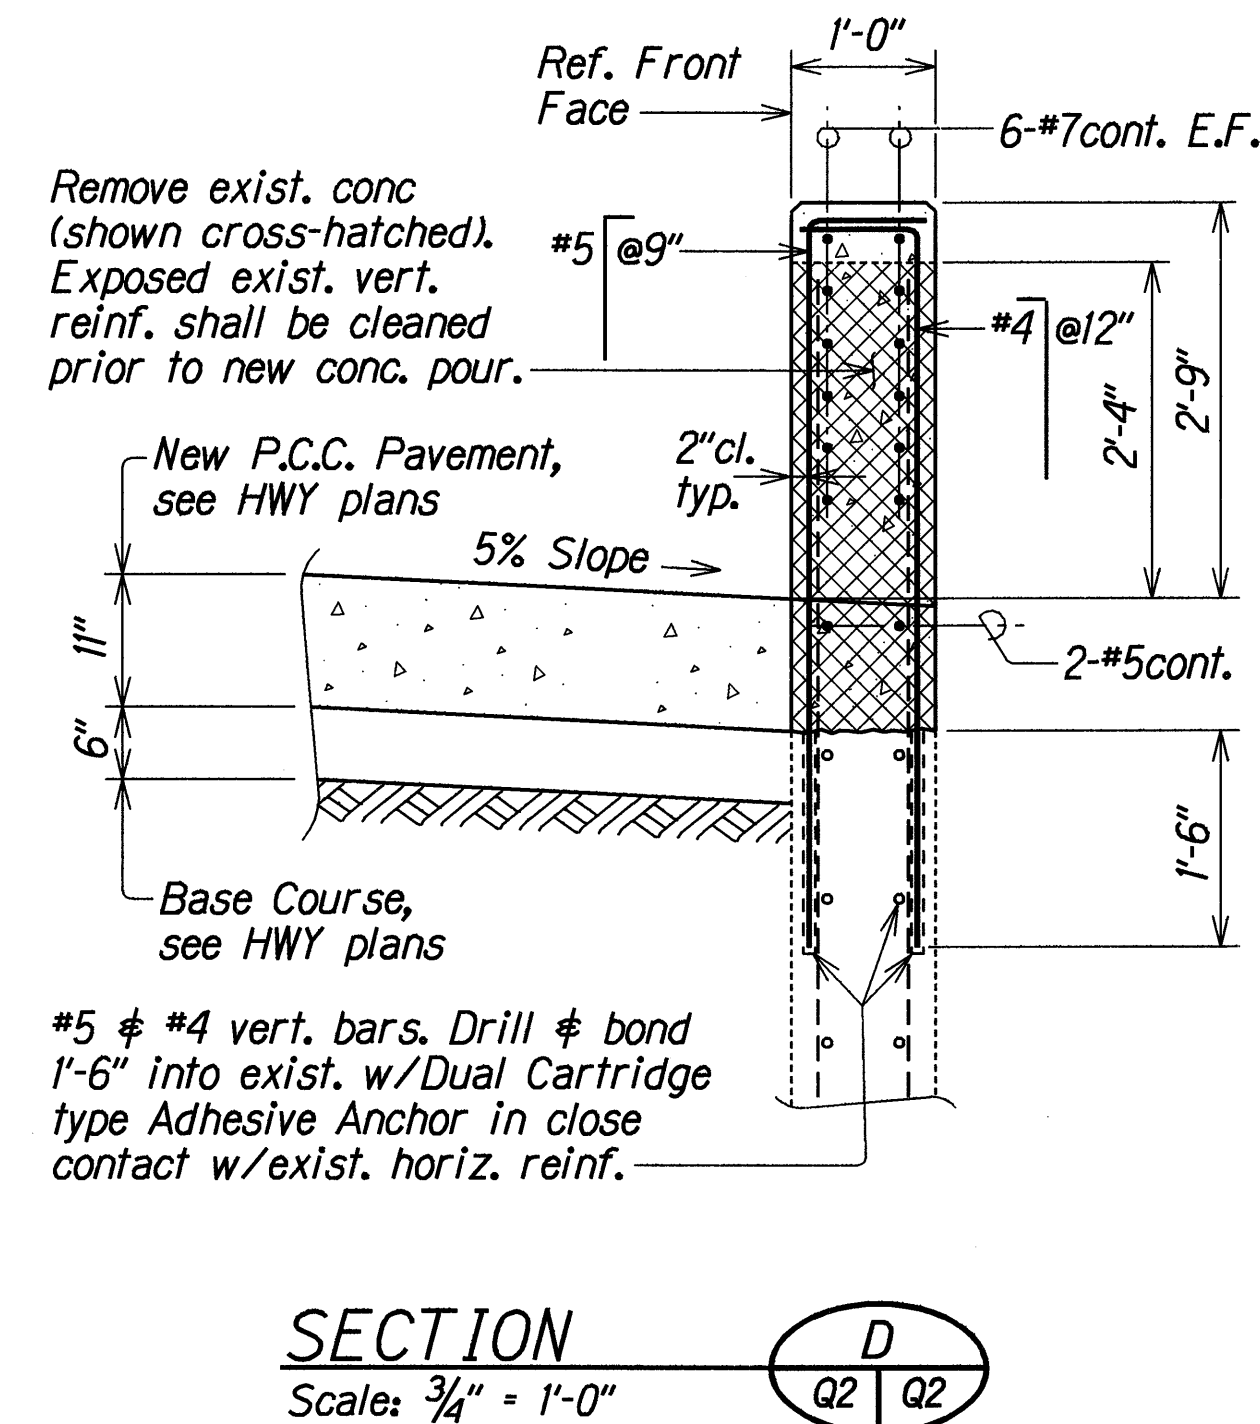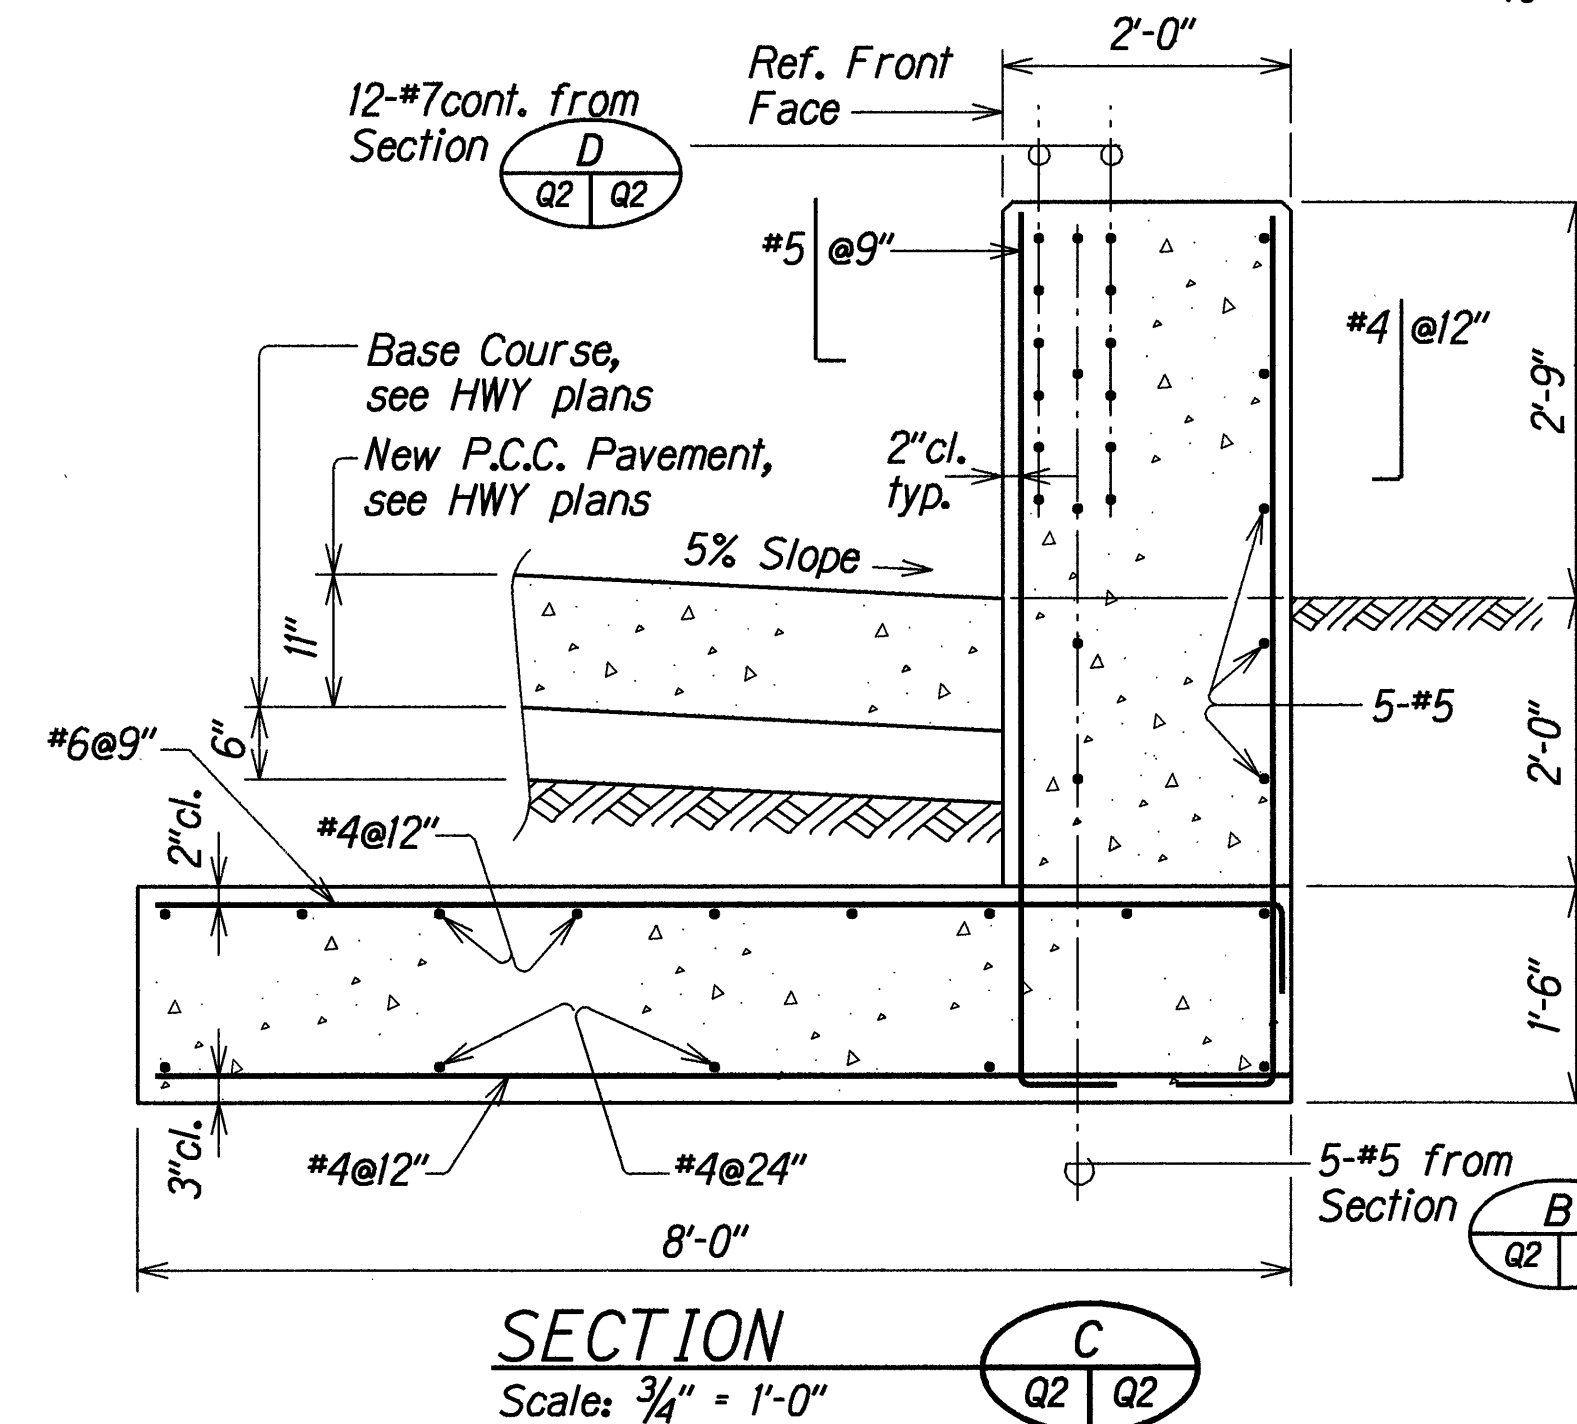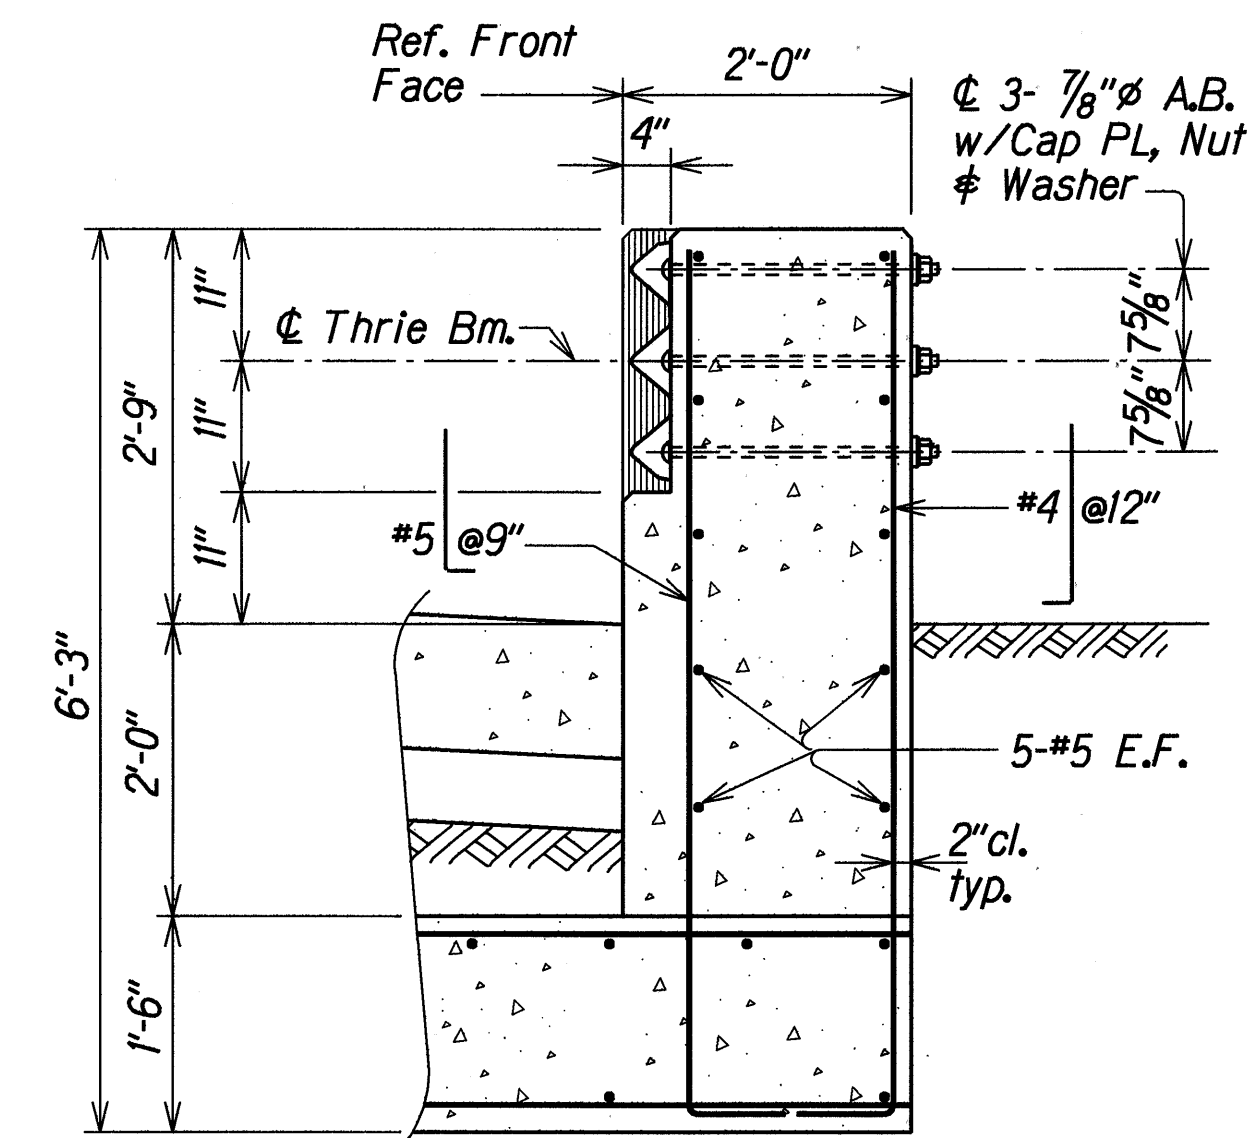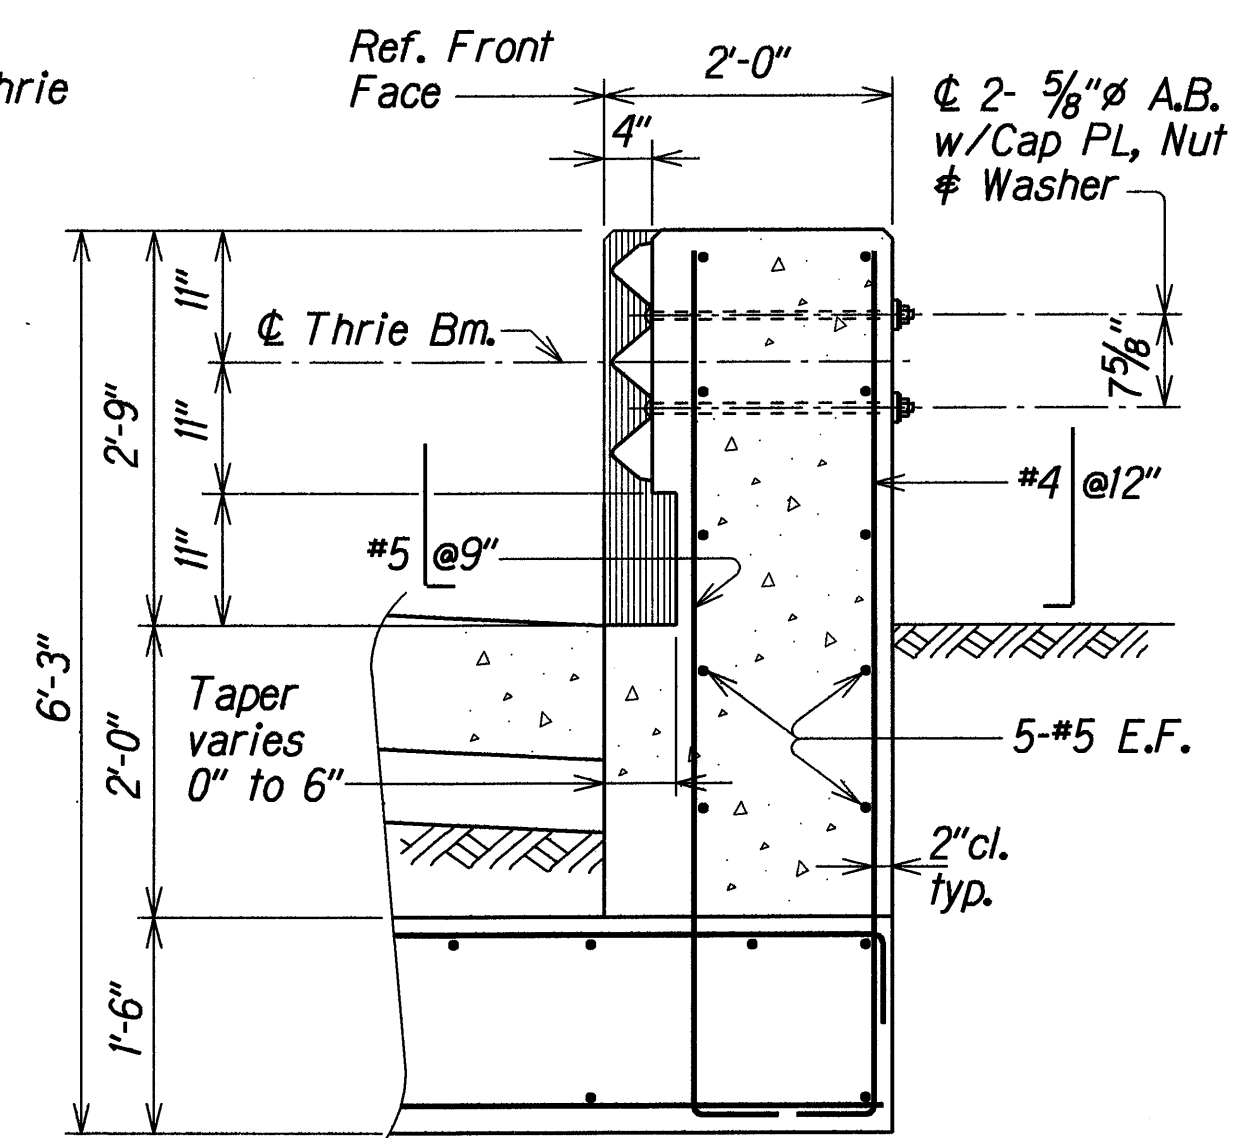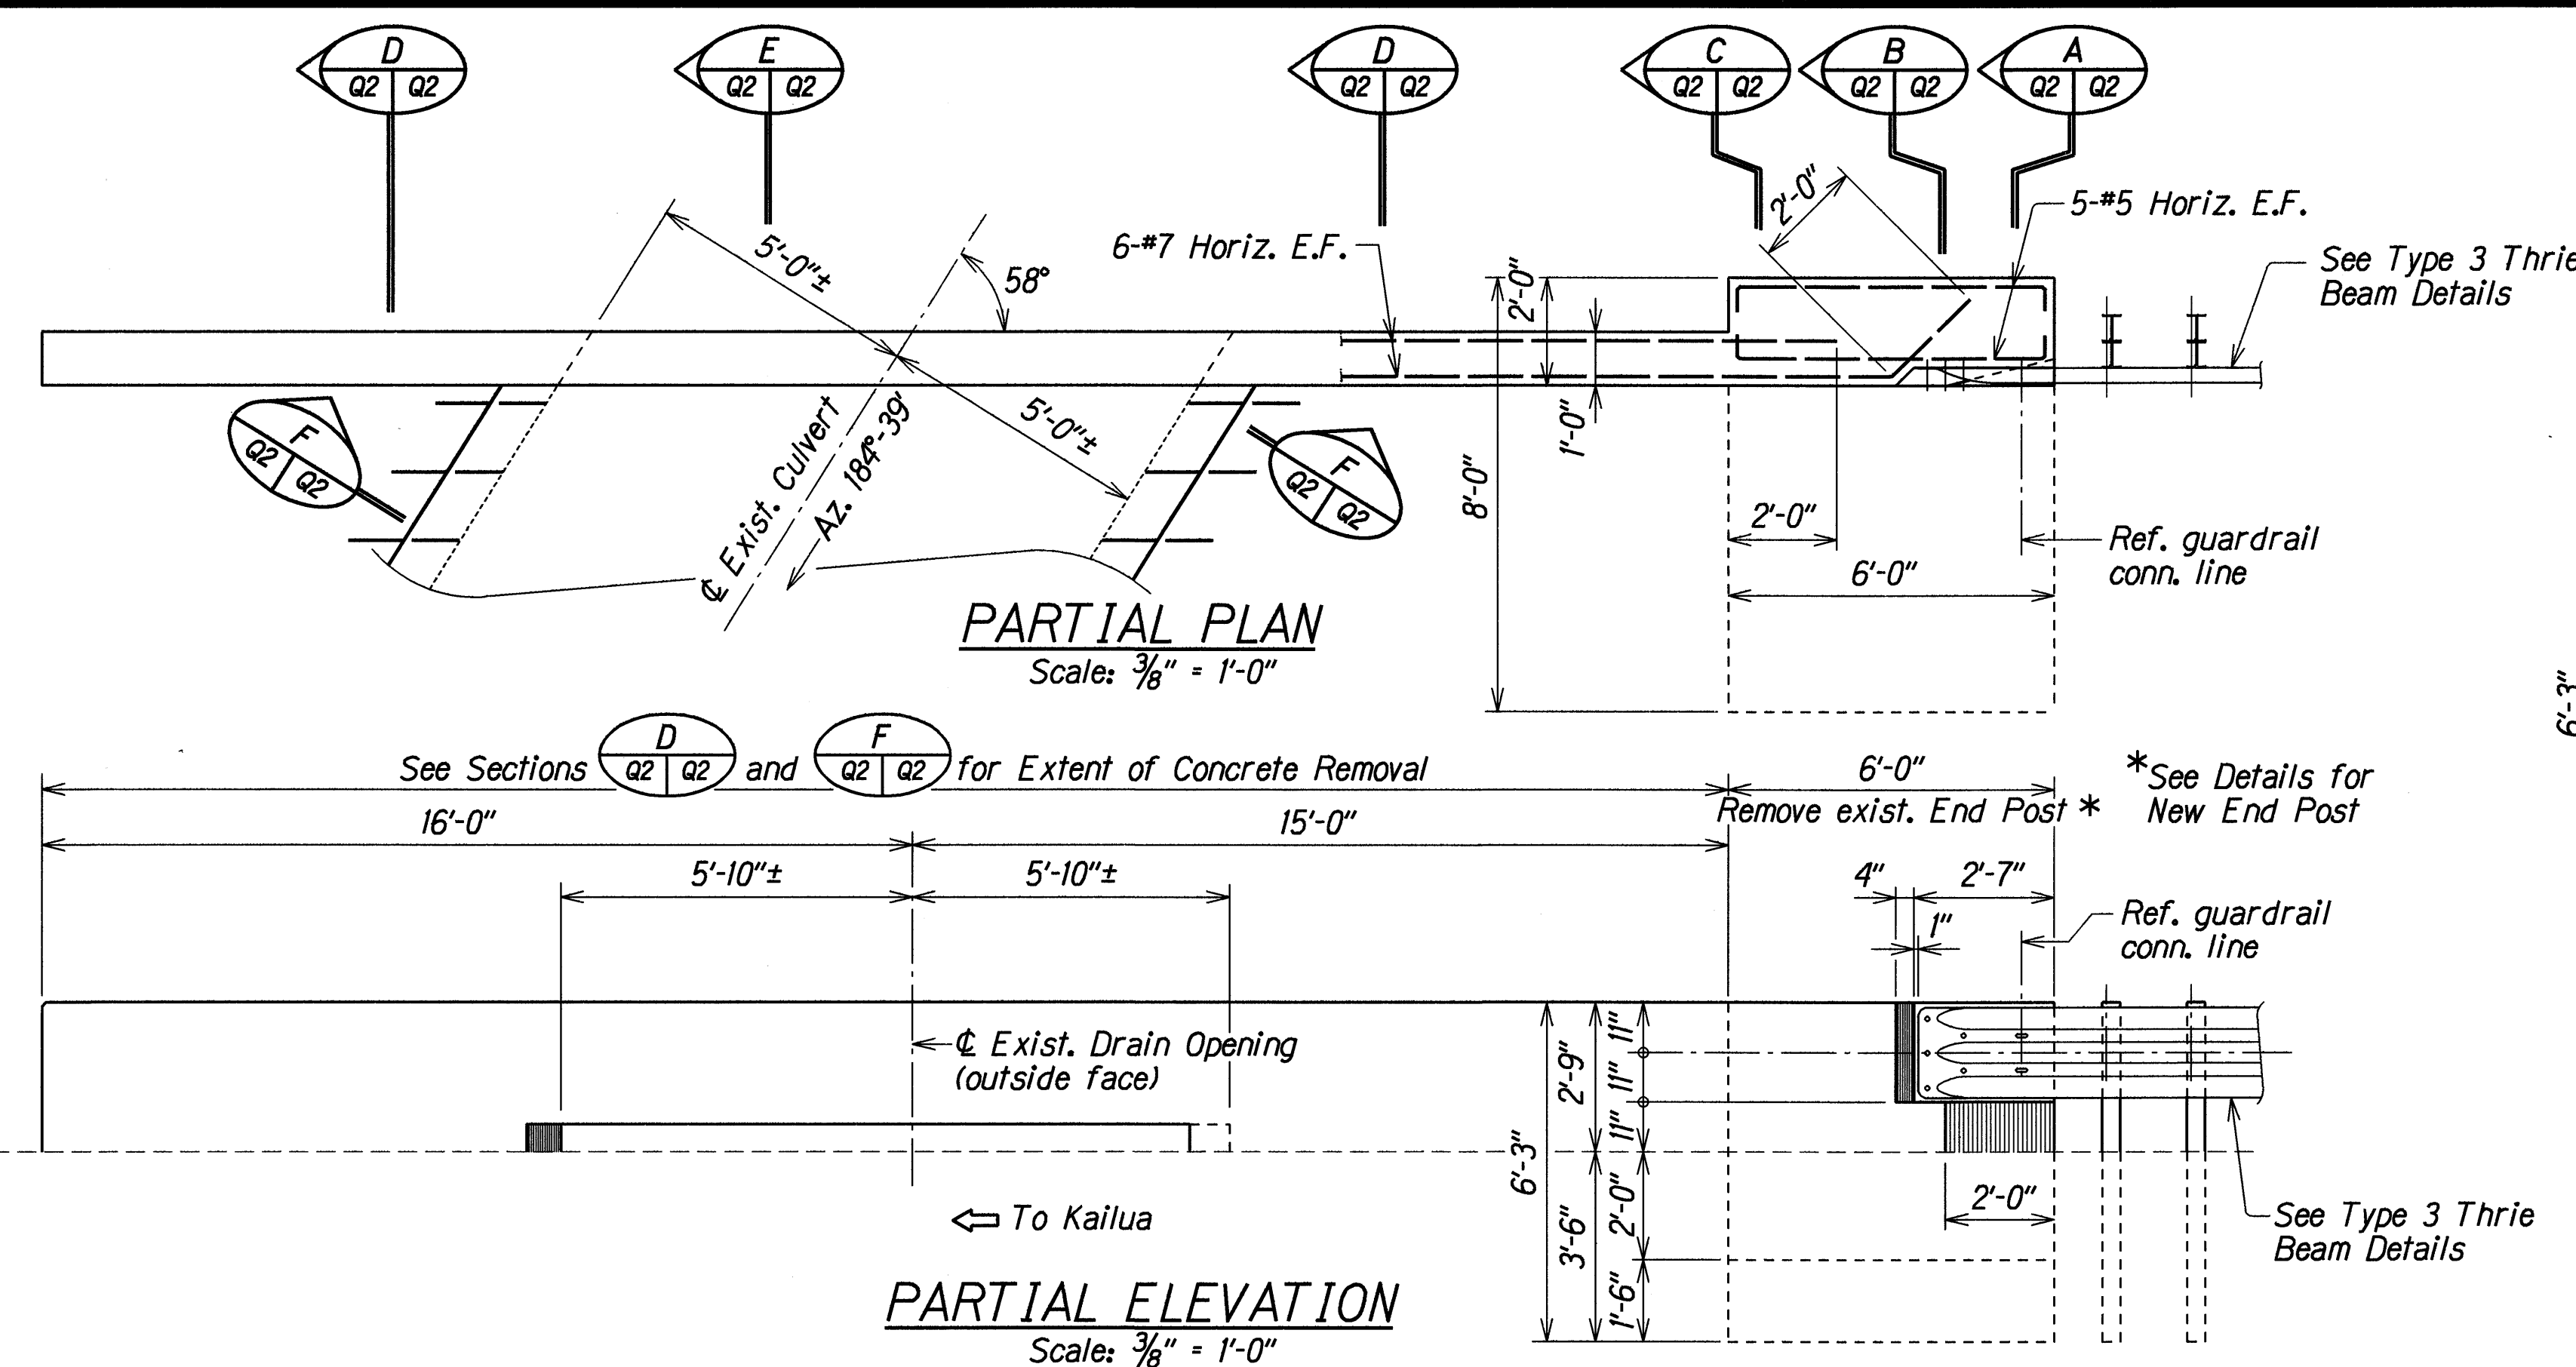

P.C.C. PAVEMENT RECONSTRUCTION AT EXISTING 10'x10' BOX CULVERT PALI HIGHWAY @ STA. 49+72


ORIGINAL PLAN	DATE	BY	CHECKED BY
PLAN	AUG 1998	KSC	AW
NOTES BOOK	AUG 1998	AW	AW
4004972.q2	AUG 1998	AW	AW

8-24-98	Added Sheet
DATE	REVISION
	STATE OF HAWAII DEPARTMENT OF TRANSPORTATION HIGHWAYS DIVISION
	P.C.C. PAVEMENT RECONSTRUCTION at EXISTING 10'x10' BOX CULVERT at STA. 49+72
	PARTIAL PLAN and ELEVATION and DETAILS
	PALI HIGHWAY RESURFACING Country Club Road to Tunnel Entrance Project No. 61A-01-97M
Scale: As Noted	Date: Aug. 1998

SHEET No. Q2 OF 3 SHEETS

C.O. 64 S-2

FED. ROAD DIST. NO.	STATE	PROJ. NO.	FISCAL YEAR	SHEET NO.	TOTAL SHEETS
HAWAII	HAW.	61A-01-97M	1998	C.O. 64 S-3	84

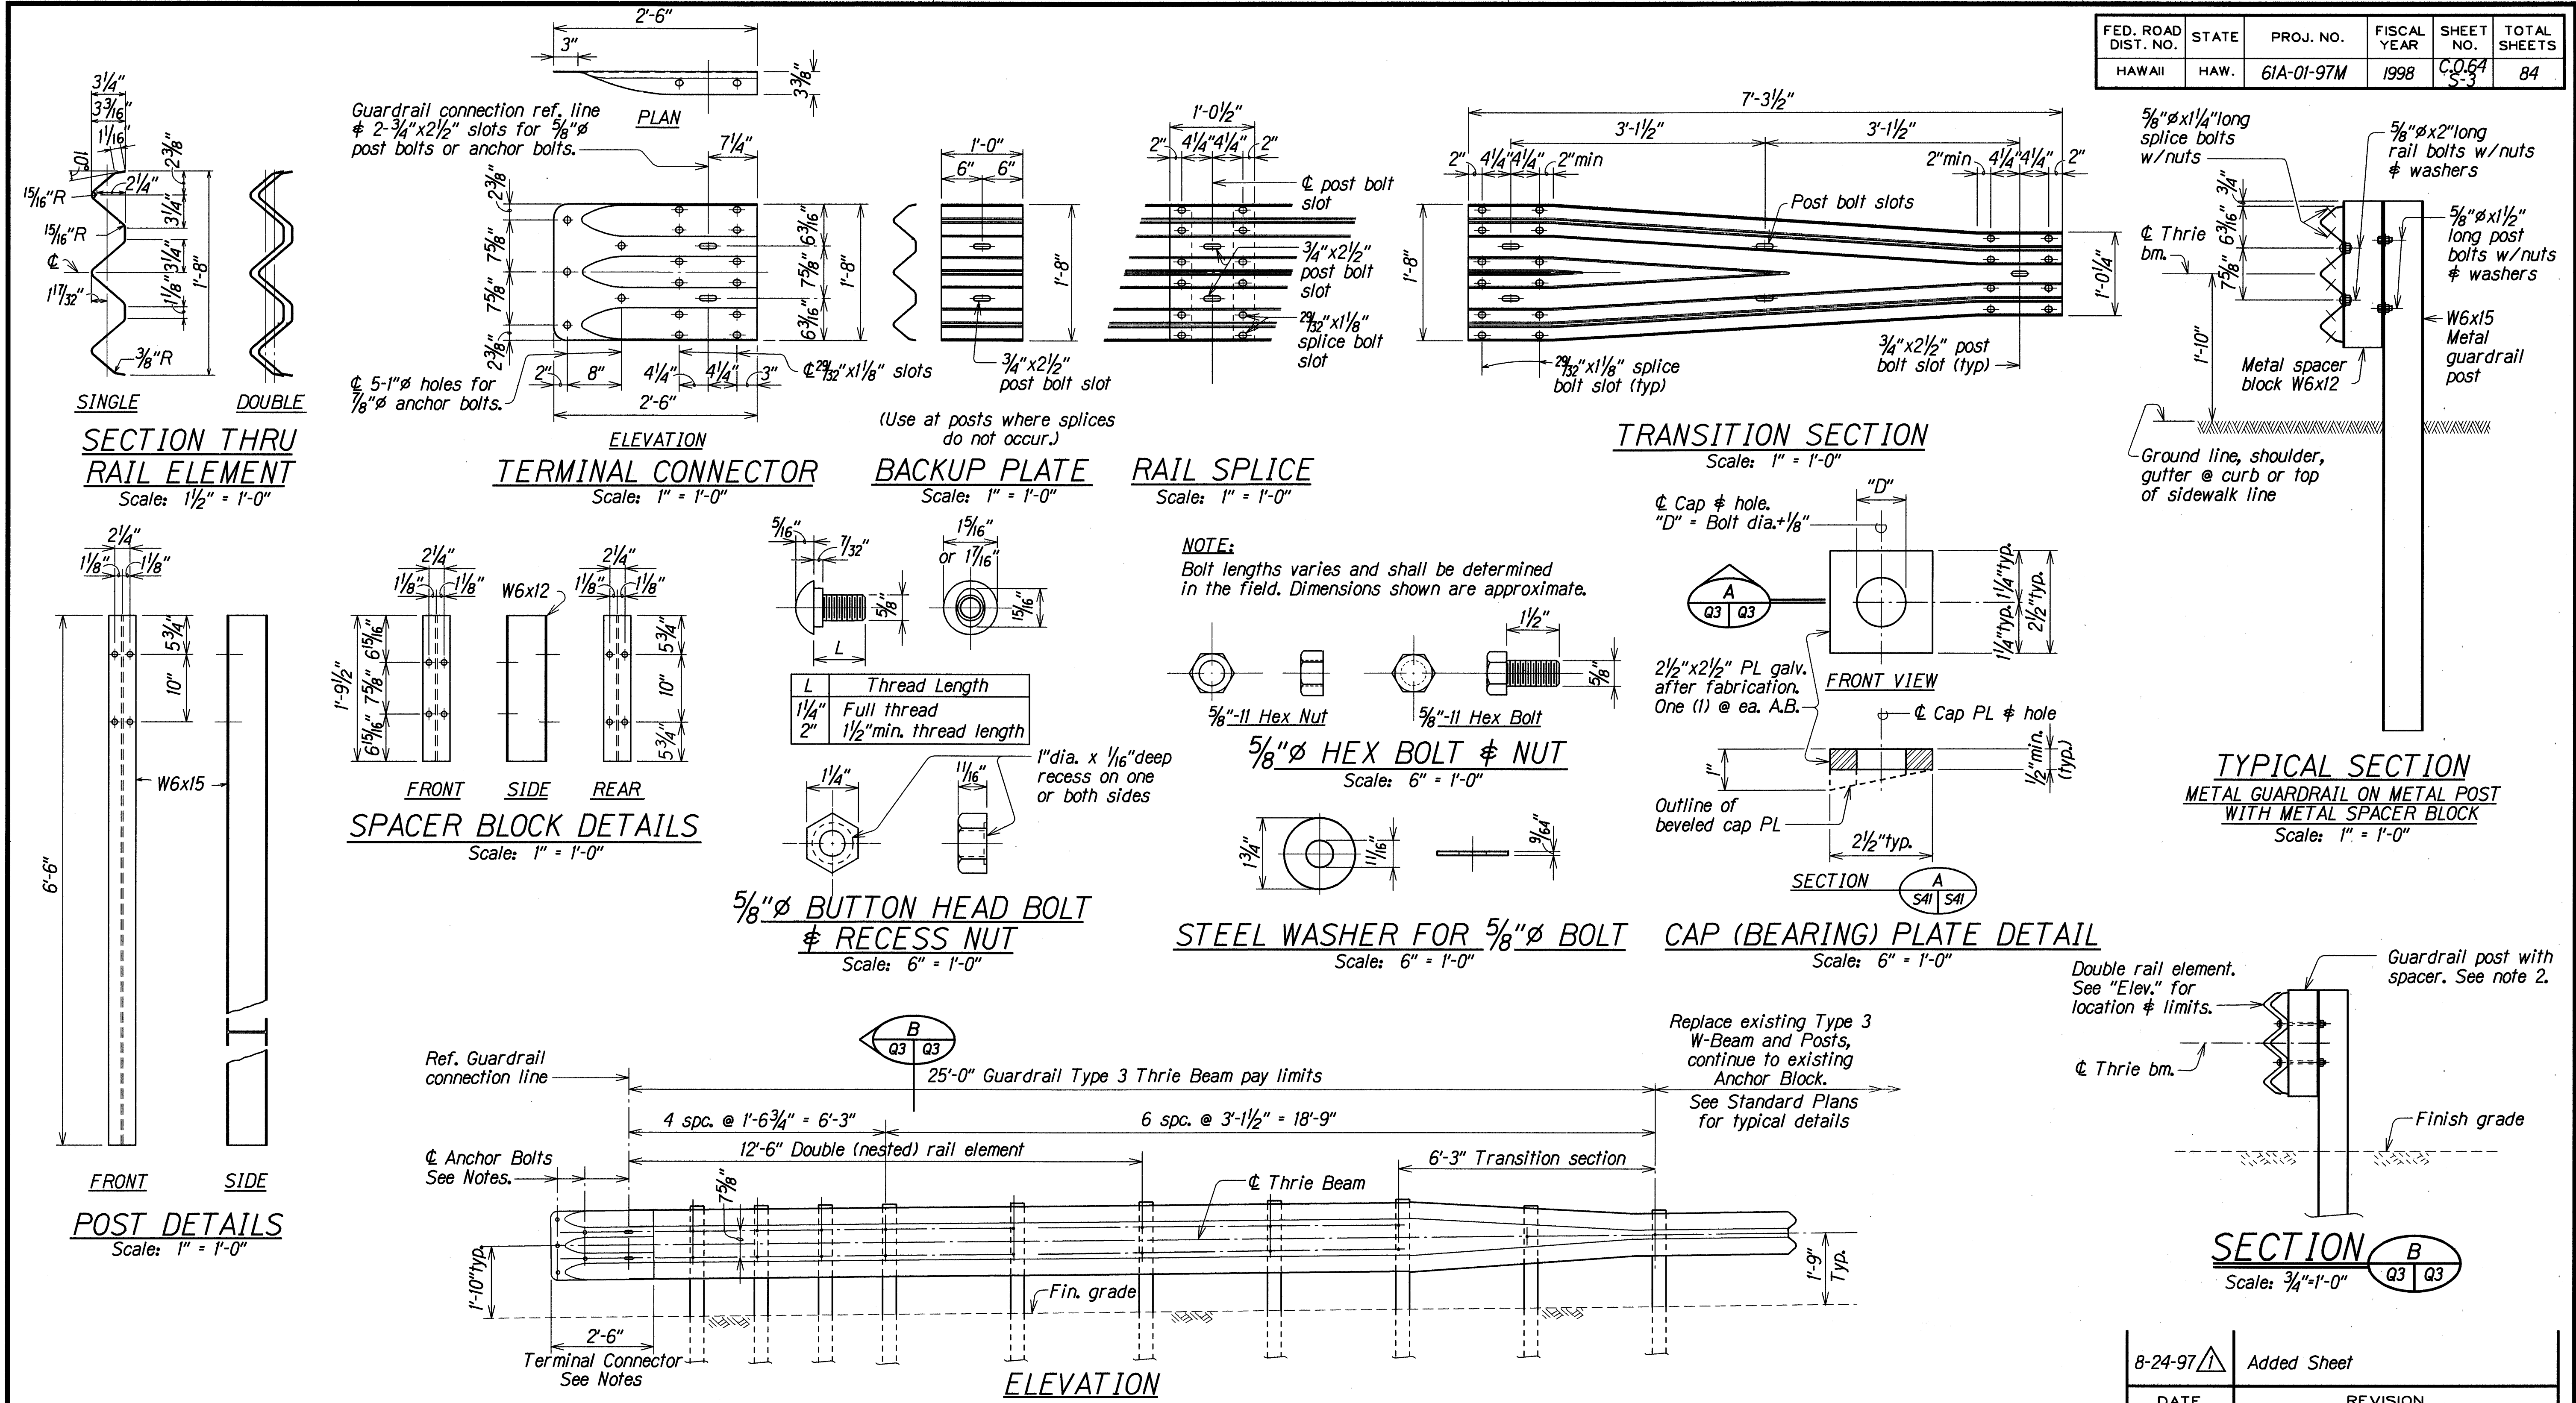

TYPE 3 THRIE BEAM METAL GUARDRAIL UPGRADE AND APPURTENANCES DETAILS

8-24-97	Added Sheet
DATE	REVISION
STATE OF HAWAII DEPARTMENT OF TRANSPORTATION HIGHWAYS DIVISION P.C.C. PAVEMENT RECONSTRUCTION AT EXISTING 10'x10' BOX CULVERT at STA. 49+72 TYPE 3 THRIE BEAM METAL GUARDRAIL UPGRADE and APPURTENANCES DETAILS PALI HIGHWAY RESURFACING Country Club Road to Tunnel Entrance Scale: As Noted Proj. No. 61A-01-97M Date: Jul, 1998	
SHEET No. Q3 OF 3 SHEETS	