

INDEX TO DRAWINGS	
SHEET NO.	DESCRIPTION
1	TITLE SHEET
2	STANDARD PLAN SUMMARY
3	GENERAL NOTES
4	LEGEND
5 - 12	TYPICAL SECTIONS & DETAILS
13	RESURFACING SCHEDULES
14 - 22	MISCELLANEOUS DETAILS
23 - 34	PLANS
35 - 40	TRAFFIC CONTROL PLANS - P.C.C. LANE RECONSTRUCTION
41 - 64	DRAINAGE PLANS & DETAILS
65 - 84	PAVEMENT MARKING & SIGNING PLANS, DETAILS AND SCHEDULES

STATE OF HAWAII

DEPARTMENT OF TRANSPORTATION

HIGHWAYS DIVISION

HONOLULU, HAWAII

PLANS FOR

PALI HIGHWAY RESURFACING

COUNTRY CLUB ROAD TO TUNNEL ENTRANCE




INCLUDING BOTH ROADS TO LOOKOUT

PROJECT NO. 61A-01-97M

DISTRICT OF HONOLULU

ISLAND OF OAHU

FED. ROAD DIST. NO.	STATE	PROJ. NO.	FISCAL YEAR	SHEET NO.	TOTAL SHEETS
HAWAII	HAW.	61A-01-97M	1997	1	84

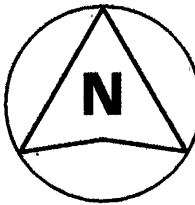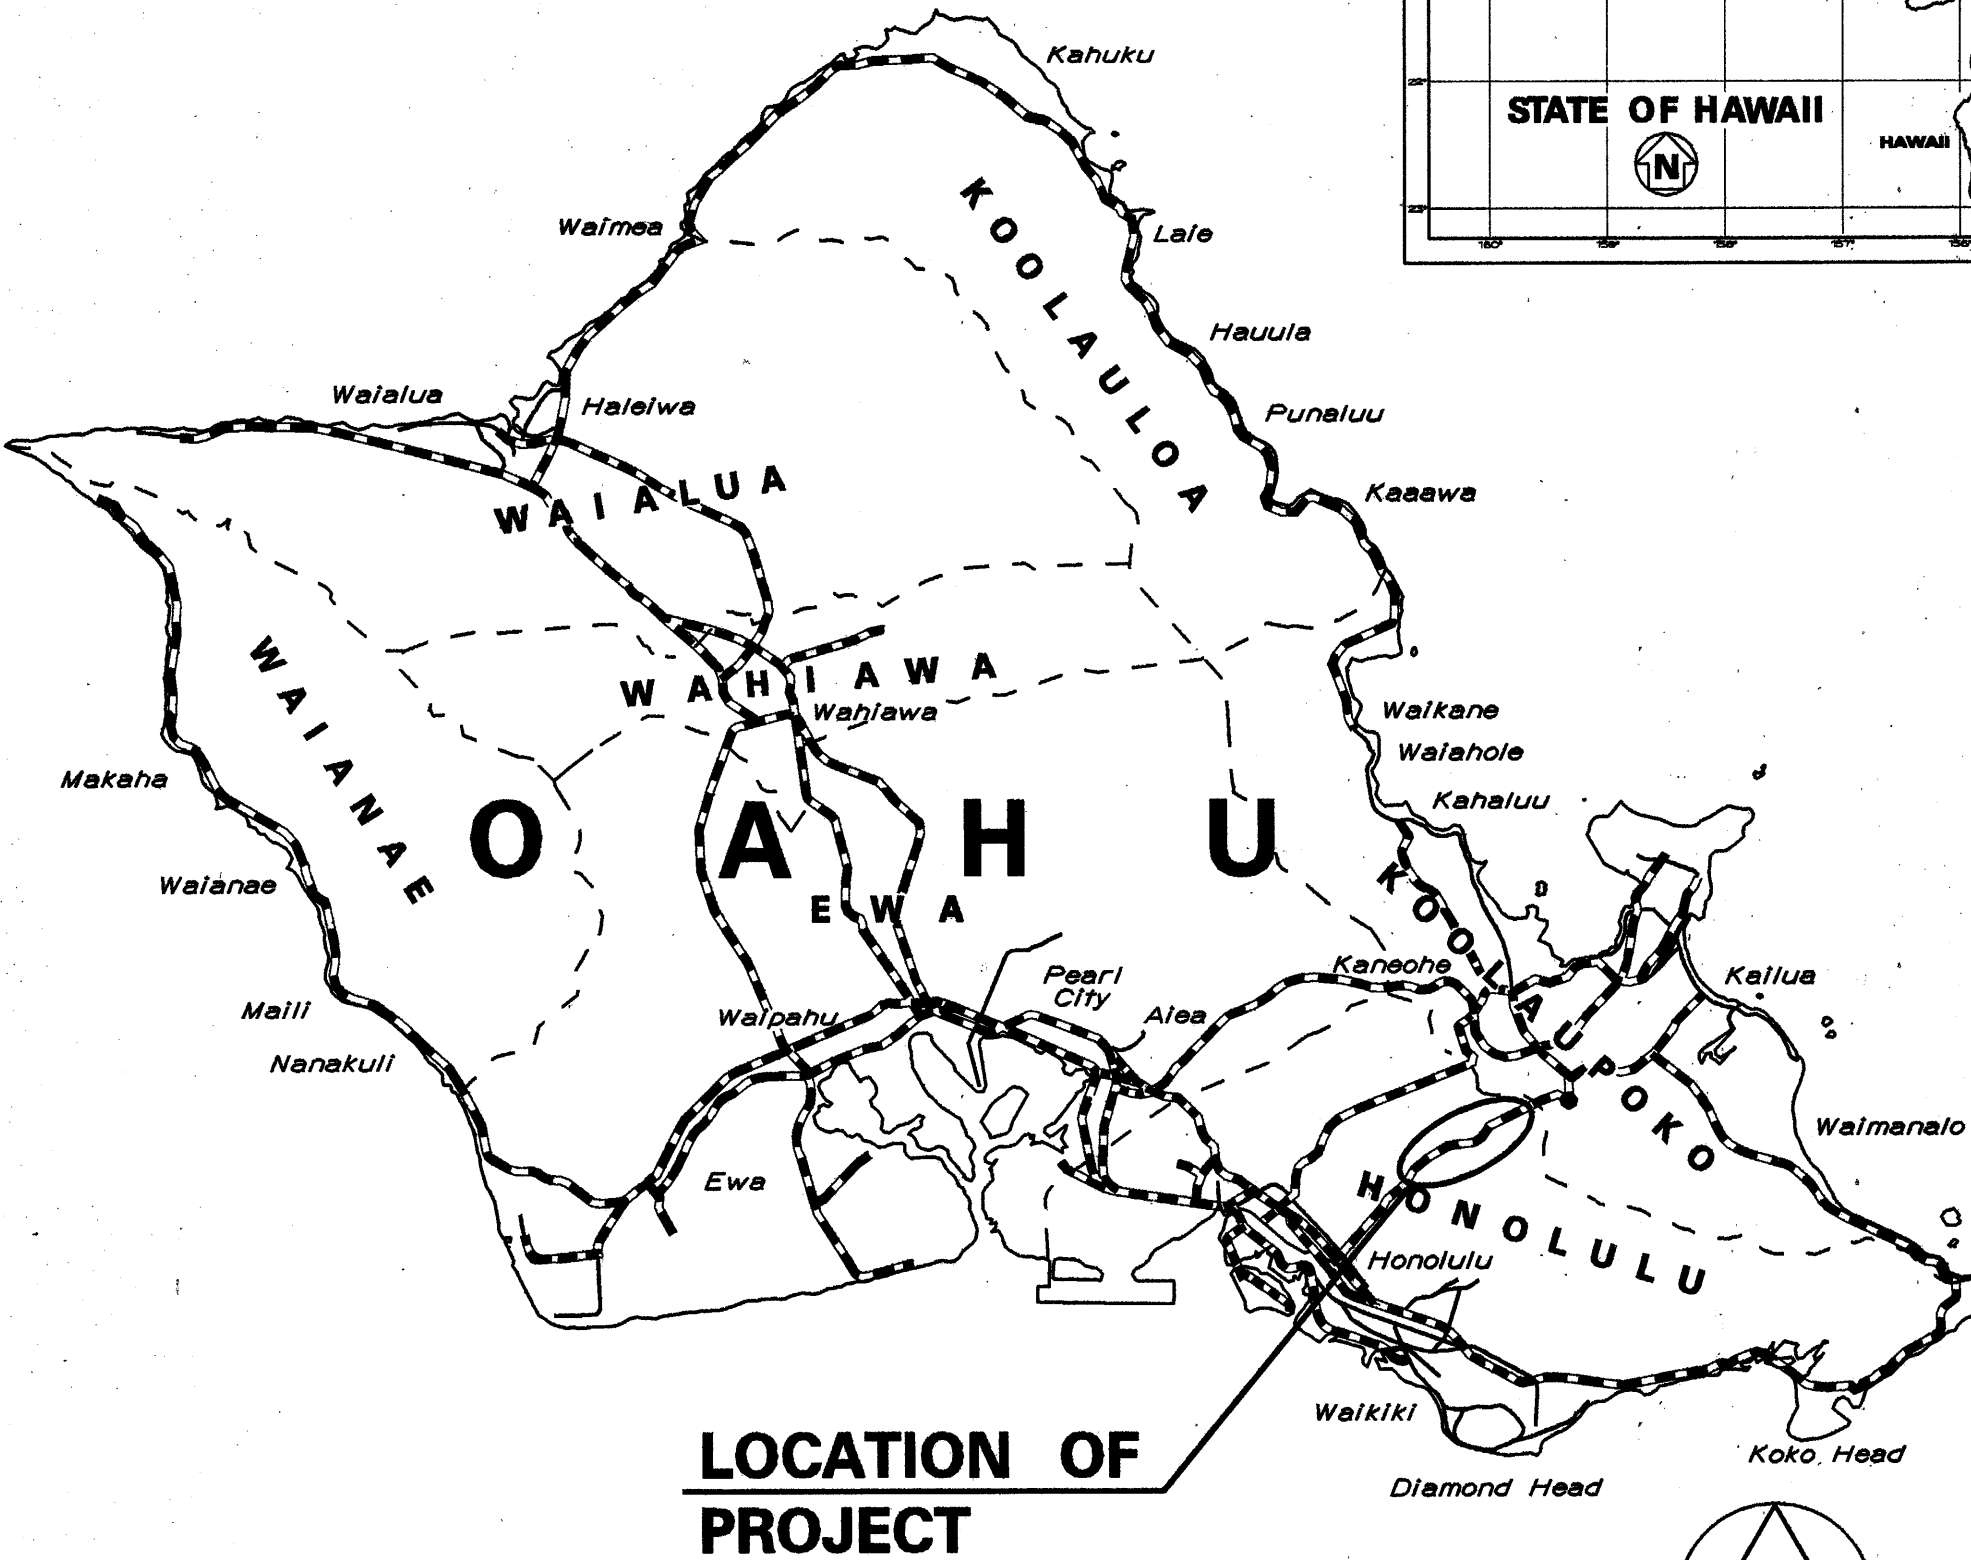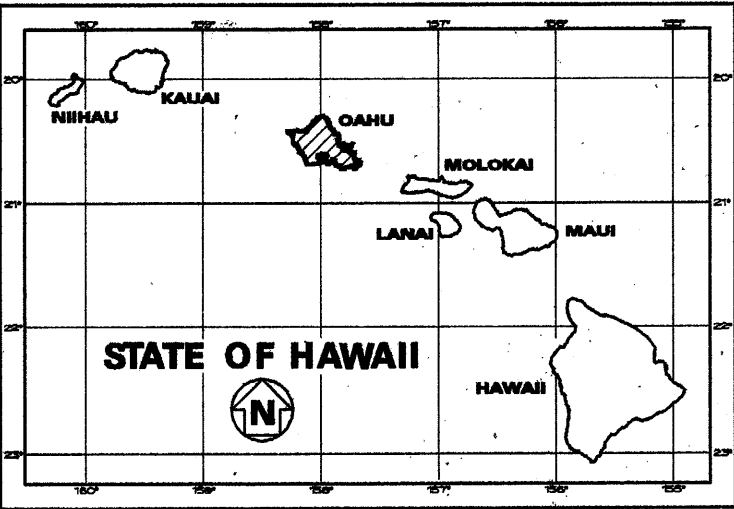

4048

SCALE IN MILES

FEDERAL AID PROJECTS PREVIOUSLY CONSTRUCTED OR UNDER CONSTRUCTION

MILE POST 2.08 TO MILE POST 5.69

DESIGN UNIT "A"

DESIGNED BY

JULIUS B. FRONDA


587-2246

MAY, 1997

DATE

P.S. & E. BY

PHONE

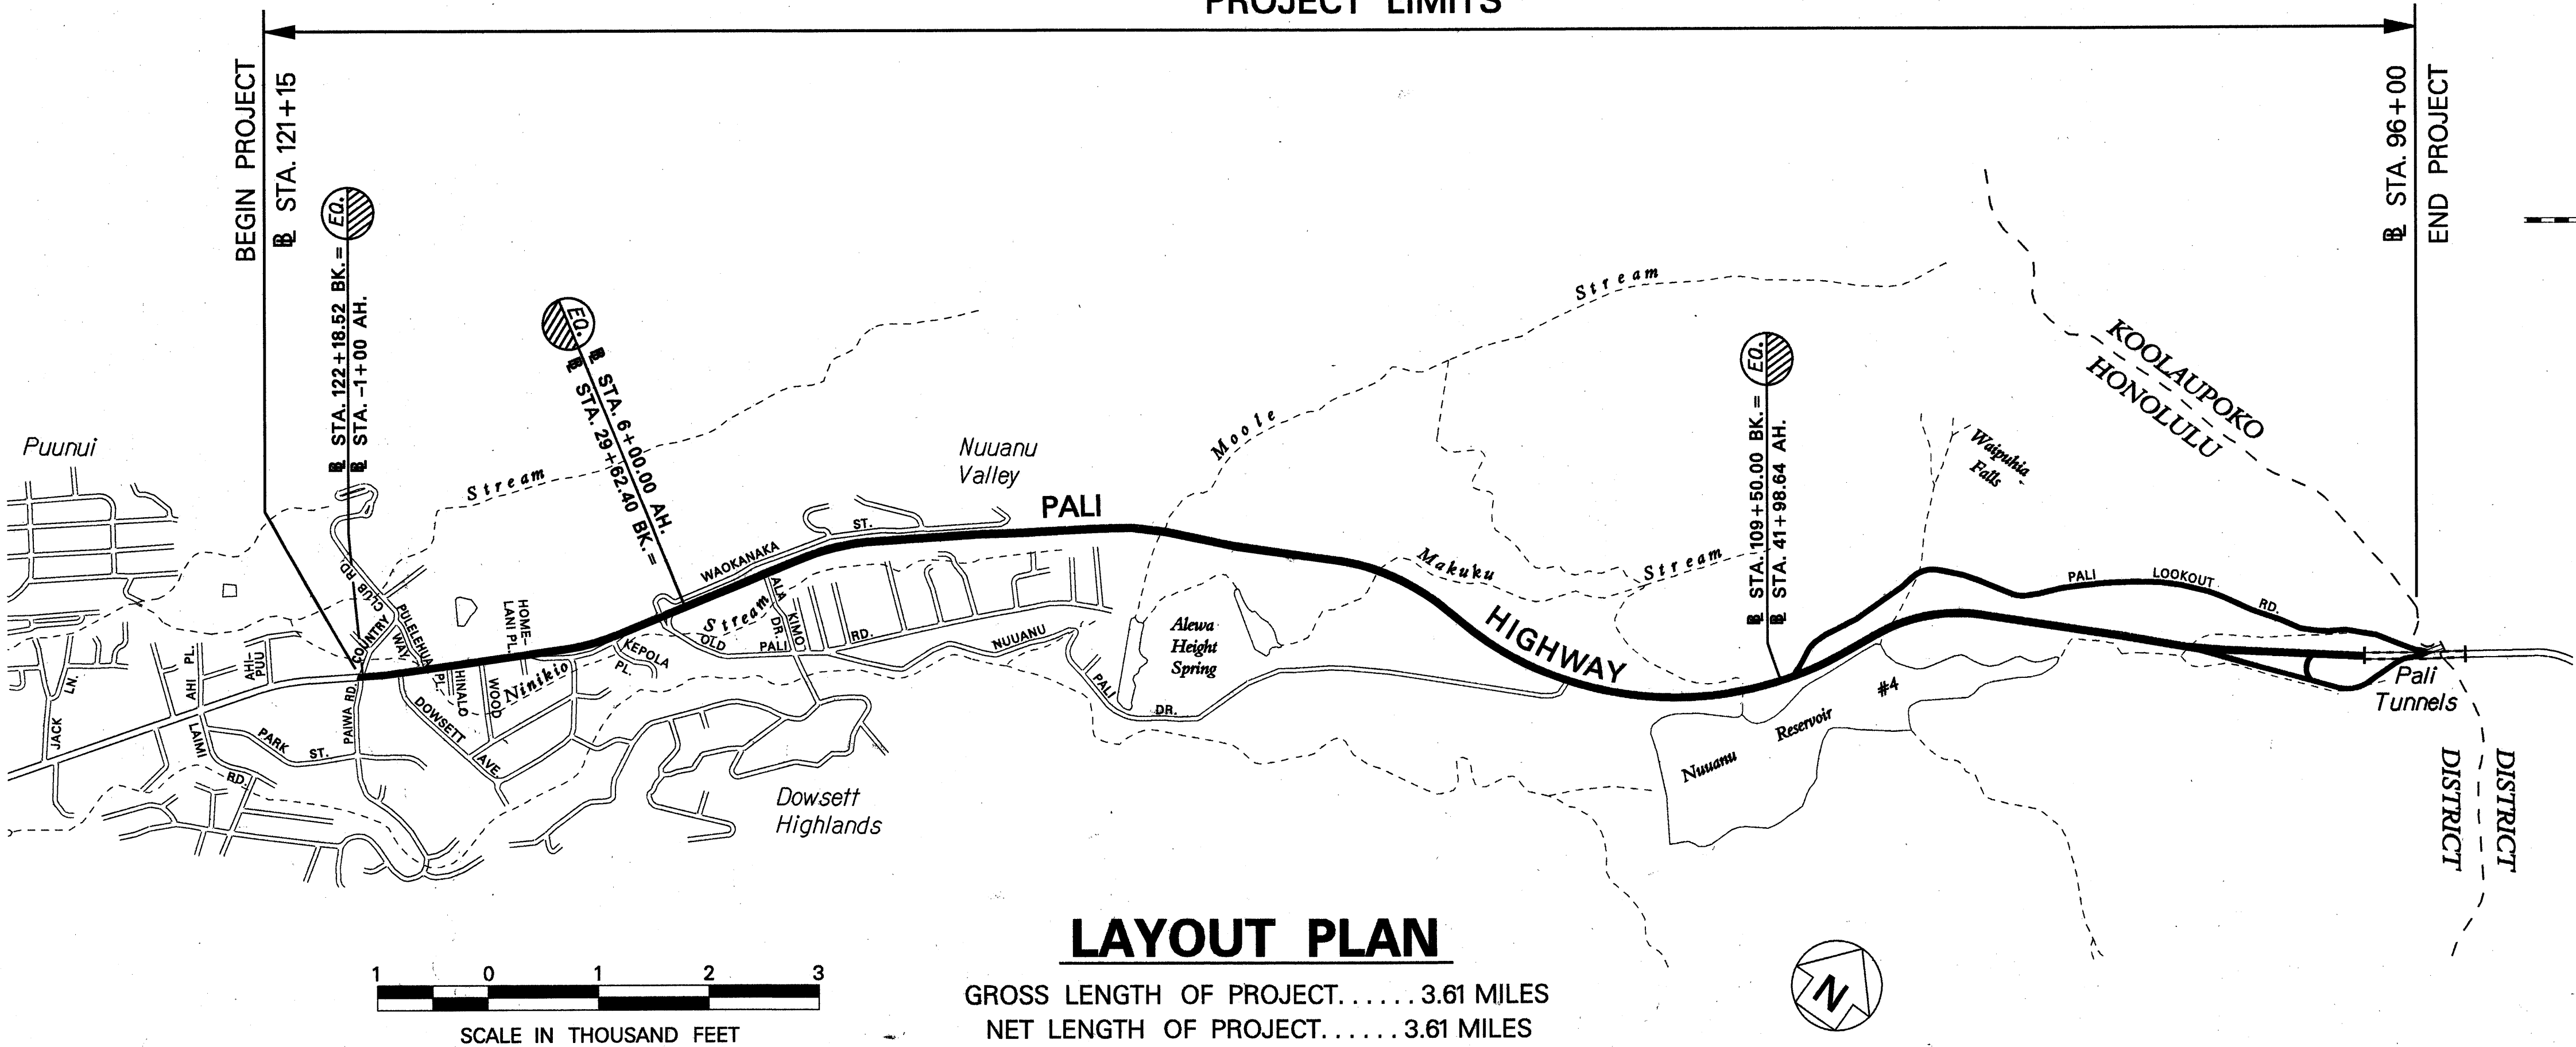

LAYOUT PLAN

GROSS LENGTH OF PROJECT..... 3.61 MILES

NET LENGTH OF PROJECT..... 3.61 MILES

DEPARTMENT OF TRANSPORTATION STATE OF HAWAII	
APPROVED:	
DIR. OF TRANSPORTATION	DATE