



FED. ROAD DIST. NO.	STATE	PROJ. NO.	FISCAL YEAR	SHEET NO.	TOTAL SHEETS
HAWAII	HAW.	61A-01-97M	1997	35	84

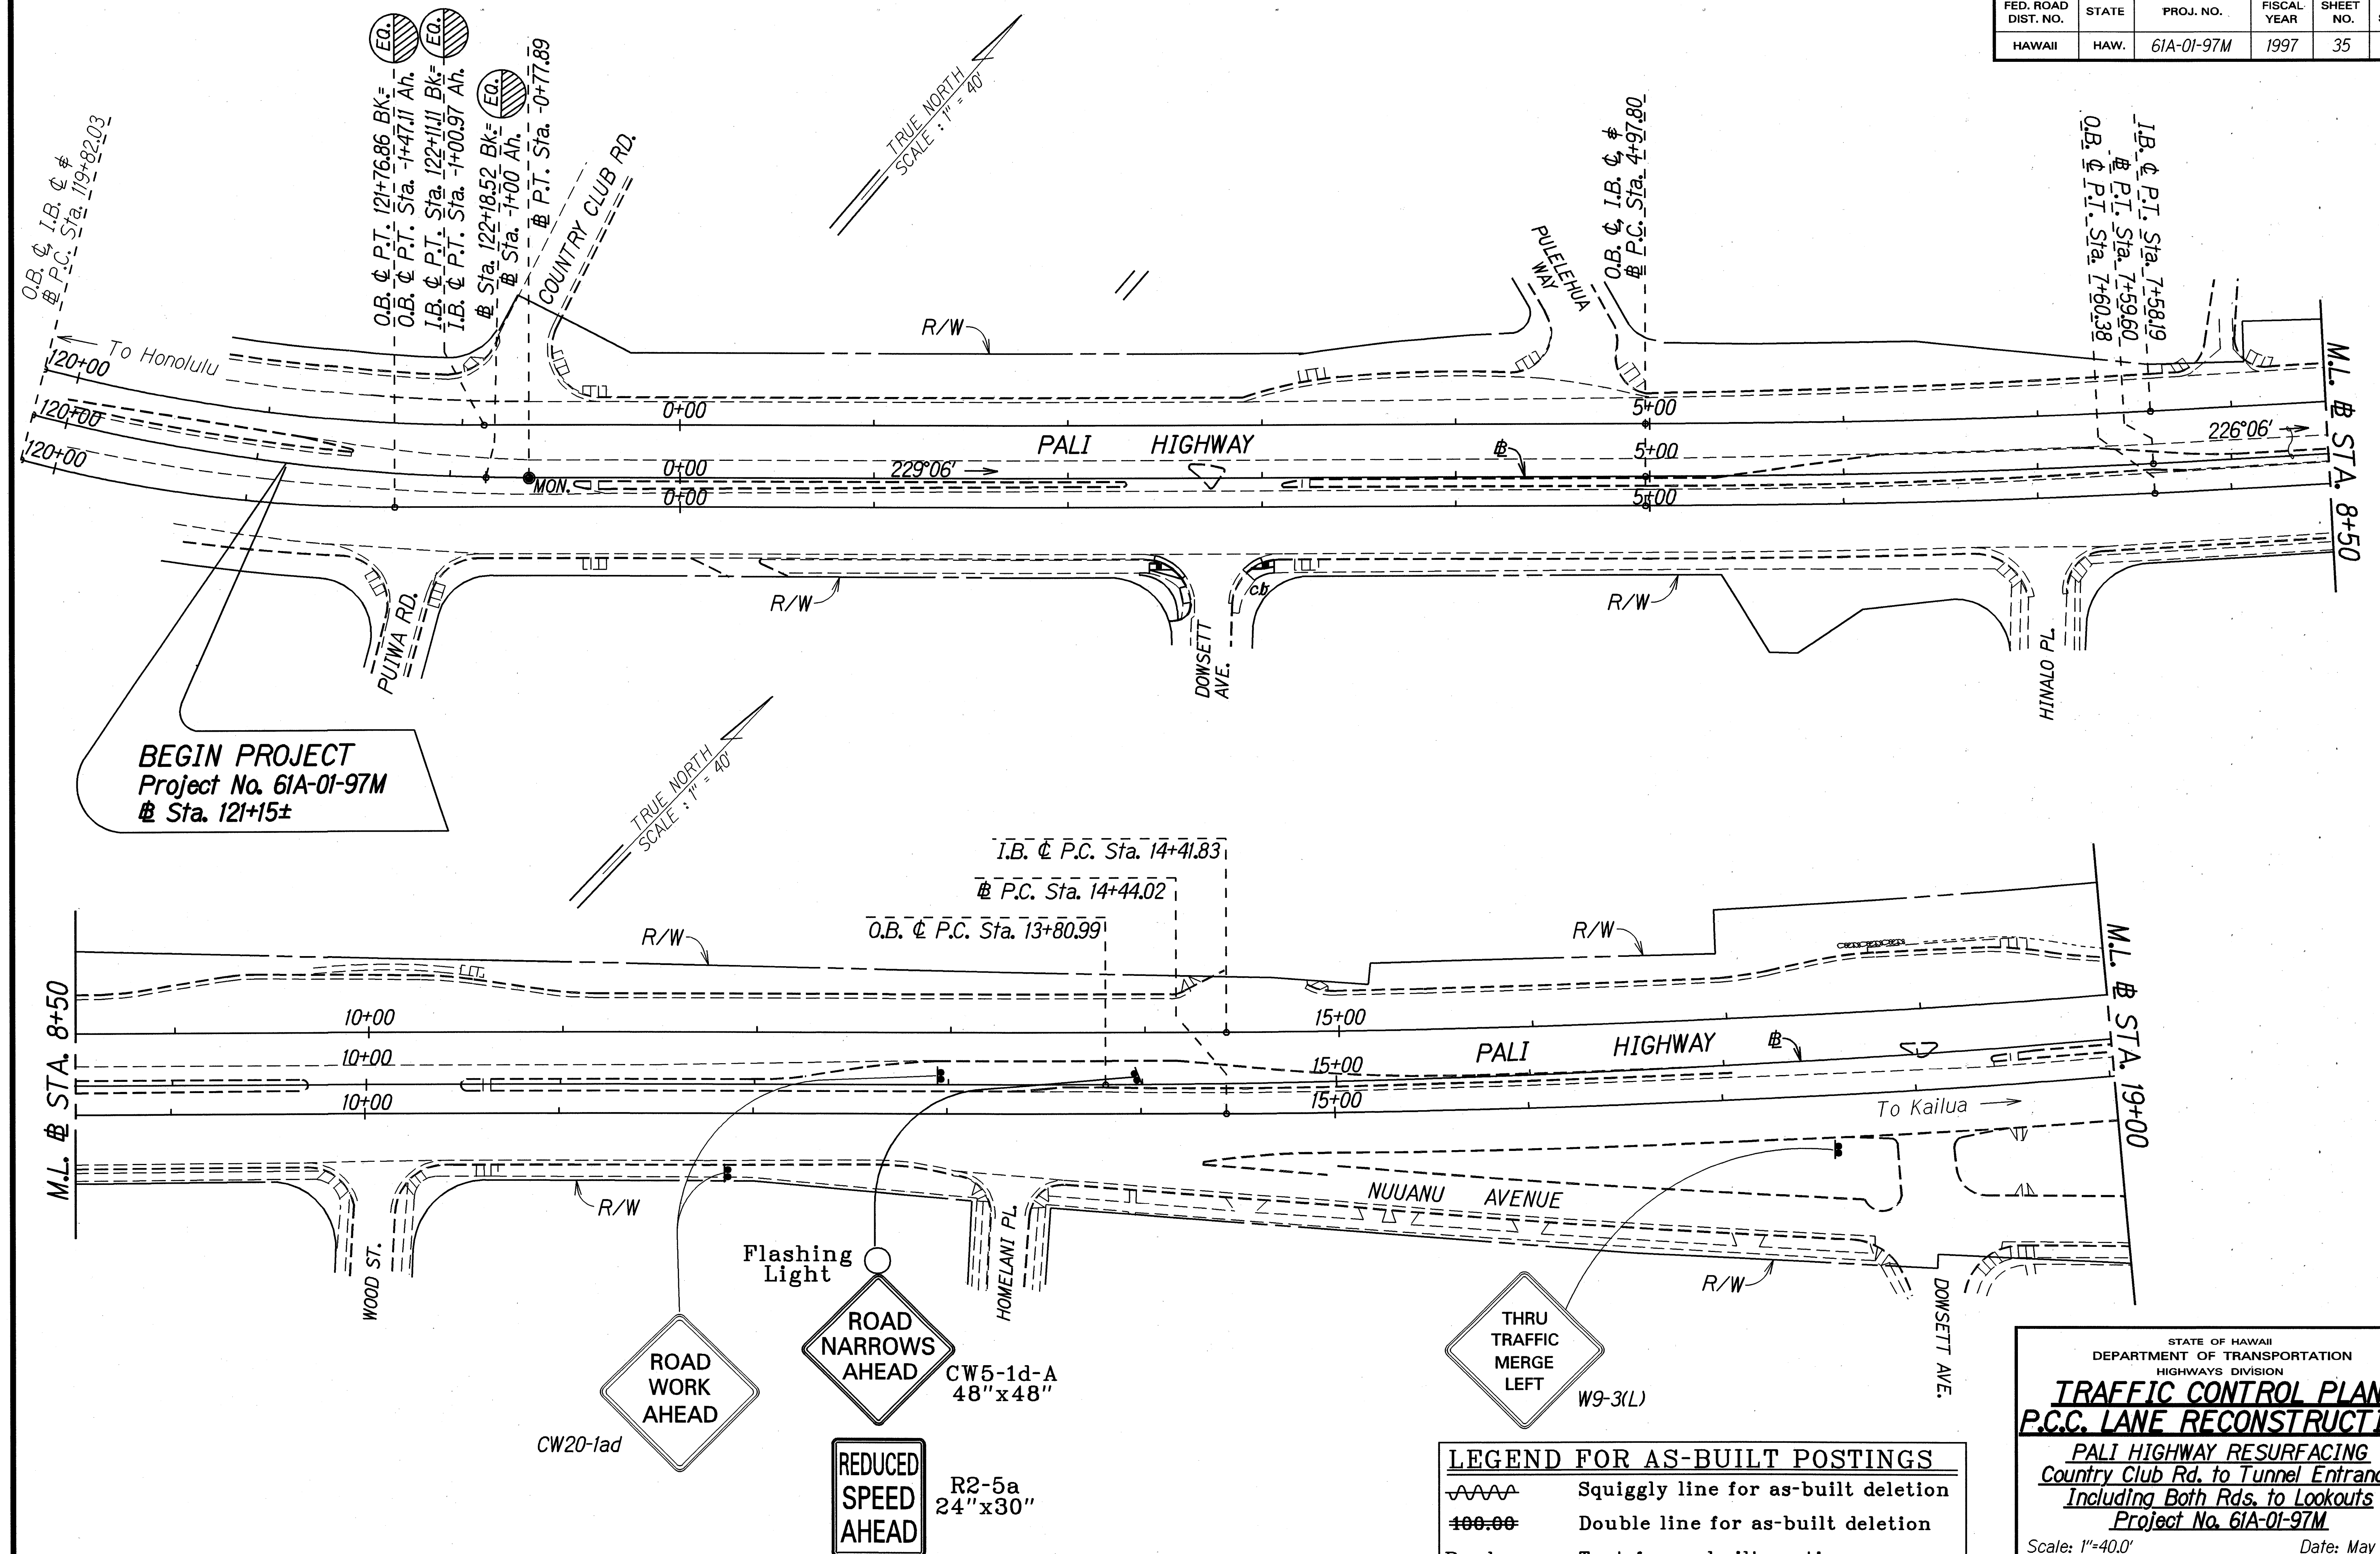

ORIGINAL PLAN	DATE
DESIGNED BY	12-29-97
TRACED BY	
NOTED BY	
QUANTITIES BY	
CHECKED BY	

Note:
Temporarily fill in catch basins along
left E.P. with A.C. For details, see
plan sheet no. 12.

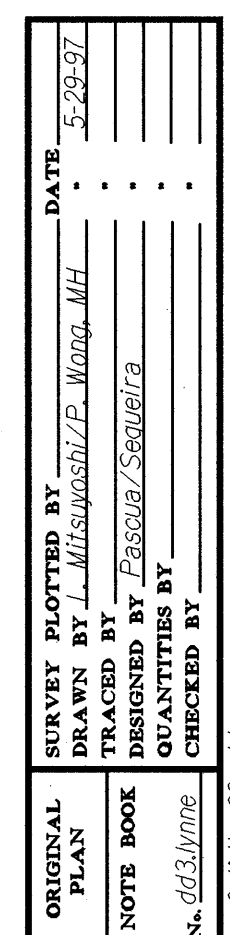

6/9/97	Revised Typical Section, "Right Lane Exit Only" Sign and Pavement Markings.
DATE	REVISION

STATE OF HAWAII
DEPARTMENT OF TRANSPORTATION
HIGHWAYS DIVISION

TRAFFIC CONTROL PLAN
P.C.C. LANE RECONSTRUCTION

PALI HIGHWAY RESURFACING
Country Club Rd. to Tunnel Entrance,
Including Both Rds. to Lookouts
Project No. 61A-01-97M

Scale: 1"=40.0' Date: May 1997


SHEET No. **2** OF **6** SHEETS

"AS-BUILT"

ADD. 36

FED. ROAD DIST. NO.	STATE	PROJ. NO.	FISCAL YEAR	SHEET NO.	TOTAL SHEETS
HAWAII	HAW.	61A-01-97M	1997	37	84

TRUE NORTH
SCALE: 1" = 40'

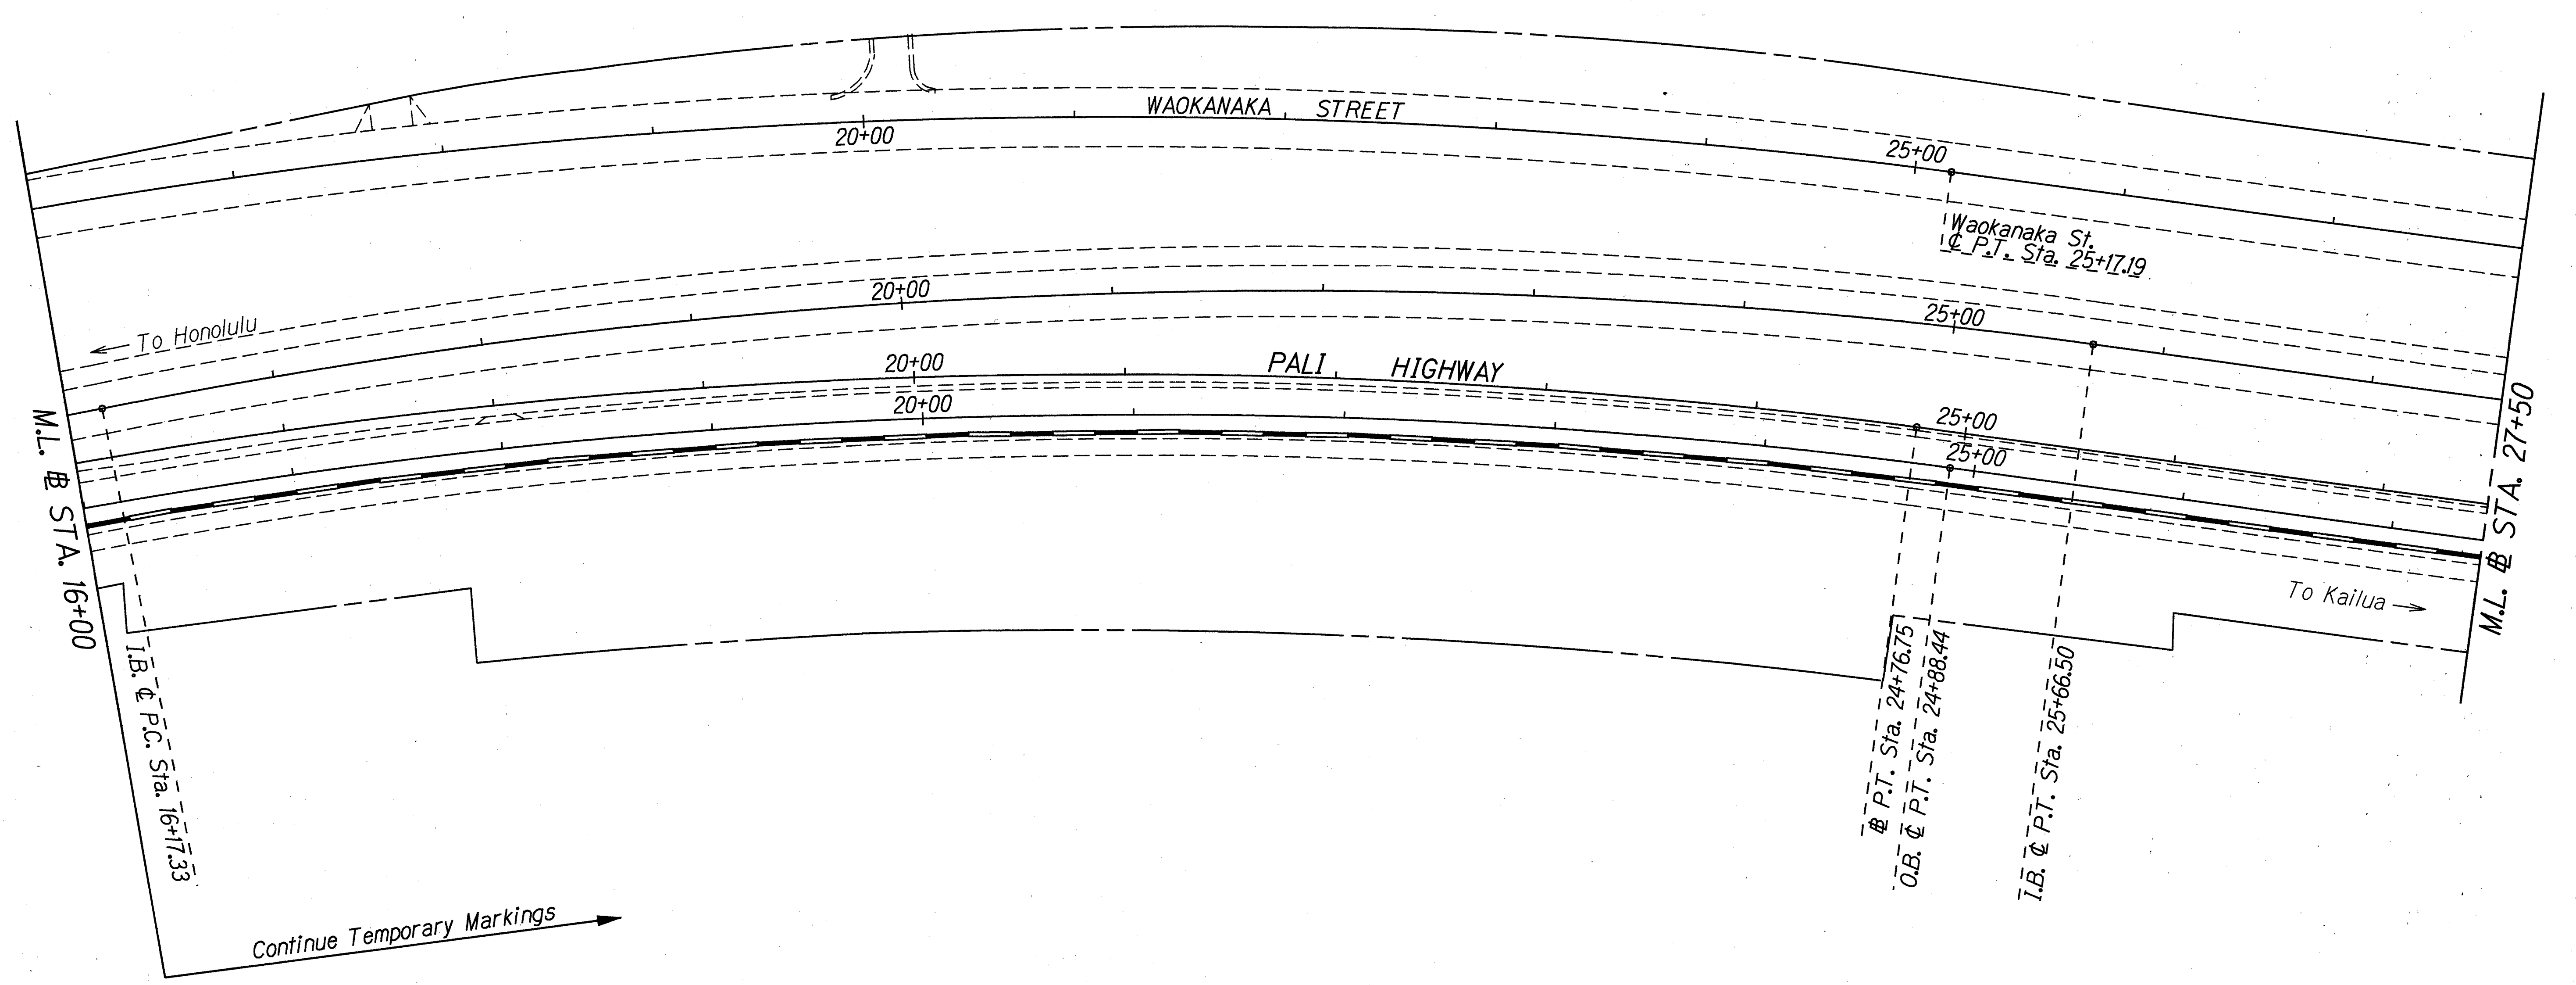

ORIGINAL PLAN	SURVEY PLOTTED BY	DATE
NOTE BOOK	DRAWN BY	5/23/97
add'l	TRACED BY	
03	QUANTITIES BY	
	CHECKED BY	

STATE OF HAWAII
DEPARTMENT OF TRANSPORTATION
HIGHWAYS DIVISION


TRAFFIC CONTROL PLAN
P.C.C. LANE RECONSTRUCTION

*PALI HIGHWAY RESURFACING
Country Club Rd. to Tunnel Entrance,
Including Both Rds. to Lookouts
Project No. 61A-01-97M*

Scale: 1"=40.0' Date: May 1997

SHEET No. 3 OF 6 SHEETS

FED. ROAD DIST. NO.	STATE	PROJ. NO.	FISCAL YEAR	SHEET NO.	TOTAL SHEETS
HAWAII	HAW.	61A-01-97M	1997	38	84

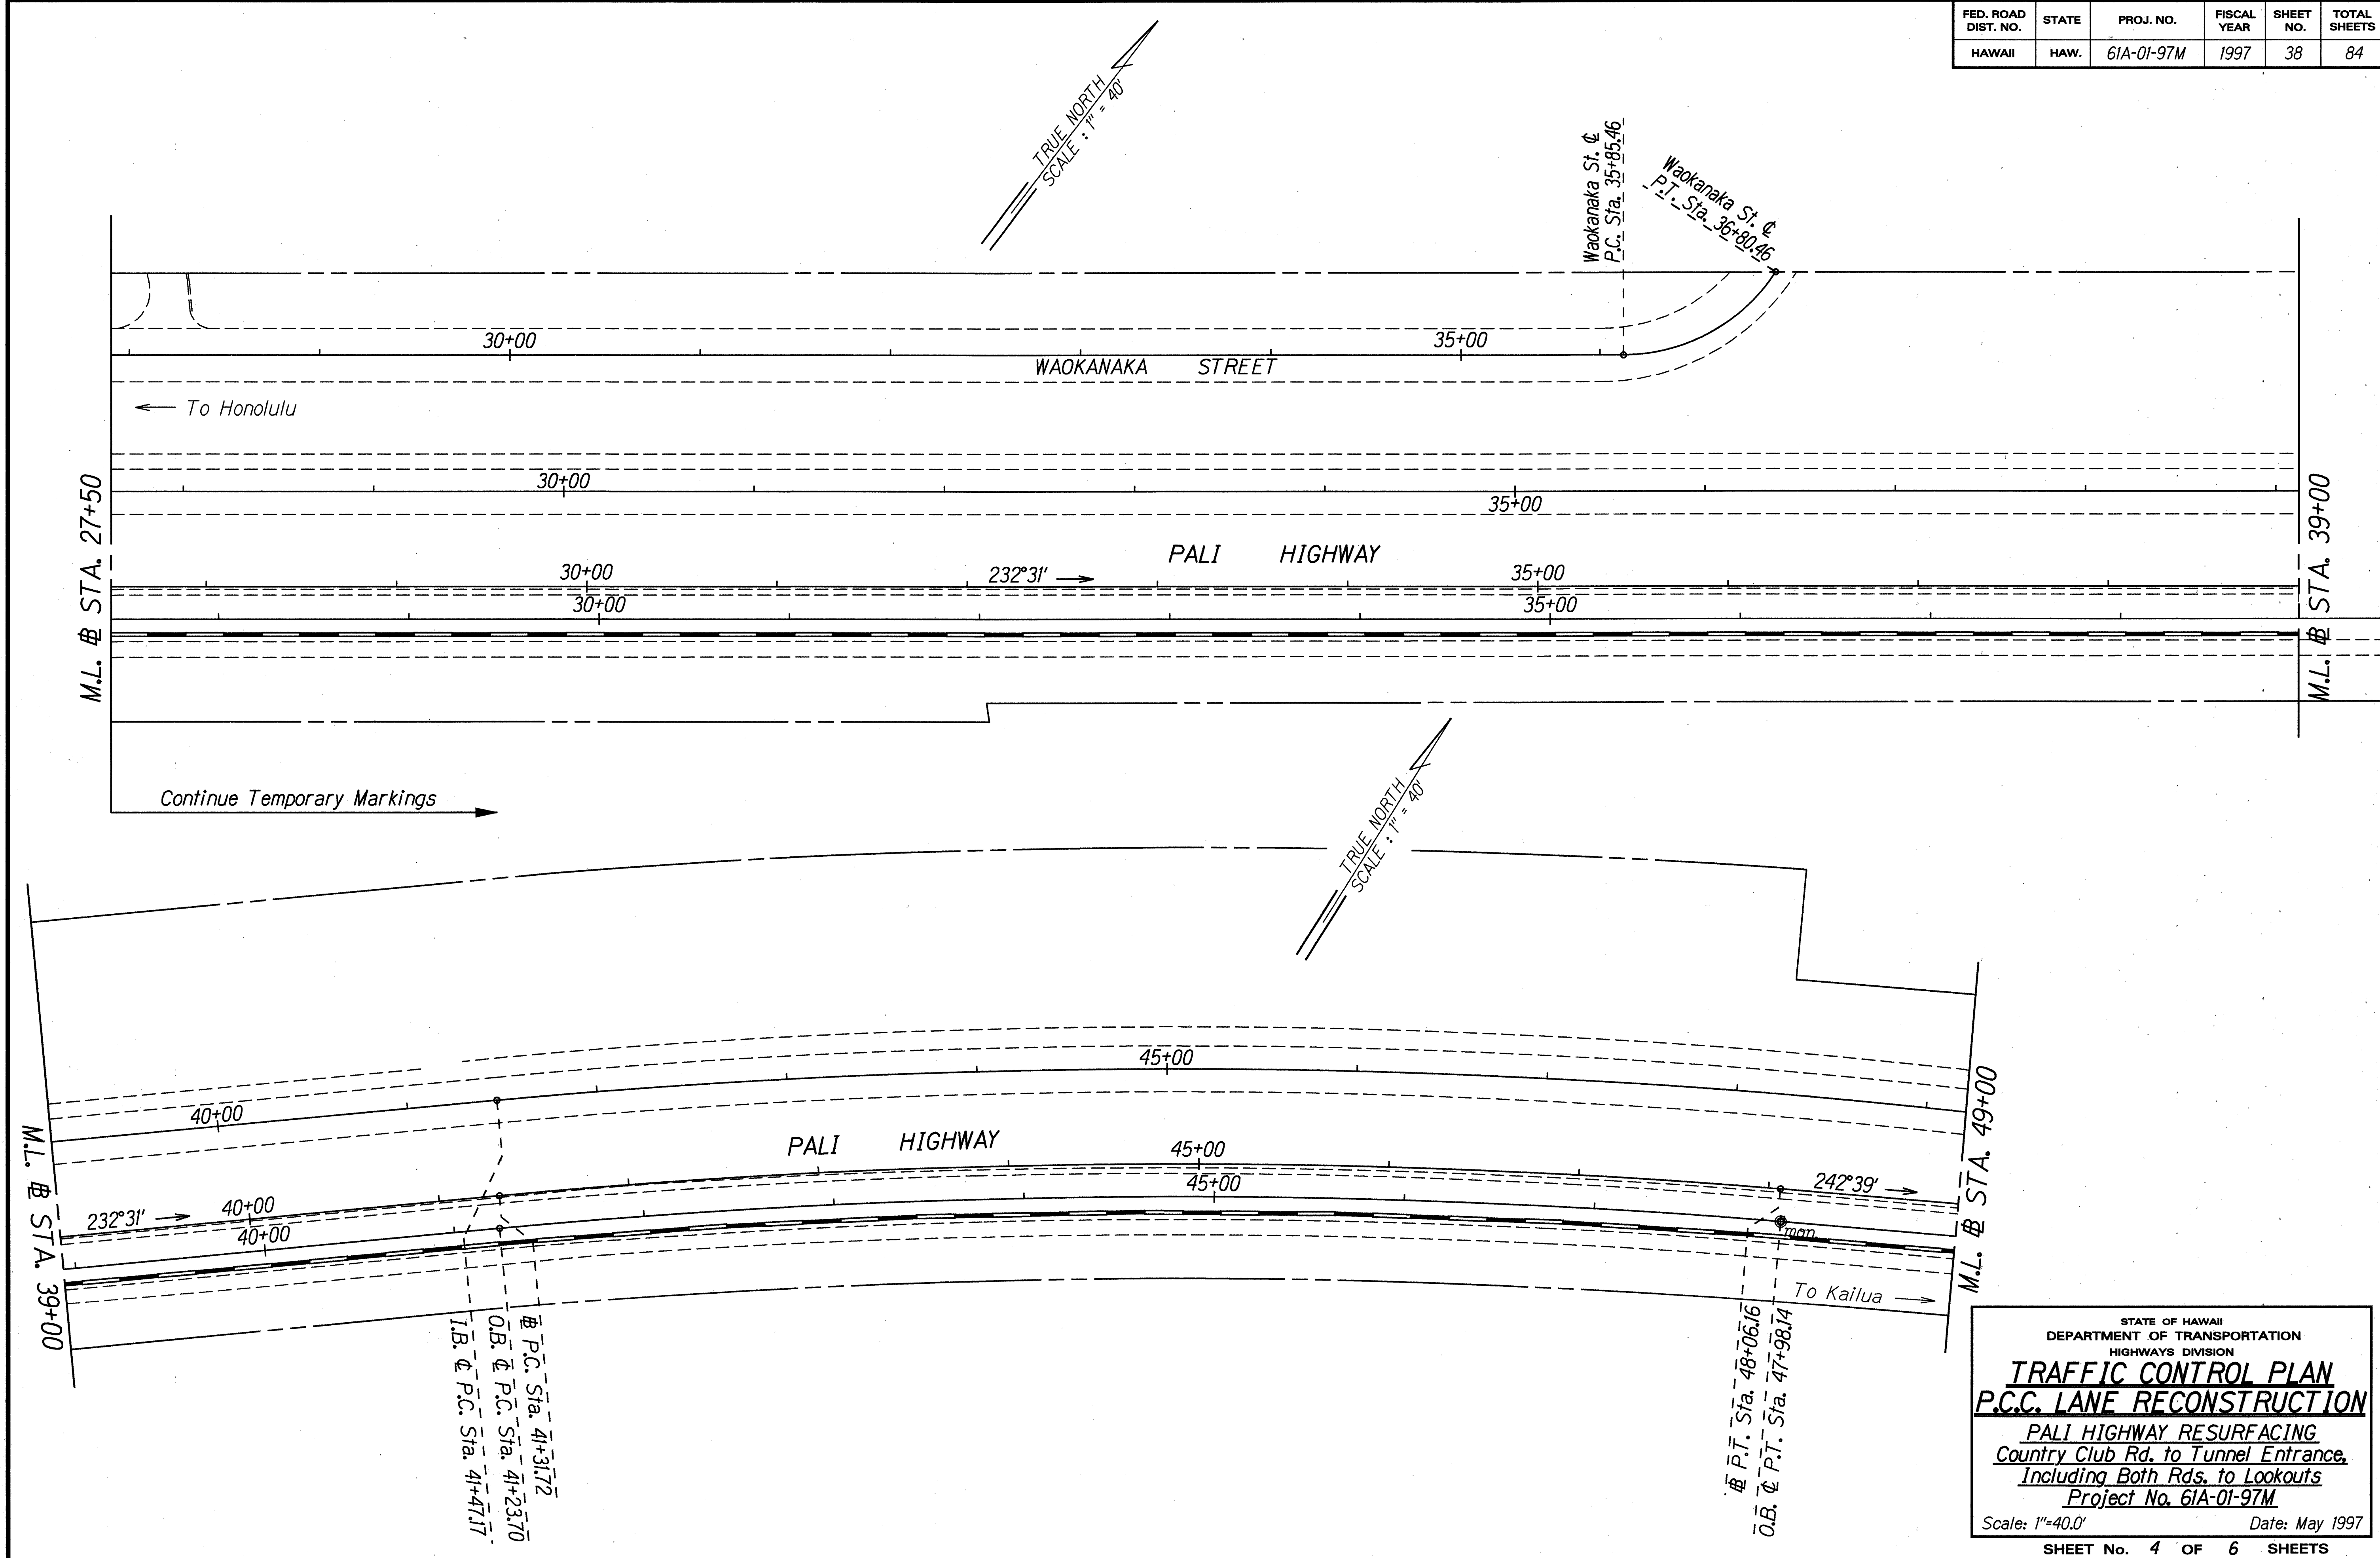

ORIGINAL PLAN	SURVEY PLOTTED BY	DATE
NOTE BOOK	DRAWN BY	5/23/97
eddyline	TRACED BY	
Ms. Giddings	QUANTITIES BY	
	CHECKED BY	

STATE OF HAWAII
DEPARTMENT OF TRANSPORTATION
HIGHWAYS DIVISION


TRAFFIC CONTROL PLAN
P.C.C. LANE RECONSTRUCTION

PALI HIGHWAY RESURFACING
Country Club Rd. to Tunnel Entrance,
Including Both Rds. to Lookouts
Project No. 61A-01-97M

Scale: 1"=40.0' Date: May 1997

SHEET No. 4 OF 6 SHEETS

FED. ROAD DIST. NO.	STATE	PROJ. NO.	FISCAL YEAR	SHEET NO.	TOTAL SHEETS
HAWAII	HAW.	61A-01-97M	1997	40	84

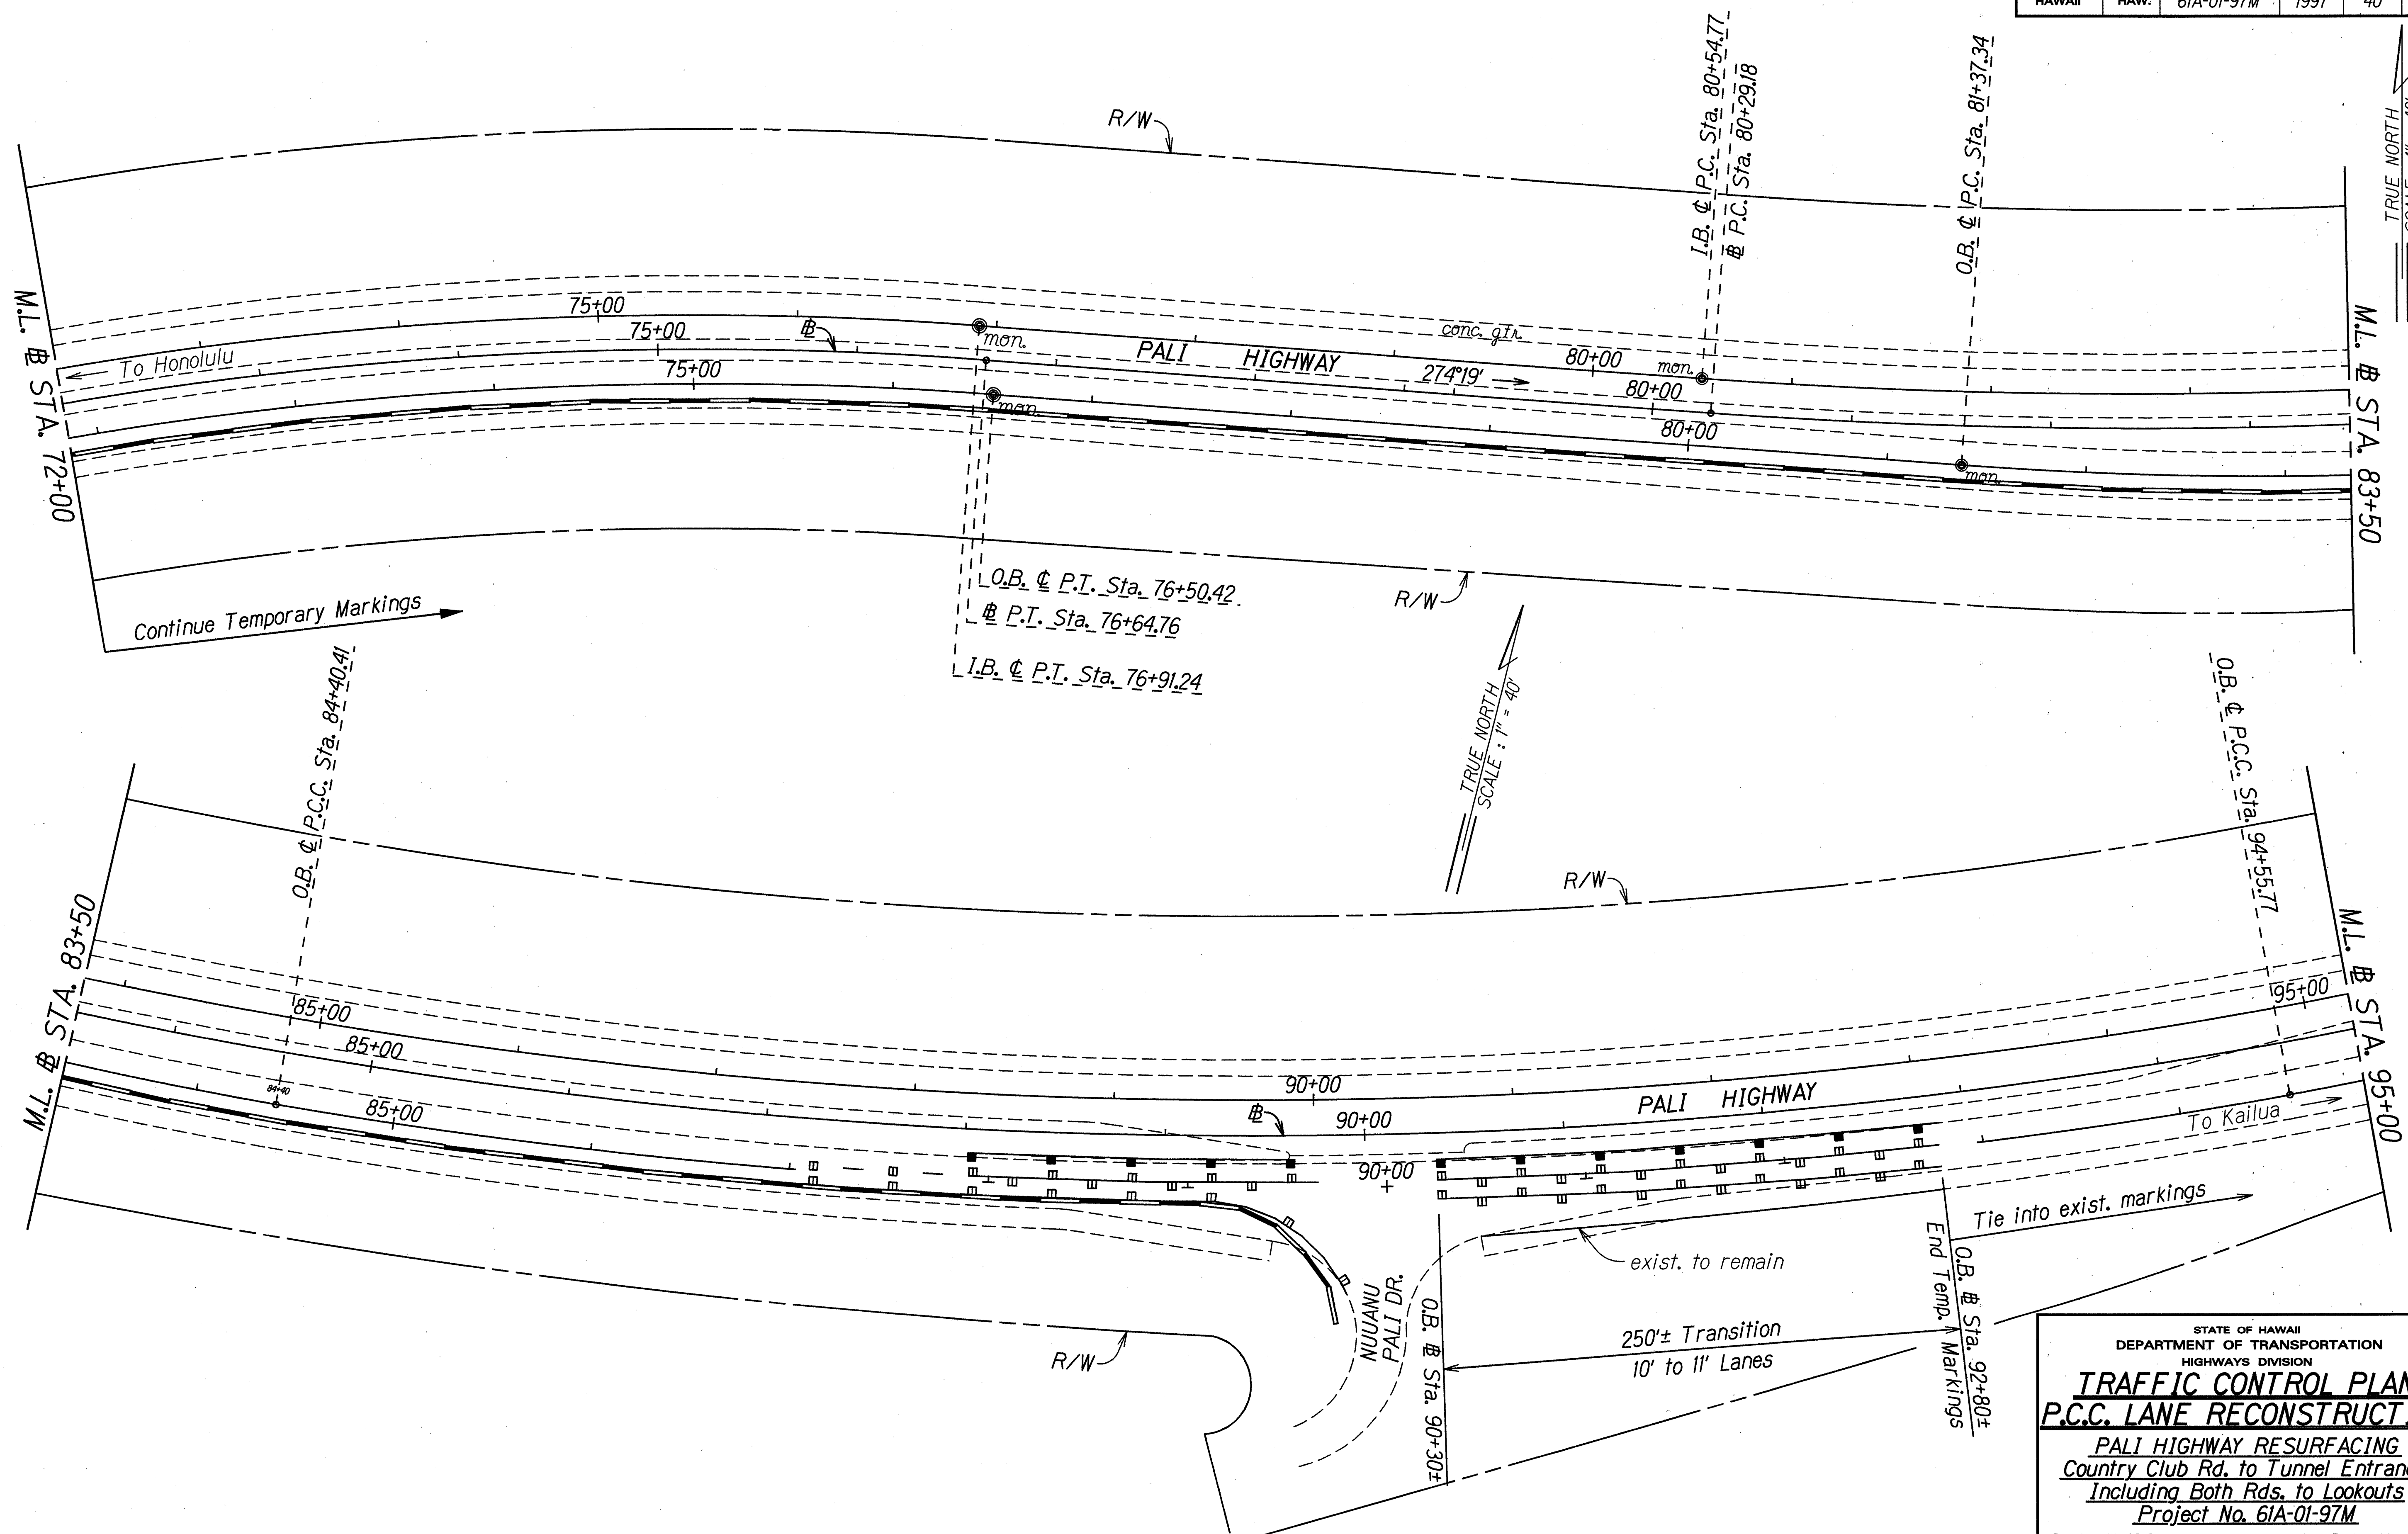

ORIGINAL PLAN	SURVEY PLOTTED BY	DATE
NOV 2000	DRIVEN BY L. Mitsuyoshi/P. Wong, MH	5-29-97
eddyline	TRACED BY	
N. Goldtop06	QUANTITIES BY	
	CHECKED BY	

STATE OF HAWAII
DEPARTMENT OF TRANSPORTATION
HIGHWAYS DIVISION

TRAFFIC CONTROL PLAN
P.C.C. LANE RECONSTRUCTION

PALI HIGHWAY RESURFACING
Country Club Rd. to Tunnel Entrance,
Including Both Rds. to Lookouts
Project No. 61A-01-97M

Scale: 1"=40.0' Date: May 1997

SHEET No. 6 OF 6 SHEETS